

**UNION
TOWNSHIP
1942**

INDEX MAP

CORRECTED TO

ORDER OF NUMBER SECTION TOWN RANGE

~~APRIL 12 1942~~

SCALE 40 CHAINS TO THE INCH

~~January 1 1945~~

~~November 10 1945~~

~~January 1 1947~~

~~January 1 1948~~

~~January 1 1949~~

January 1 1950


		HARRISON		TOWNSHIP				
PLEASANT	TOWNSHIP	26-3-14	20-3-14	14-3-14	8-3-14	2-3-14	TOWNSHIP	
		PAGE 1	PAGE 2	PAGE 3	PAGE 4	PAGE 4		
PLEASANT	TOWNSHIP	25-3-14	19-3-14	13-3-14	7-3-14	1-3-14	TOWNSHIP	
		PAGE 5	PAGE 6	PAGE 7	PAGE 8	PAGE 8		
TOWNSHIP	TOWNSHIP	30-4-13	24-4-13	18-4-13	12-4-13	6-4-13	LIBERTY	
		PAGE 9	PAGE 10	PAGE 11	PAGE 12	PAGE 12		
TOWNSHIP	TOWNSHIP	29-4-14	23-4-13	17-4-13	11-4-13	5-4-13	LIBERTY	
		PAGE 13	PAGE 14	PAGE 15	PAGE 16	PAGE 16		
MIAMI	TOWNSHIP	28-4-13	22-4-13	16-4-13	10-4-13	4-4-13	LIBERTY	
		PAGE 17	PAGE 18	PAGE 19	PAGE 20	PAGE 20		

UNION TOWNSHIP INDEX

	SECTION	TOWN	RANGE	PAGE
MIAMI RIVERS SURVEY	26	3	14	1
	20	3	14	2
	14	3	14	3
	8	3	14	4
	2	3	14	4
	25	3	14	5
	19	3	14	6
	13	3	14	7
	7	3	14	8
	1	3	14	8
	30	4	13	9
	24	4	13	10
	18	4	13	11
	12	4	13	12
	6	4	13	12
	29	4	13	13
	23	4	13	14
	17	4	13	15
	11	4	13	16
	5	4	13	16
28	4	13	17	
22	4	13	18	
16	4	13	19	
10	4	13	20	
4	4	13	20	


UNION TOWNSHIP
SECTION 26 TOWN 3 RANGE 14

SCALE 10 CHAINS TO THE INCH

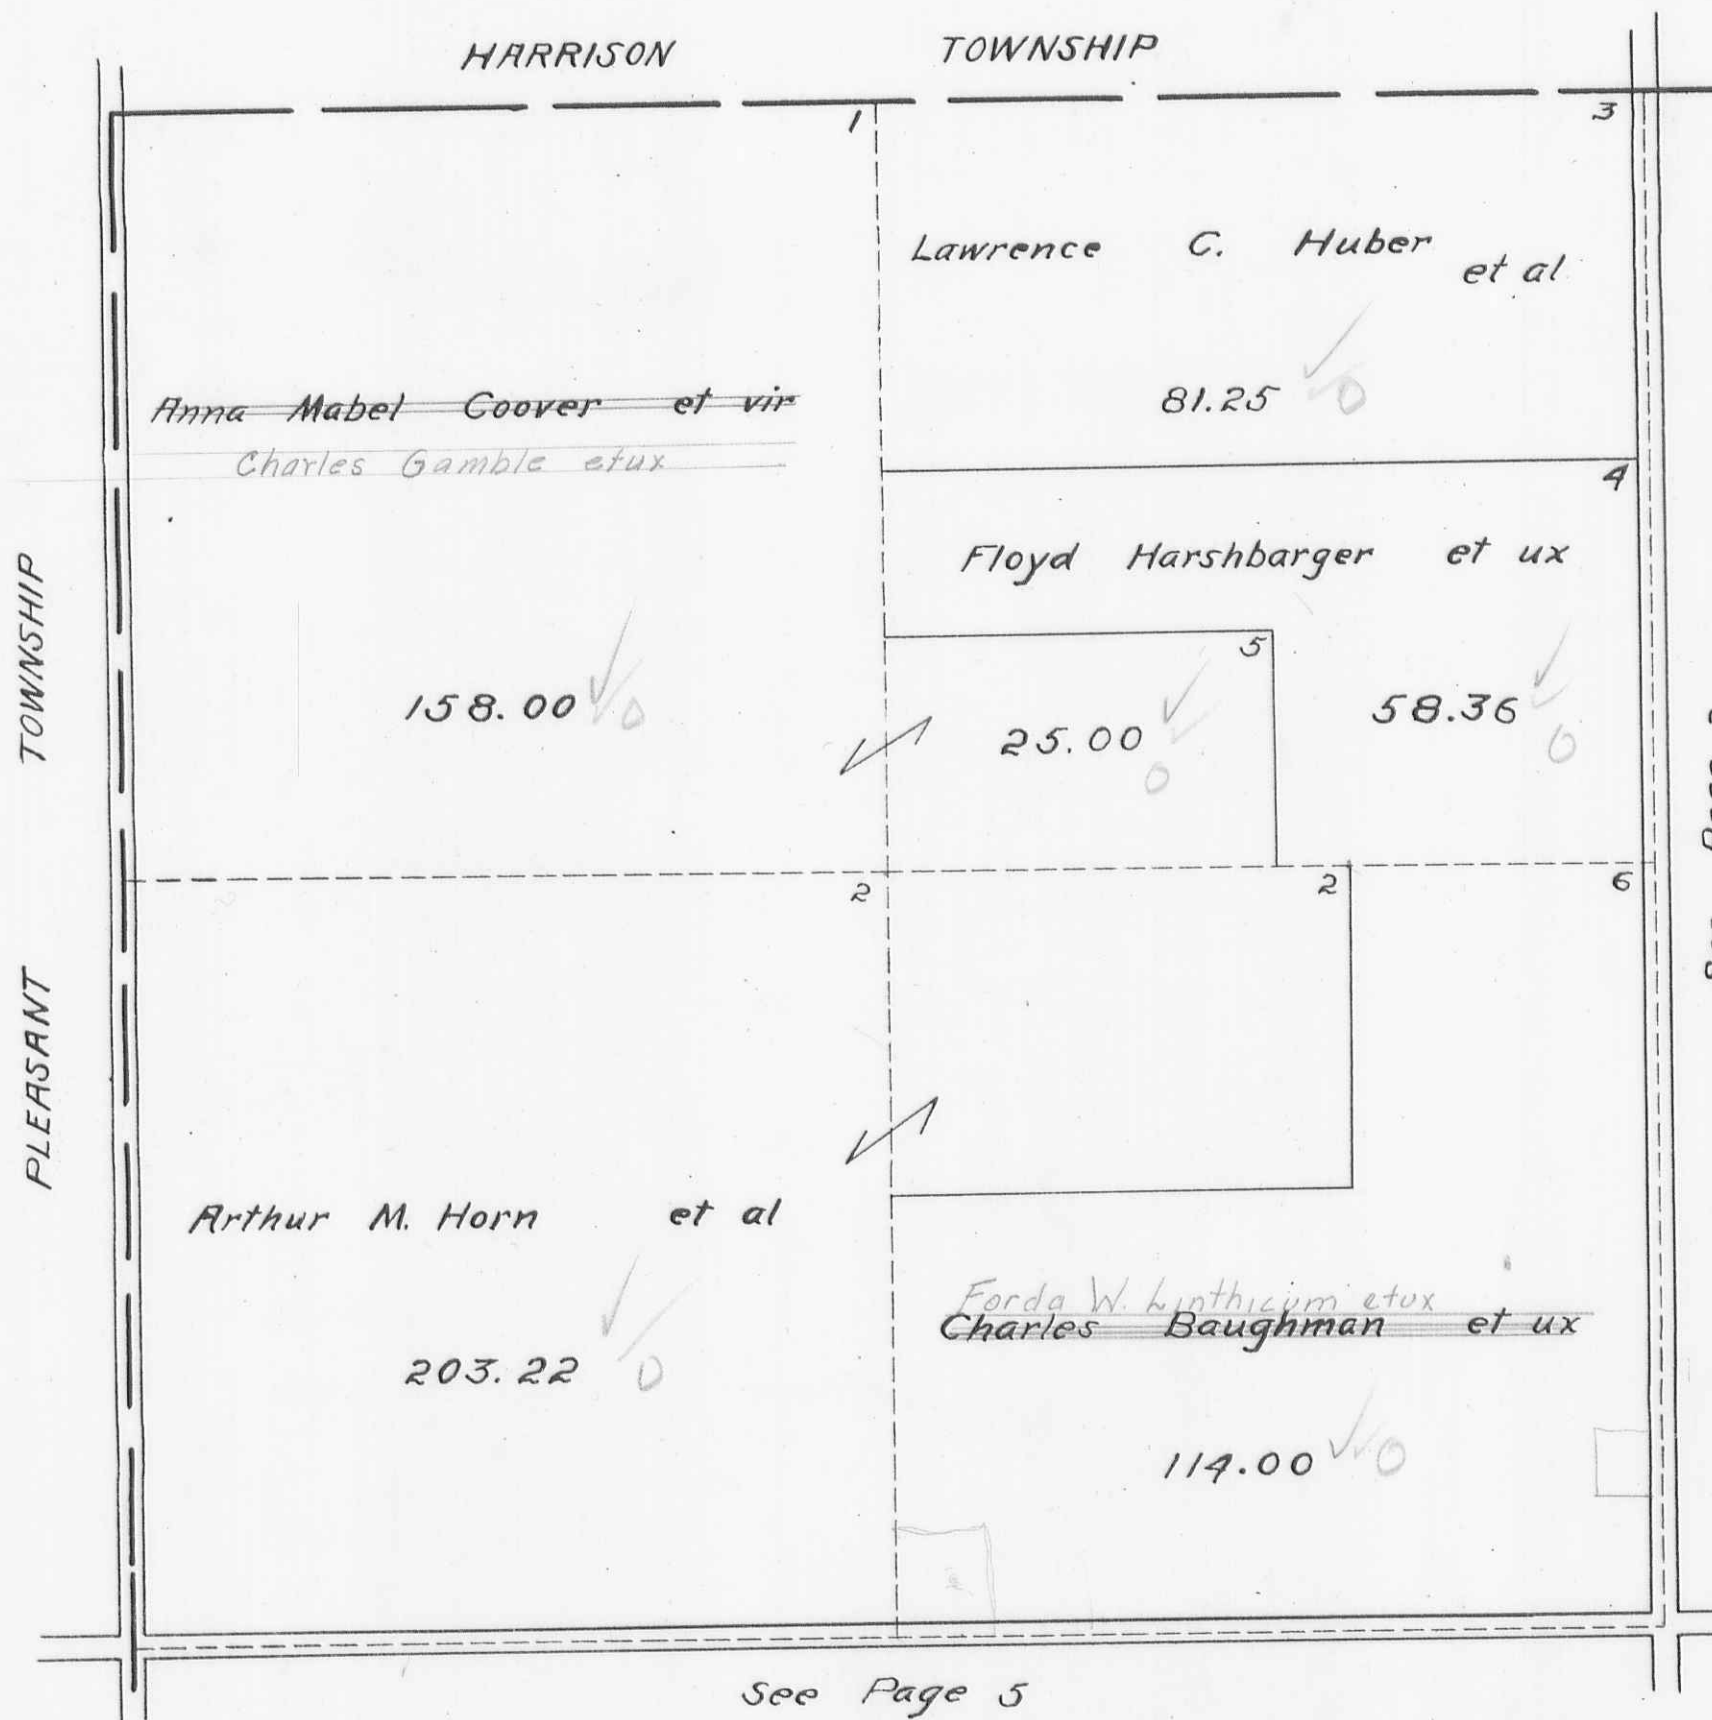


UNION TOWNSHIP
SECTION 20 TOWN 3 RANGE 14

SCALE 10 CHAINS TO THE INCH

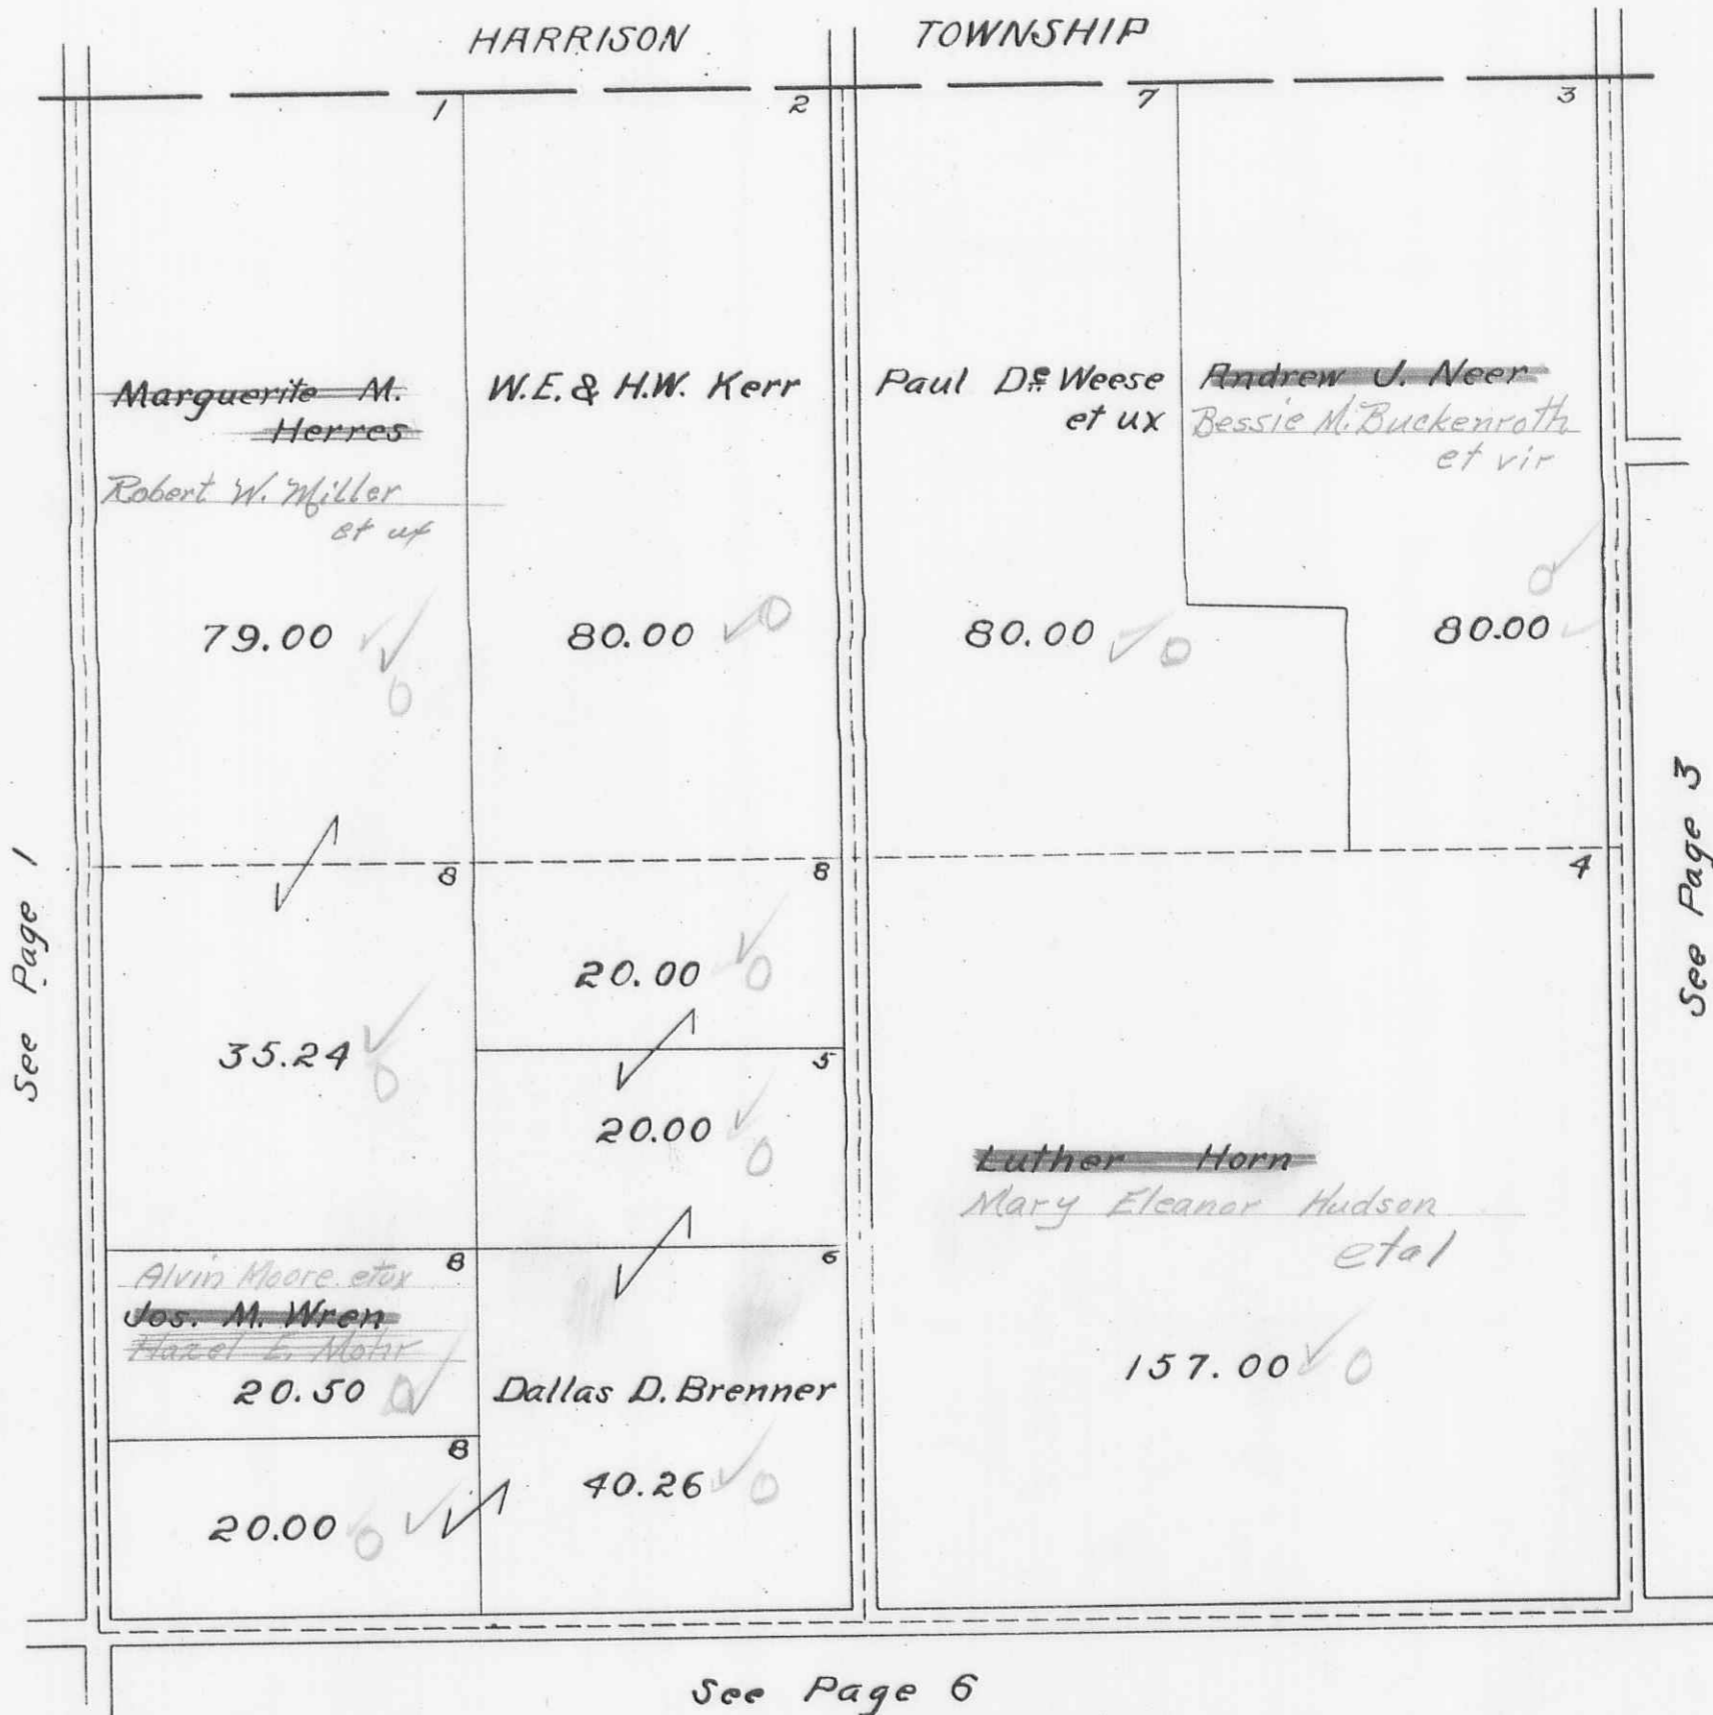

UNION TOWNSHIP
SECTION 14 TOWN 3 RANGE 14

SCALE 10 CHAINS TO THE INCH

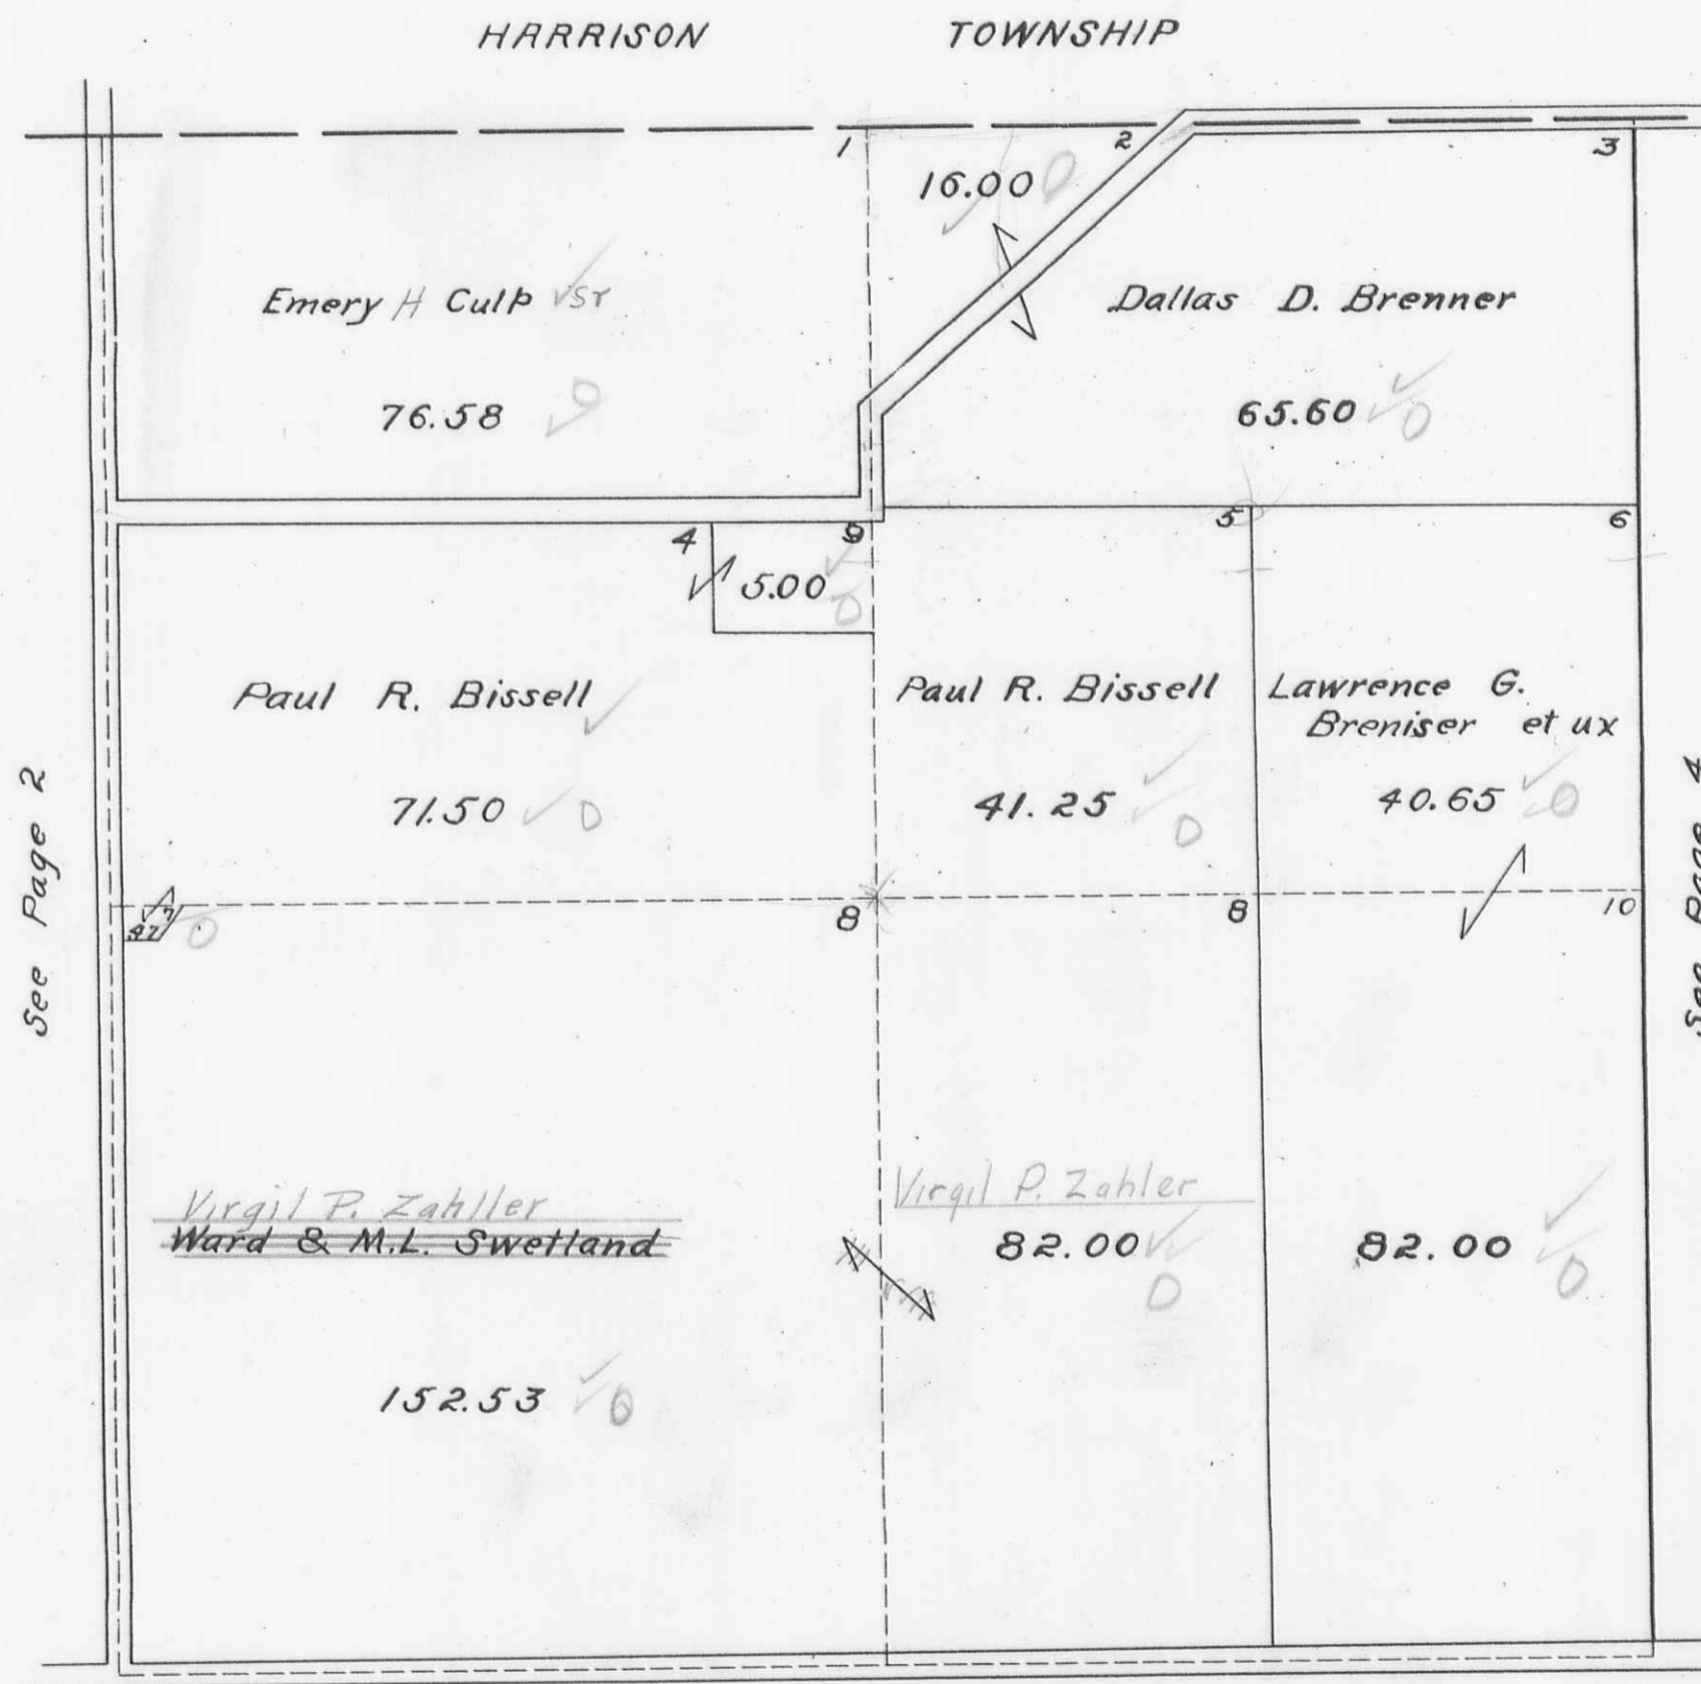

See Page 2

See Page 4

See Page 7


SECTION 8 TOWN 3 RANGE 14

SECTION 2 TOWN 3 RANGE 14

SCALE 10 CHAINS TO THE INCH

HARRISON

TOWNSHIP

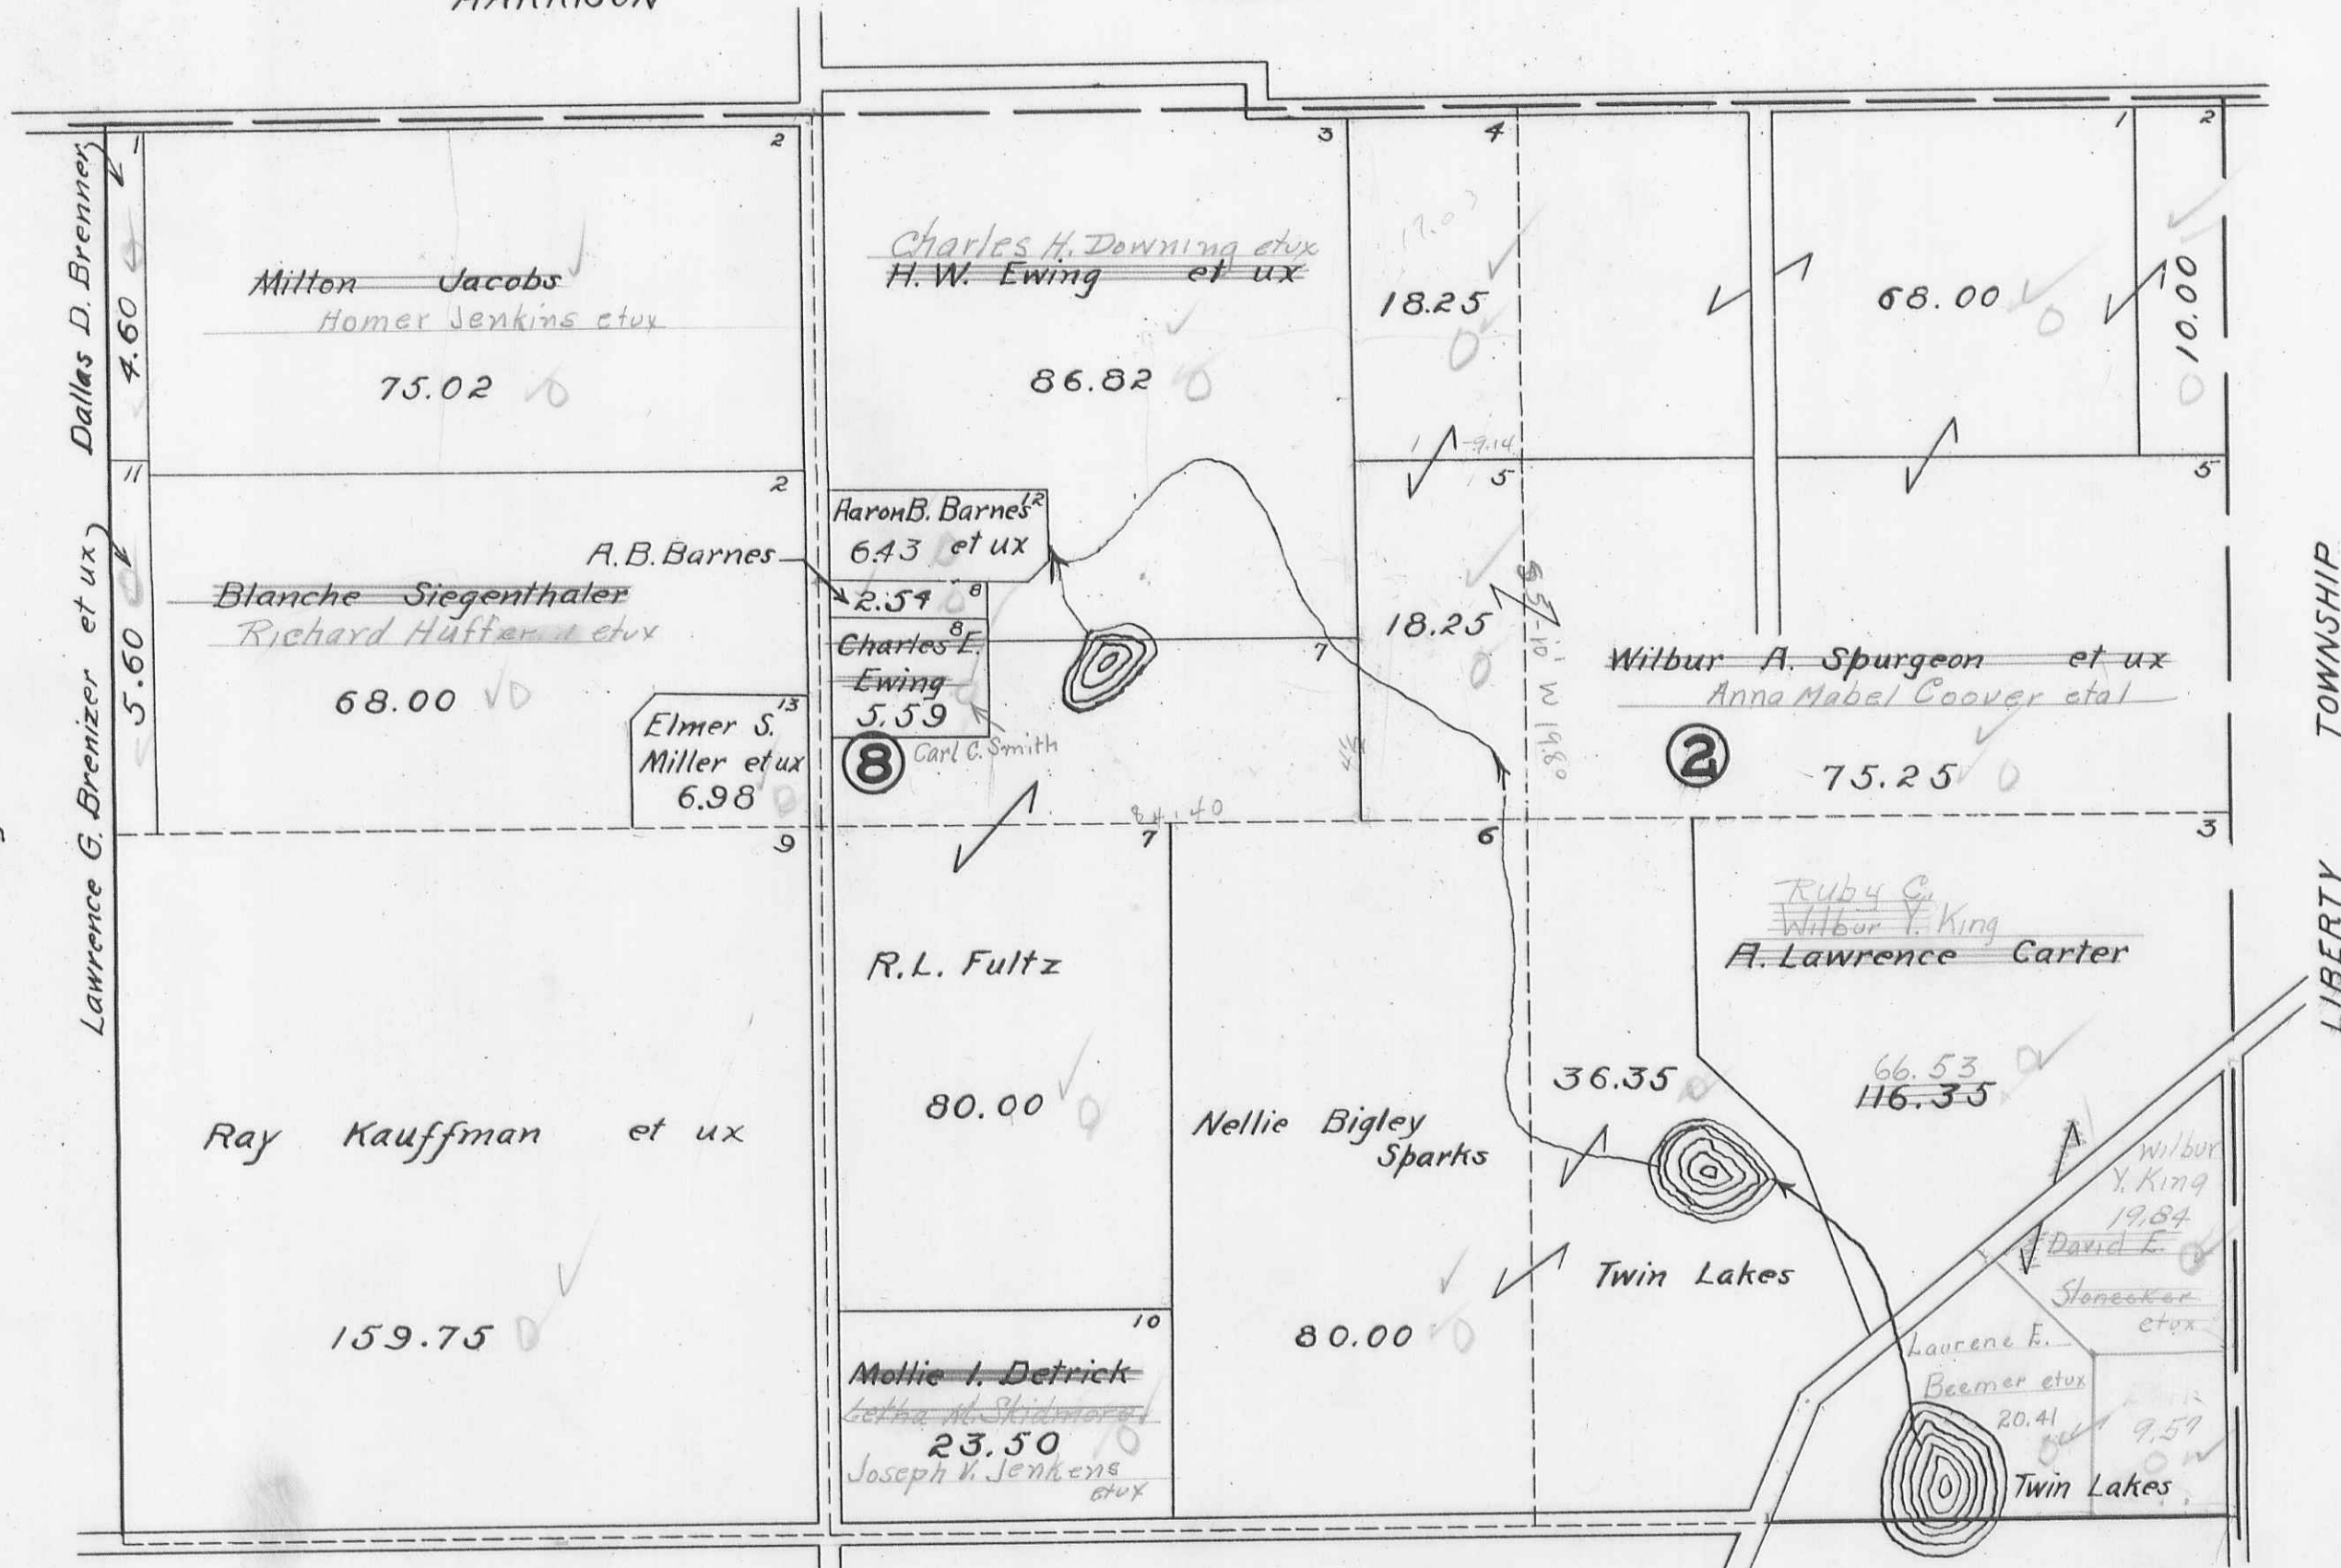

75.25
68.
1825
1825

179.75

See Page 3


See Page 8

2021
1149

3190


UNION TOWNSHIP
SECTION 25 TOWN 3 RANGE 14

SCALE 10 CHAINS TO THE INCH

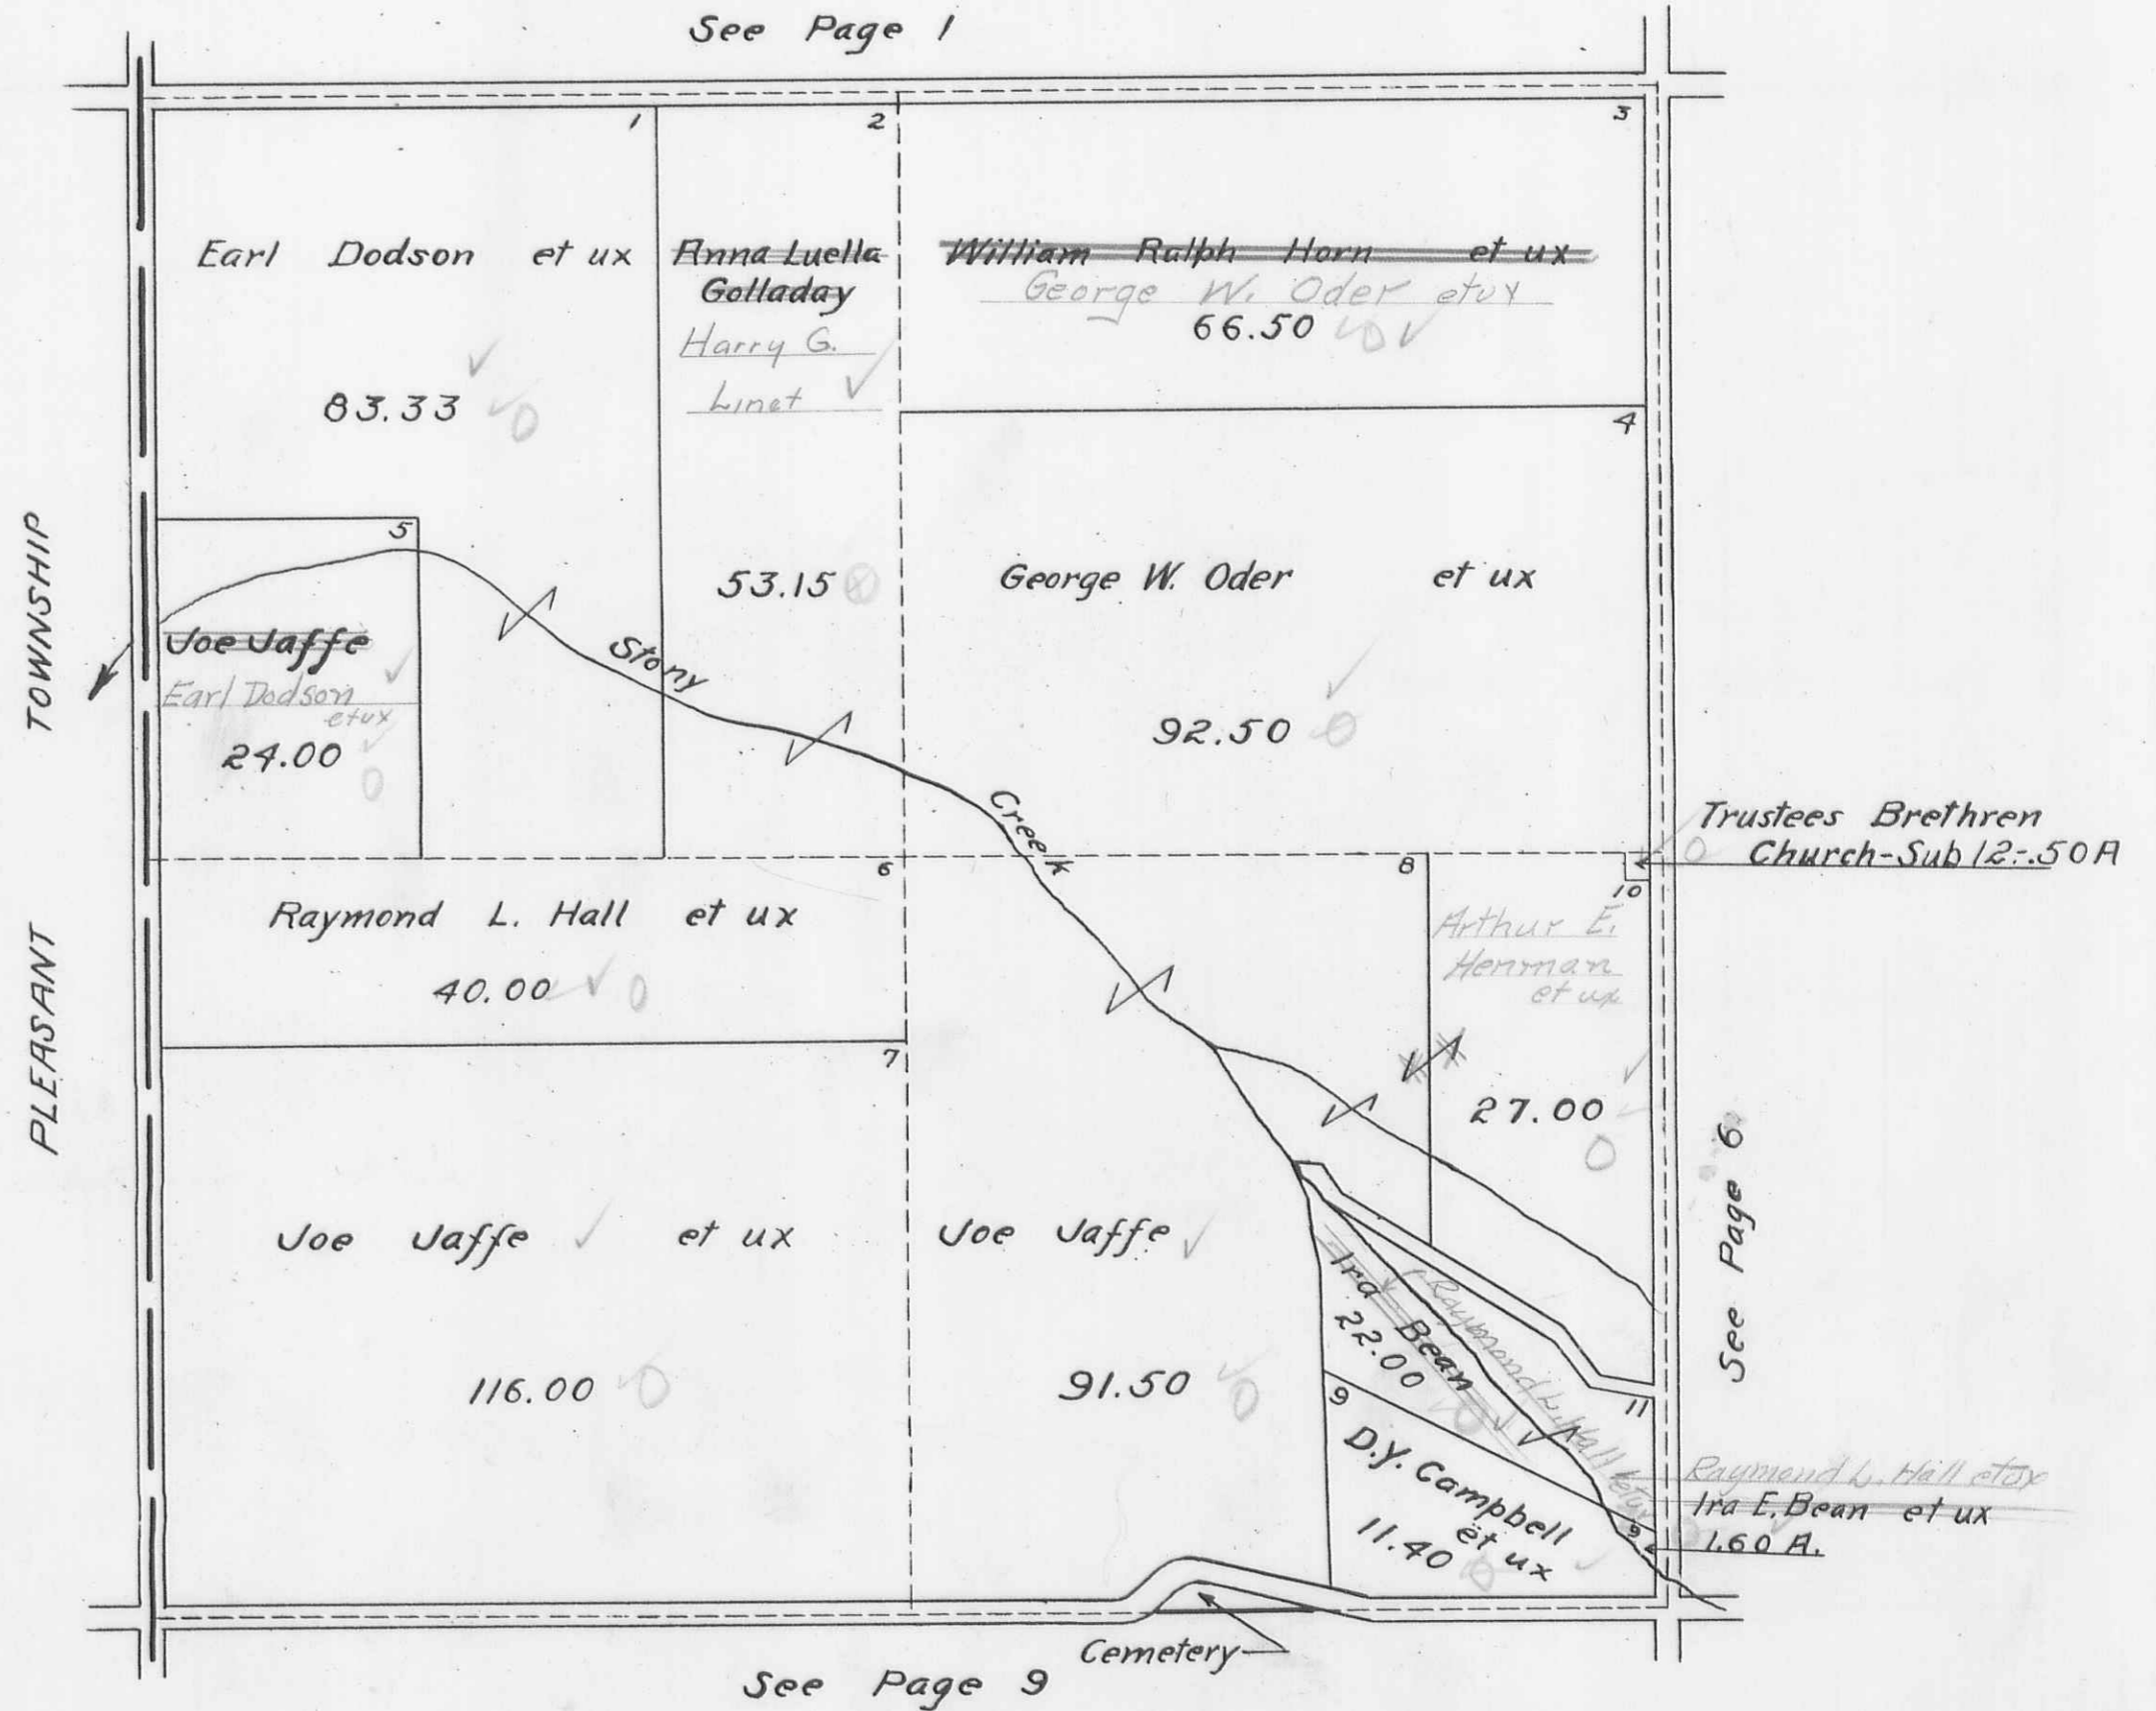

UNION TOWNSHIP
SECTION 19 TOWN 3 RANGE 14


SCALE 10 CHAINS TO THE INCH

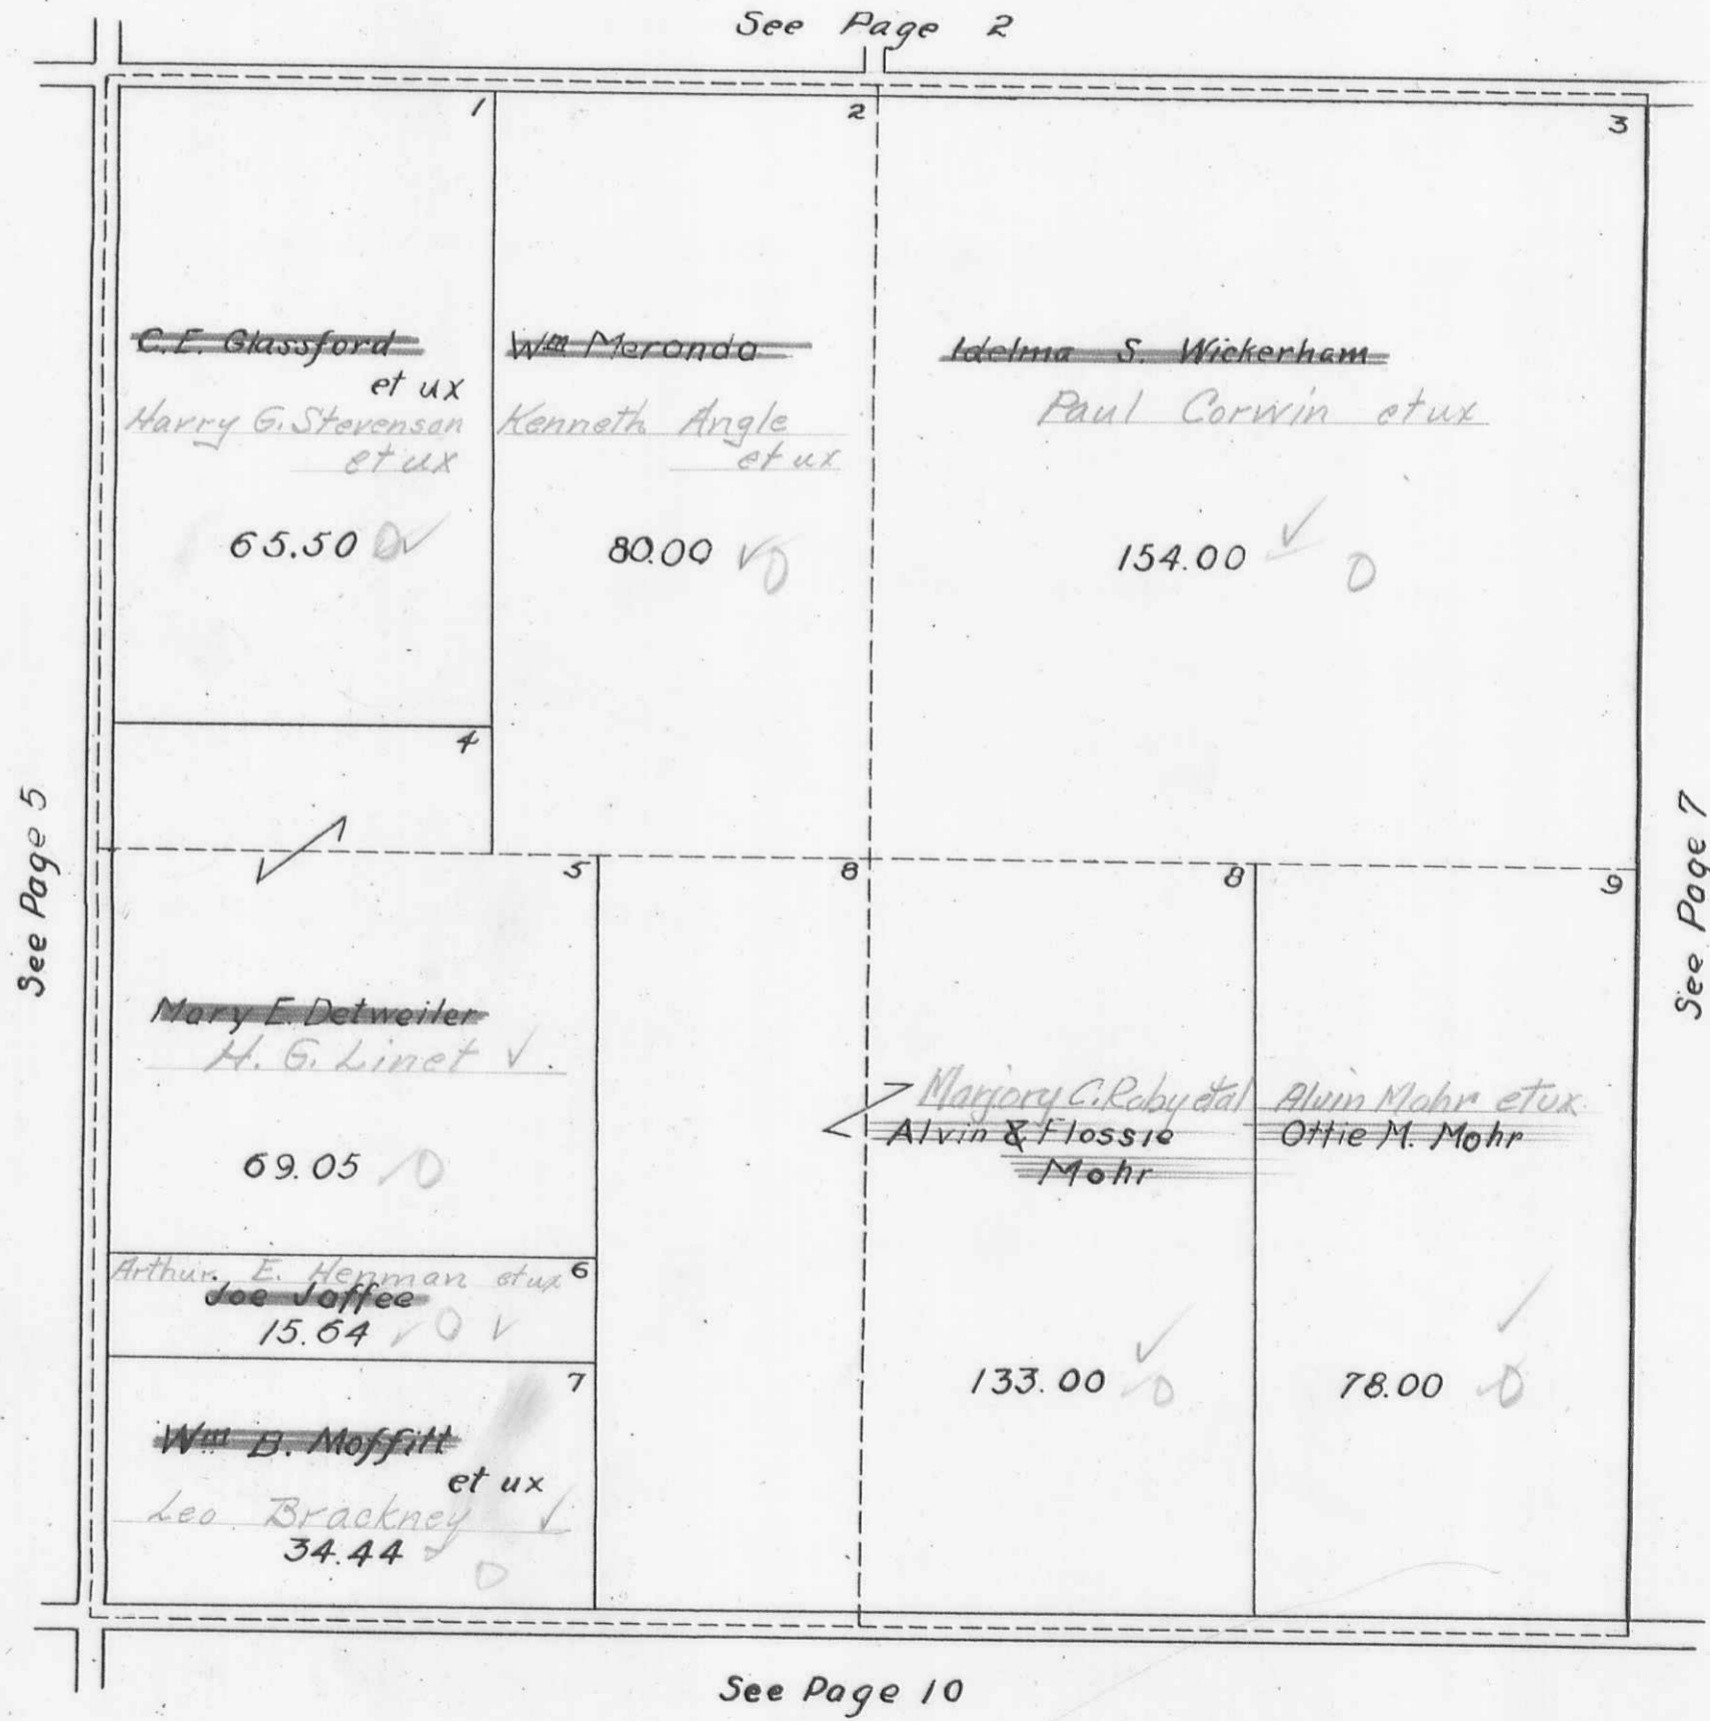

UNION TOWNSHIP
SECTION 13 TOWN 3 RANGE 14

SCALE 10 CHAINS TO THE INCH

See Page 3

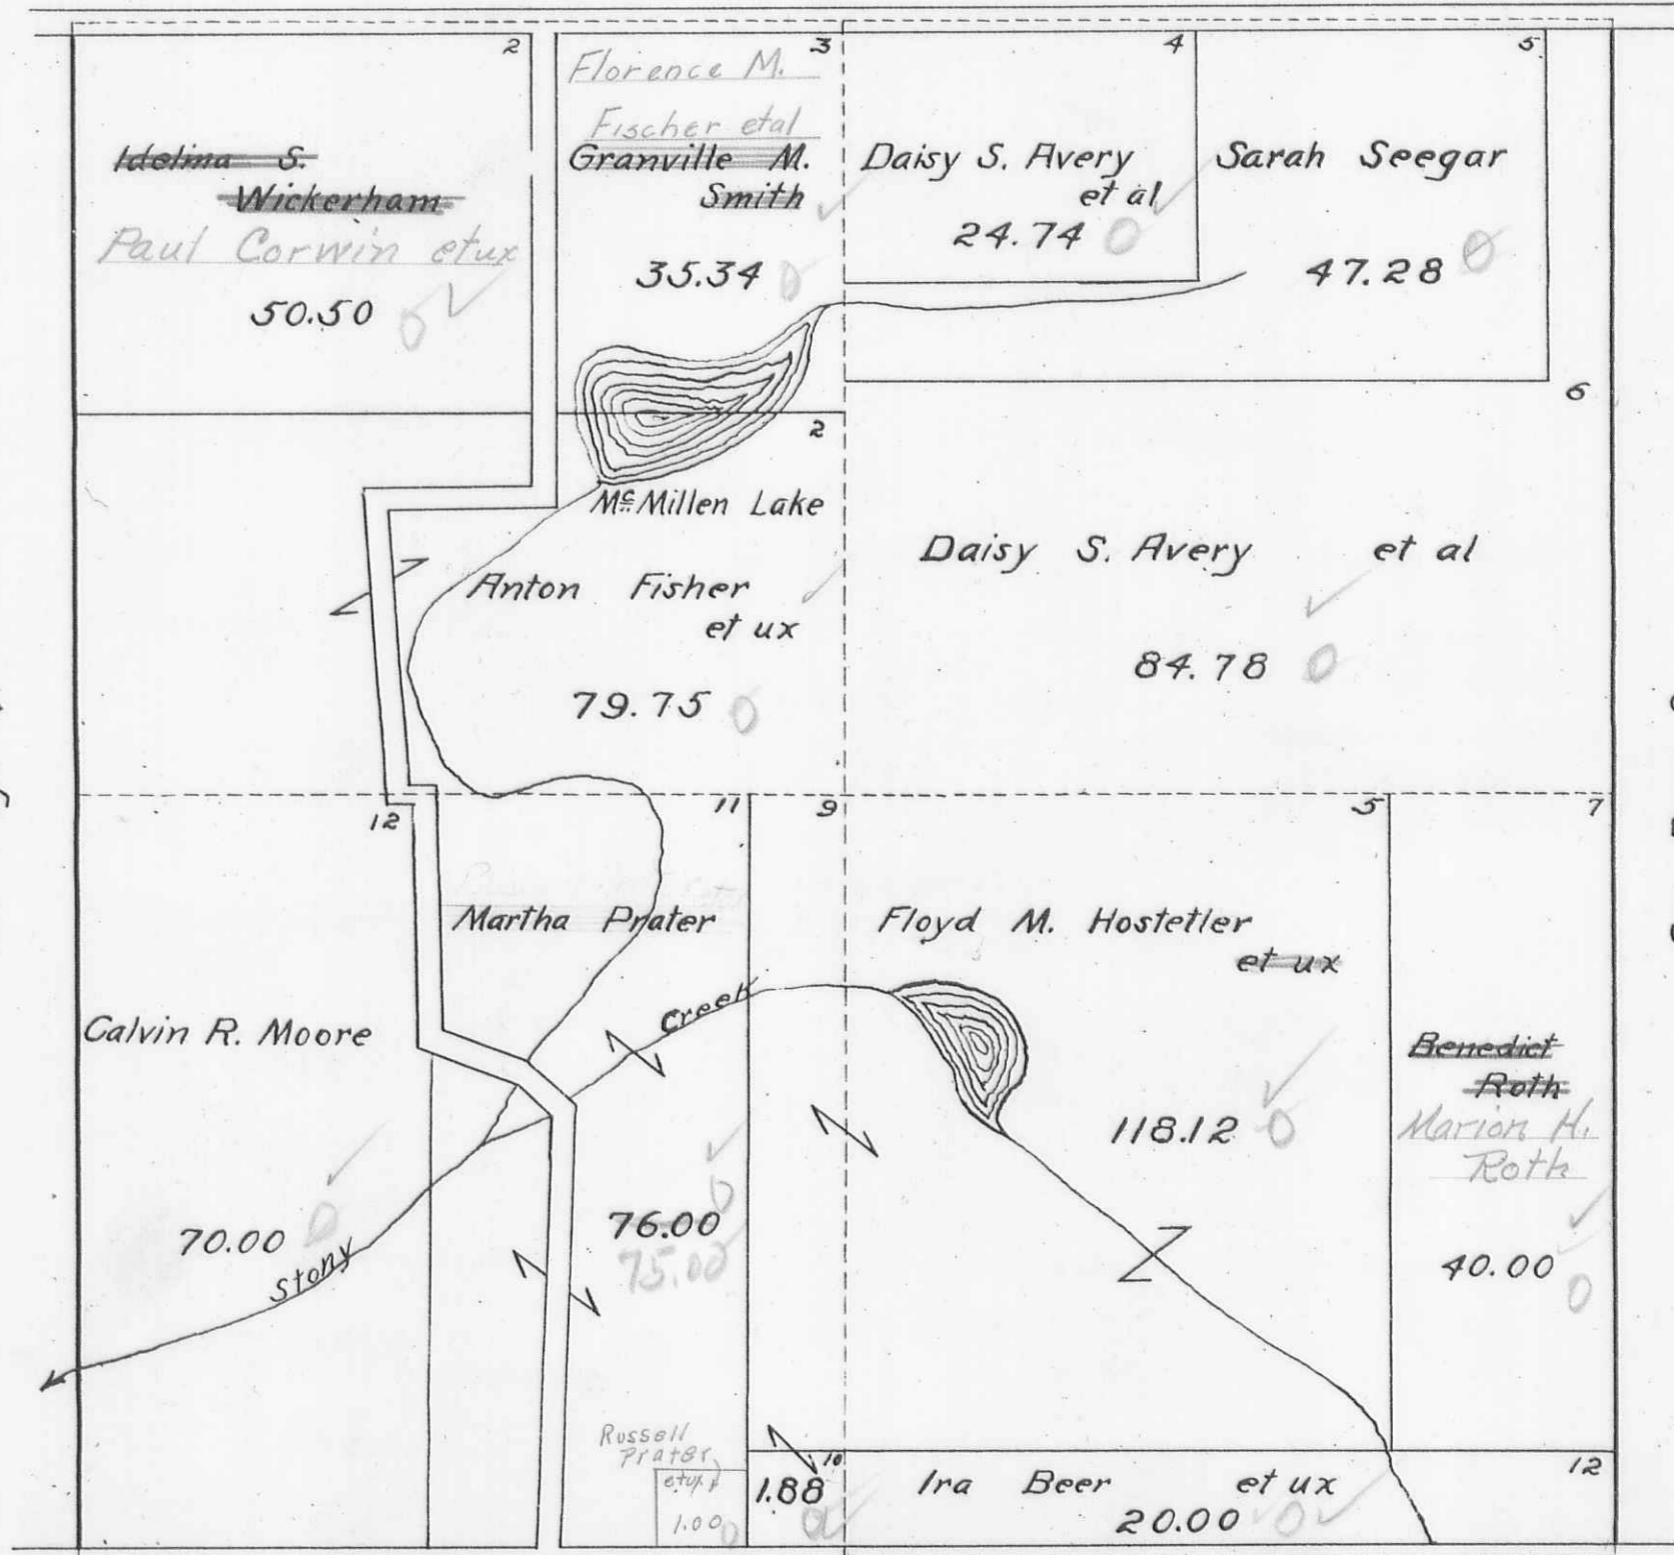

See Page 6.

See Page 8


See Page 11

208
 43560.00
 3264
 4167
 29600
 79169
 41744 43100

SECTION 7 TOWN 3 RANGE 14

SECTION 1 TOWN 3 RANGE 14

SCALE 10 CHAINS TO THE INCH

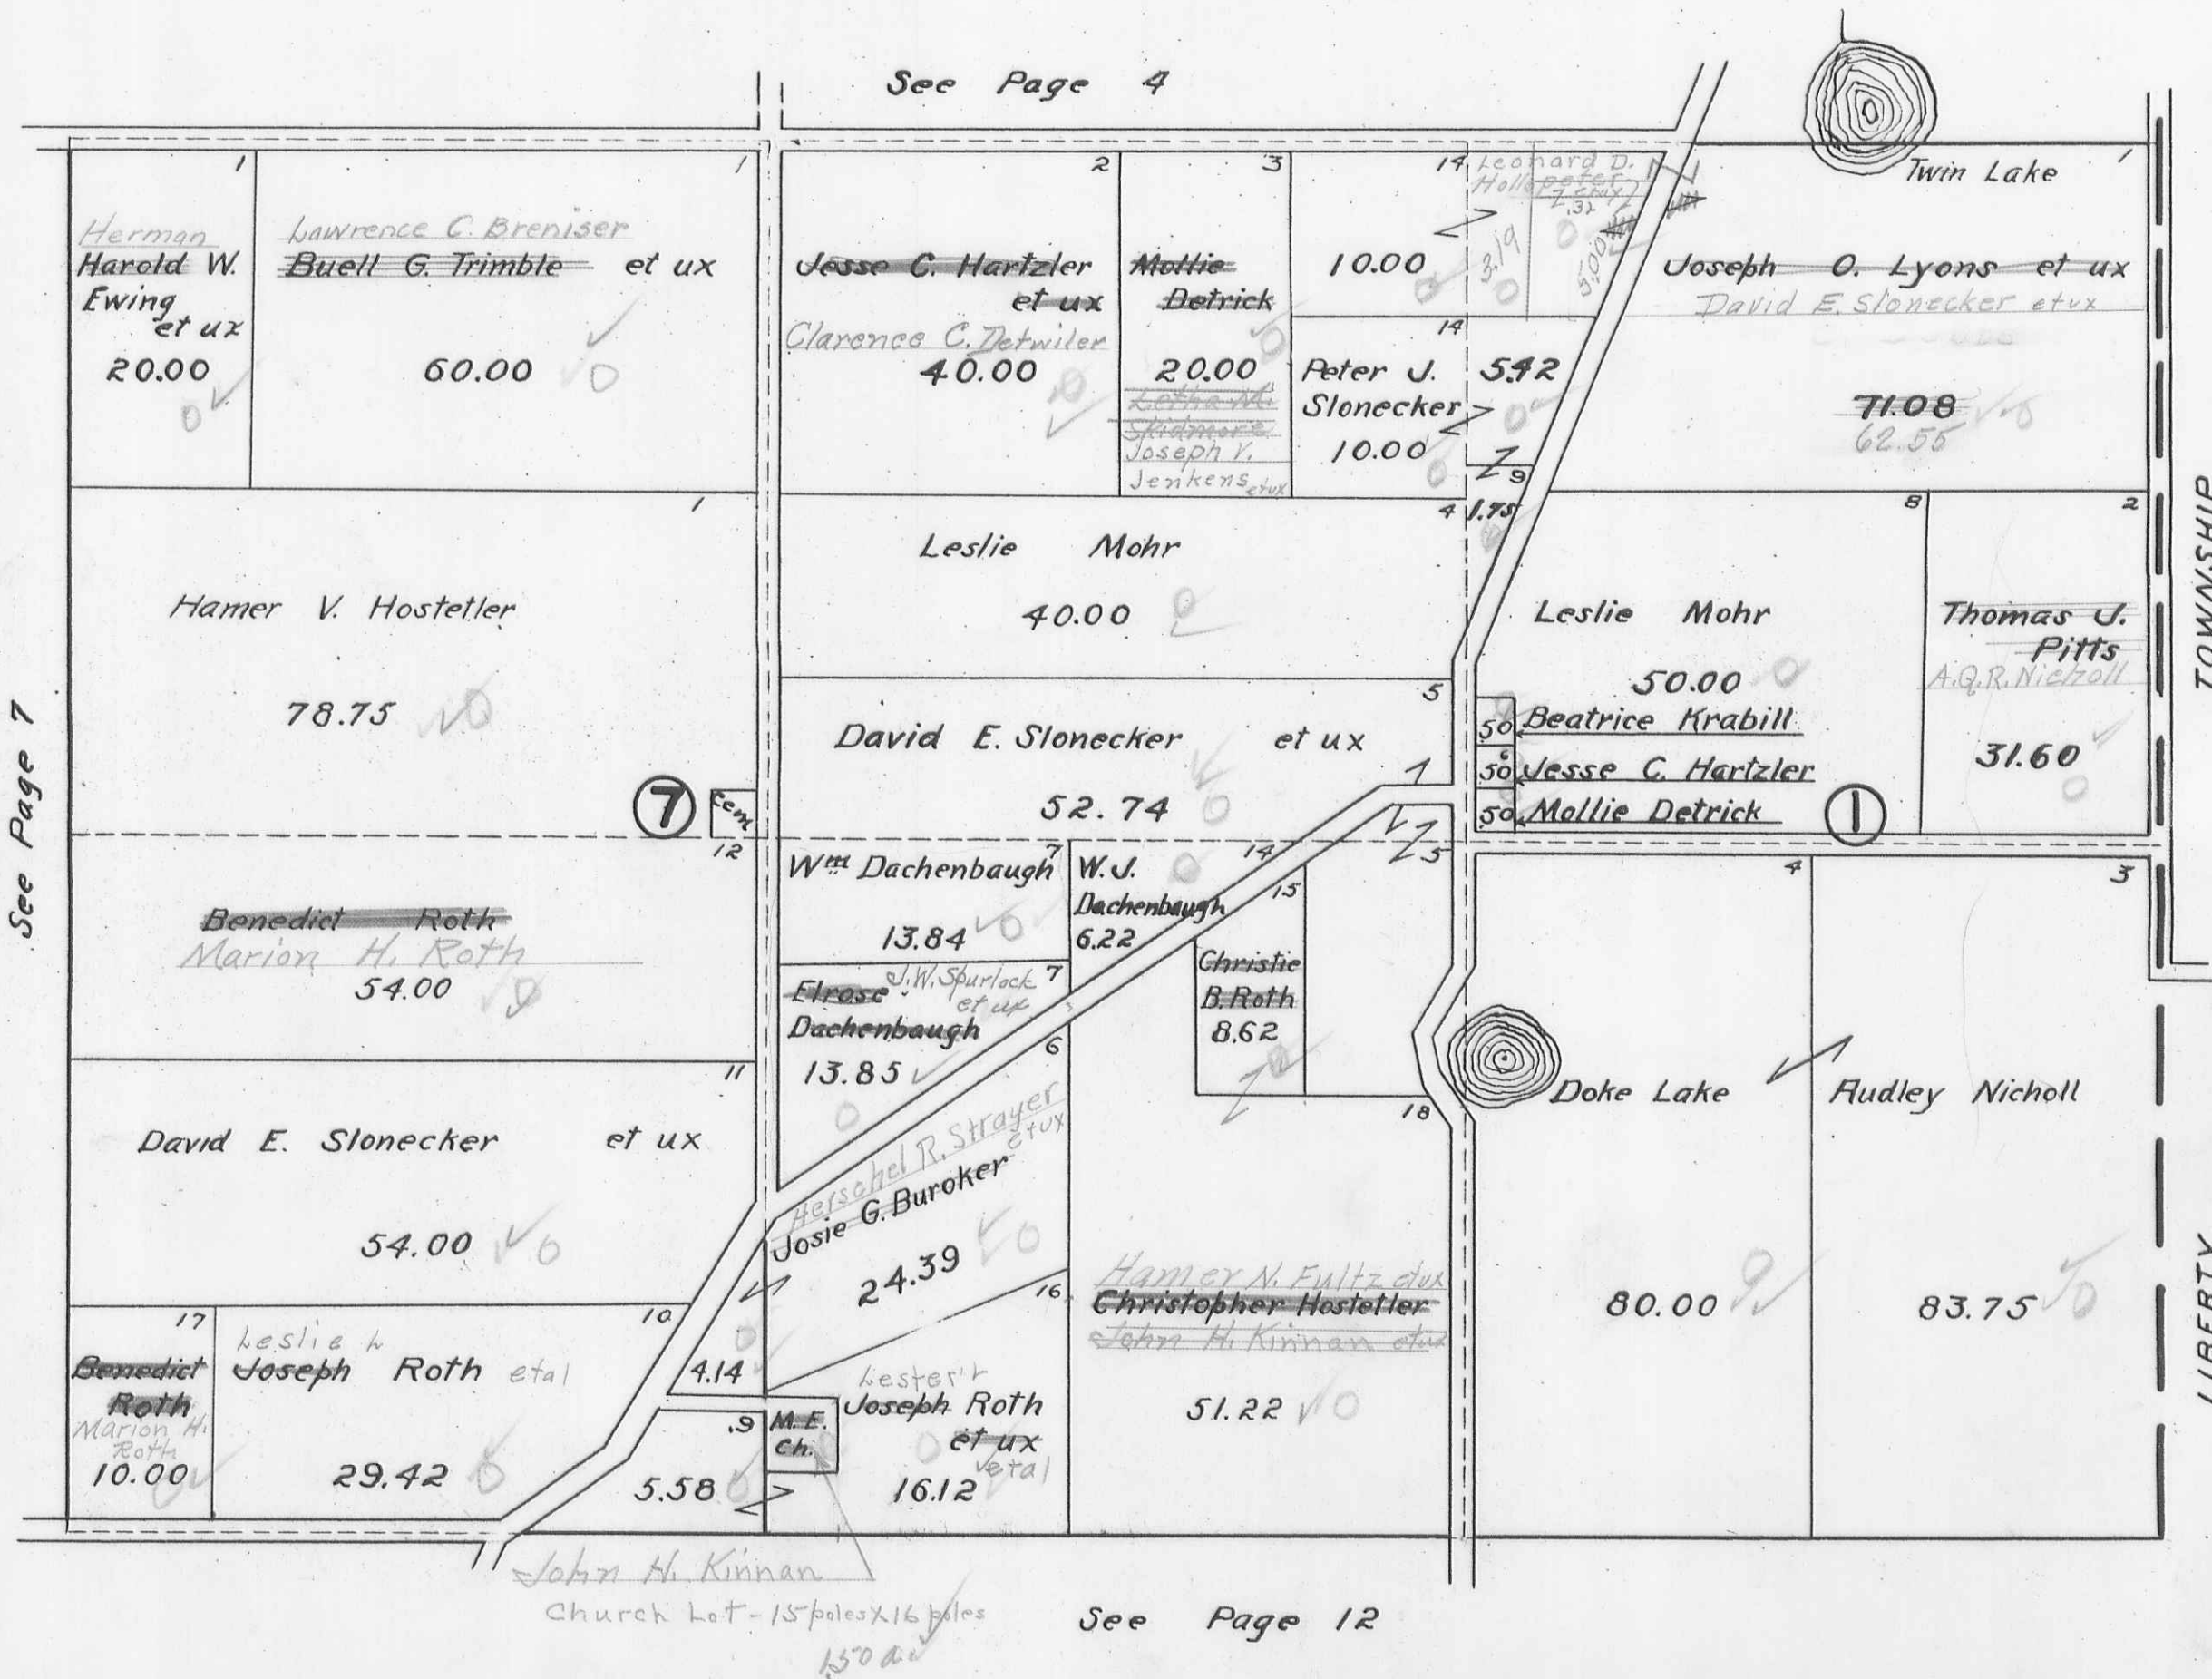

See Page 7


See Page 4

See Page 12

Church Lot - 15 poles x 16 poles


UNION TOWNSHIP
SECTION 30 TOWN 4 RANGE 13

SCALE 10 CHAINS TO THE INCH

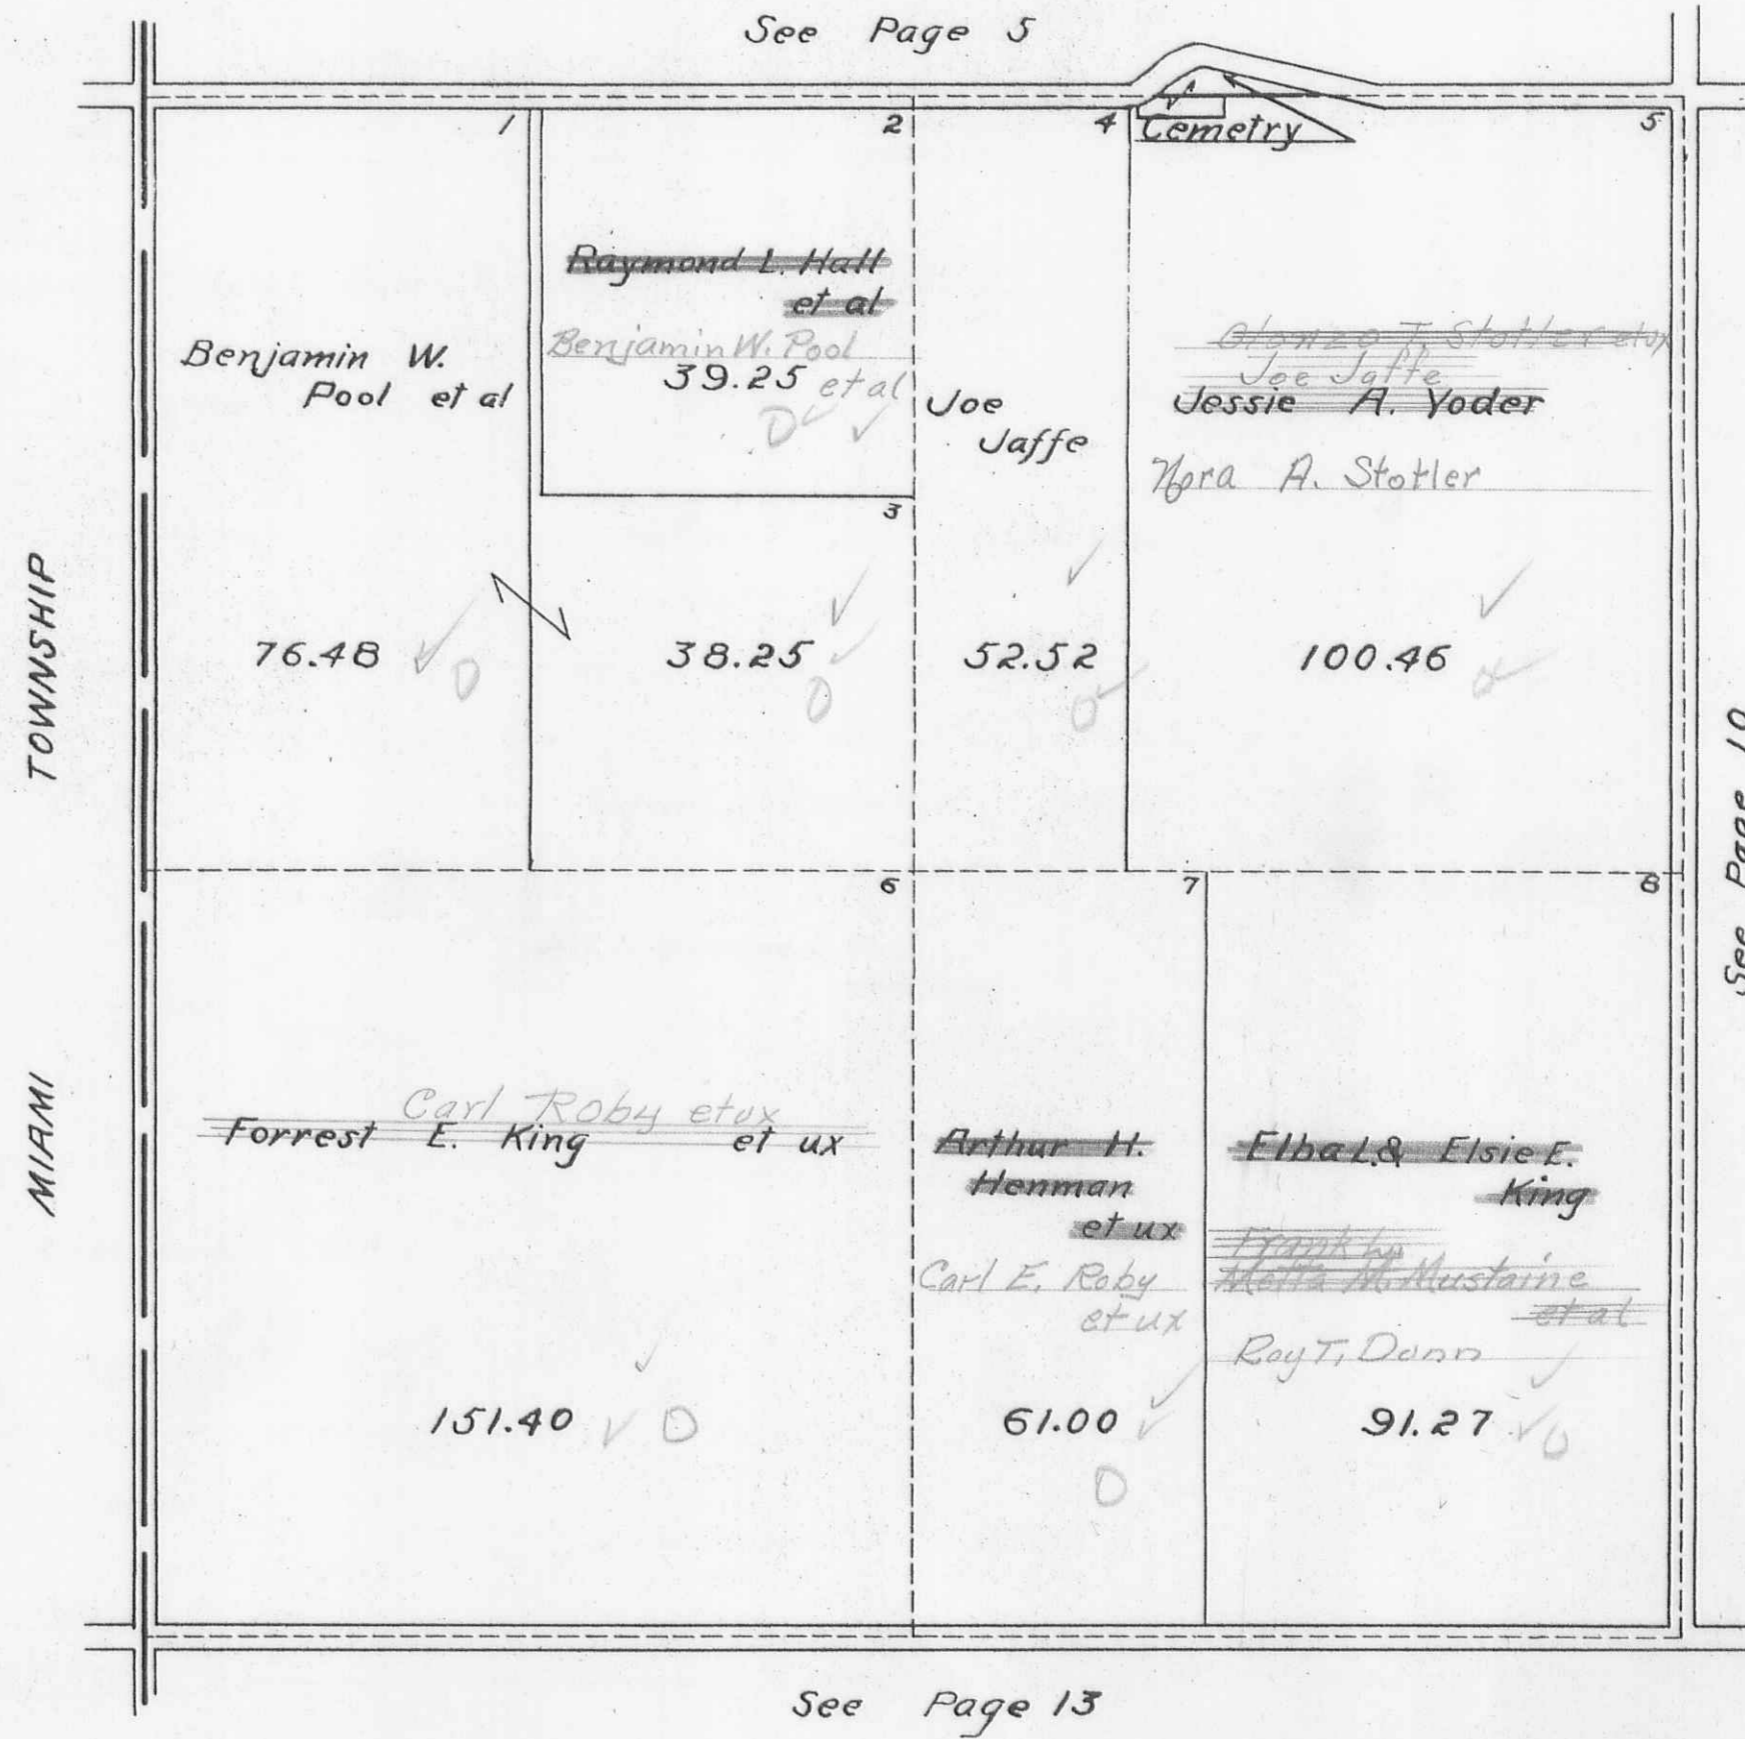

UNION TOWNSHIP
SECTION 24 TOWN 4 RANGE 13


SCALE 10 CHAINS TO THE INCH

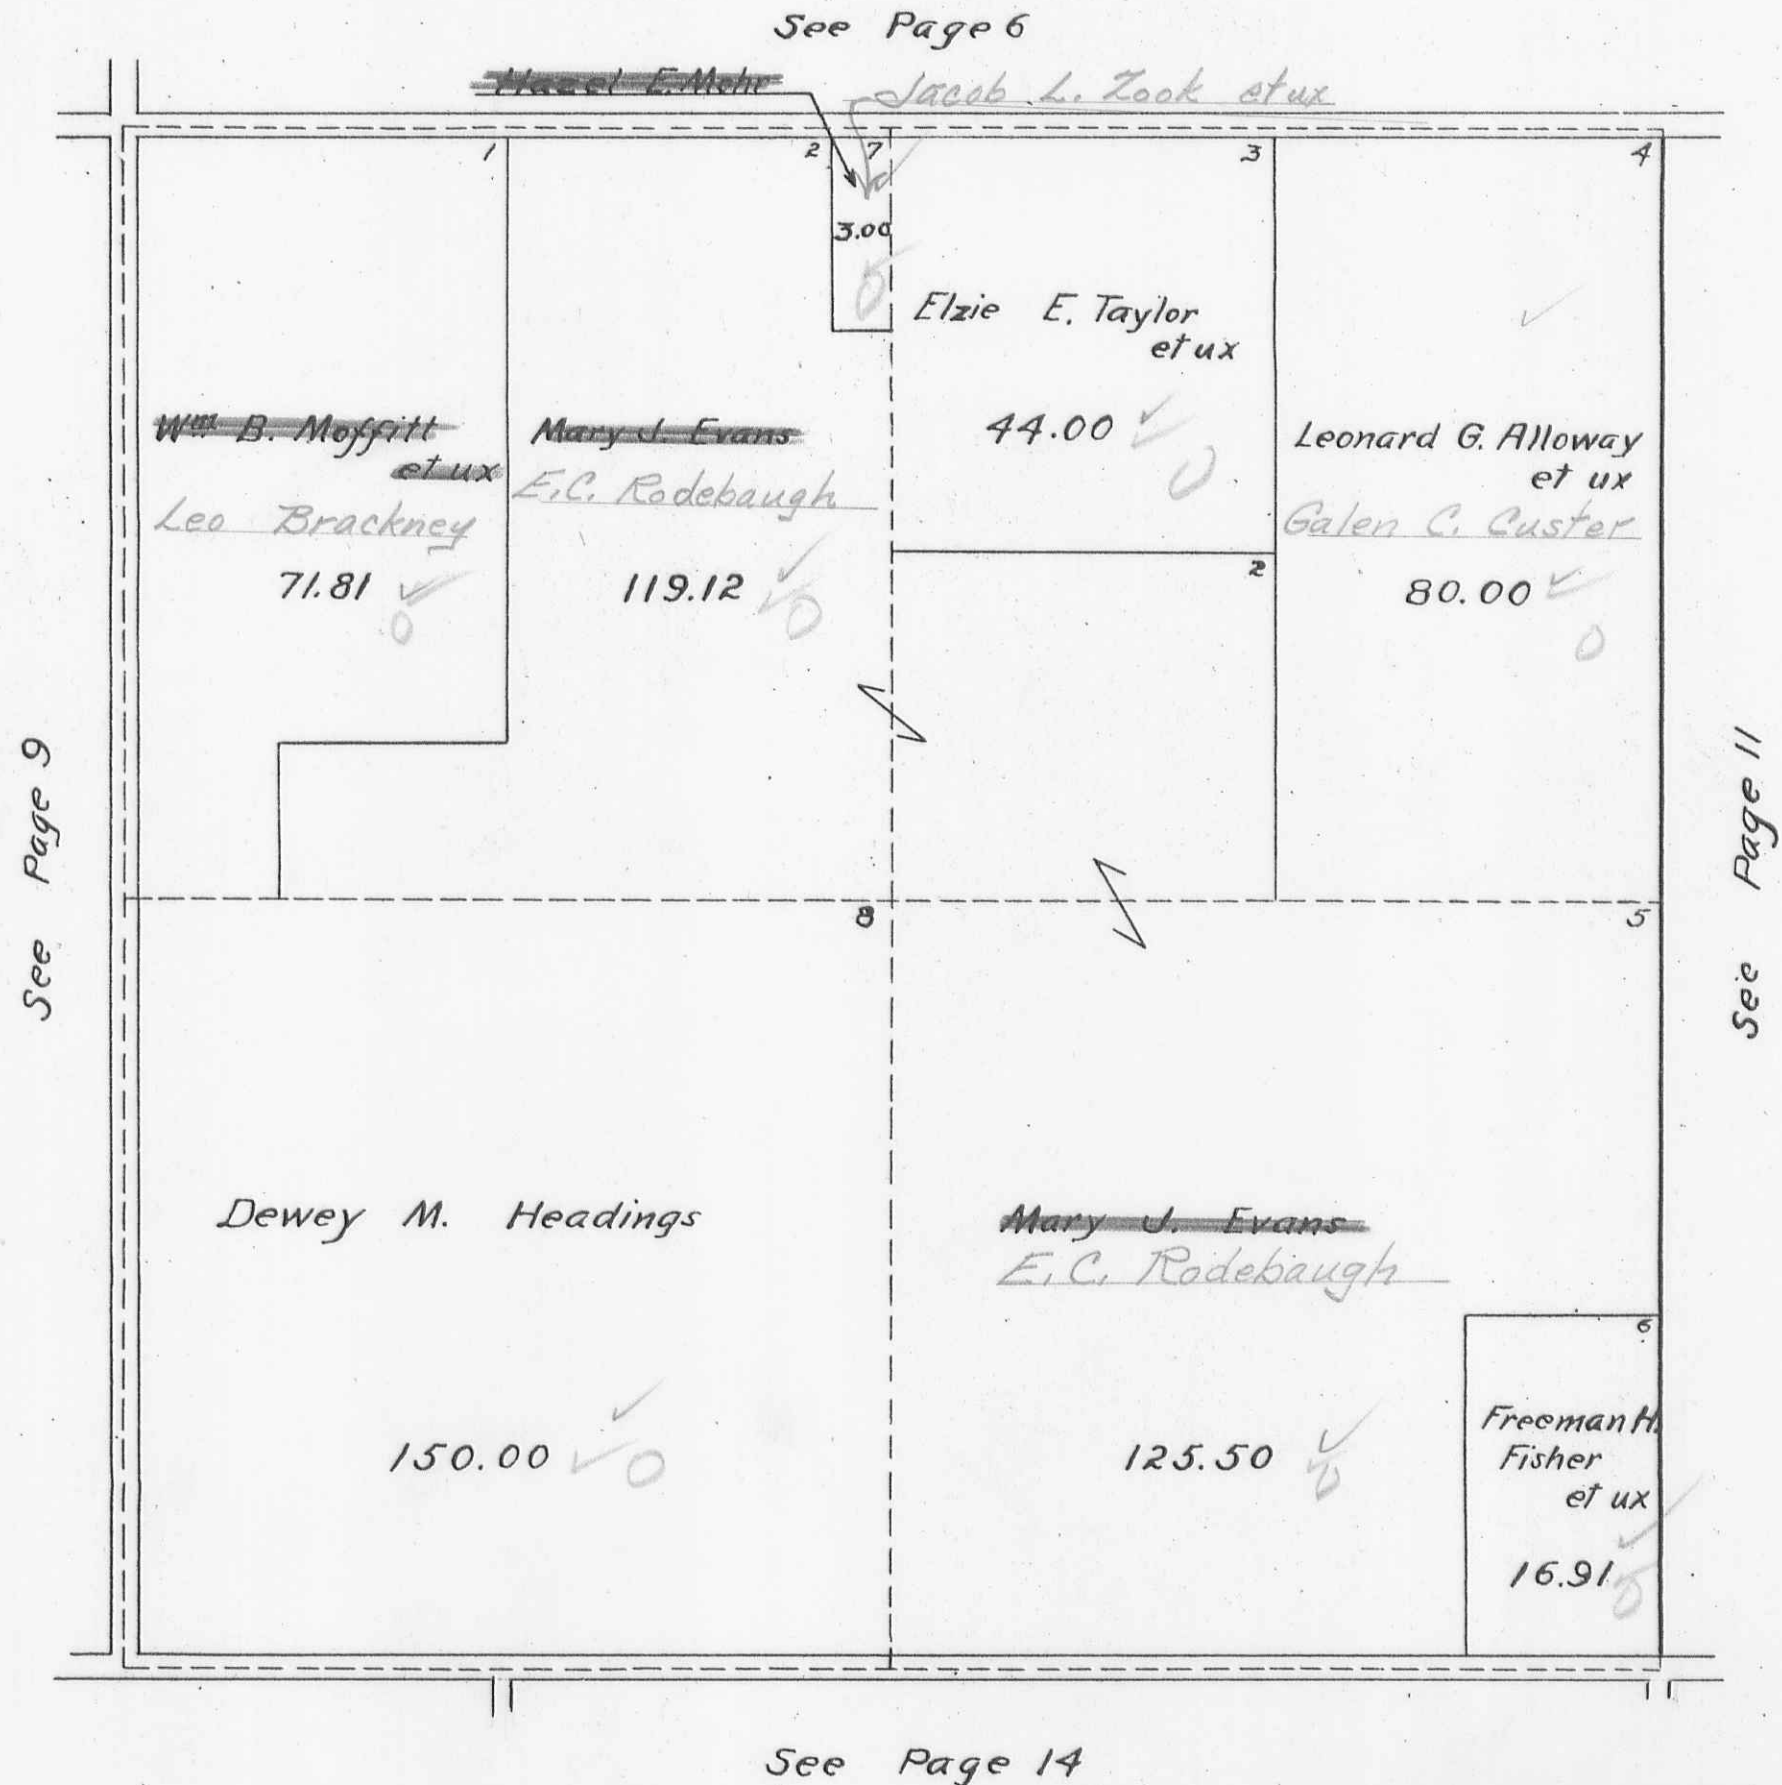

UNION TOWNSHIP
SECTION 18 TOWN 4 RANGE 13

SCALE 10 CHAINS TO THE INCH


See Page 7

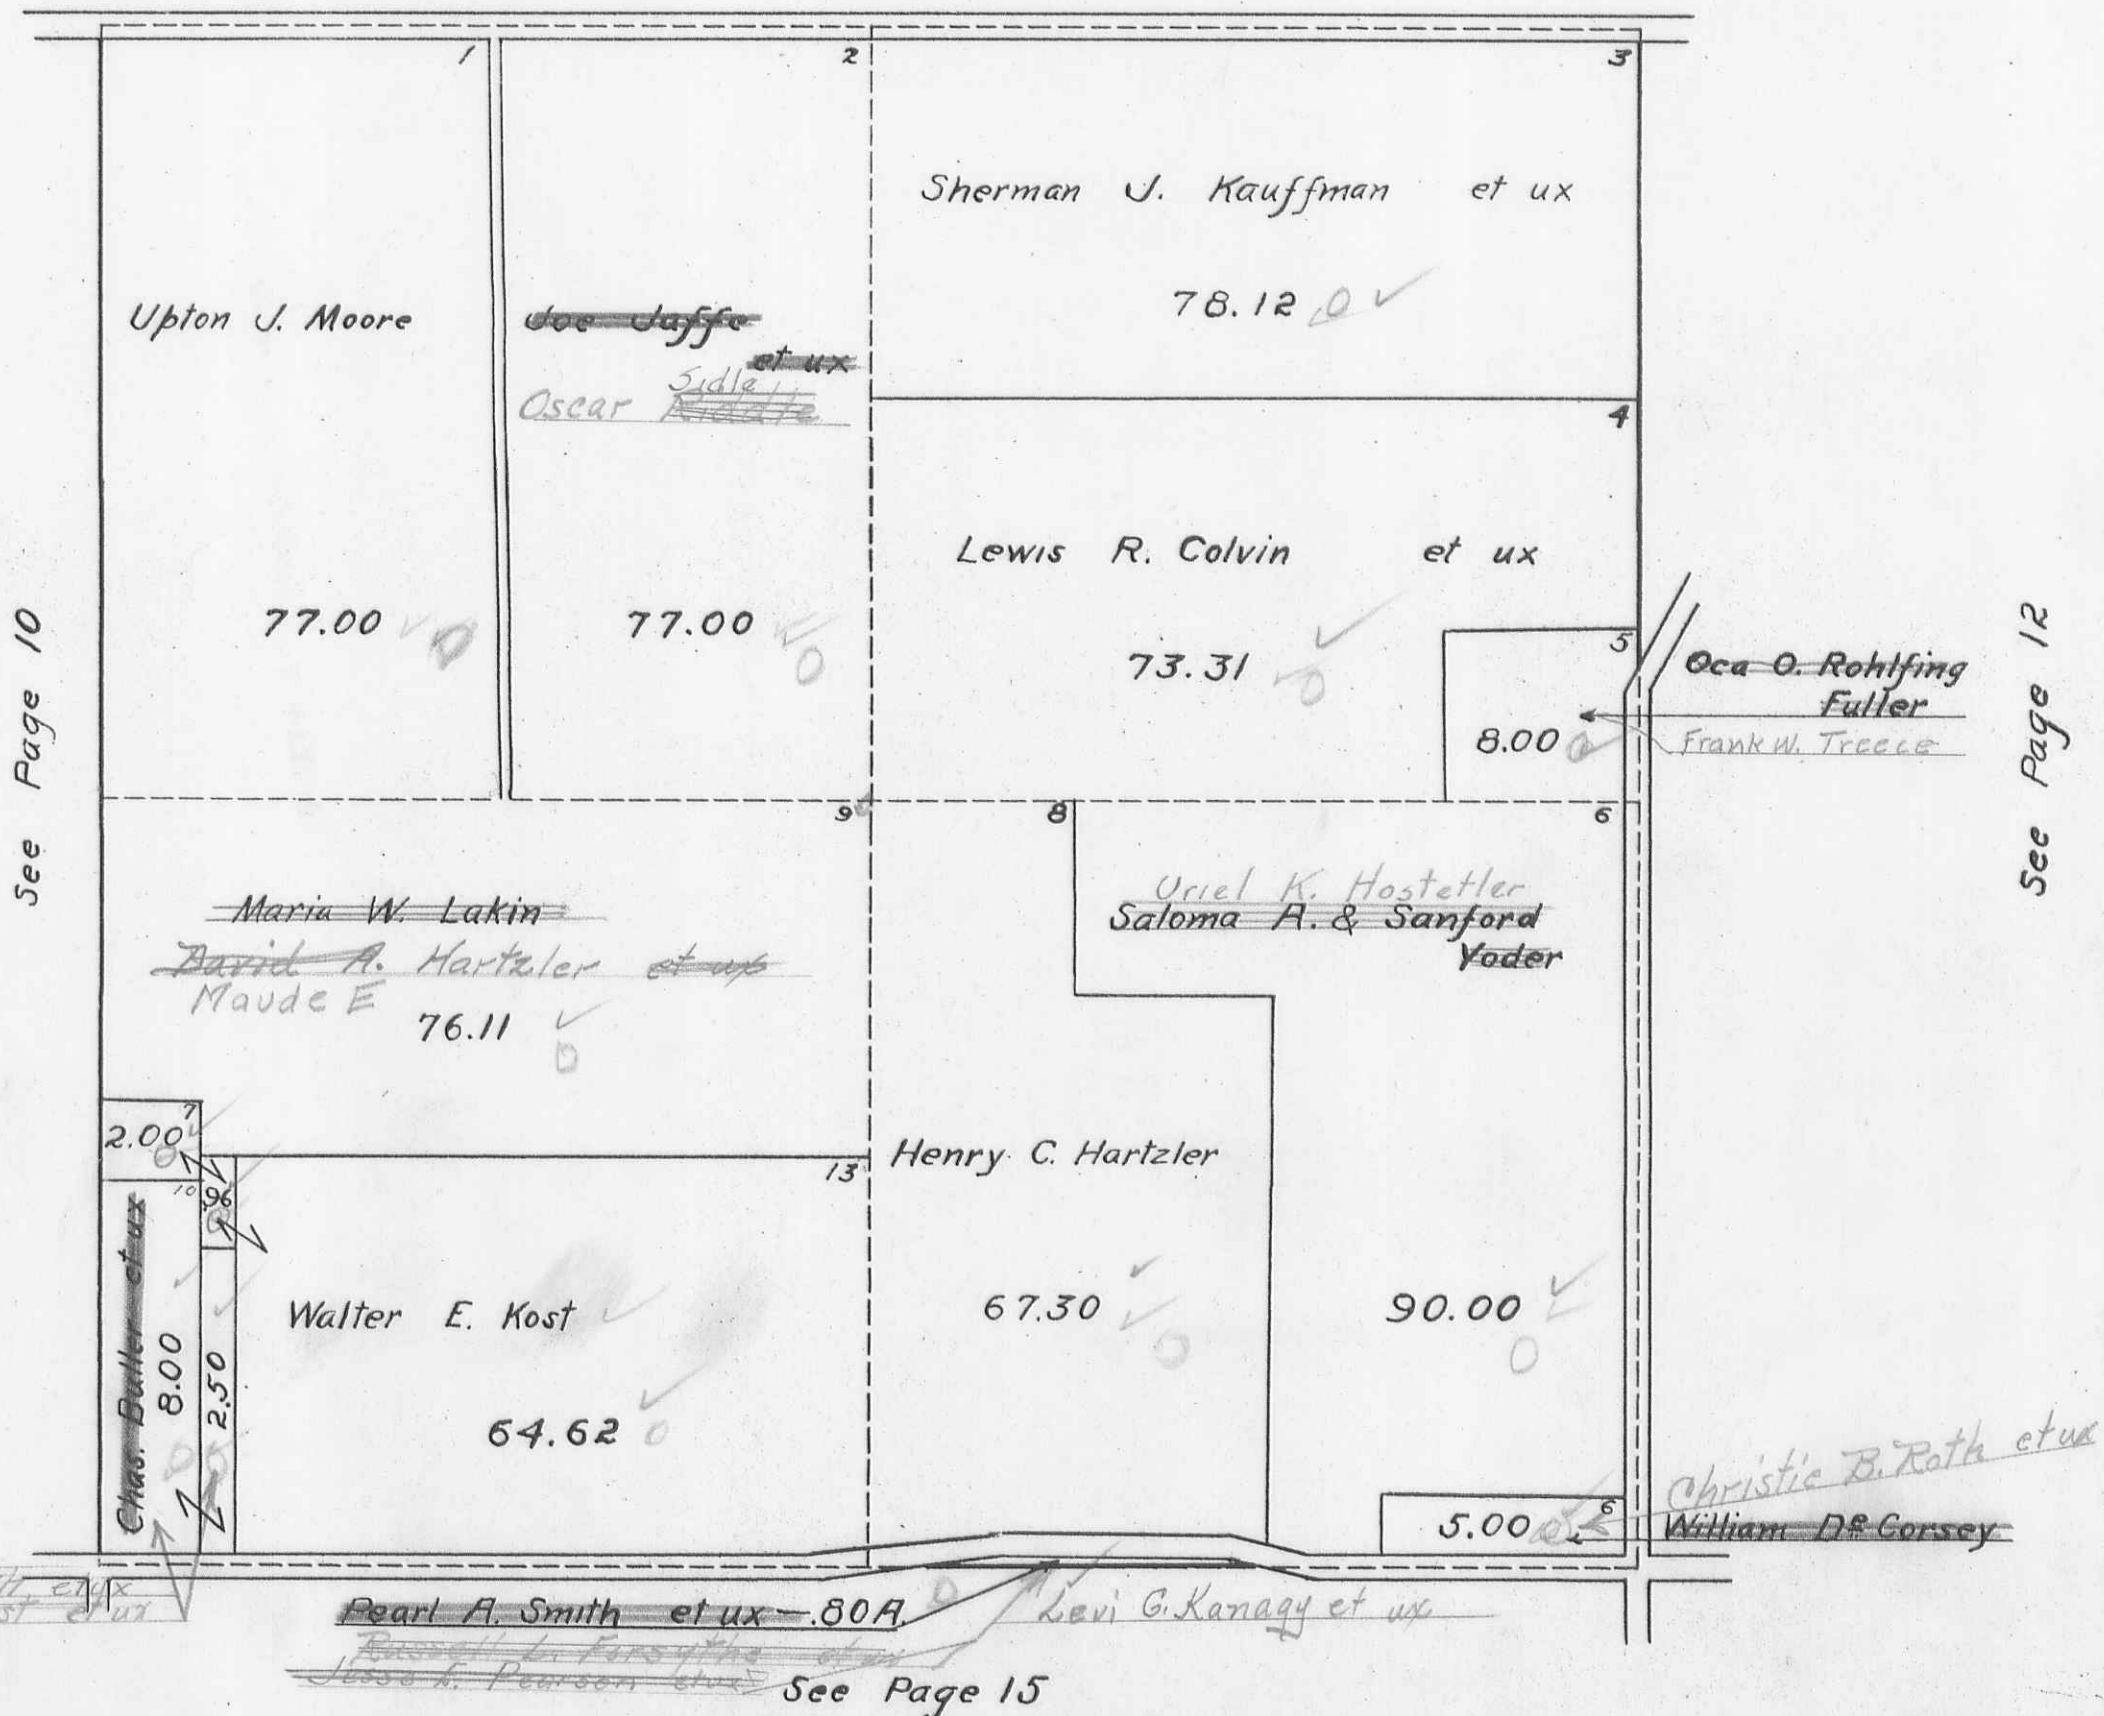

SECTION 12 TOWN 4 RANGE 13


SECTION 6 TOWN 4 RANGE 13

SCALE 10 CHAINS TO THE INCH

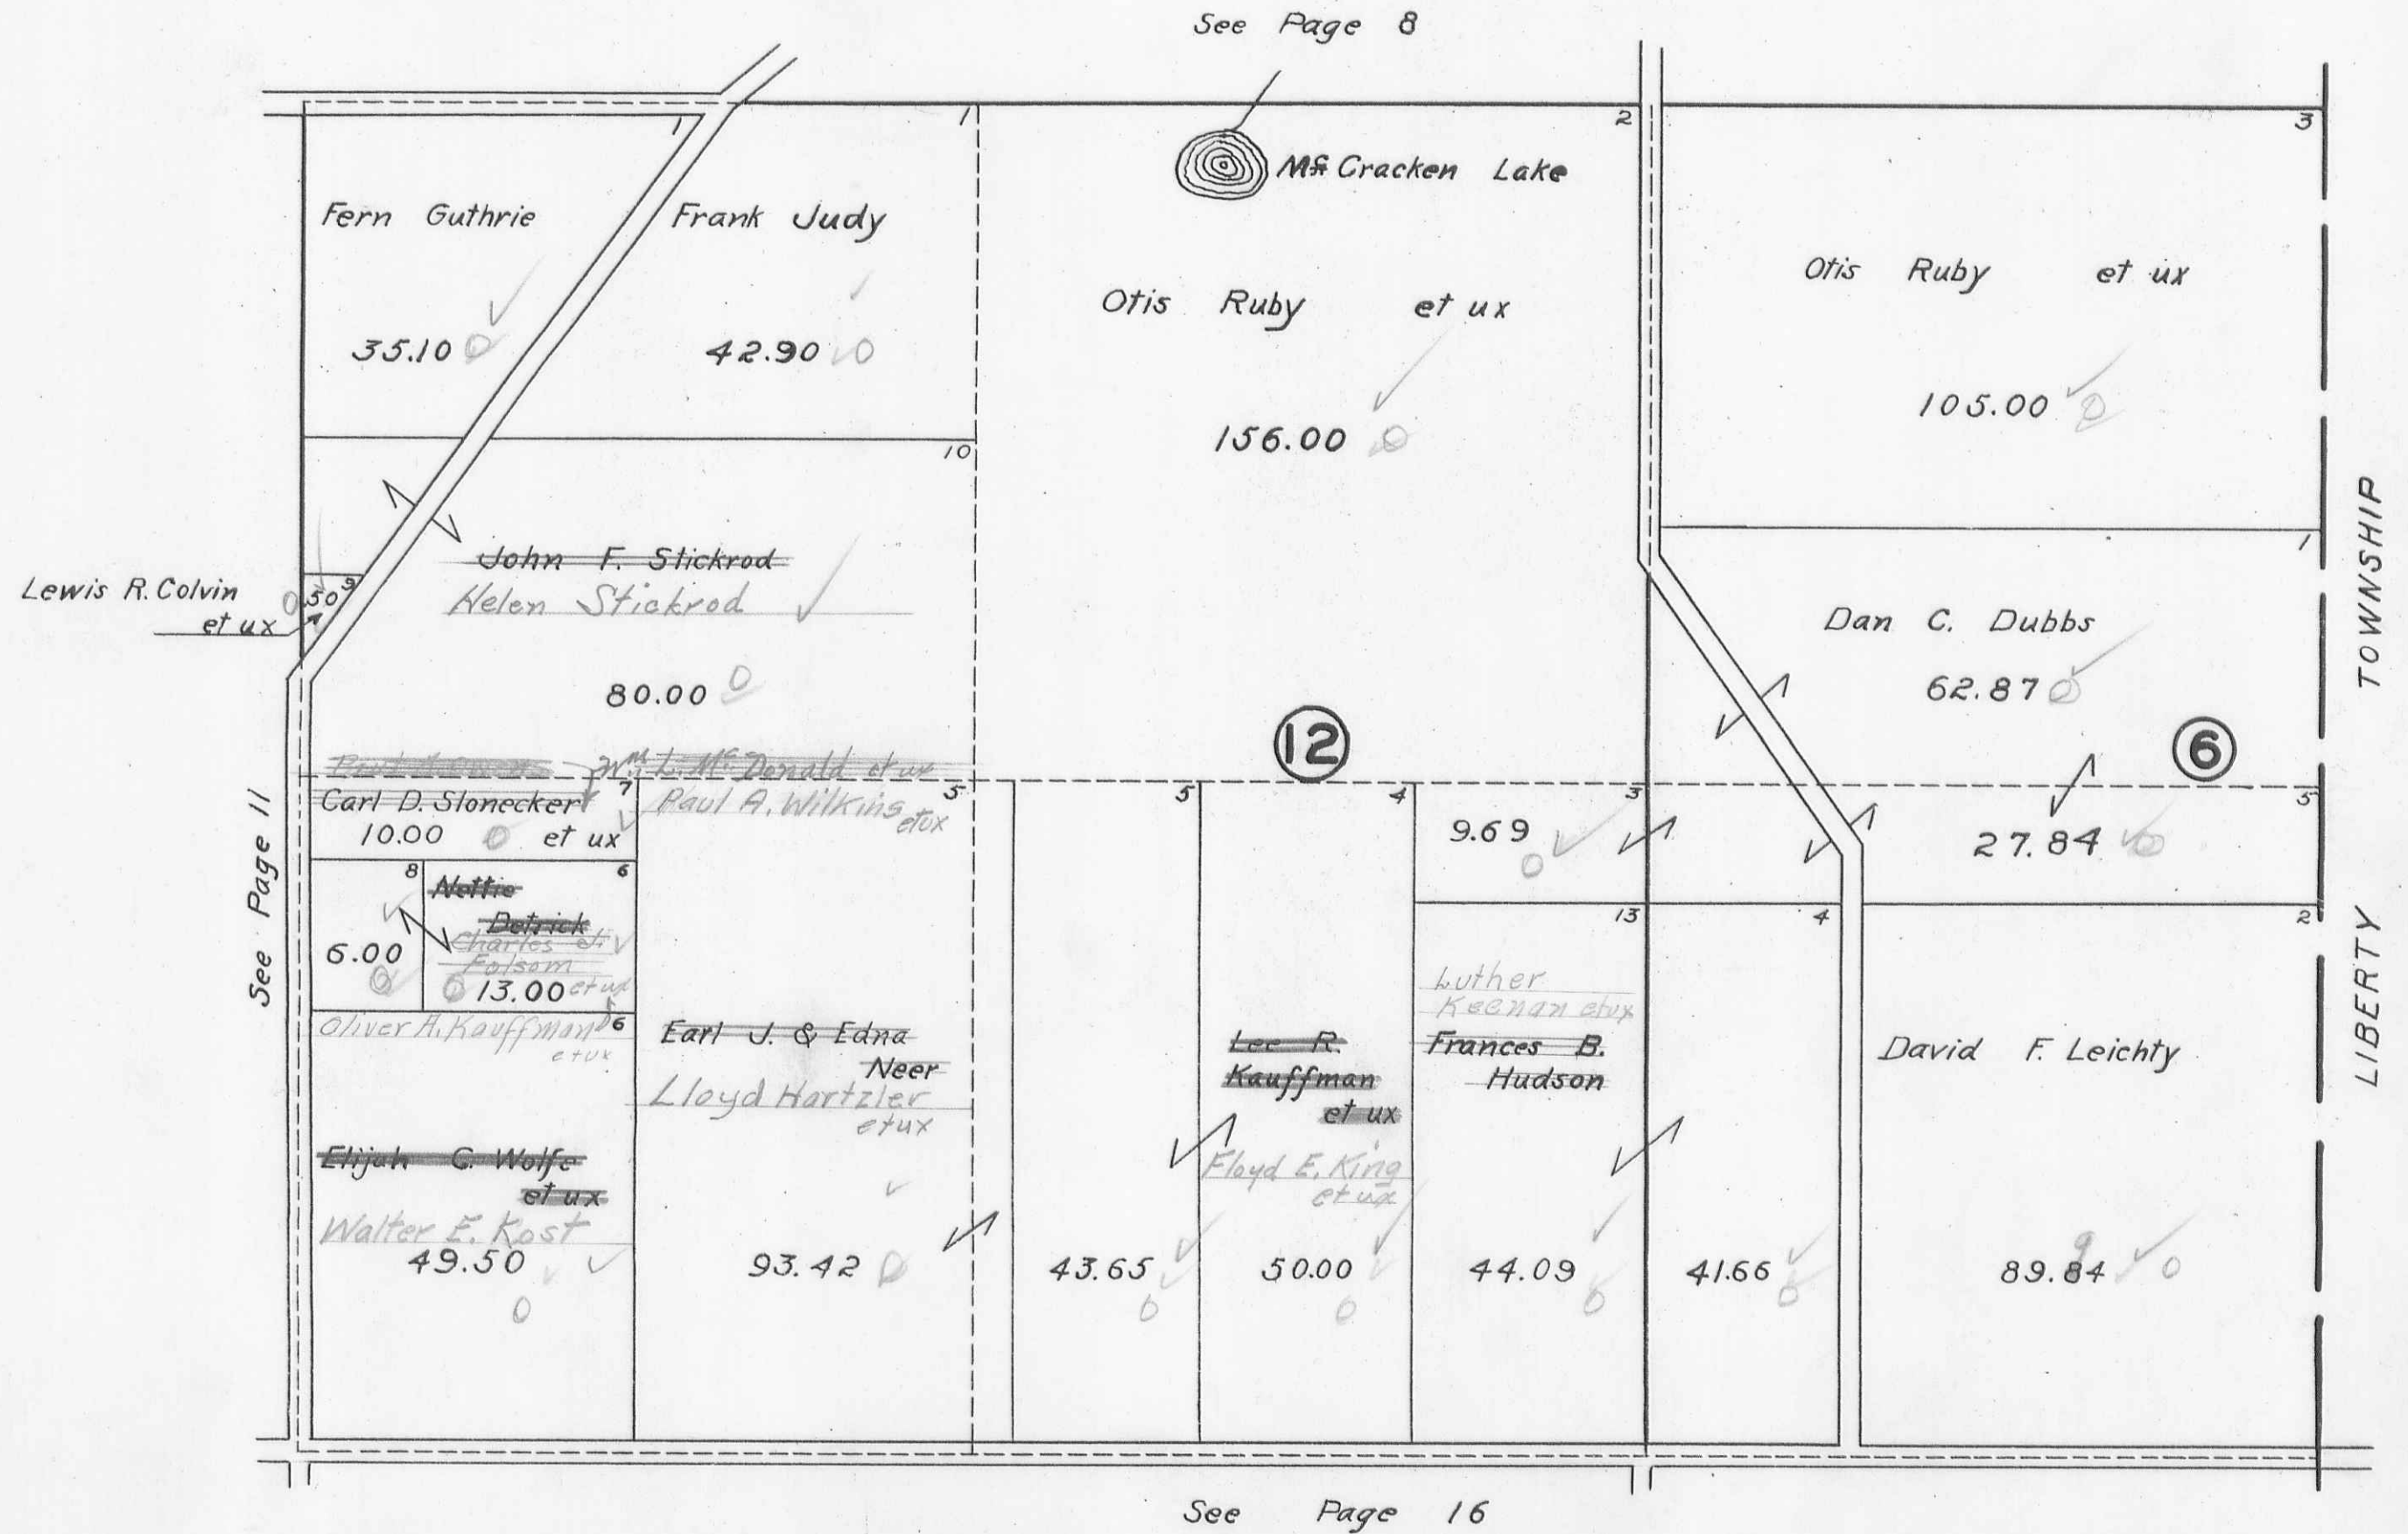

UNION TOWNSHIP
SECTION 29 TOWN 4 RANGE 13


SCALE 10 CHAINS TO THE INCH

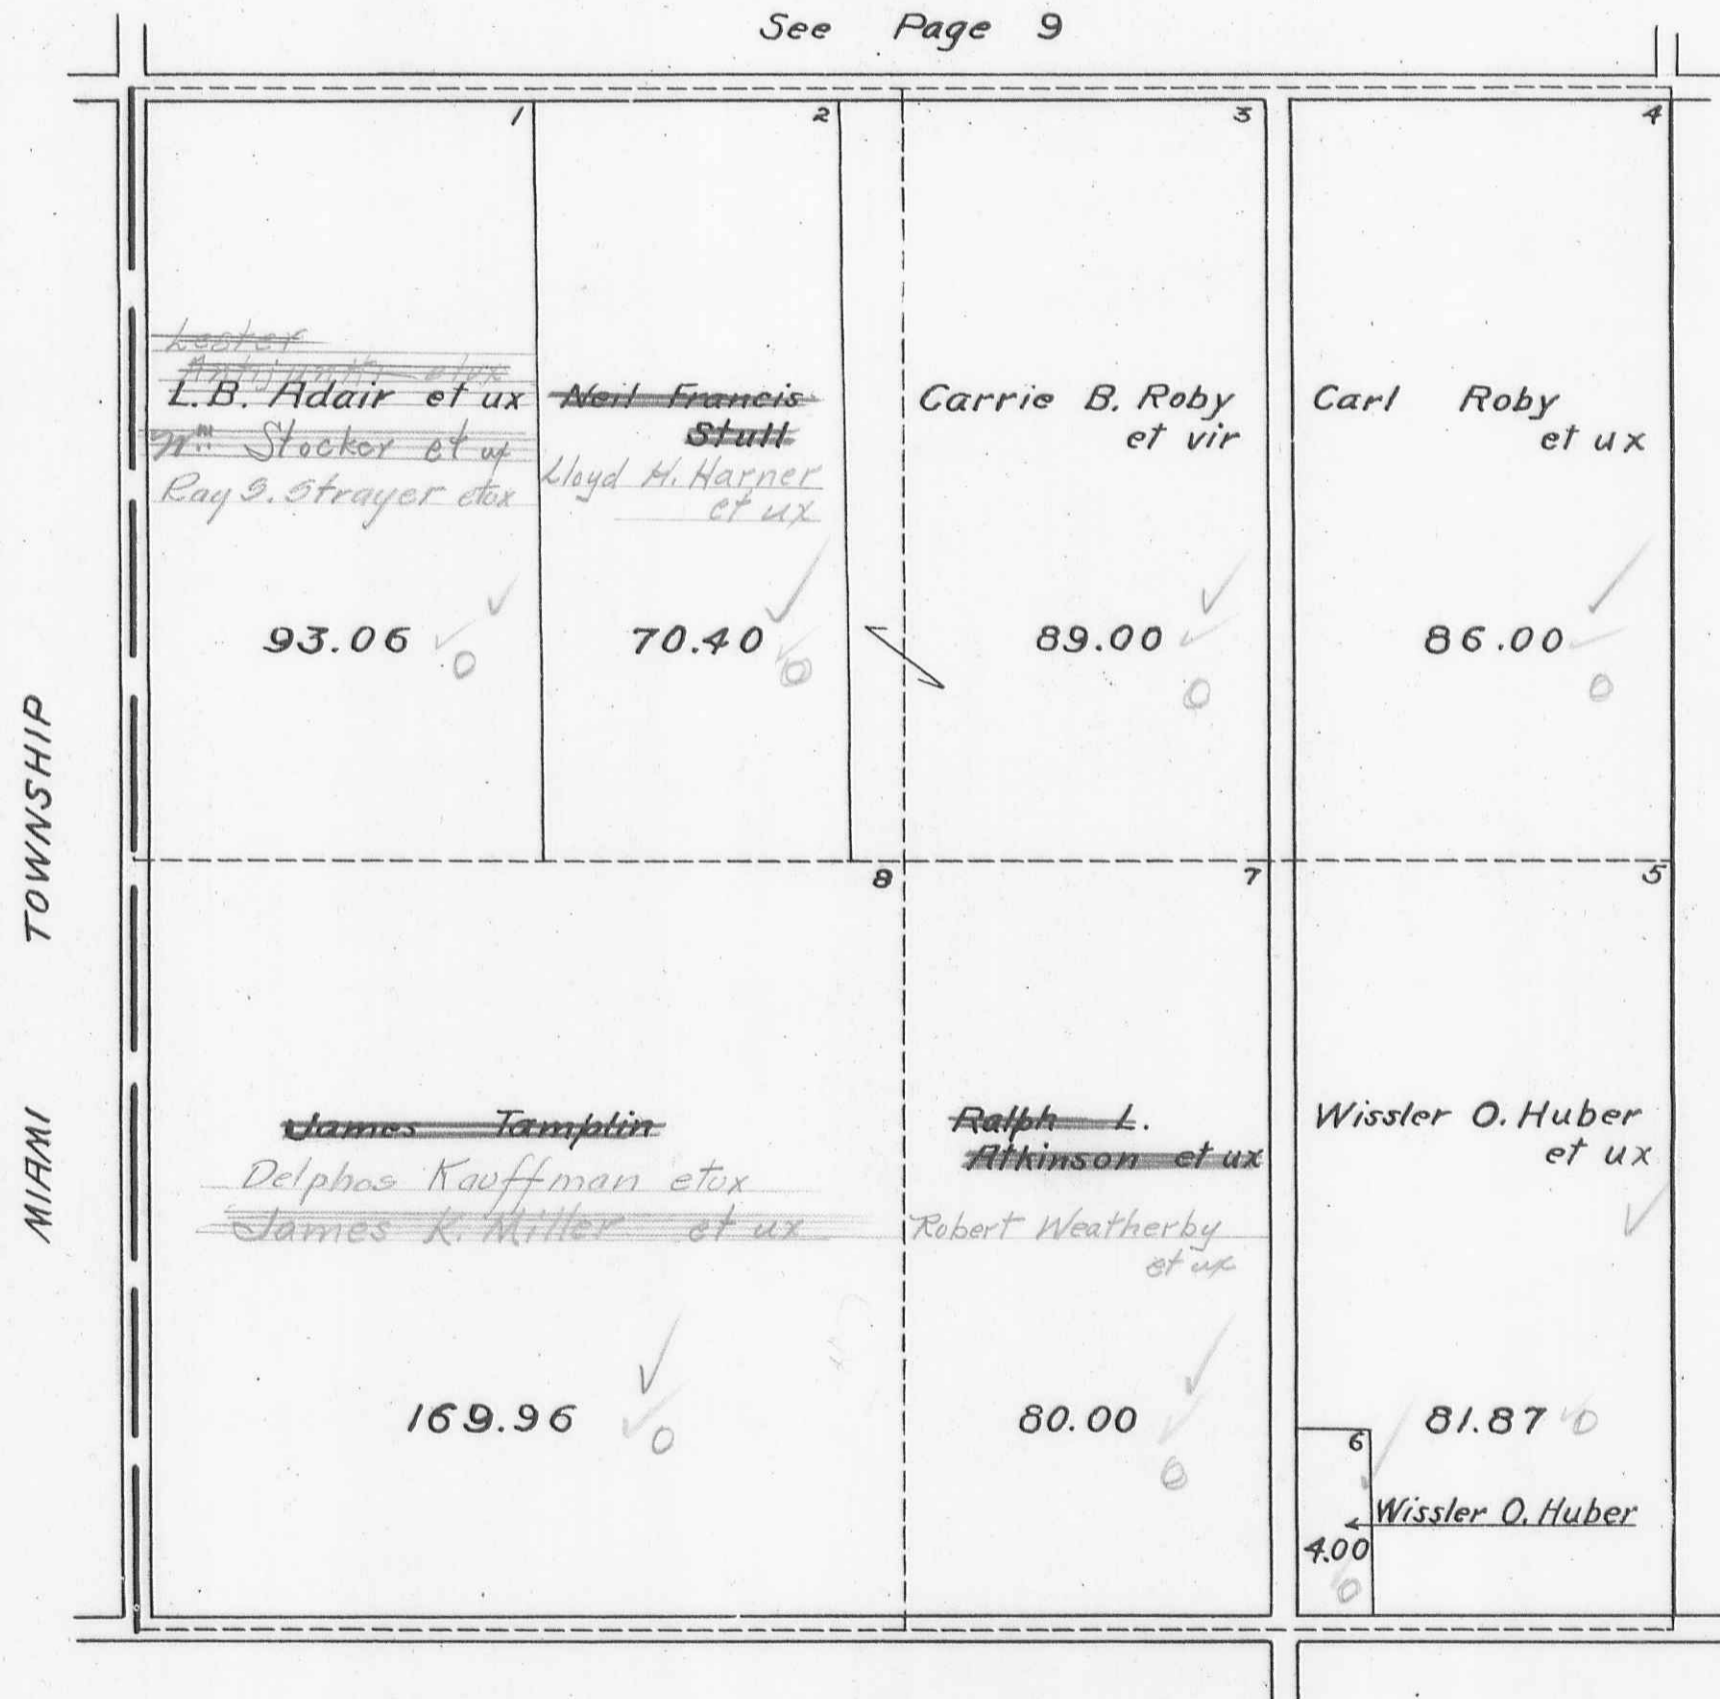

UNION TOWNSHIP
SECTION 23 TOWN 4 RANGE 13

SCALE 10 CHAINS TO THE INCH

See Page 10

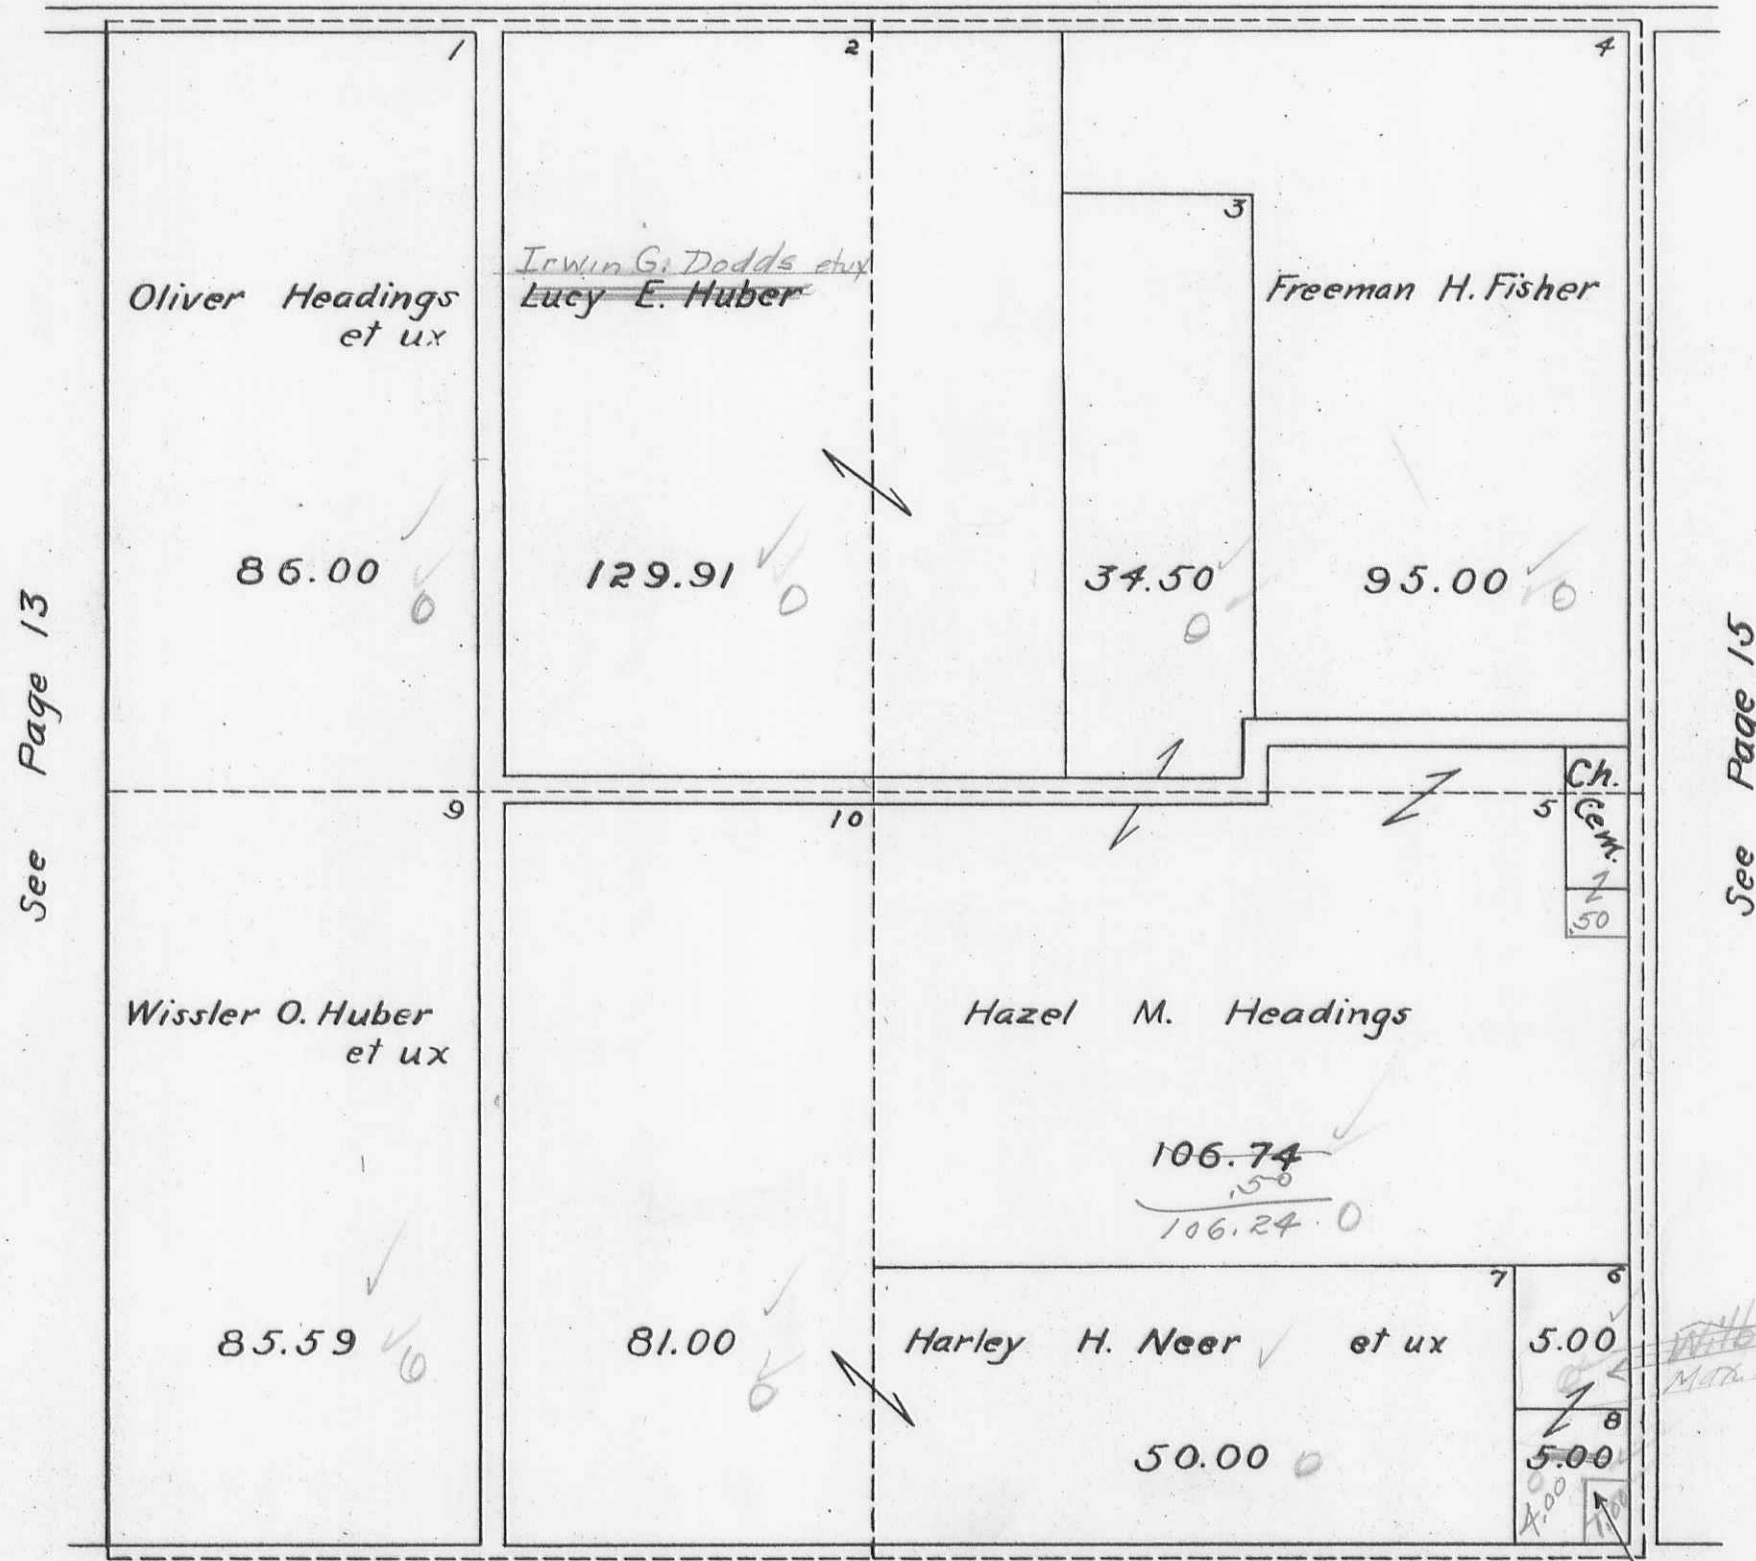

See Page 13

See Page 15


See Page 18

~~Amanda D. Plank et al~~ ~~Lawrence V. Adkins et ux~~
Loren King
Raymond King

~~William W. Roby et ux~~
~~Martha Weatherby et ux~~

SECTION 17 TOWN 4 RANGE 13

SCALE 10 CHAINS TO THE INCH

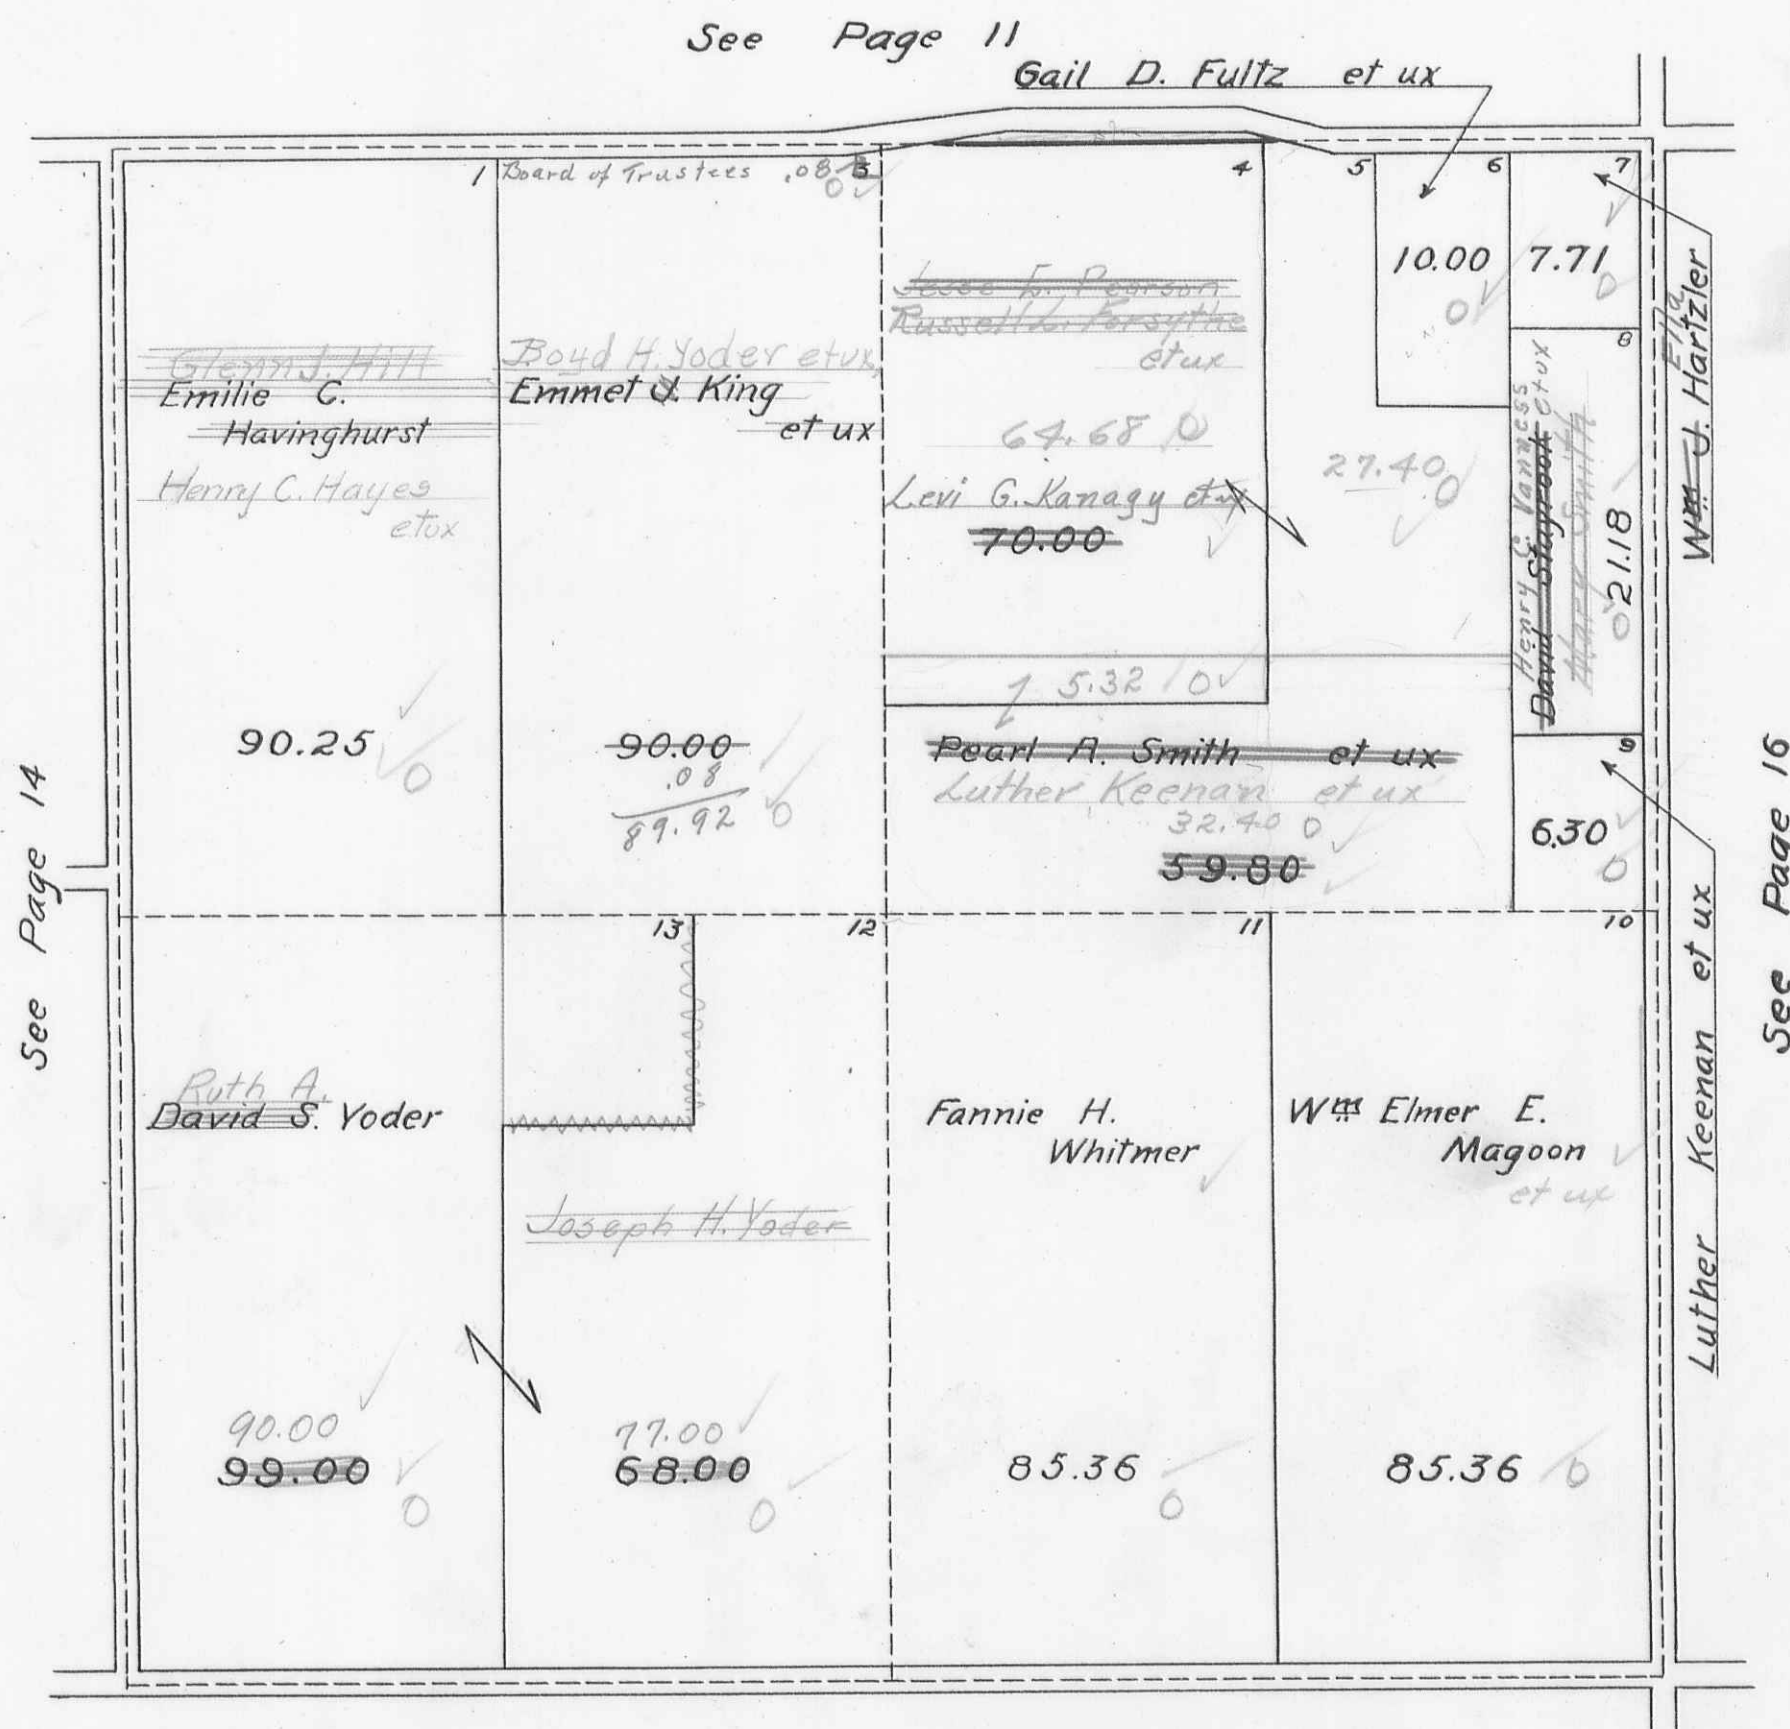


SECTION 11 TOWN 4 RANGE 13

SECTION 5 TOWN 4 RANGE 13

SCALE 10 CHAINS TO THE INCH


See Page 12

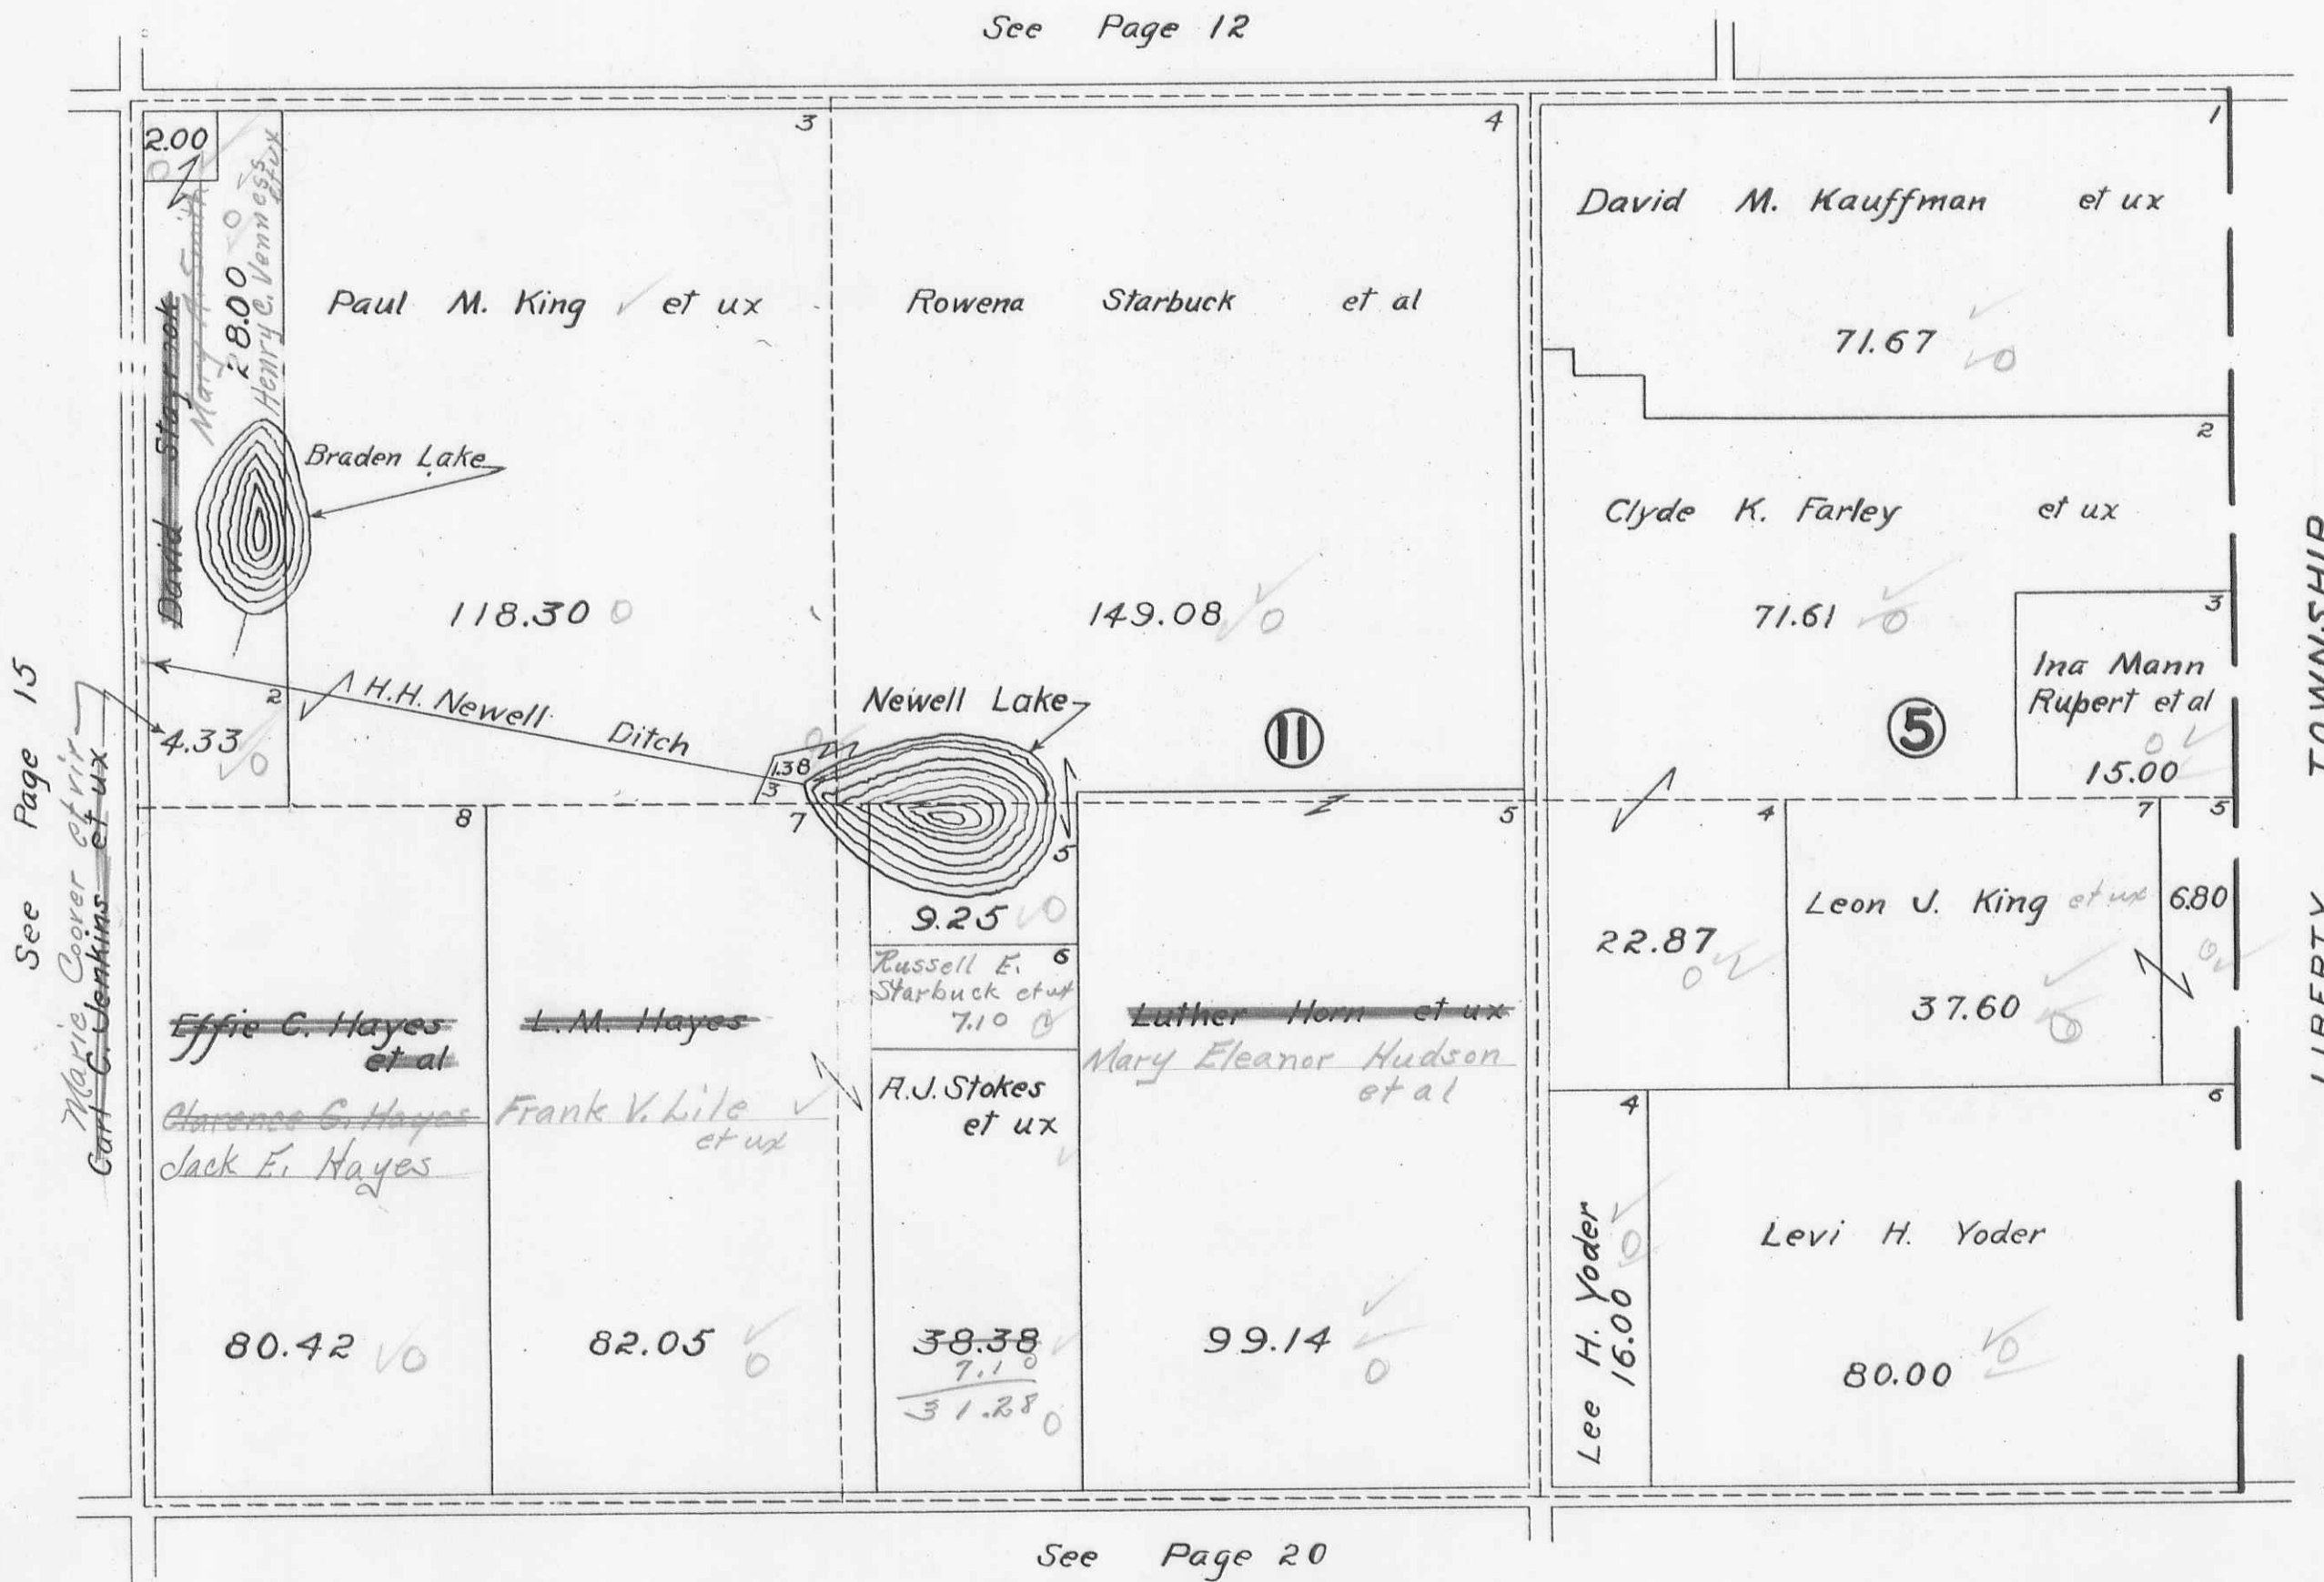

UNION TOWNSHIP
SECTION 28 TOWN 4 RANGE 13

SCALE 10 CHAINS TO THE INCH

See Page 13

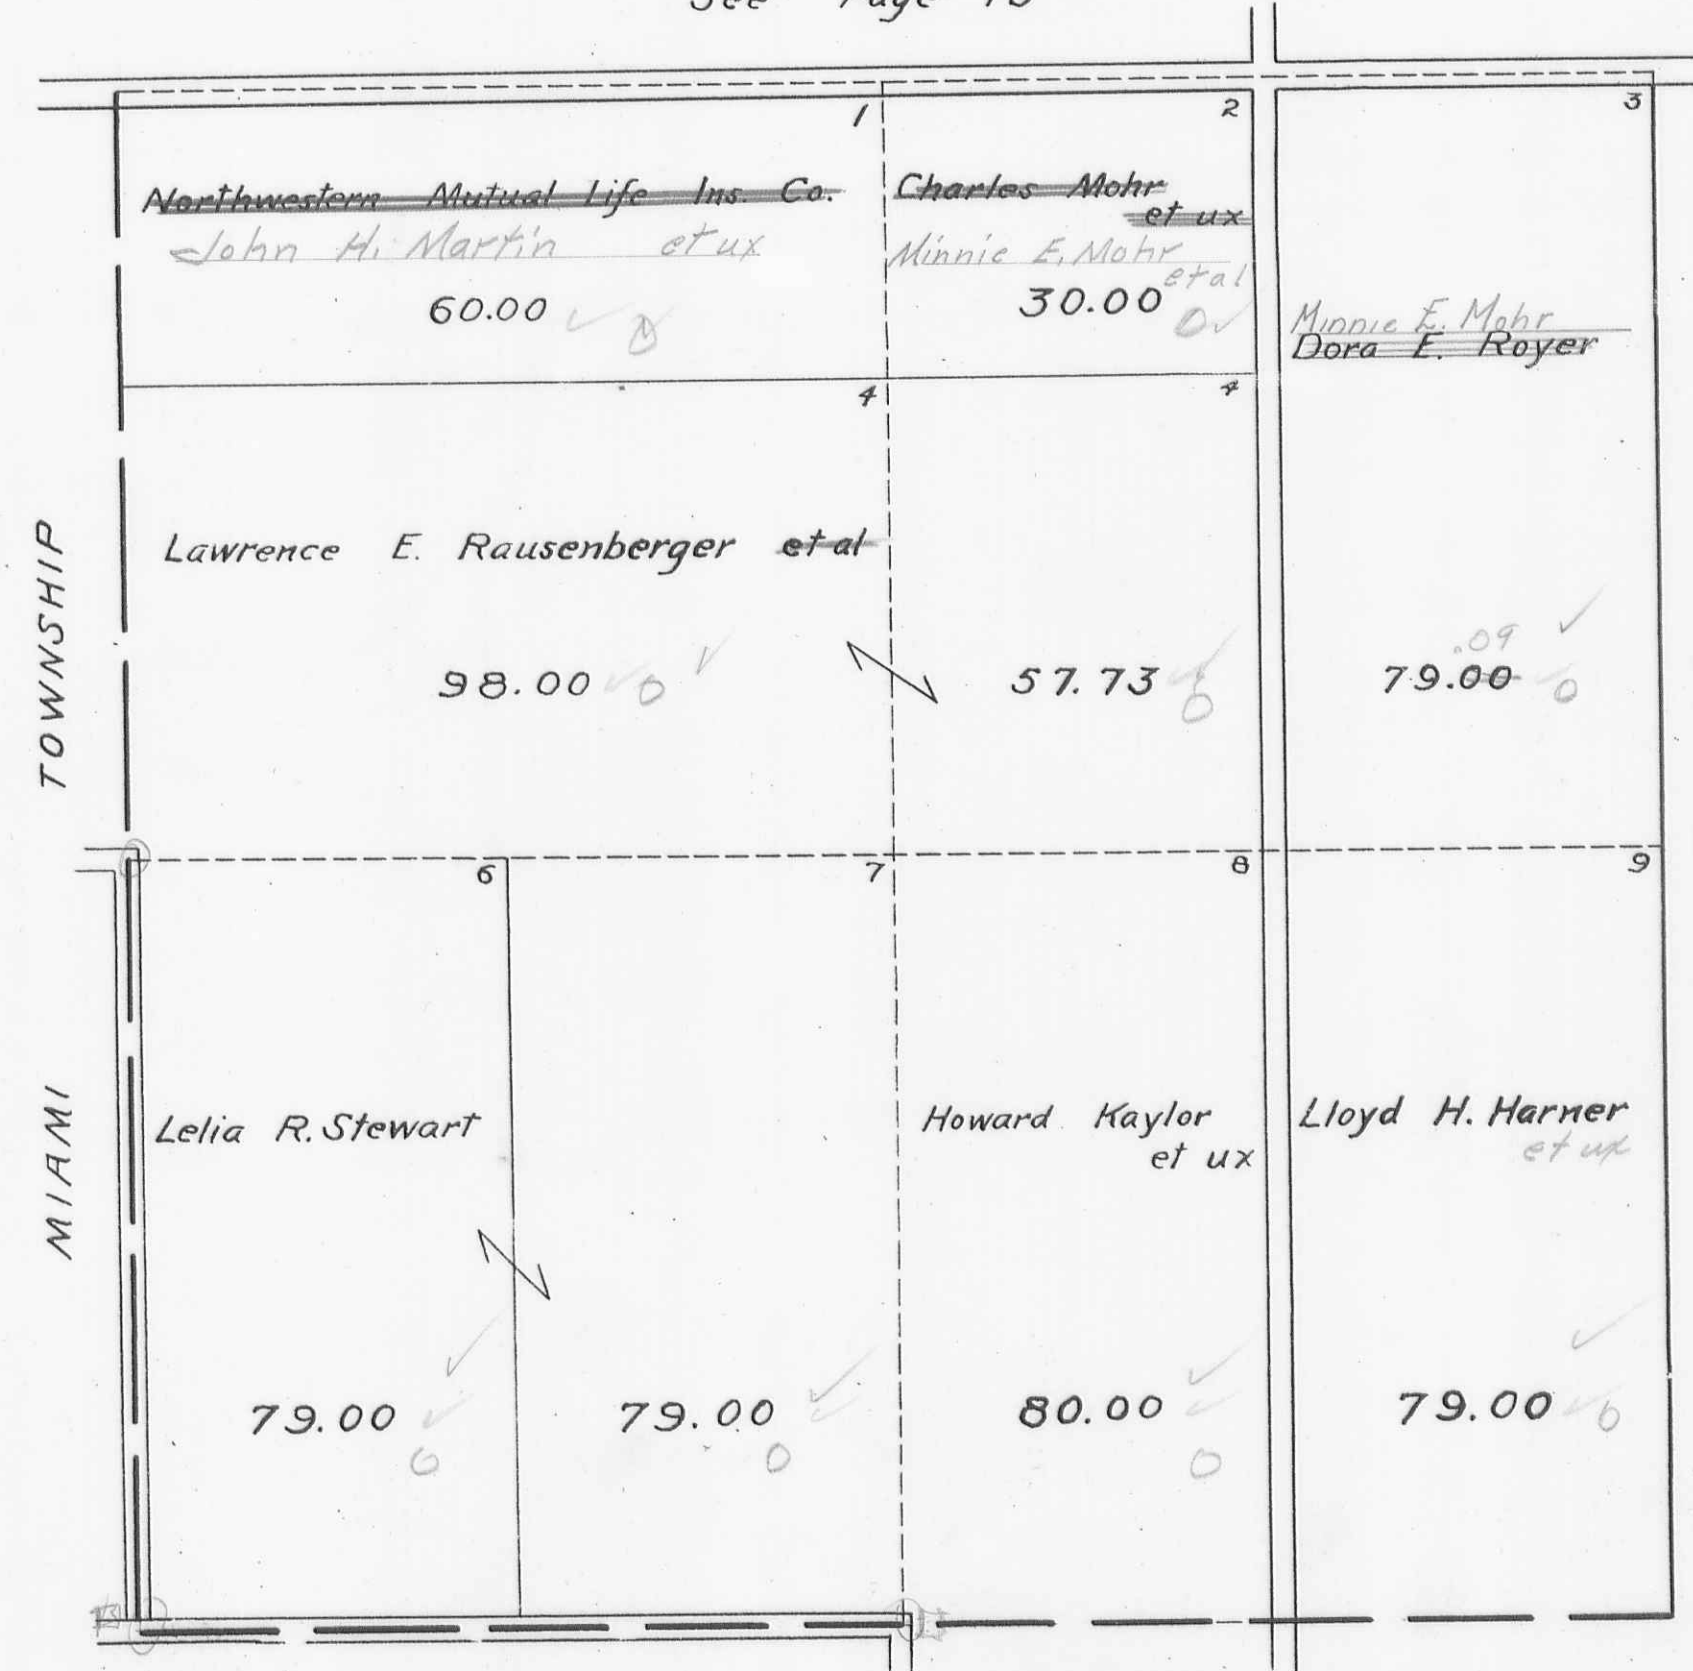

TOWNSHIP

MIAMI


CHAMPAIGN COUNTY

See Page 18

UNION TOWNSHIP
SECTION 22 TOWN 4 RANGE 13

SCALE 10 CHAINS TO THE INCH

See Page 14

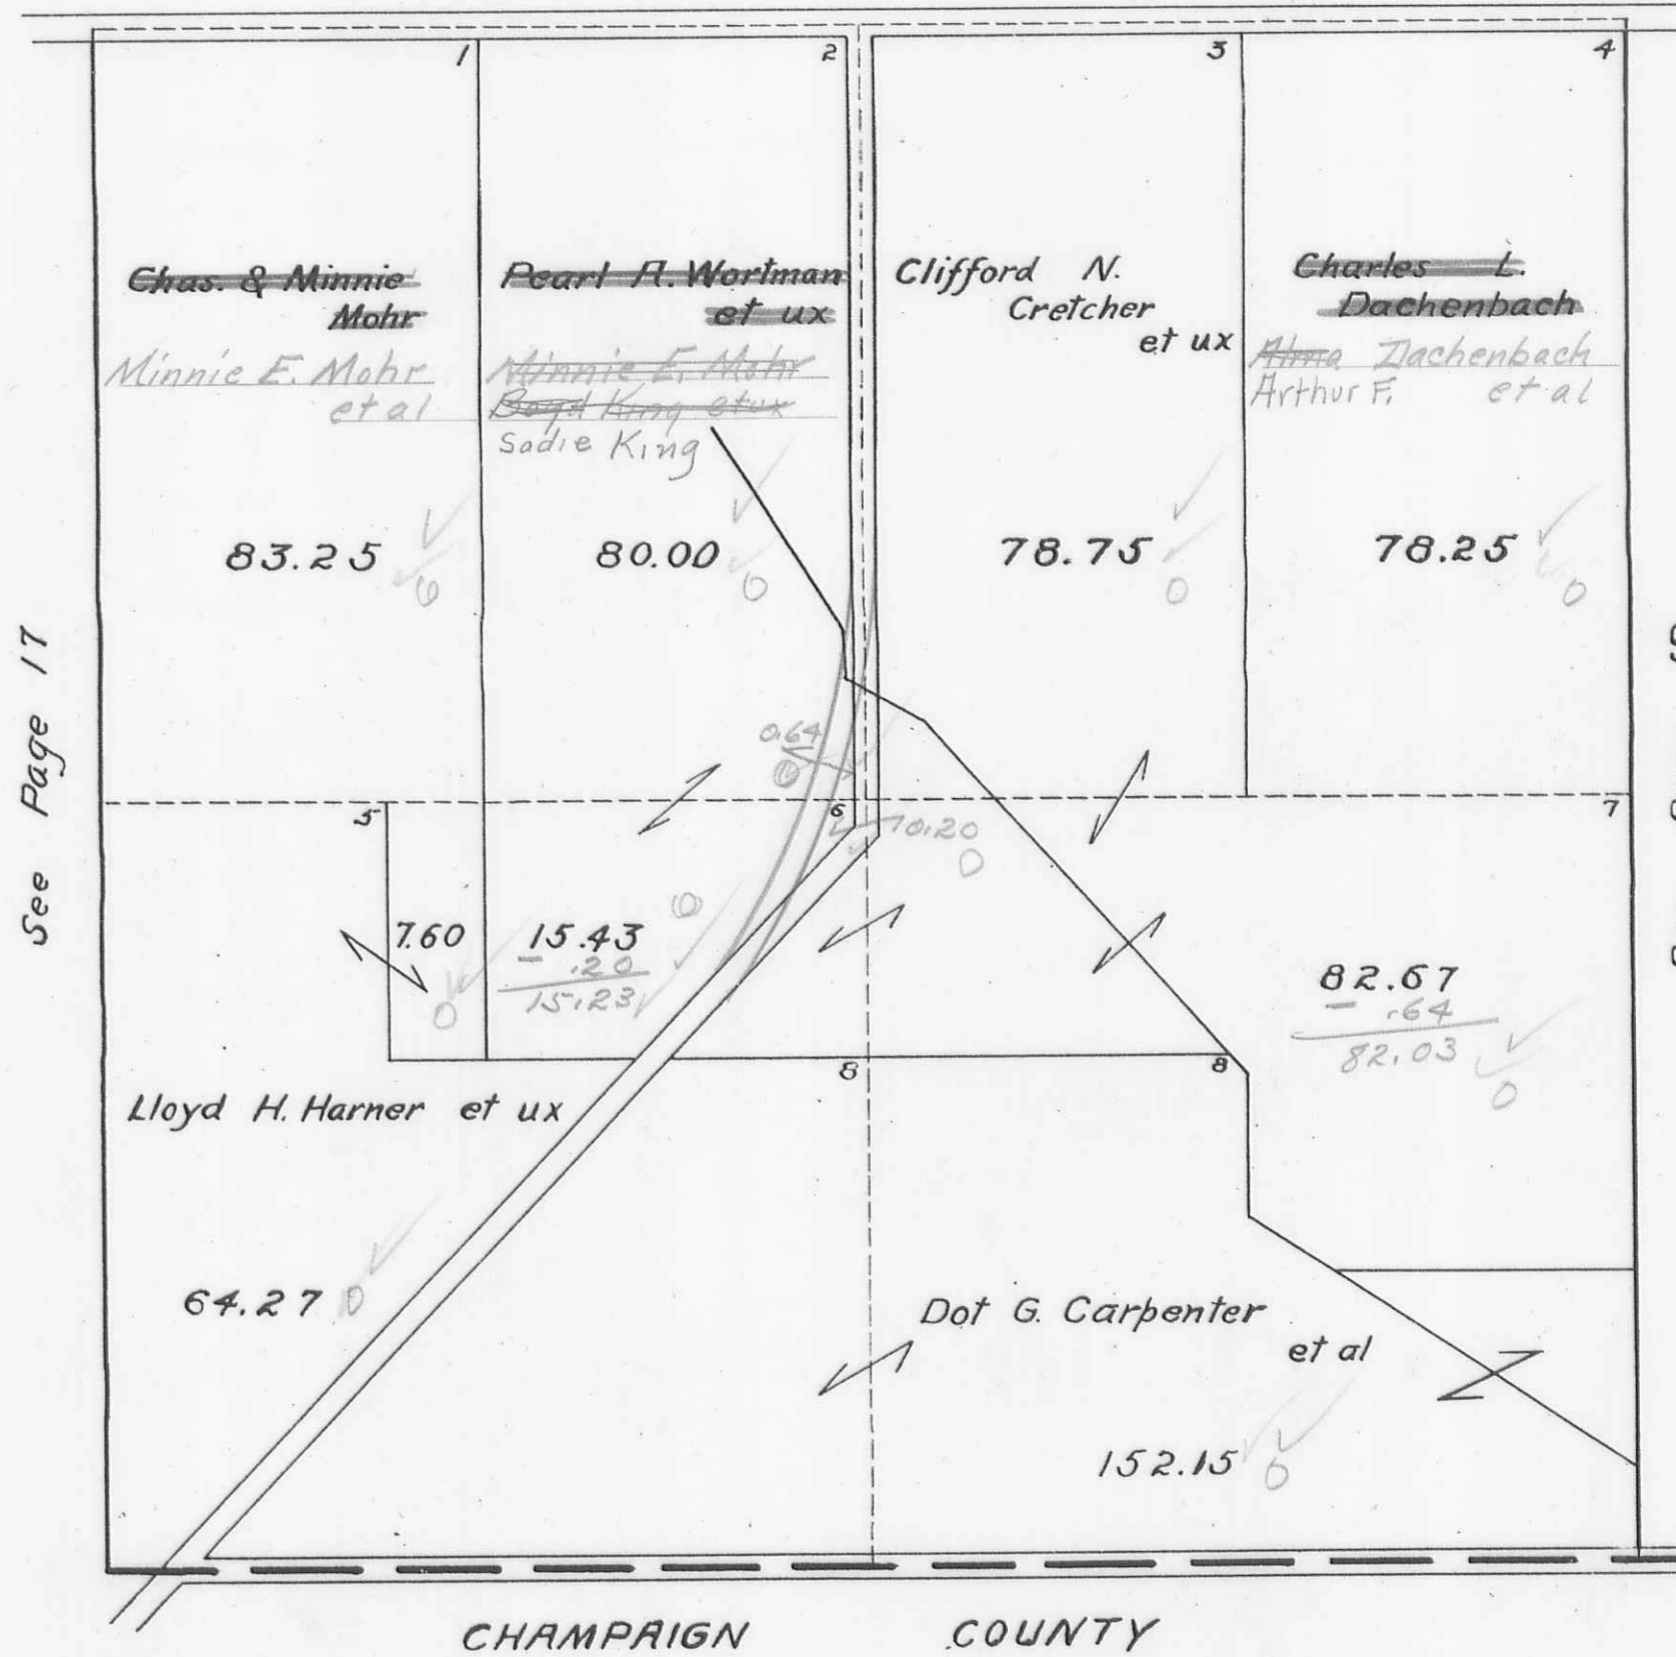


See Page 17

See Page 19

UNION TOWNSHIP
SECTION 16 TOWN 4 RANGE 13

SCALE 10 CHAINS TO THE INCH

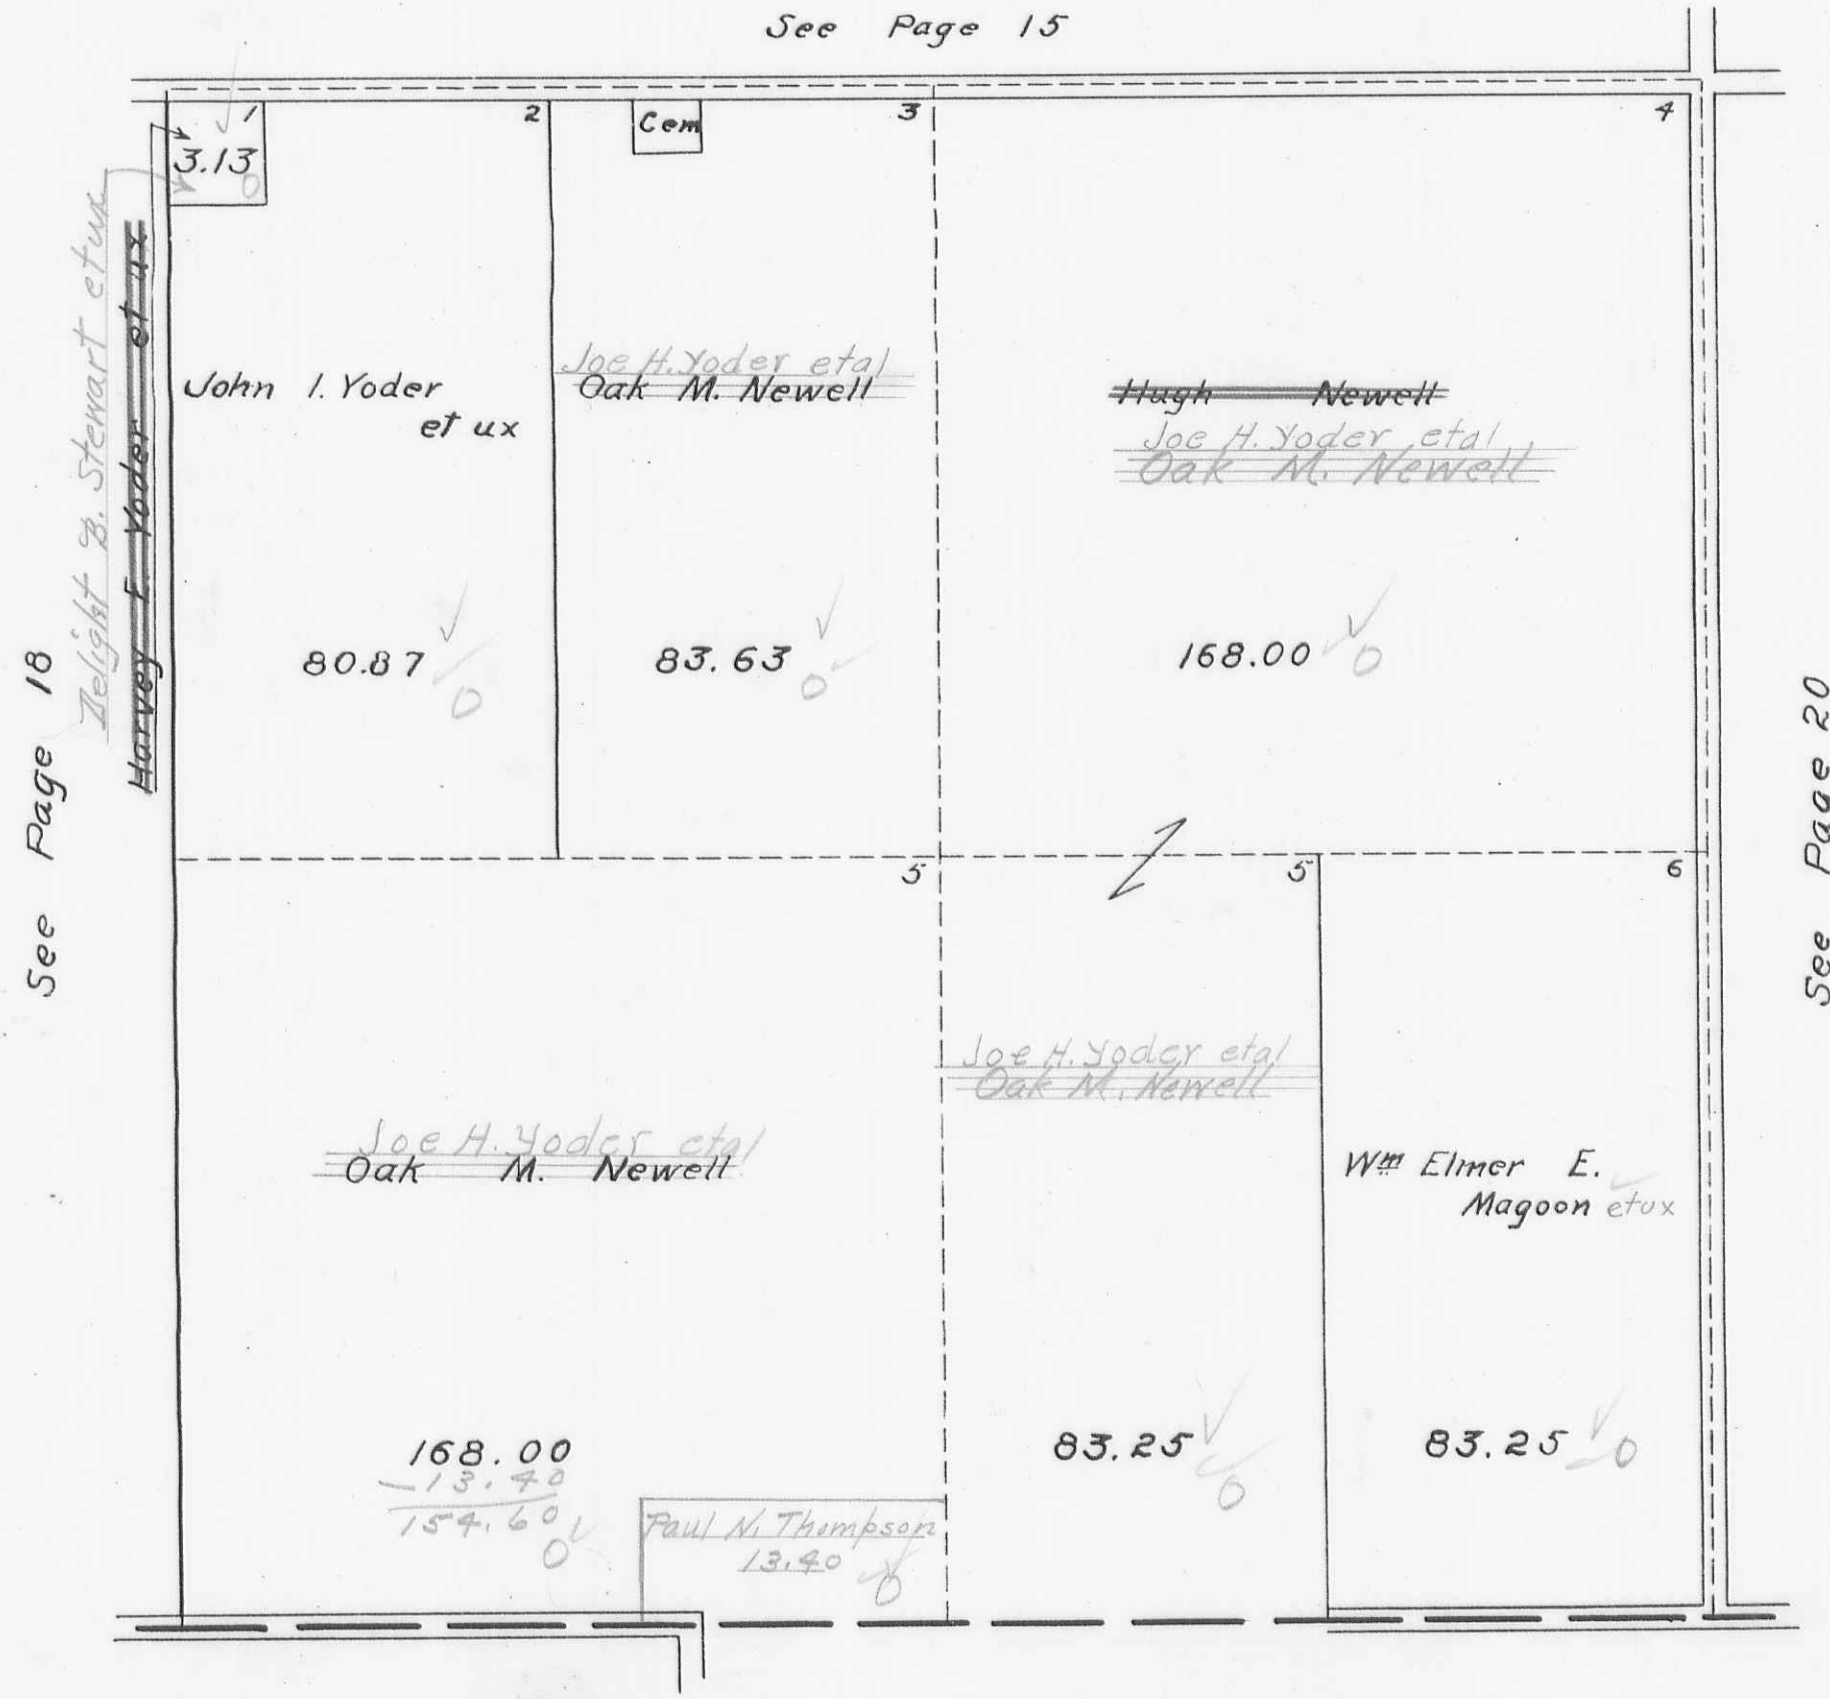


CHAMPAIGN COUNTY

UNION TOWNSHIP
 SECTION 10 TOWN 4 RANGE 13
 SECTION 4 TOWN 4 RANGE 13

SCALE 10 CHAINS TO THE INCH

See Page 16

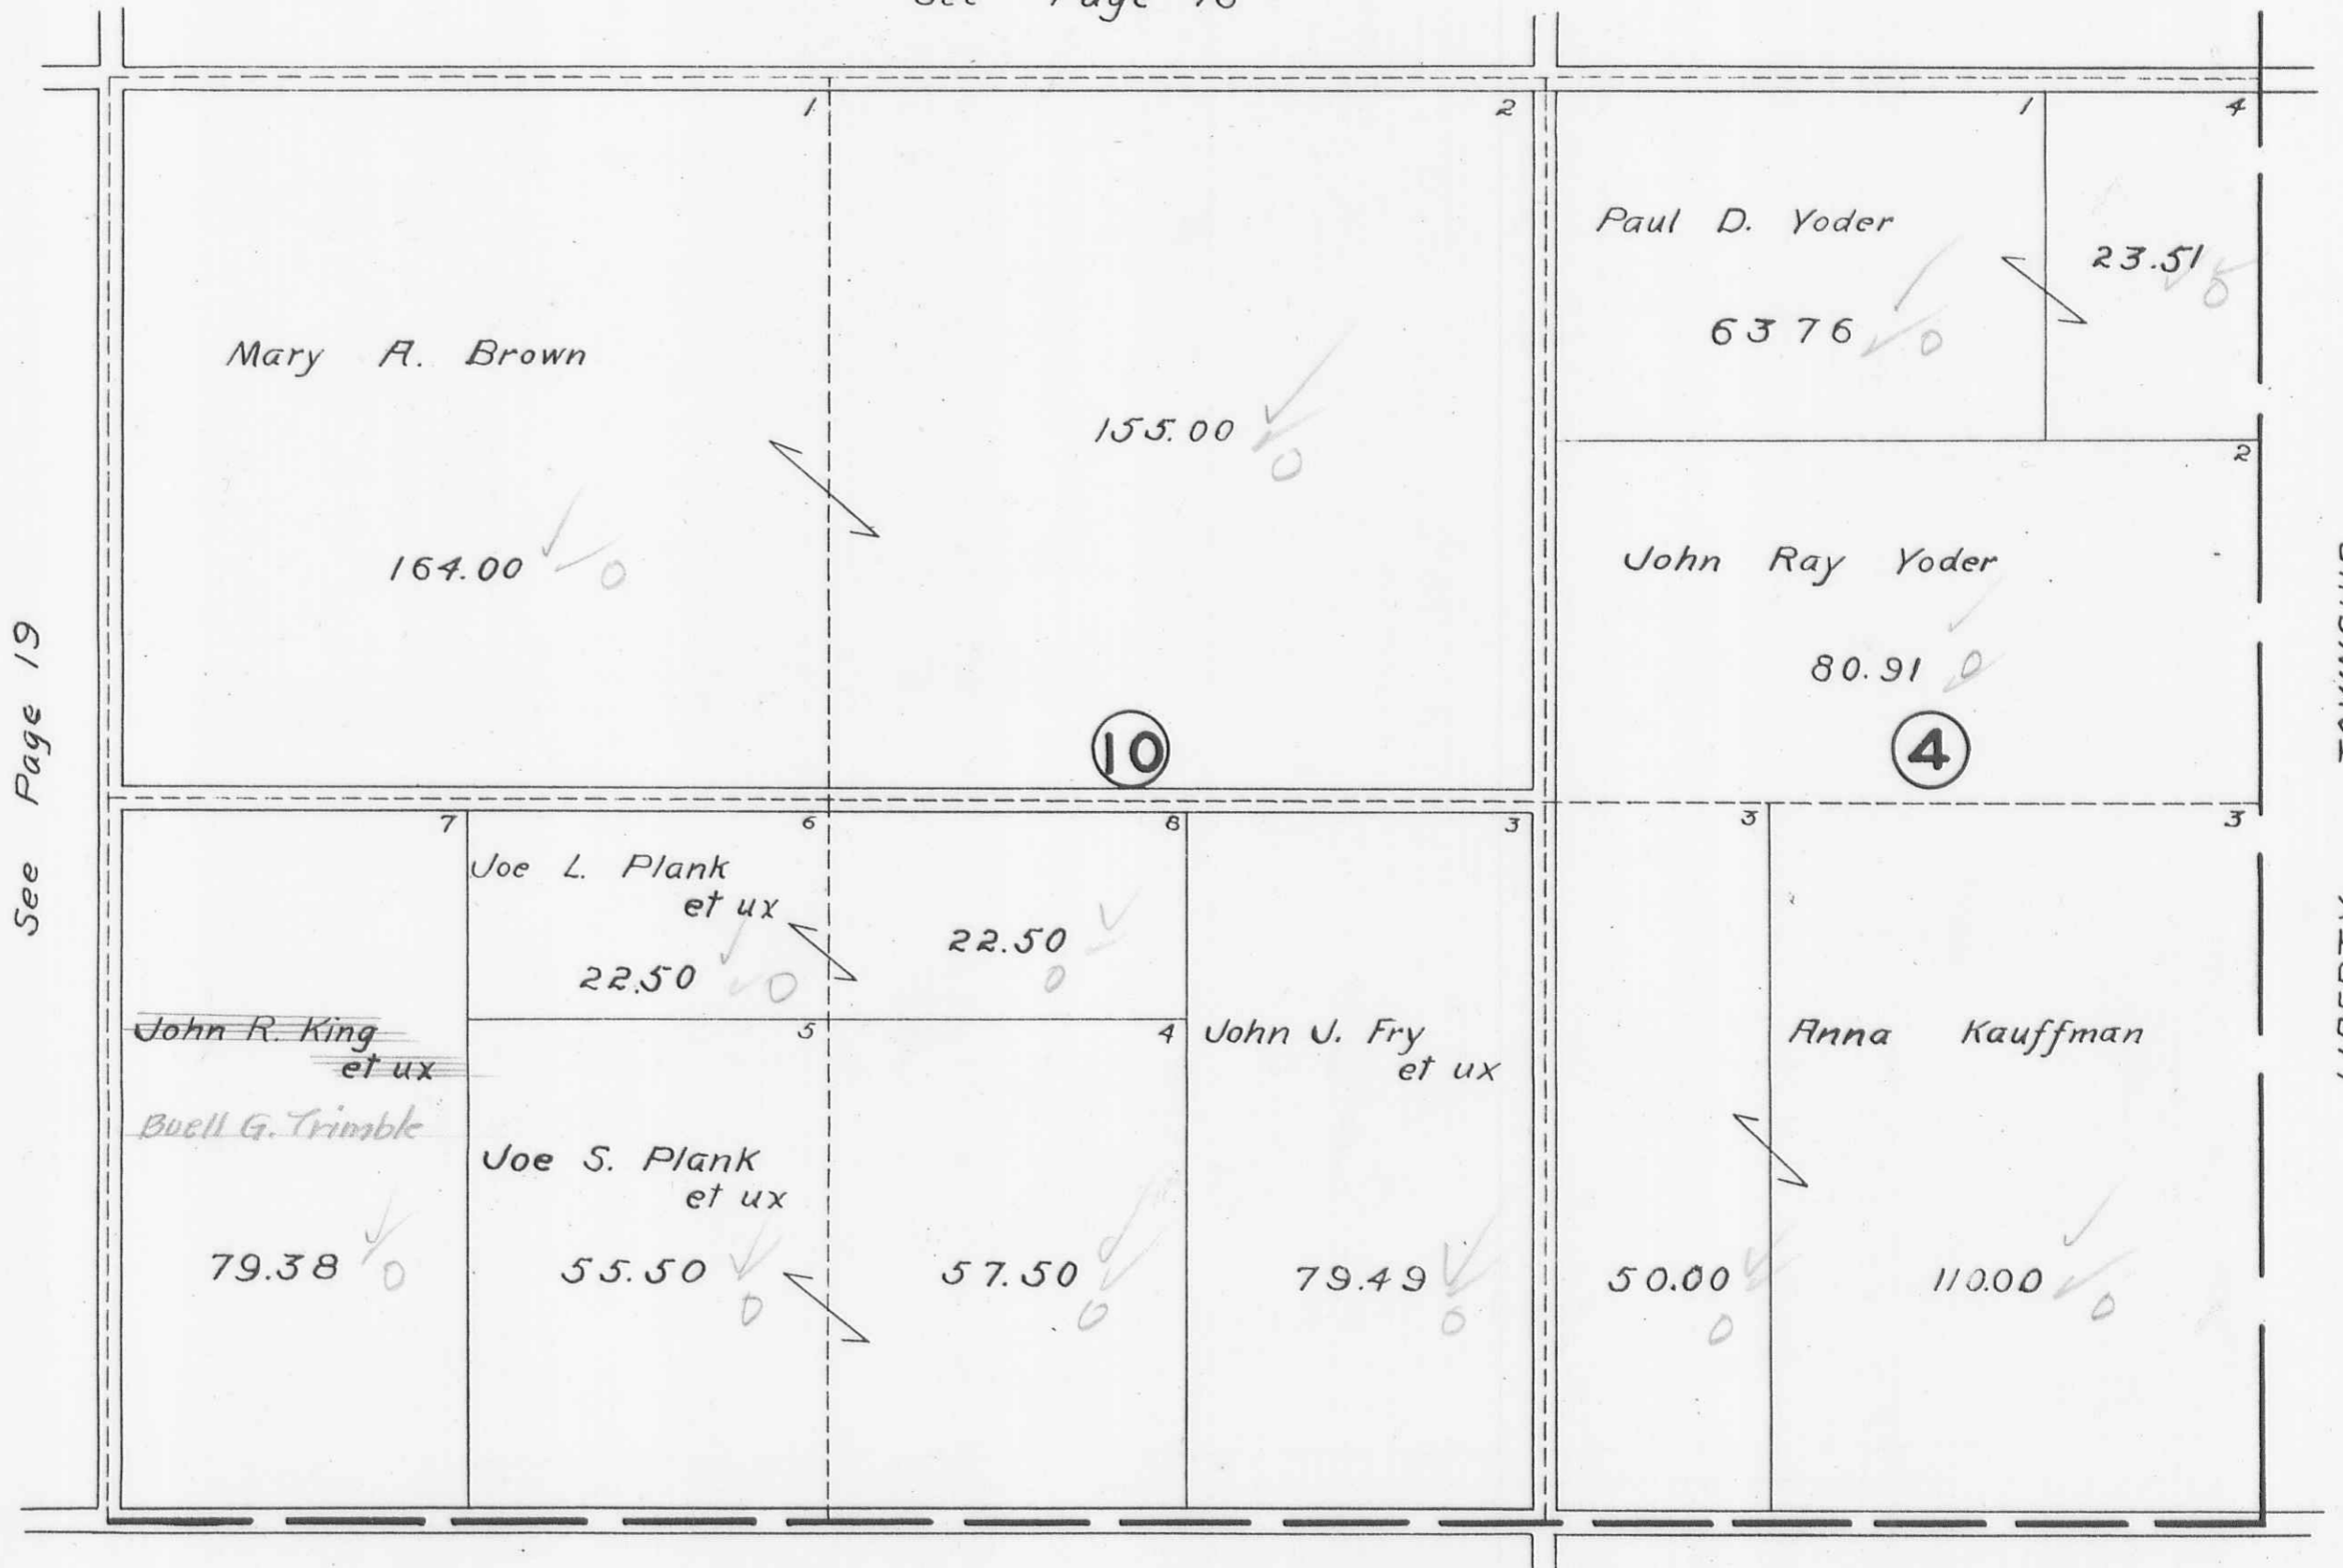

See Page 19

LIBERTY TOWNSHIP

CHAMPAIGN COUNTY