

Recorder

ZANE
TOWNSHIP
1933

REVISED 1942


DRAWN BY
Wright C.E.
Revised By G.W. Wilgus April 12-1942

ZANE TOWNSHIP

VIRGINIA MILITARY SURVEYS INDEX

CORRECTED TO ~~March 12, 1942~~

January 1, 1945
April 9, 1945
November 10, 1945
~~January 1, 1949~~
 January 1, 1950

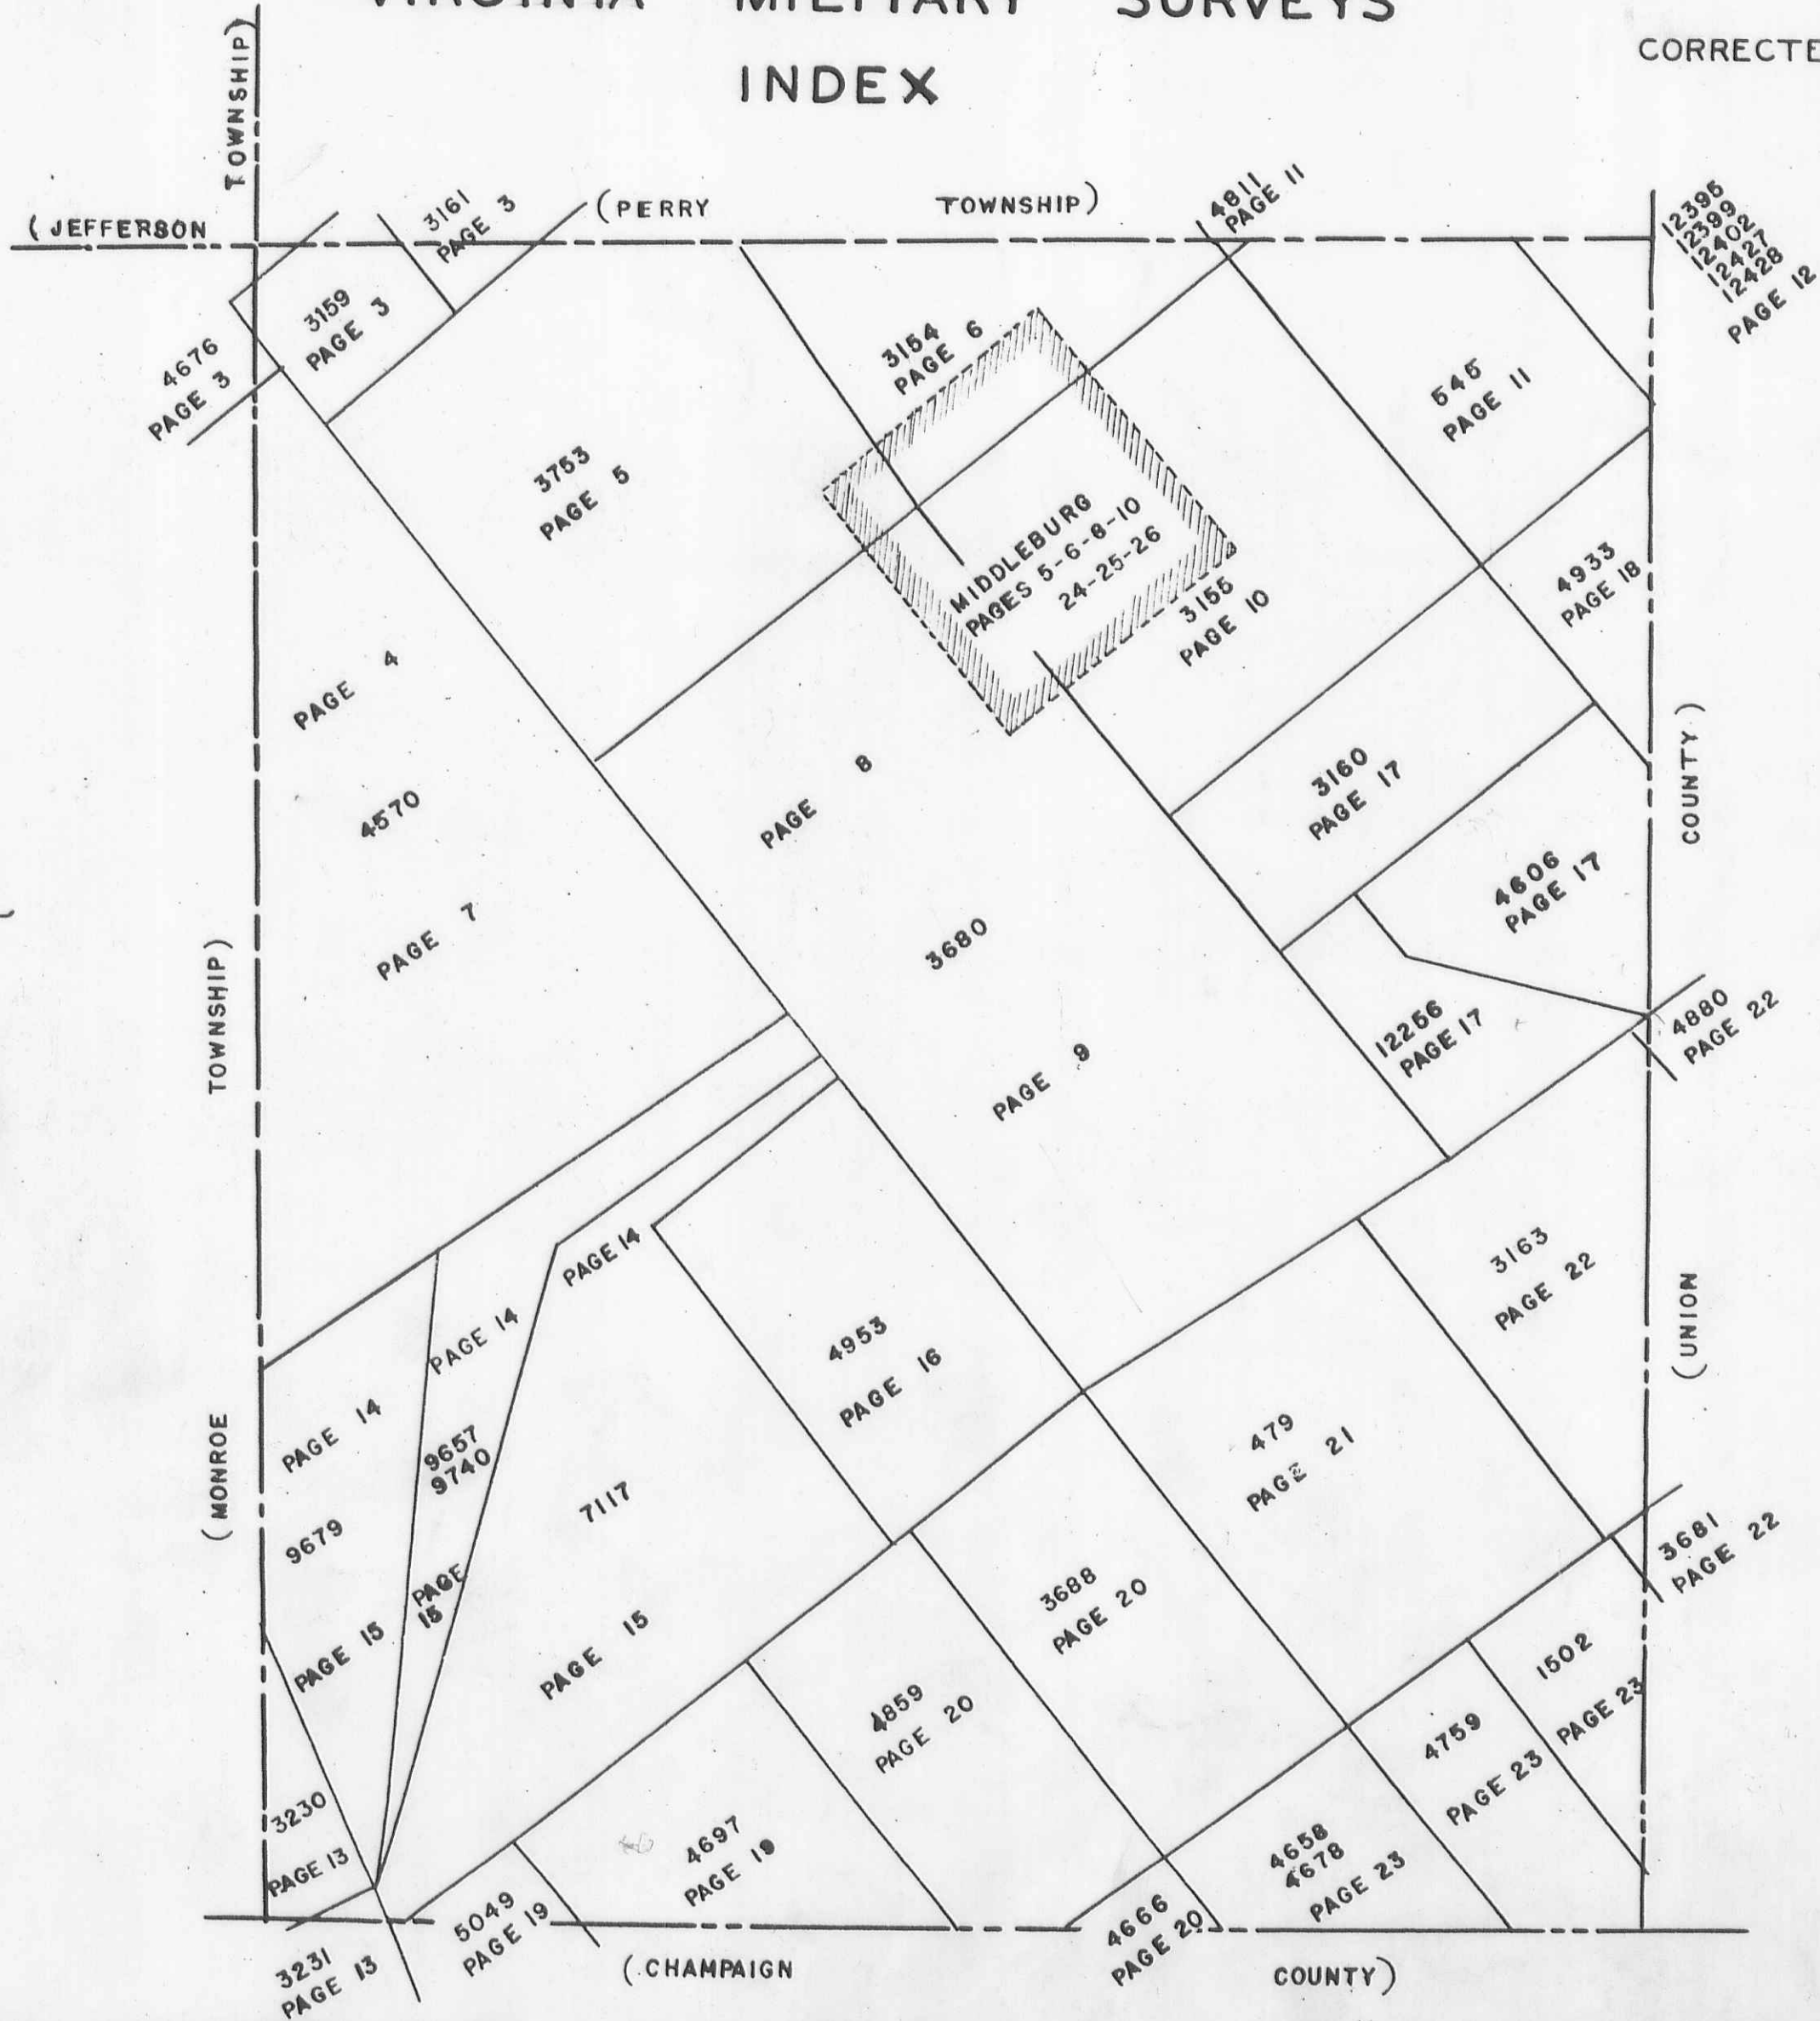

RFW: G.H.J. 1933 1942

ZANE TOWNSHIP
 VIRGINIA MILITARY SURVEYS
 INDEX


SURVEY NUMBER	PAGE
479.....	21
545.....	11
1502.....	23
3154.....	6
3155.....	10-24-25-26
3159.....	3
3160.....	17
3161.....	3
3163.....	22
3230.....	13
3231.....	13
3680.....	8-9
3681.....	22
3688.....	20
3753.....	5
4570.....	4-7
4606.....	17
4658 }.....	23
4678 }	
4666.....	20
4676.....	3
4697.....	19
4759.....	23
4811.....	11
4859.....	20
4880.....	22
4933.....	18
4953.....	16

SURVEY NUMBER	PAGE
5049.....	19
7117.....	14-15
9657 }.....	14-15
9740 }	
9679.....	14-15
12256.....	17
12395 }.....	12
12399 }	
12402 }	
12427 }	
12428 }	

ZANE TOWNSHIP
 VIRGINIA MILITARY SURVEYS

3159
 3161
 4570
 4676

SCALE 10 CHAINS TO THE INCH

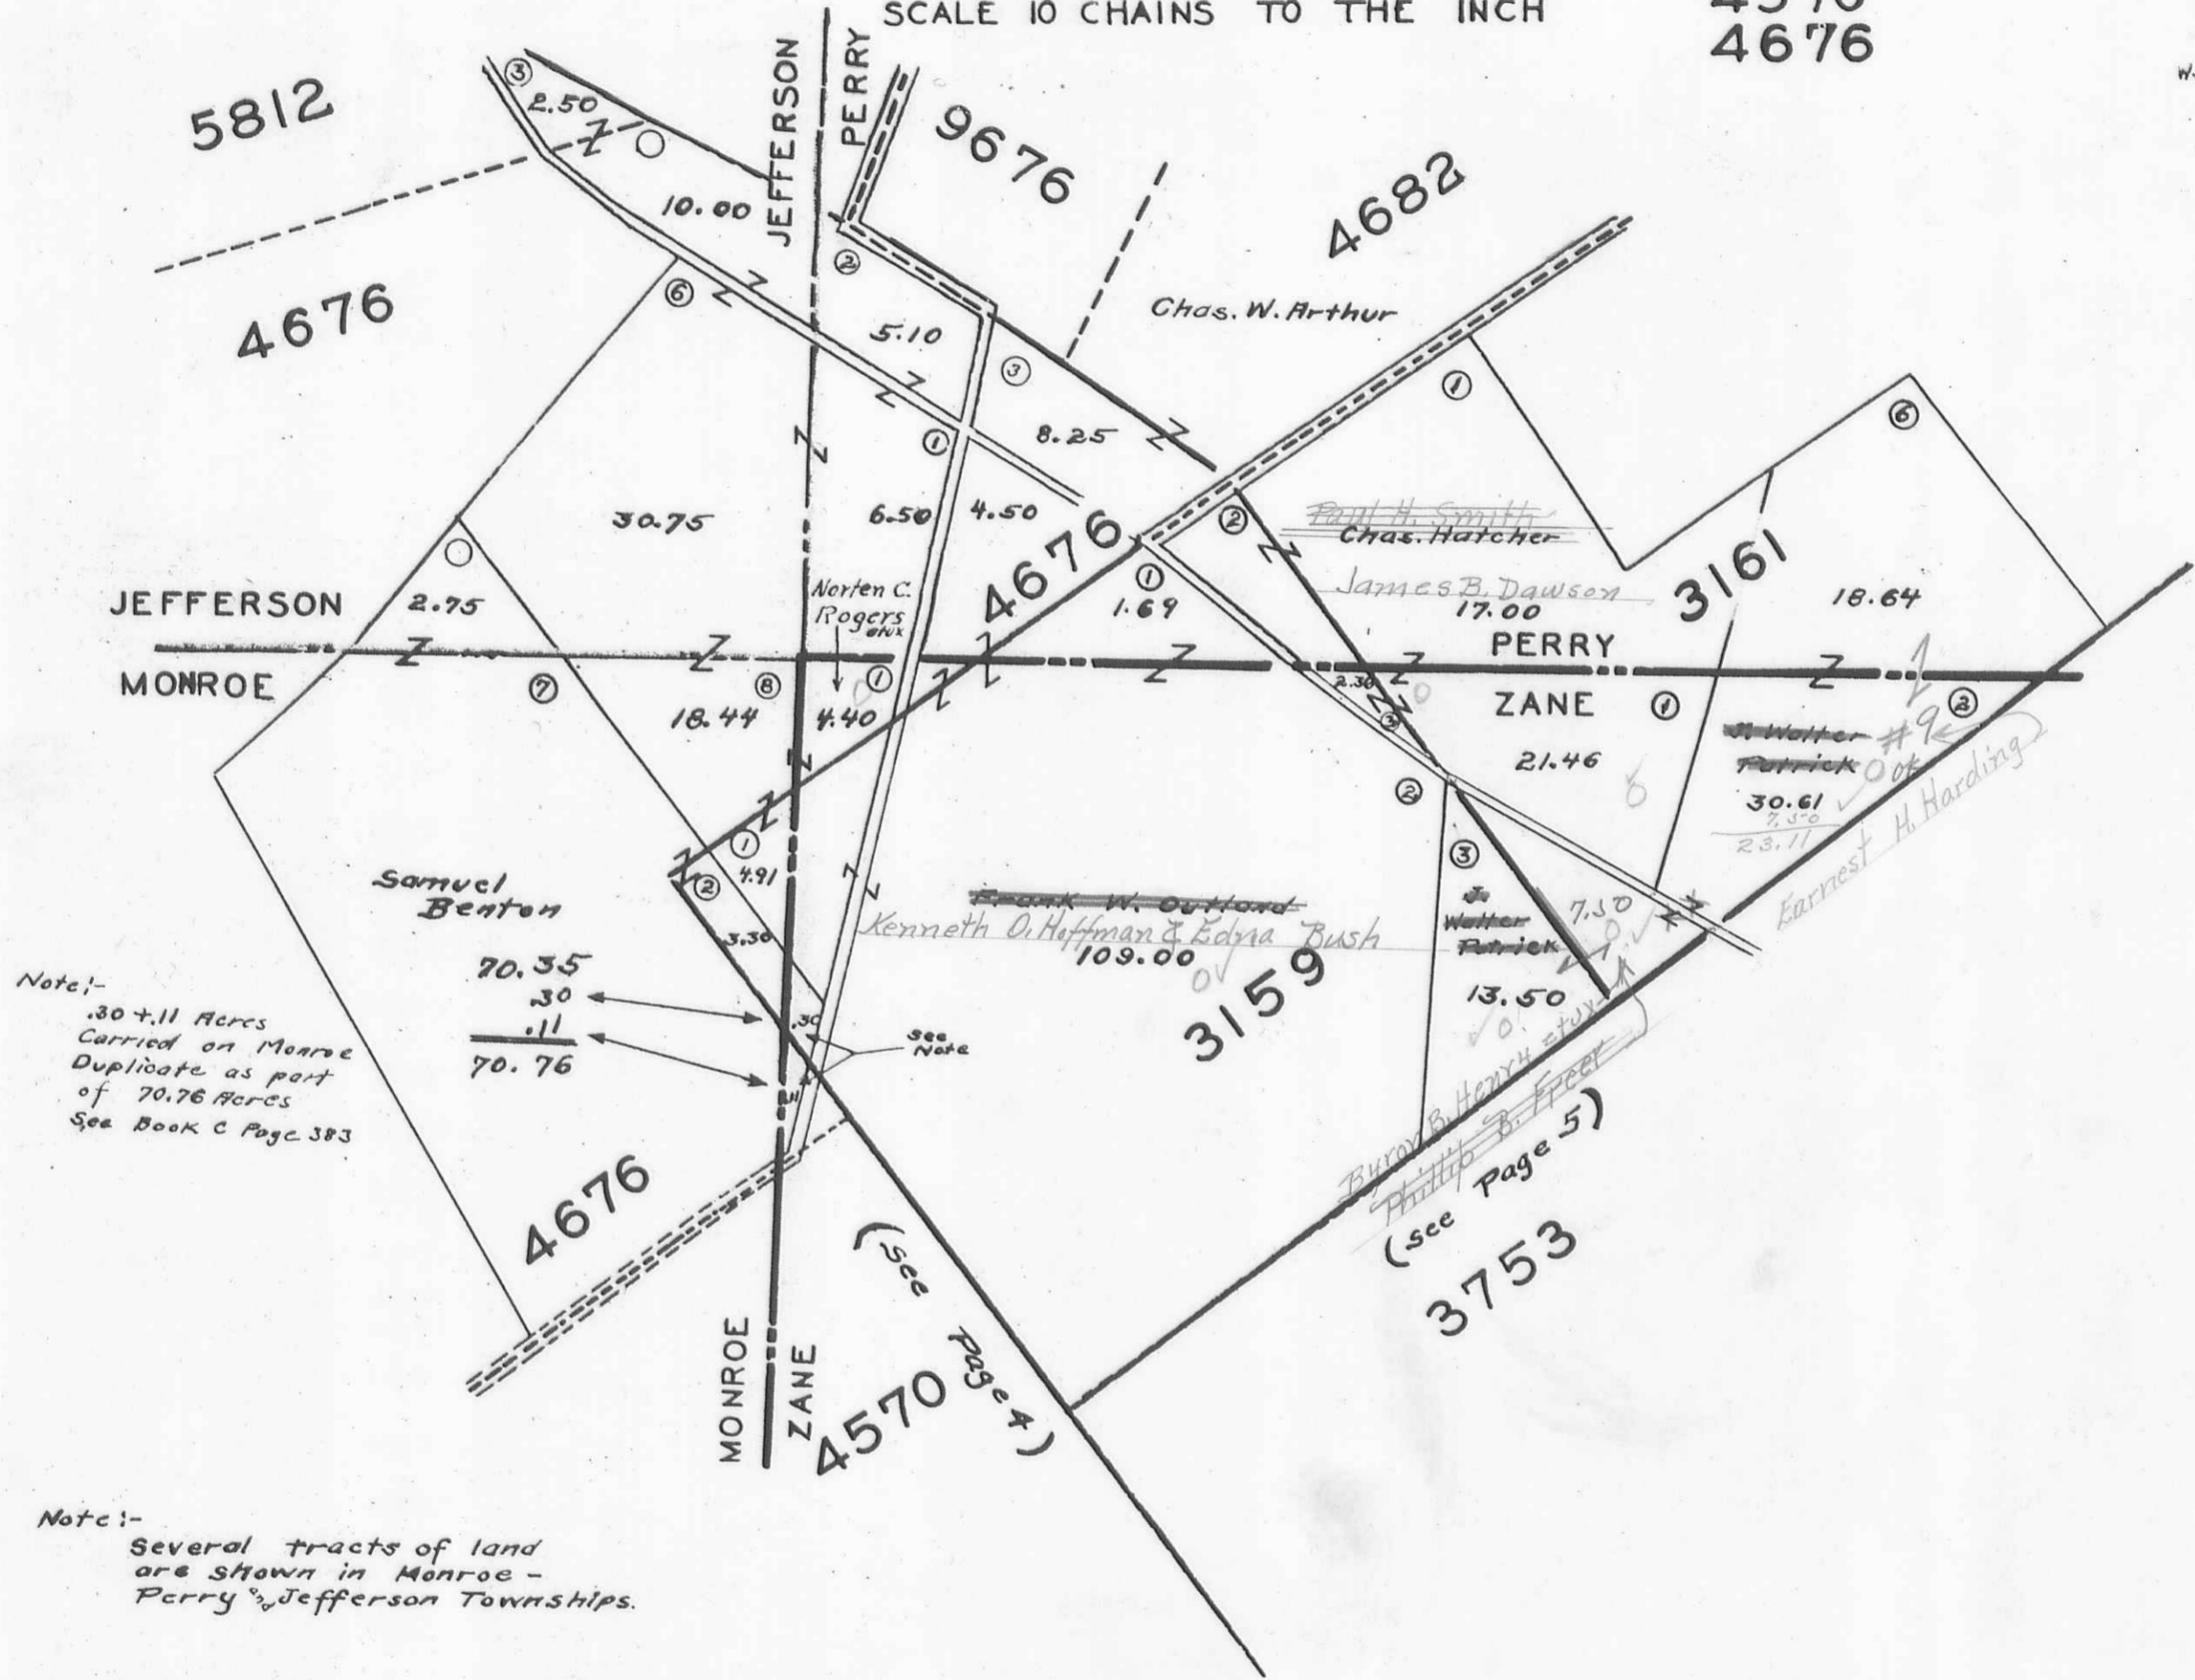


Note:-
 .30 + .11 Acres
 Carried on Monroe
 Duplicate as part
 of 70.76 Acres
 See Book C Page 383

Note:-
 Several tracts of land
 are shown in Monroe -
 Perry & Jefferson Townships.

ZANE TOWNSHIP
 VIRGINIA MILITARY SURVEY 4570



SCALE 10 CHAINS TO THE INCH

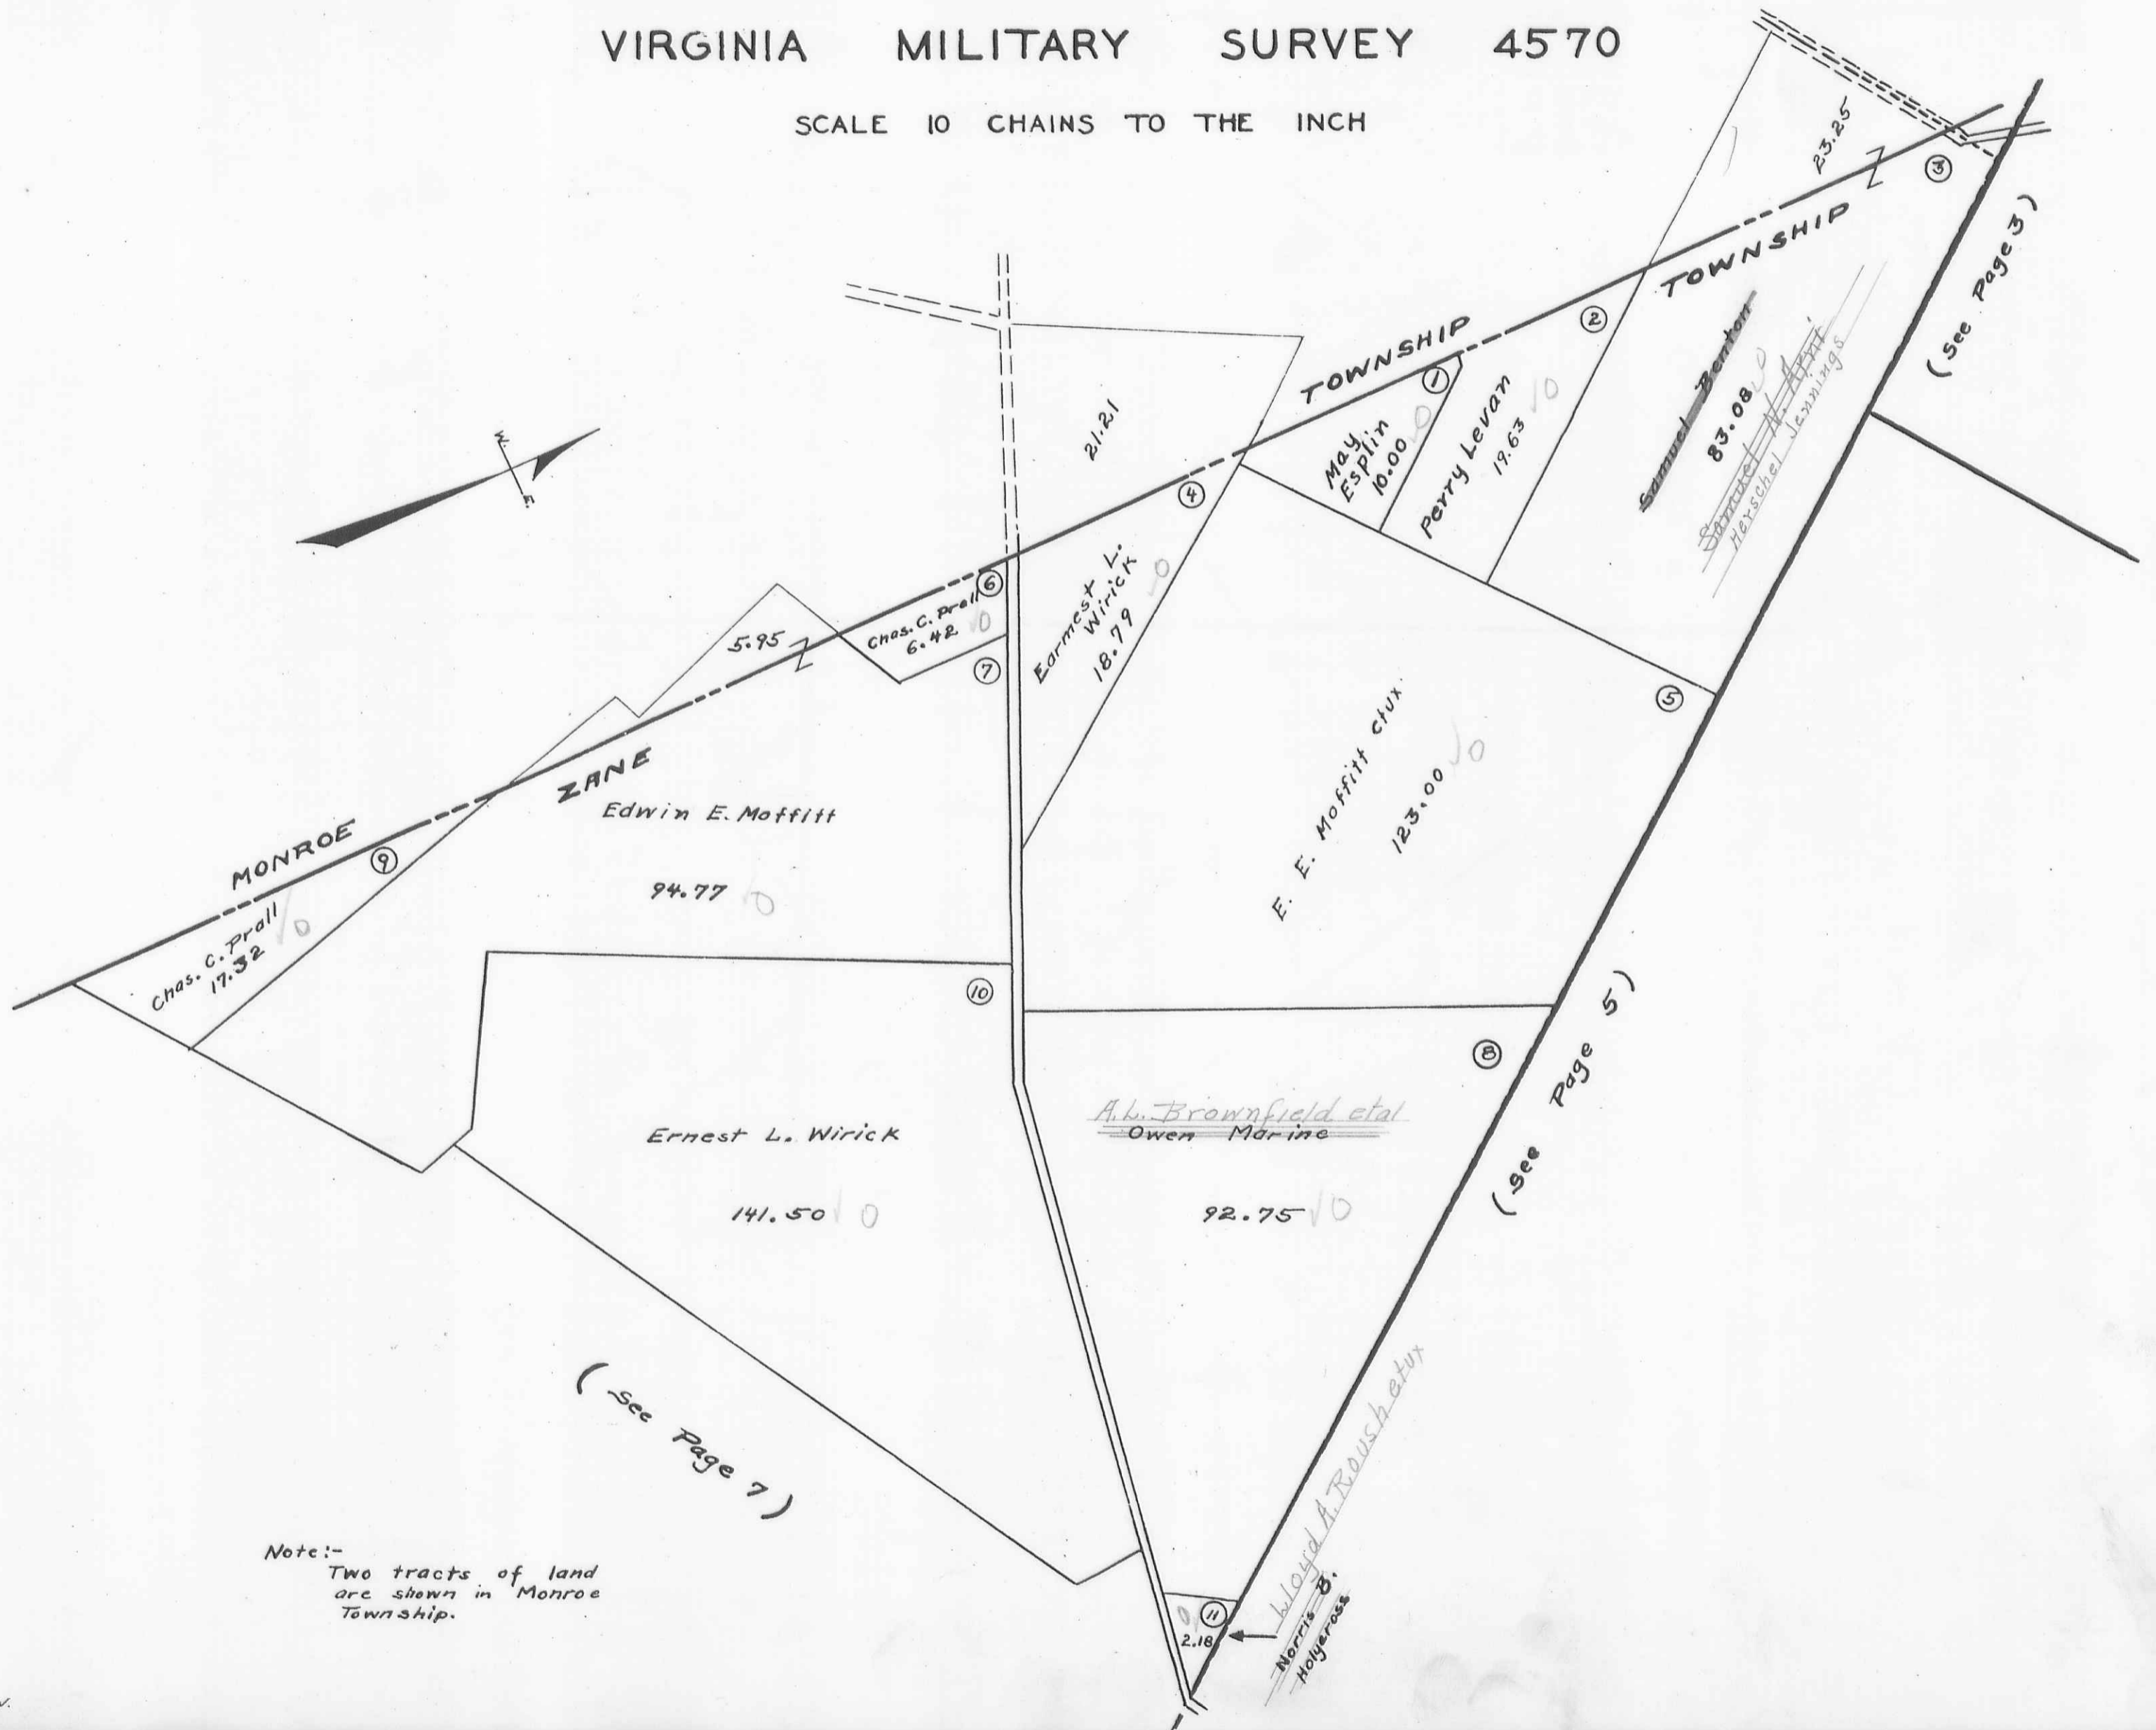

Note:-
 Two tracts of land
 are shown in Monroe
 Township.

ZANE TOWNSHIP
VIRGINIA MILITARY SURVEY 3753

SCALE 10 CHAINS TO THE INCH
(See Page 3)

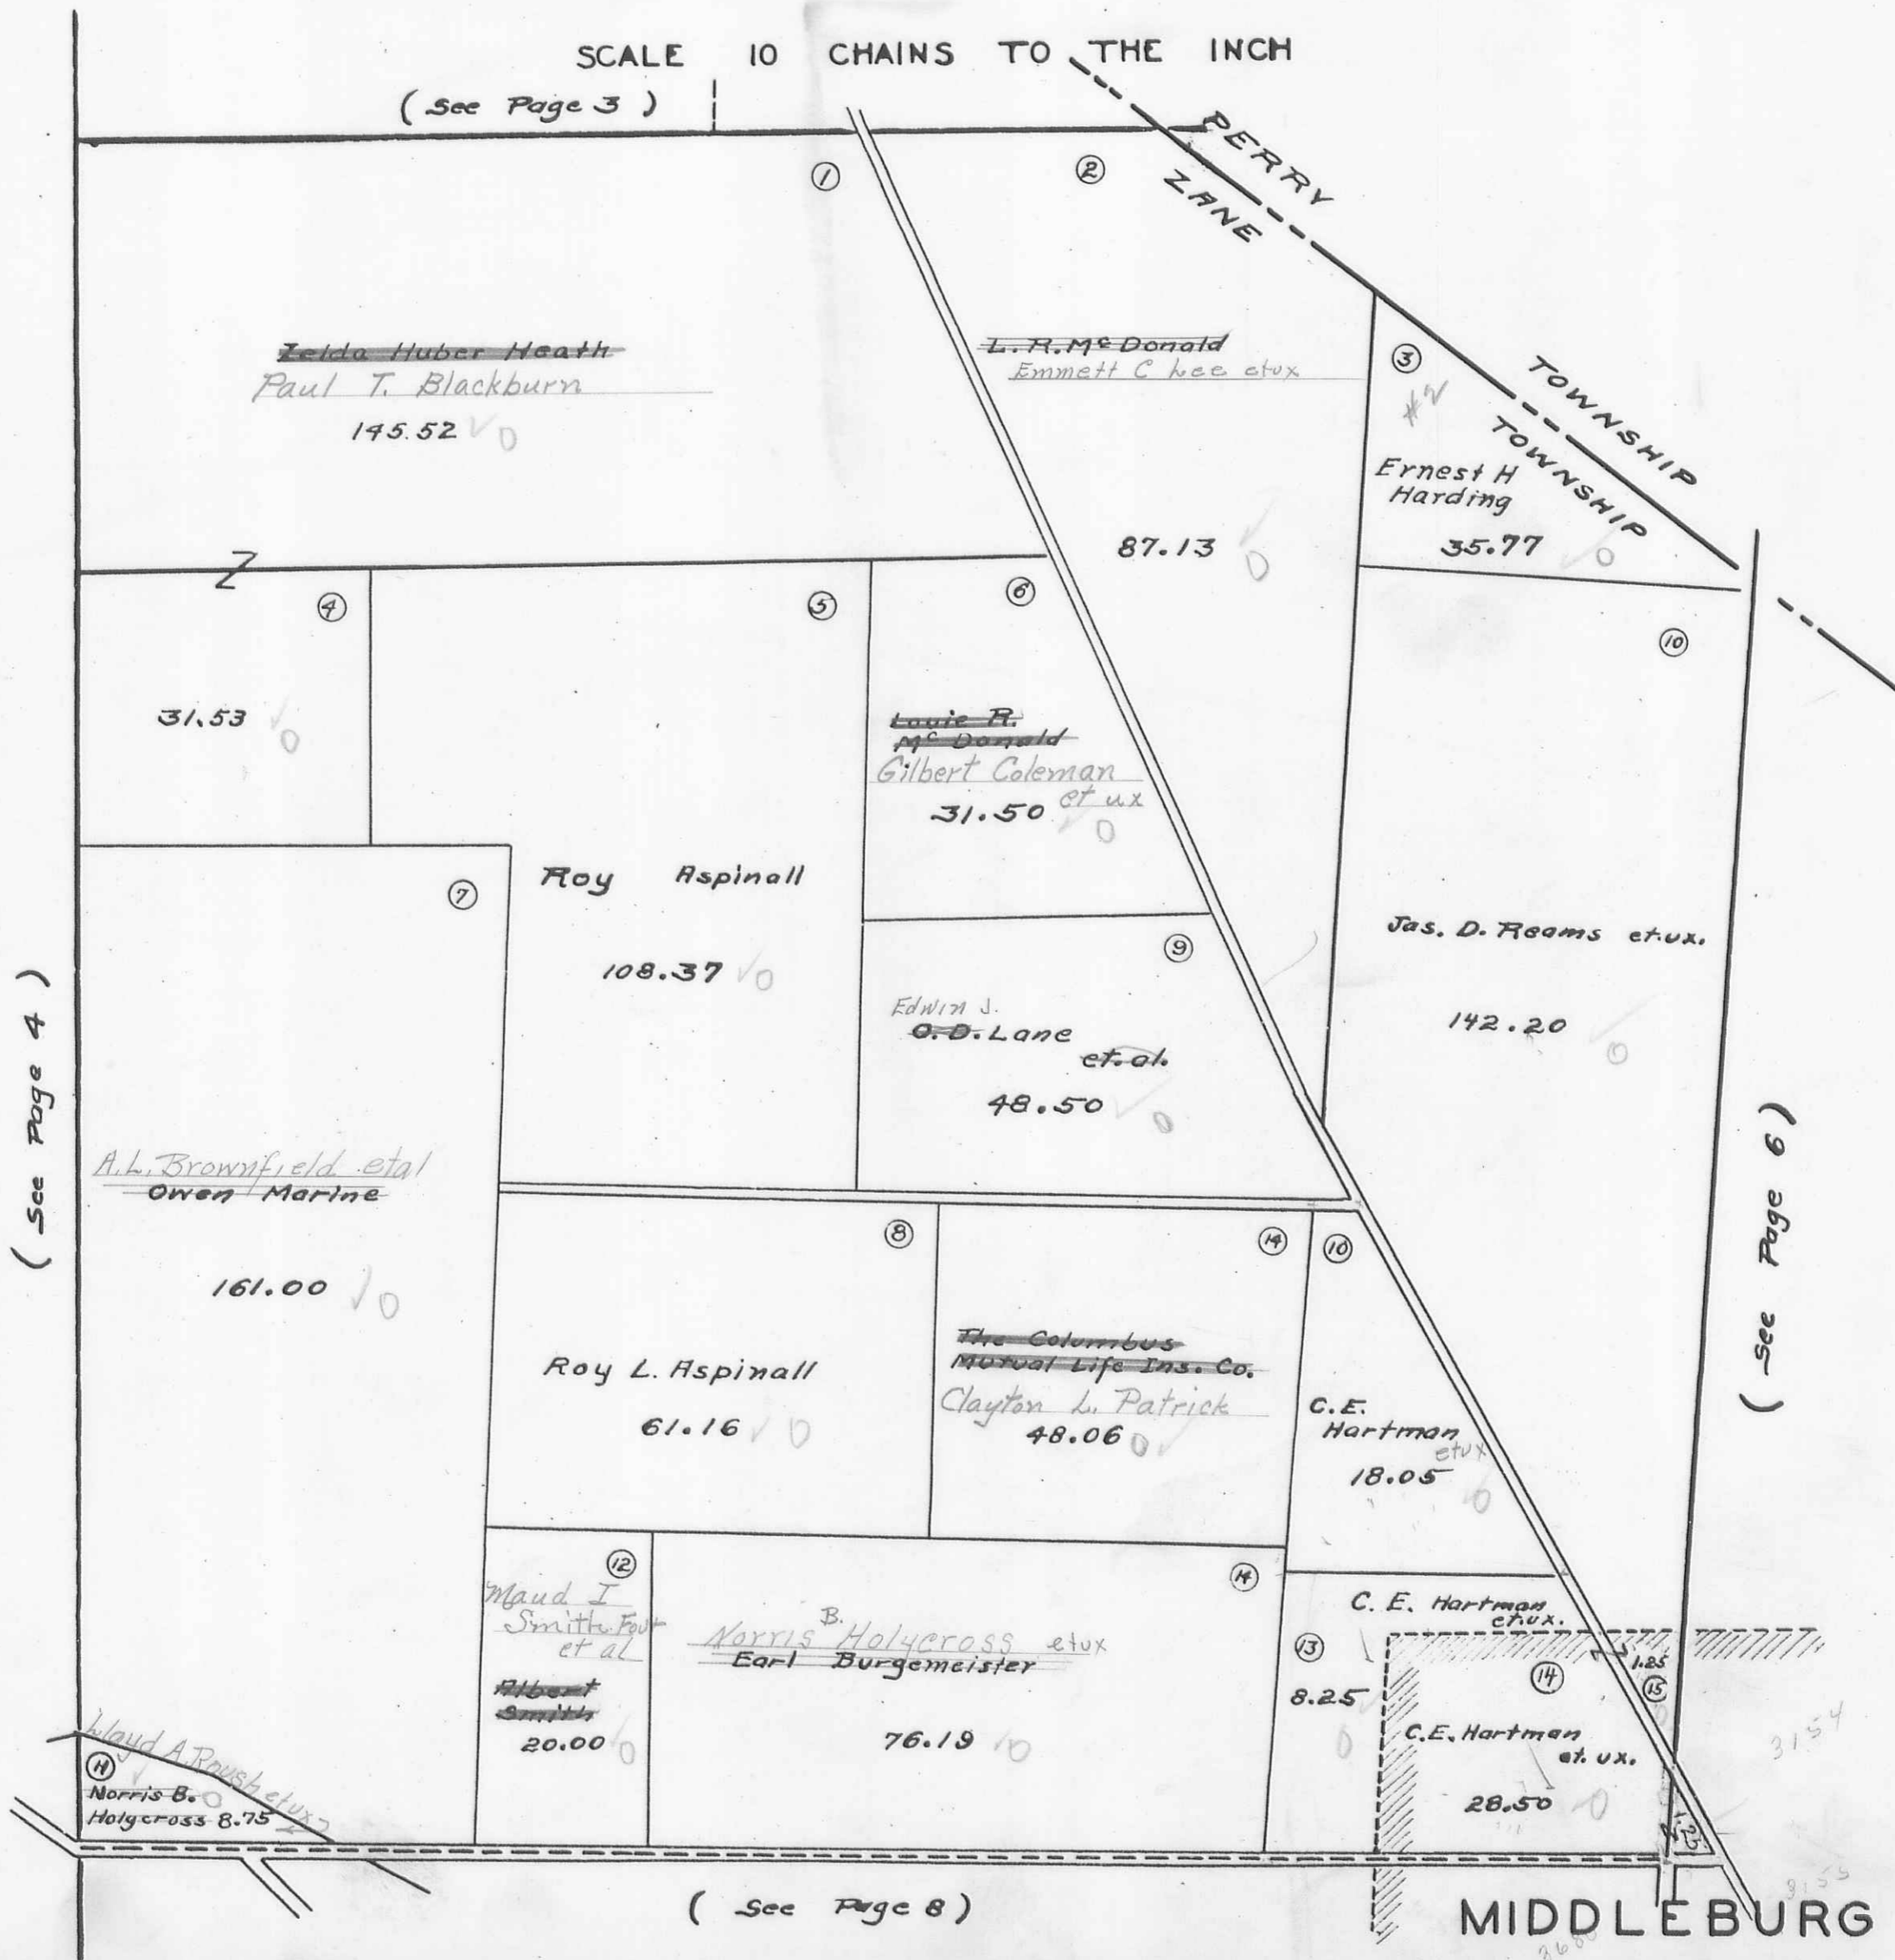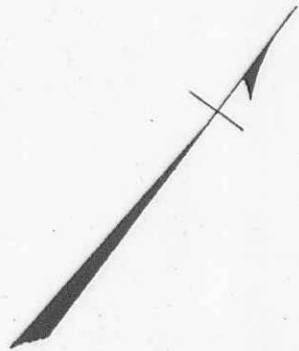

(See Page 4)

(See Page 6)


(See Page 8)

MIDDLEBURG

ZANE TOWNSHIP
 VIRGINIA MILITARY SURVEY 3154



SCALE 10 CHAINS TO THE INCH

6861
 17910
 19771
 12877
 2050
 19927

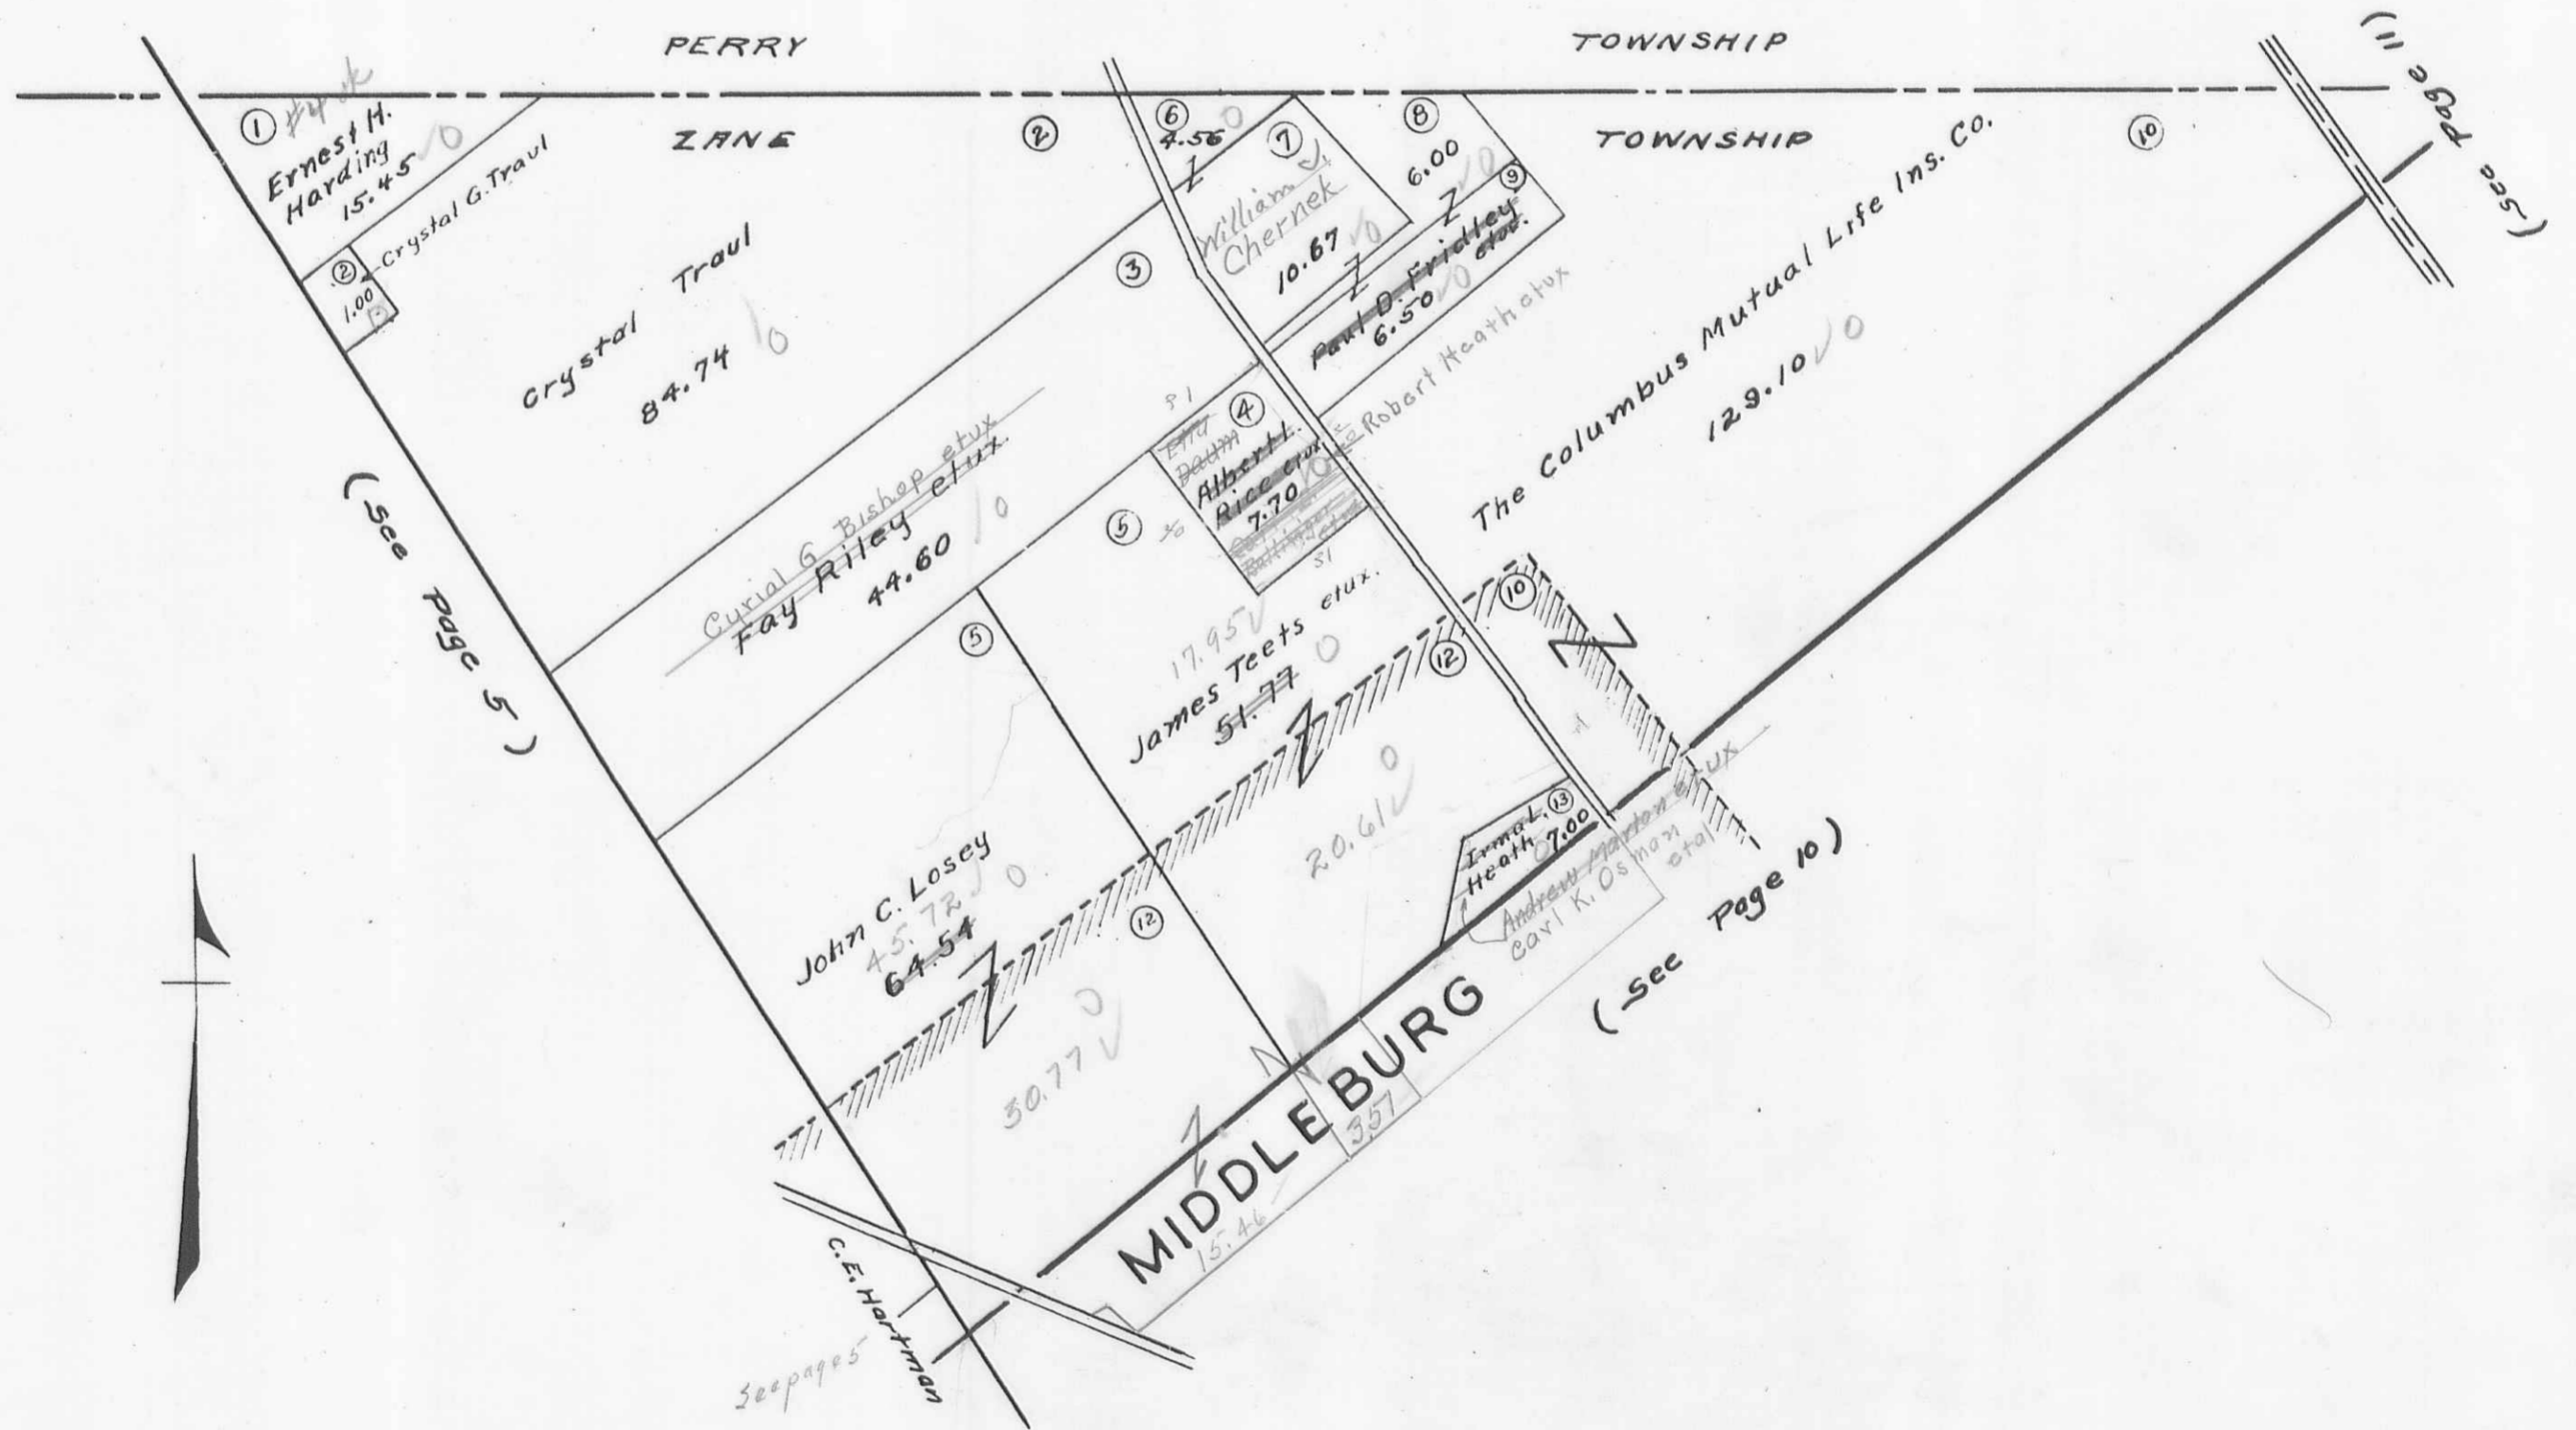

ZANE TOWNSHIP
VIRGINIA MILITARY SURVEY 4570



SCALE 10 CHAINS TO THE INCH

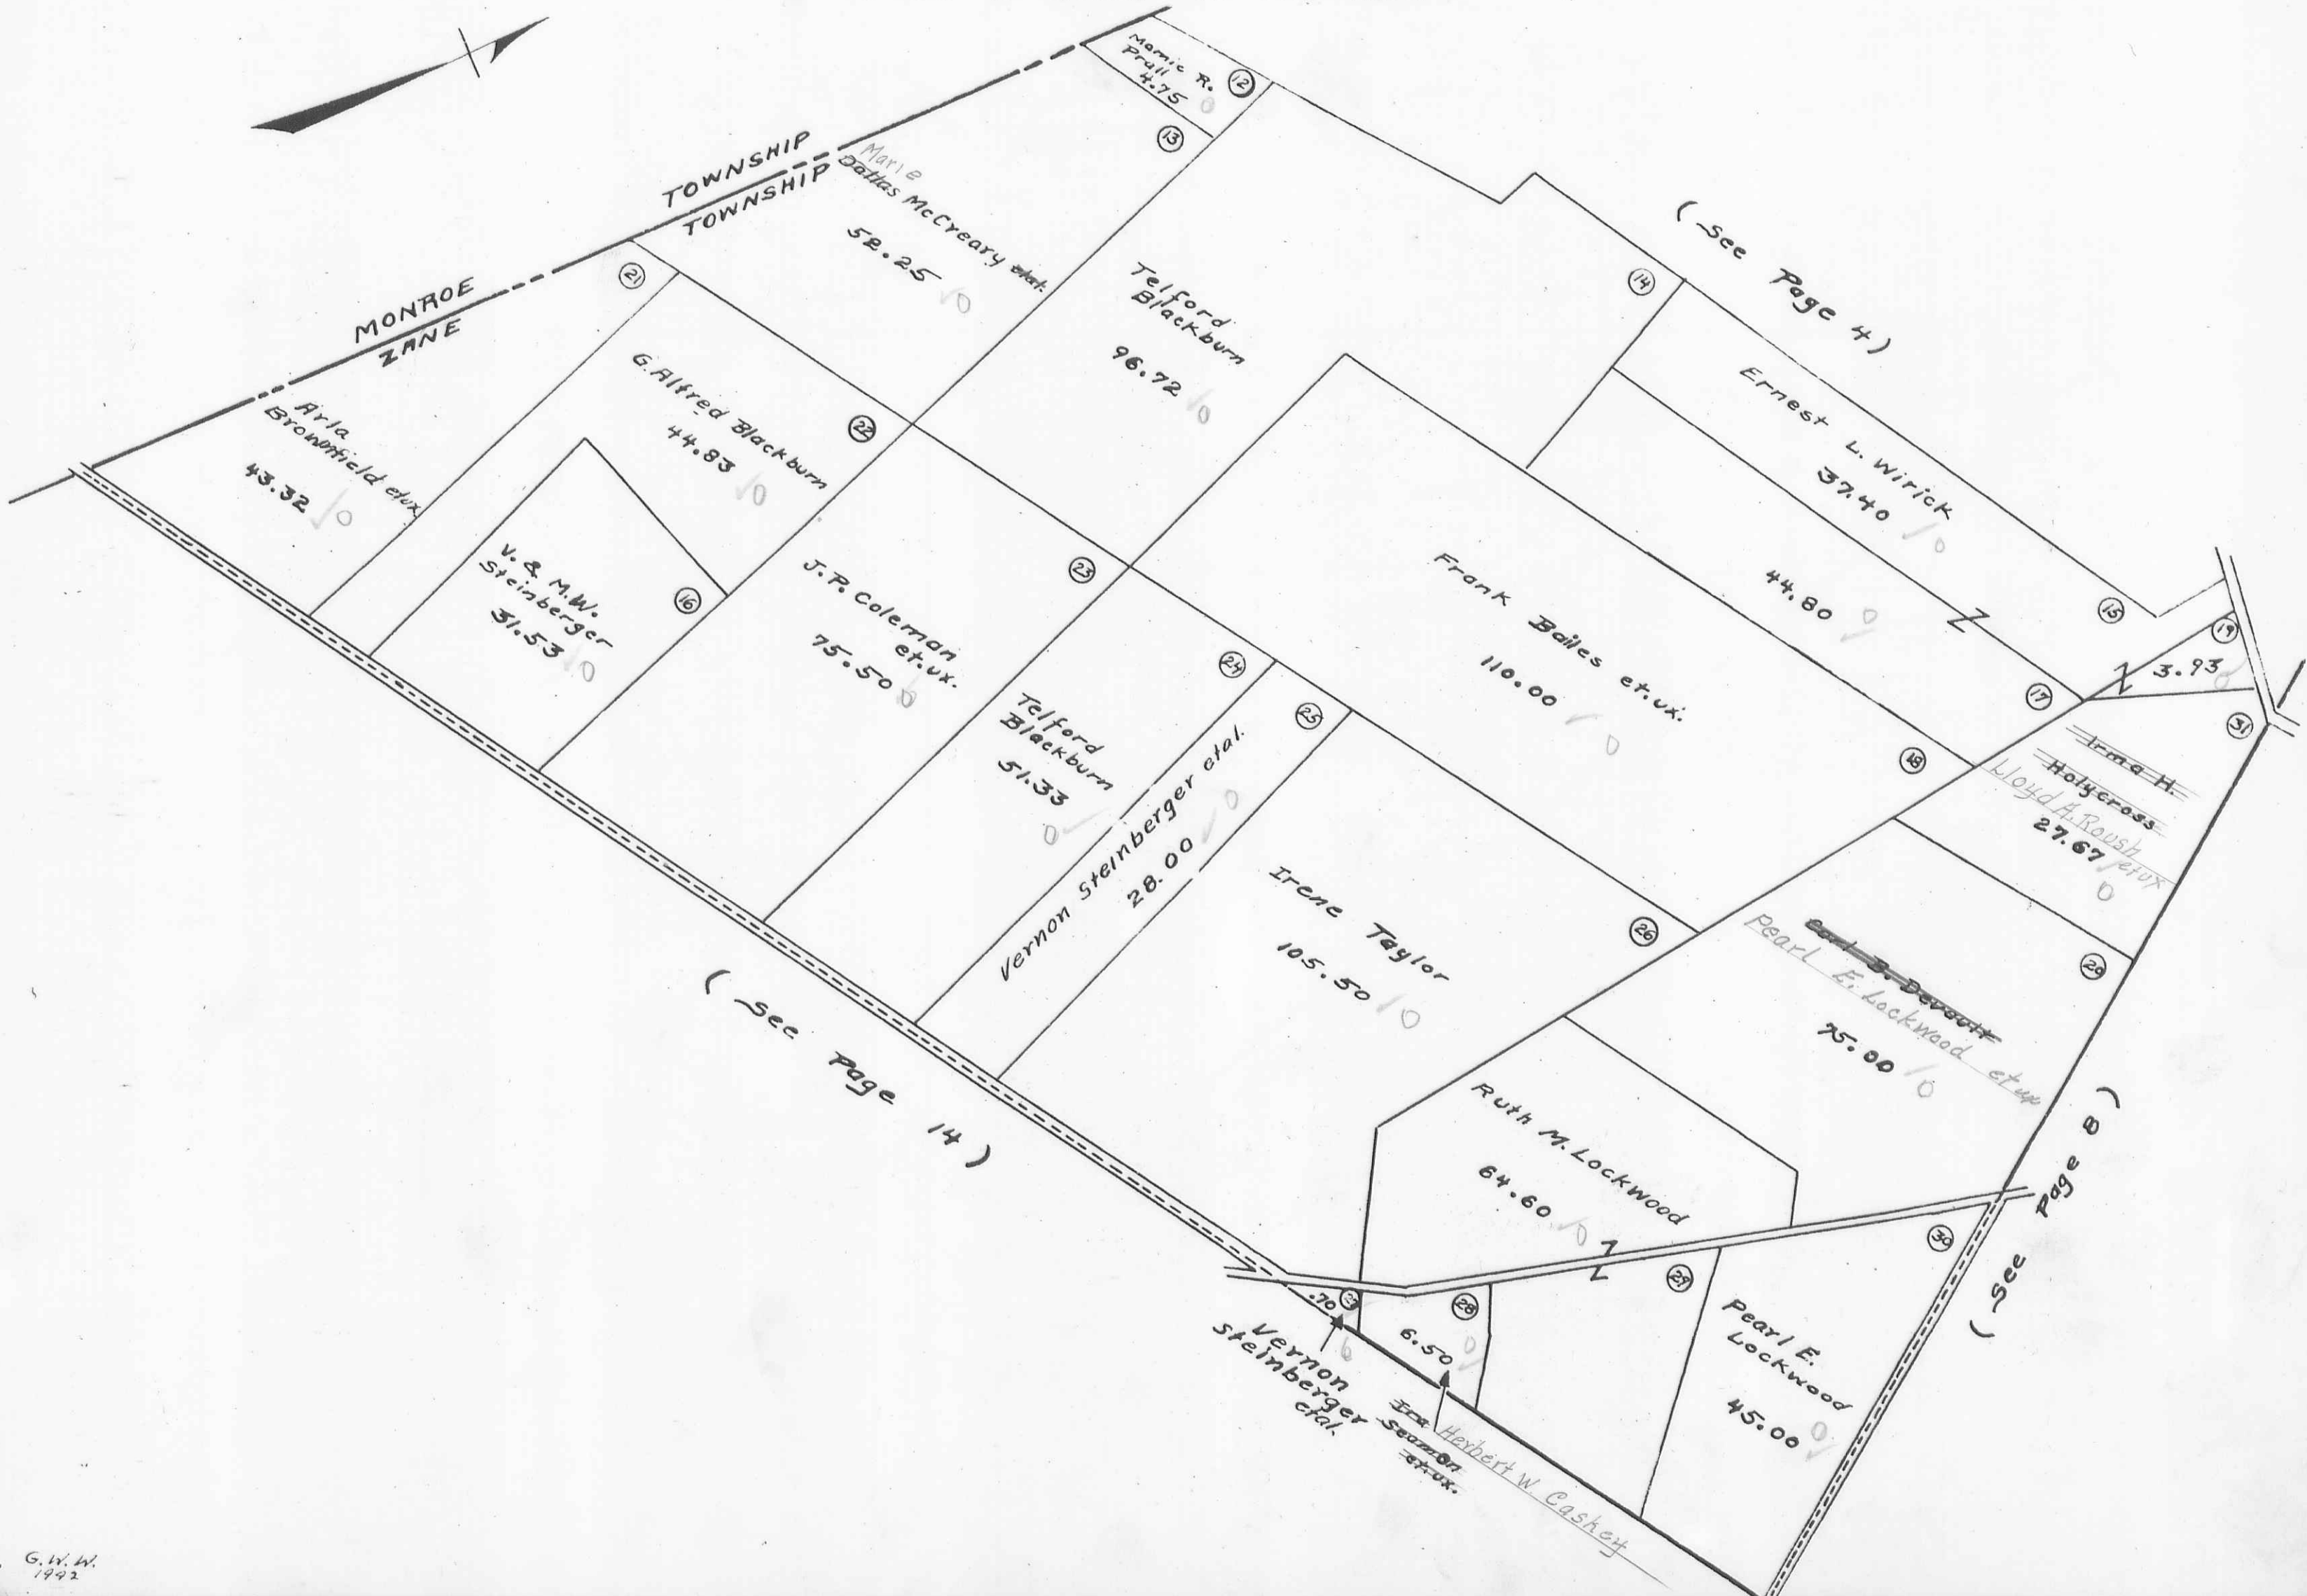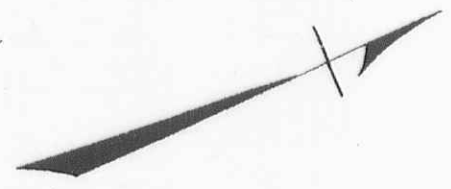

ZANE TOWNSHIP
VIRGINIA MILITARY SURVEY 3680


SCALE 10 CHAINS TO THE INCH

See Page 5

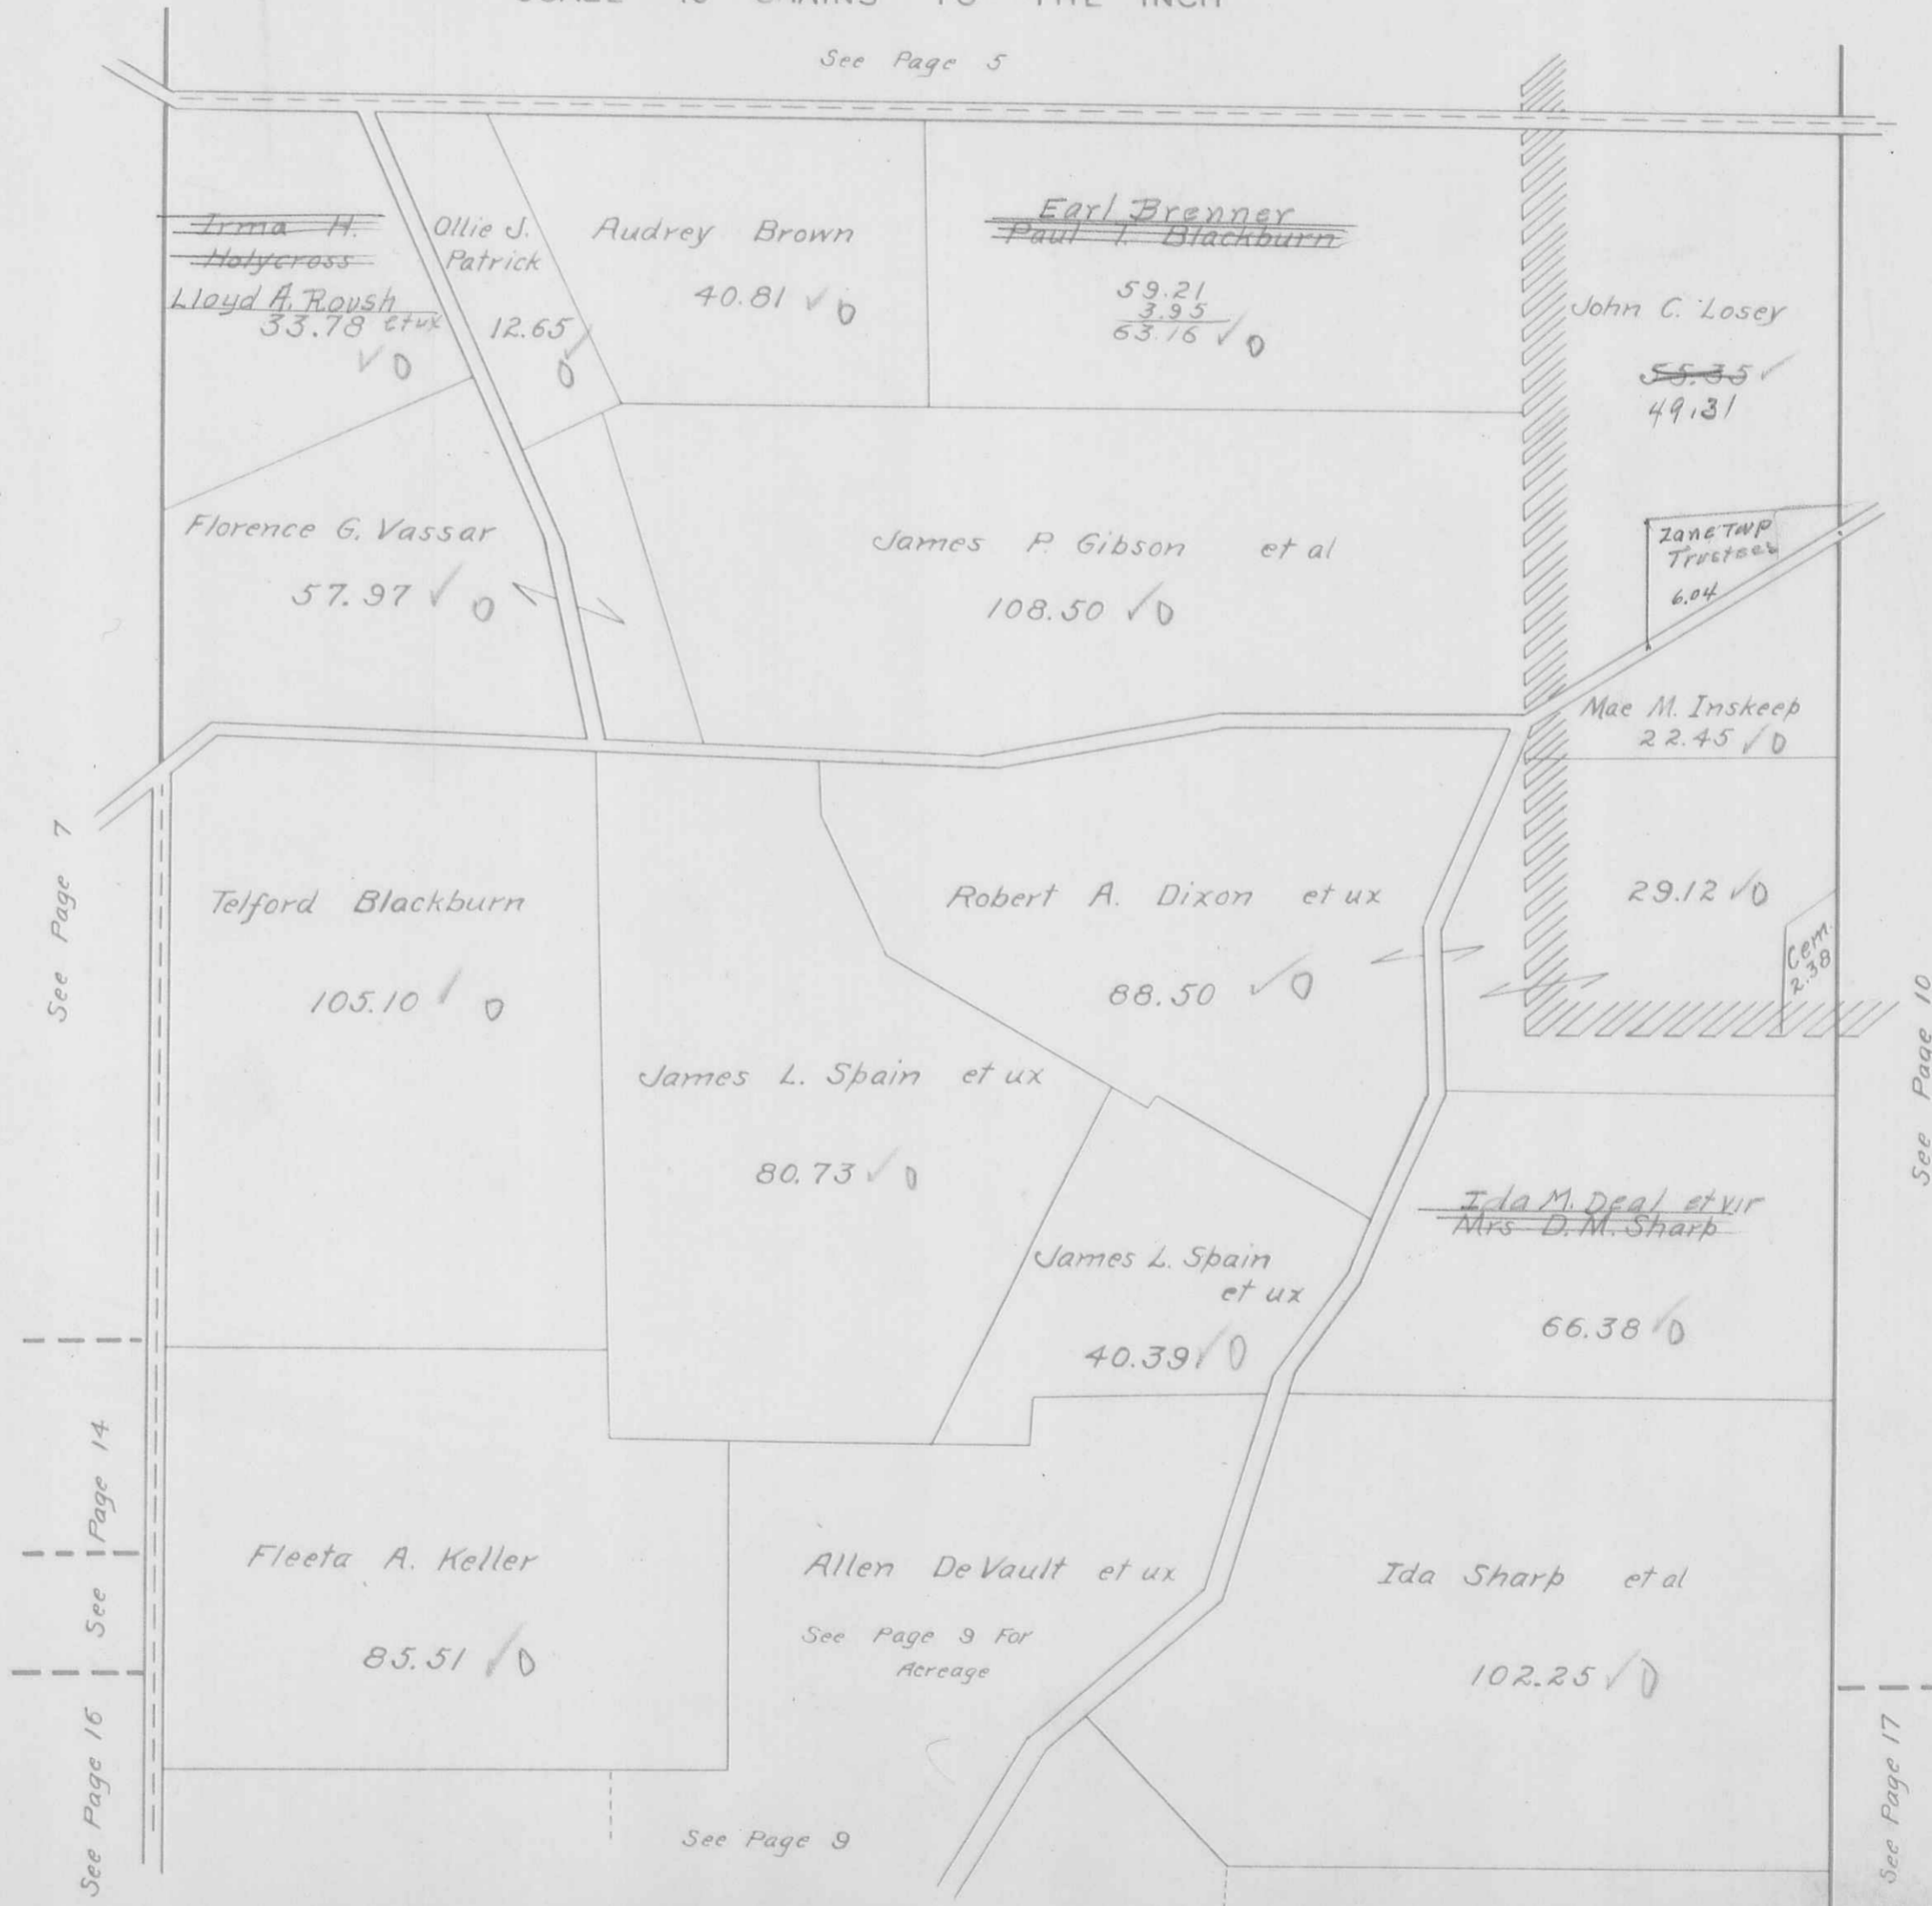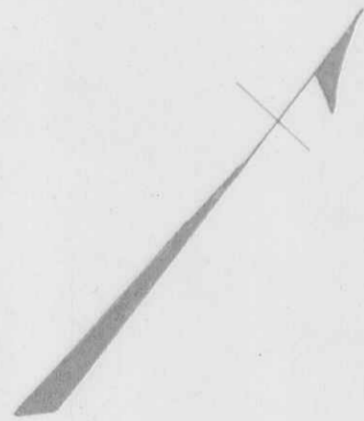


ZANE TOWNSHIP
 VIRGINIA MILITARY SURVEY 3680

SCALE 10 CHAINS TO THE INCH

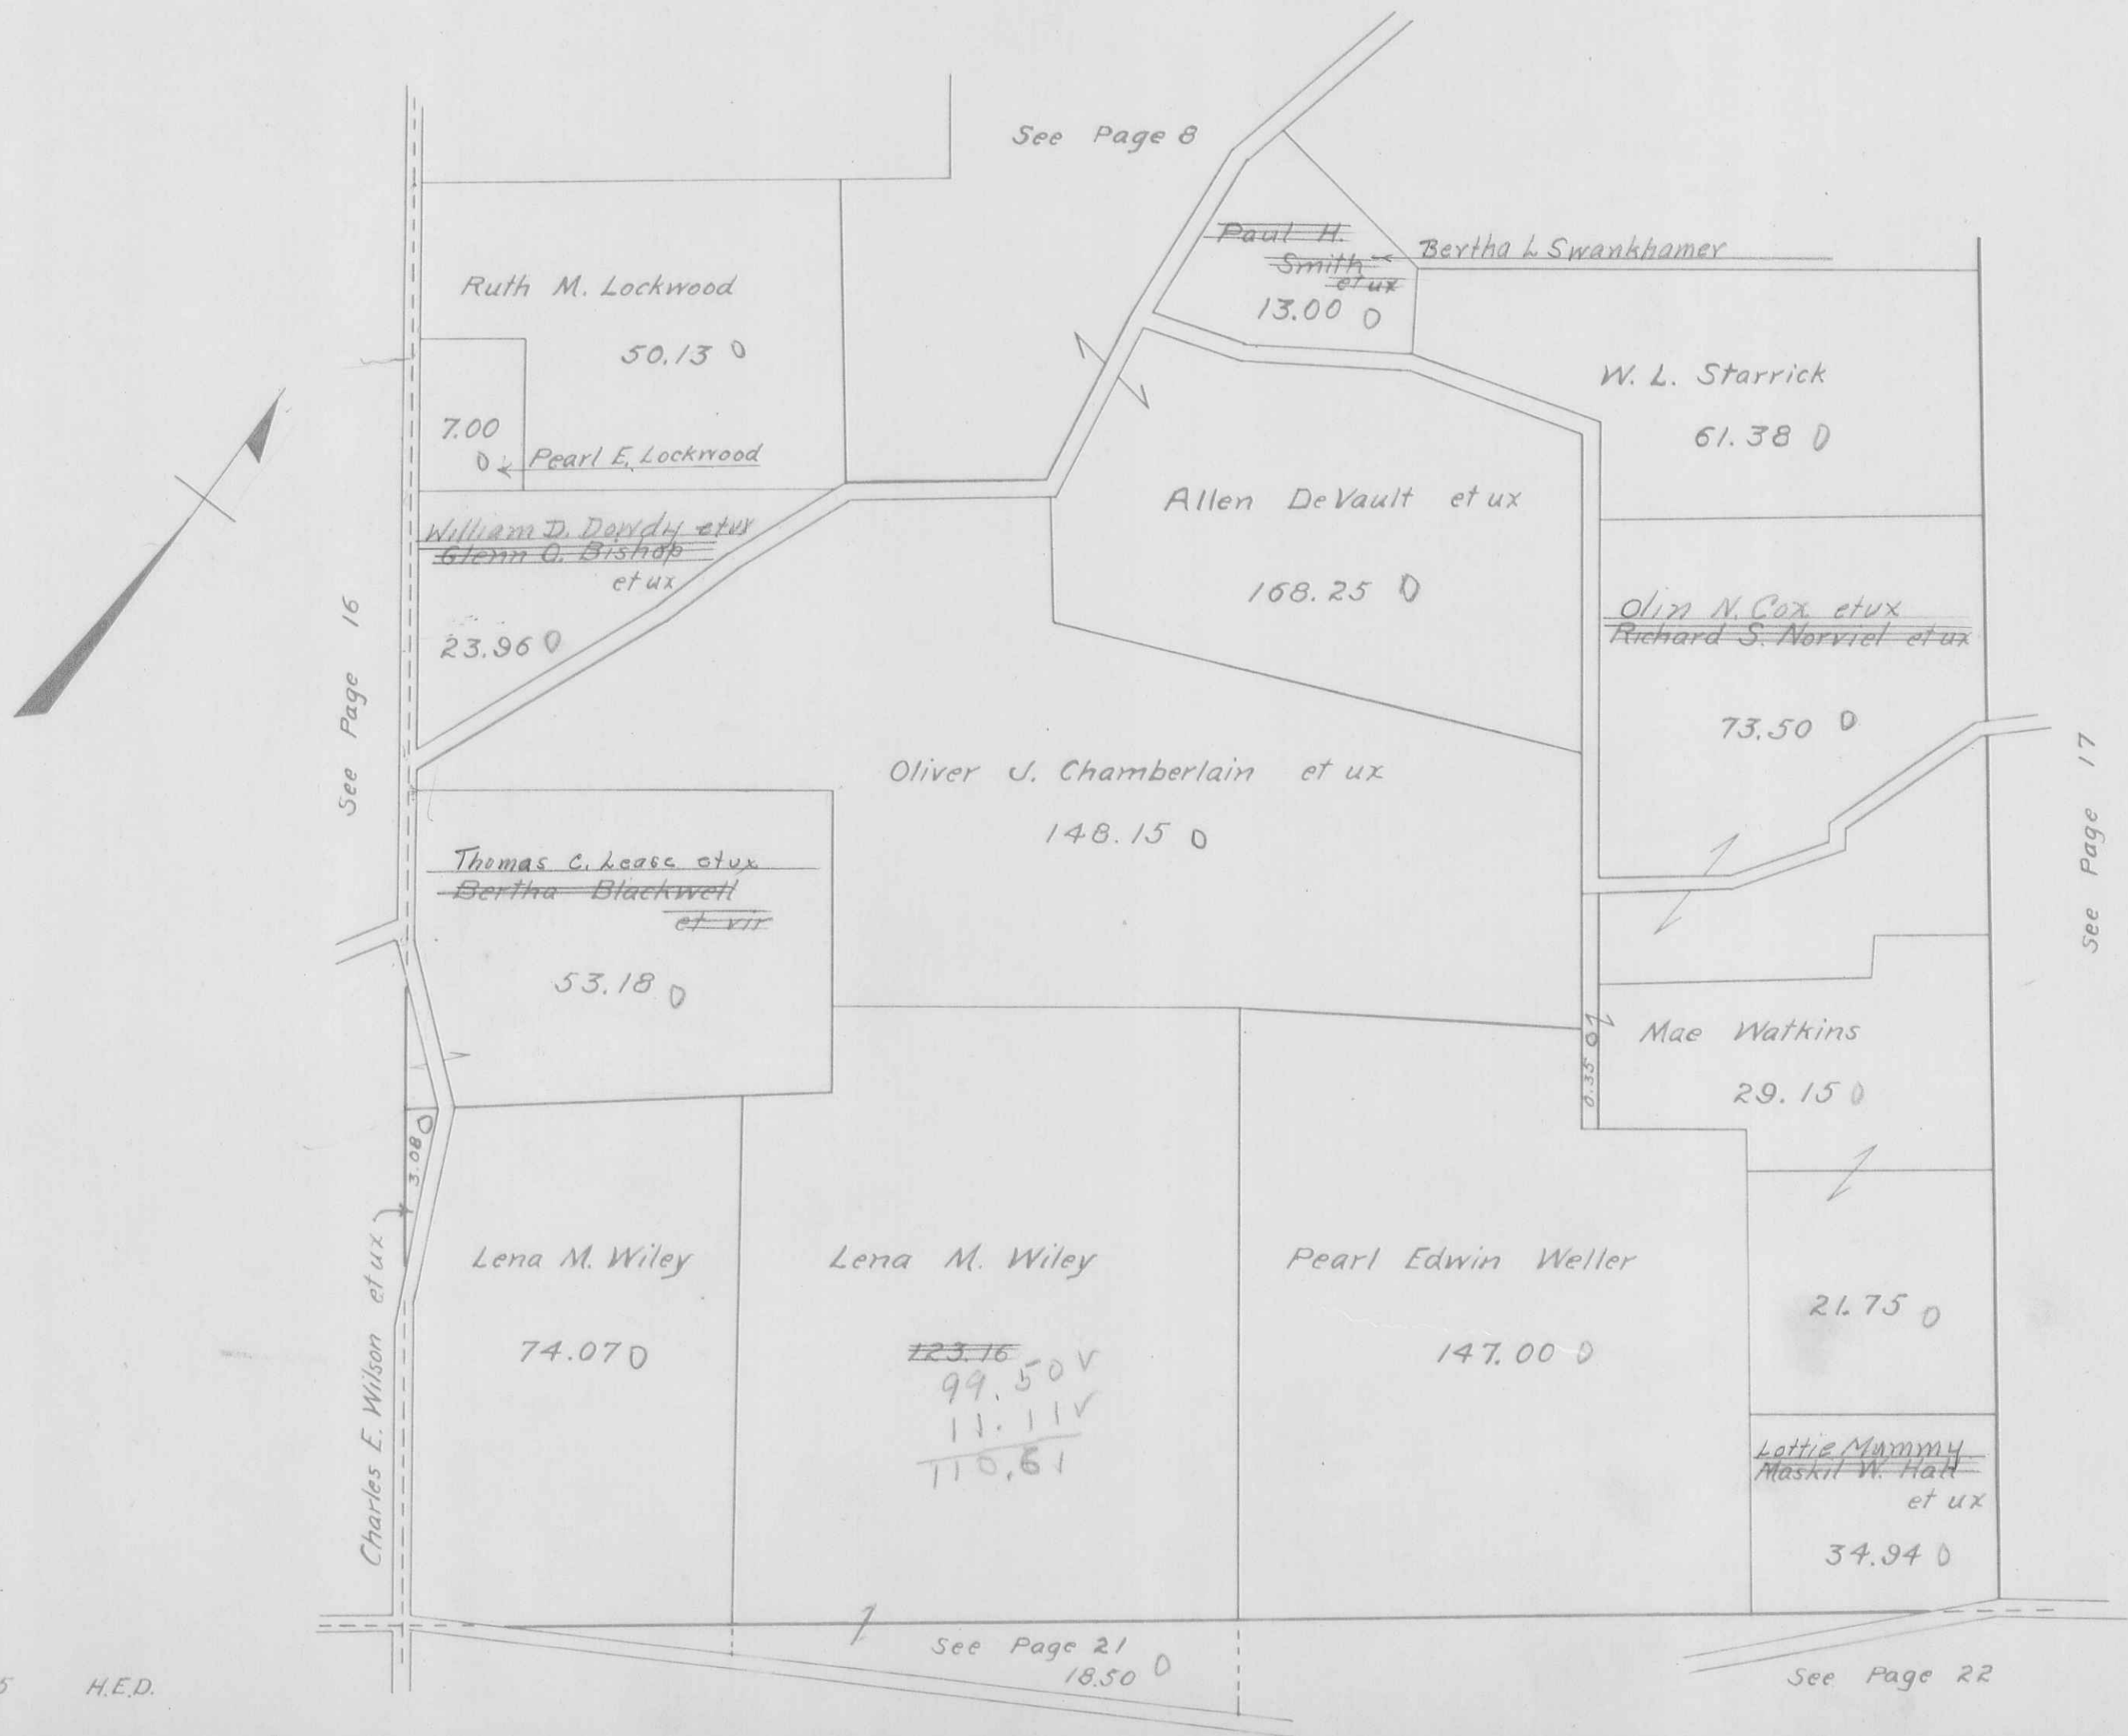

Z A N E T O W N S H I P
 VIRGINIA M I L I T A R Y S U R V E Y 3 1 5 5

SCALE 10 CHAINS TO THE INCH

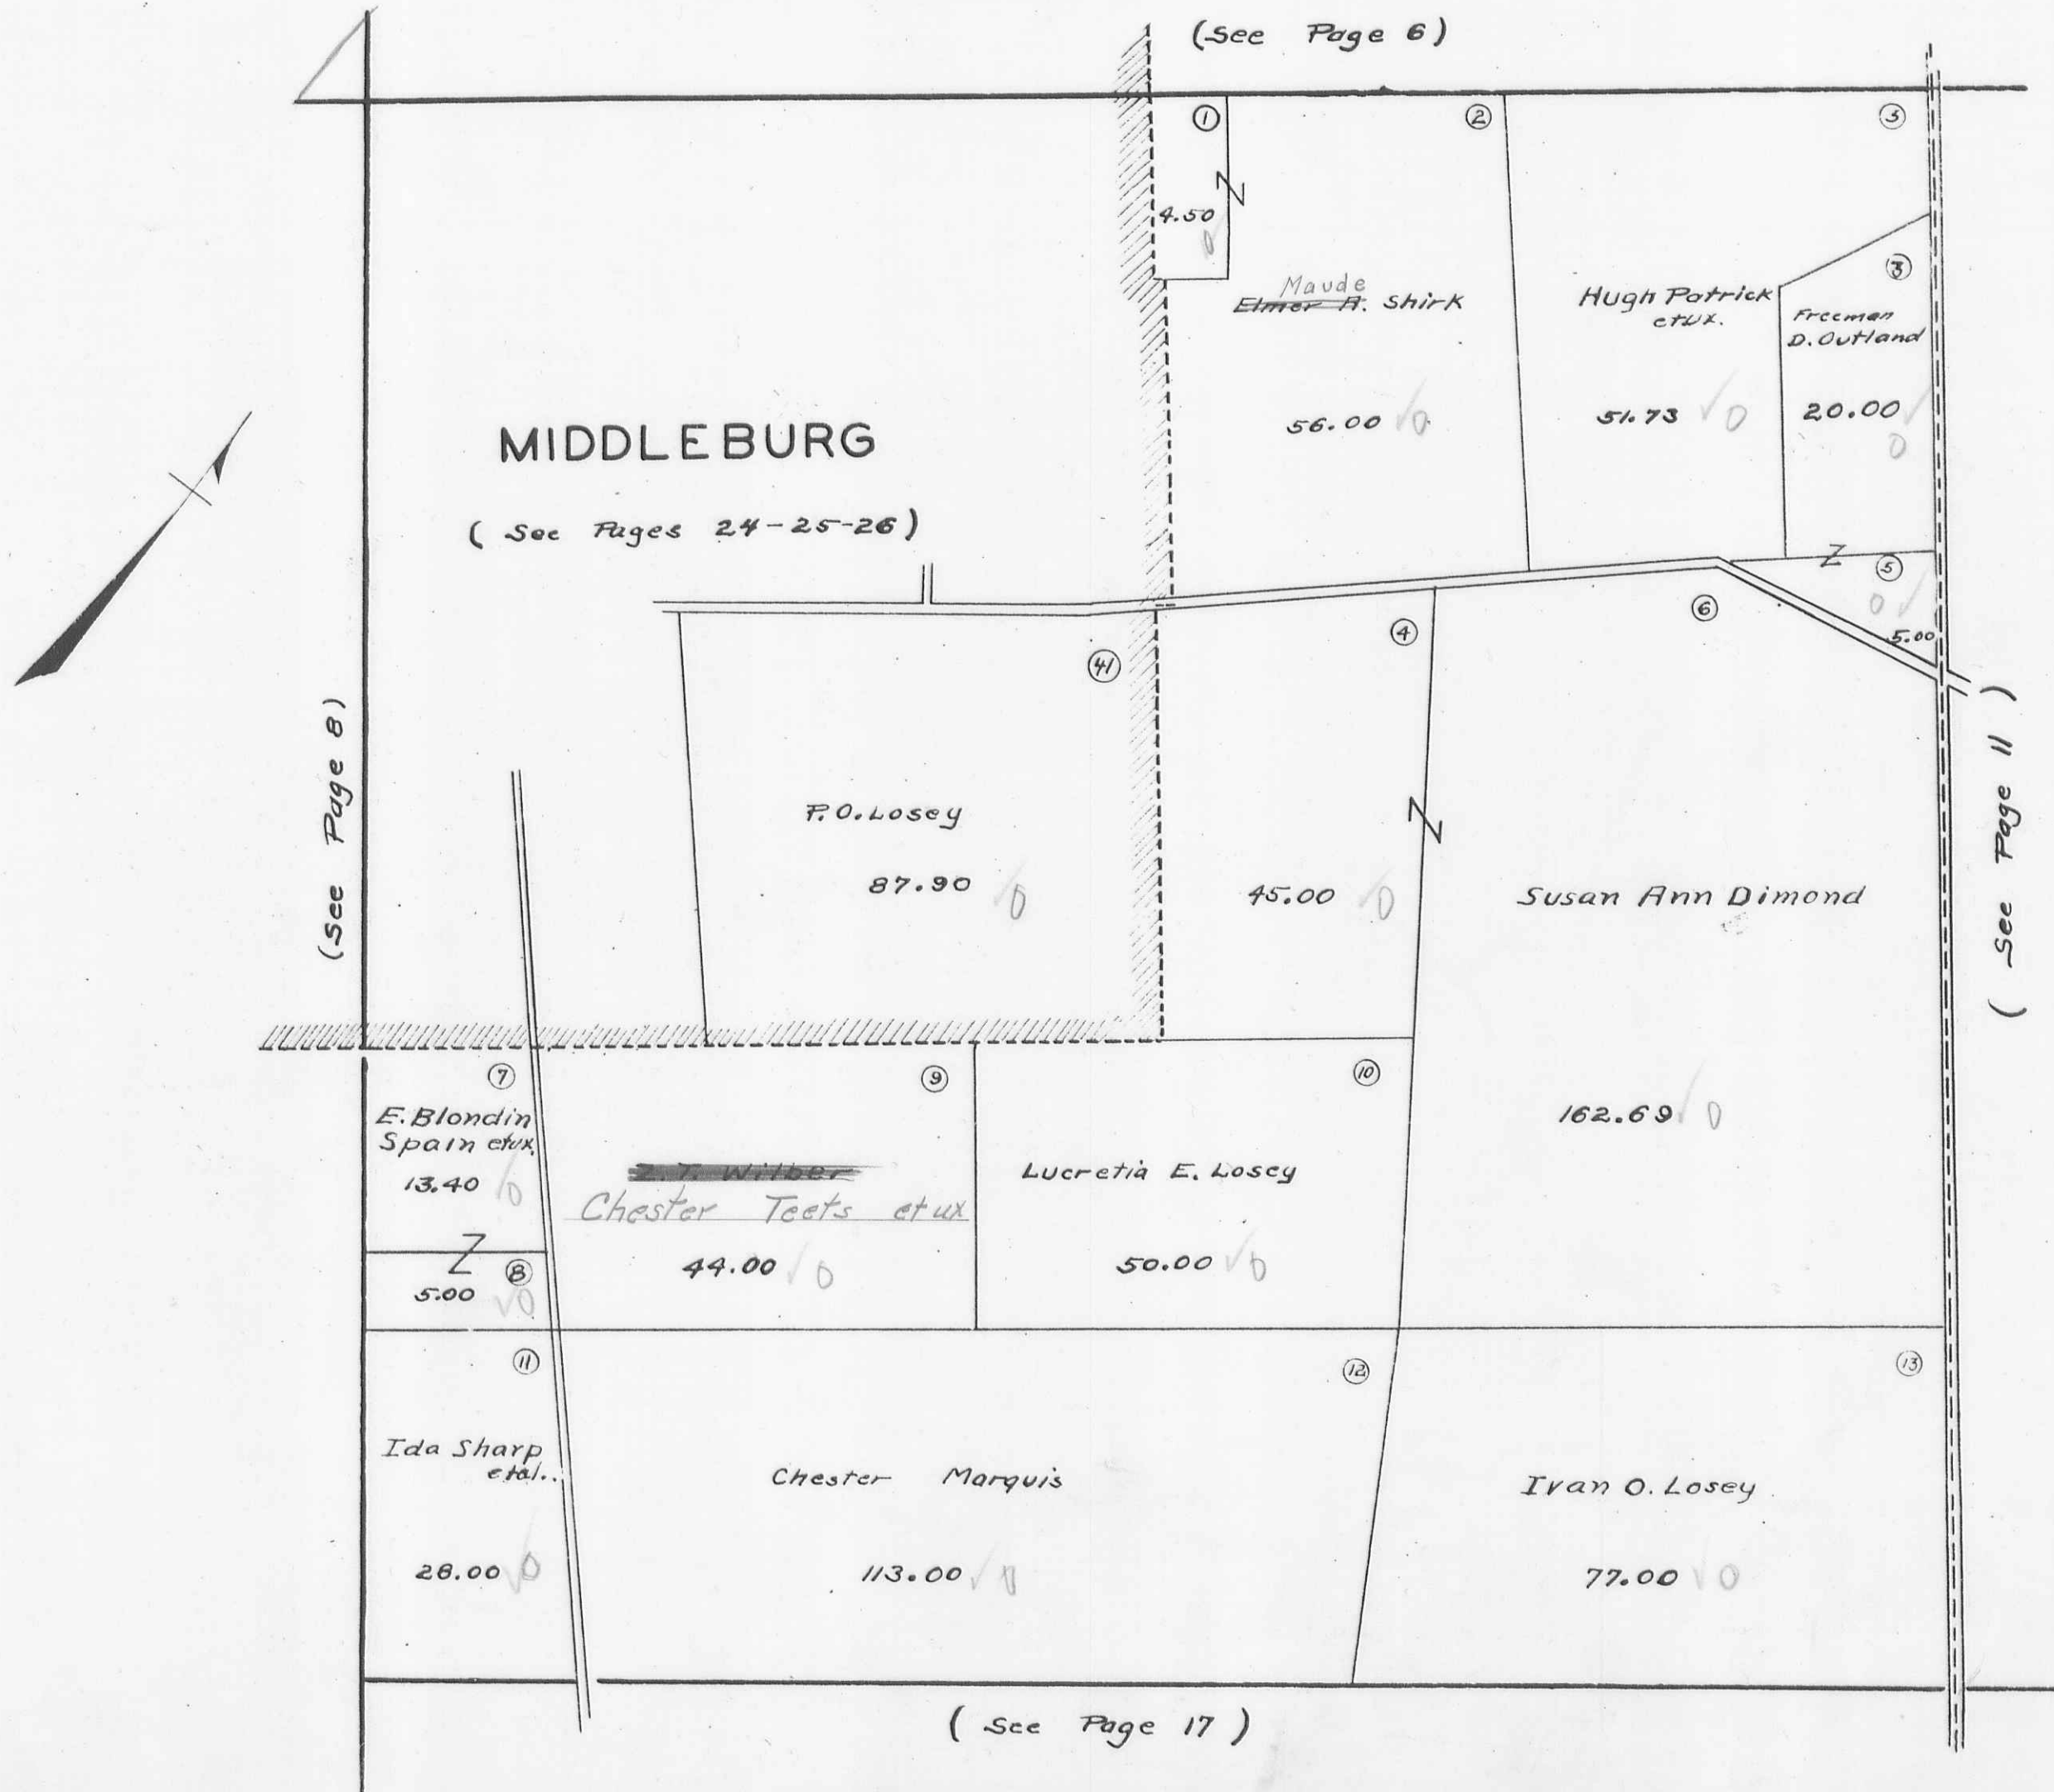

(See Page 6)


(See Page 8)

(See Page 11)

(See Page 17)

ZANE TOWNSHIP
VIRGINIA MILITARY SURVEYS 545 4811
 SCALE 10 CHAINS TO THE INCH


41.50
 3.32
 37.05
 21.05
 103.32

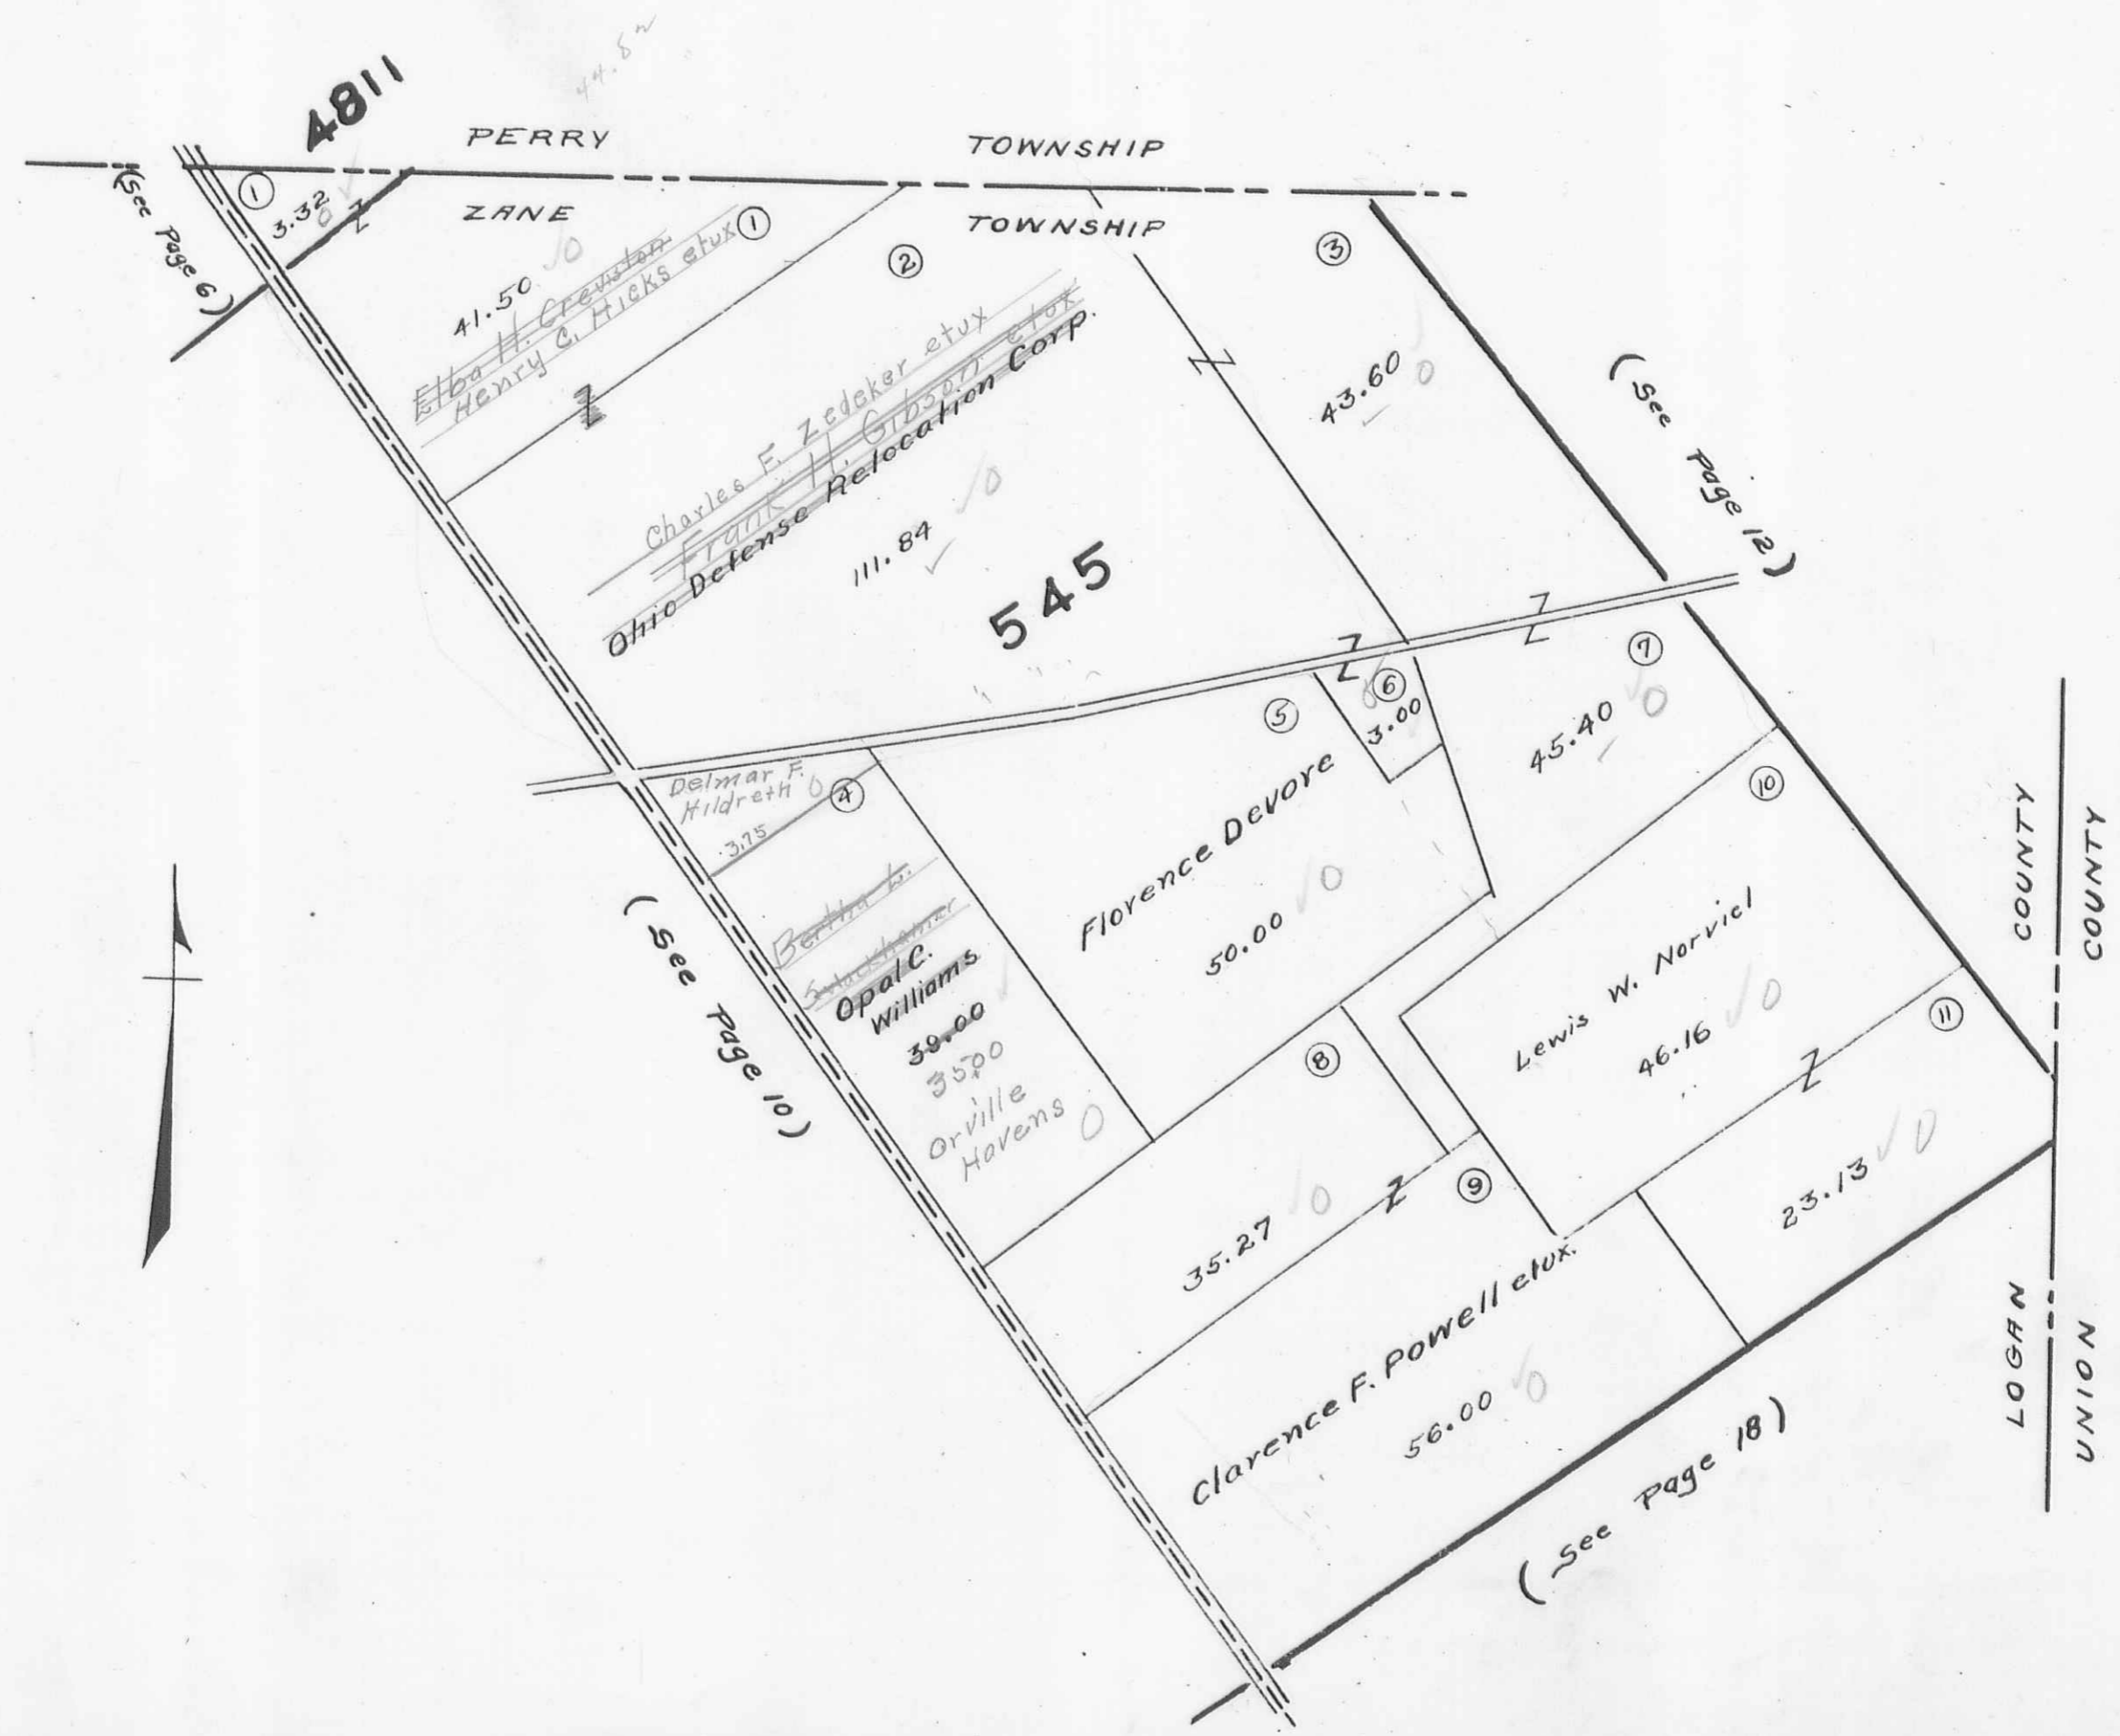

ZANE TOWNSHIP
 VIRGINIA MILITARY SURVEY


SCALE 10 CHAINS TO THE INCH

12395
 12399
 12402
 12427
 12428

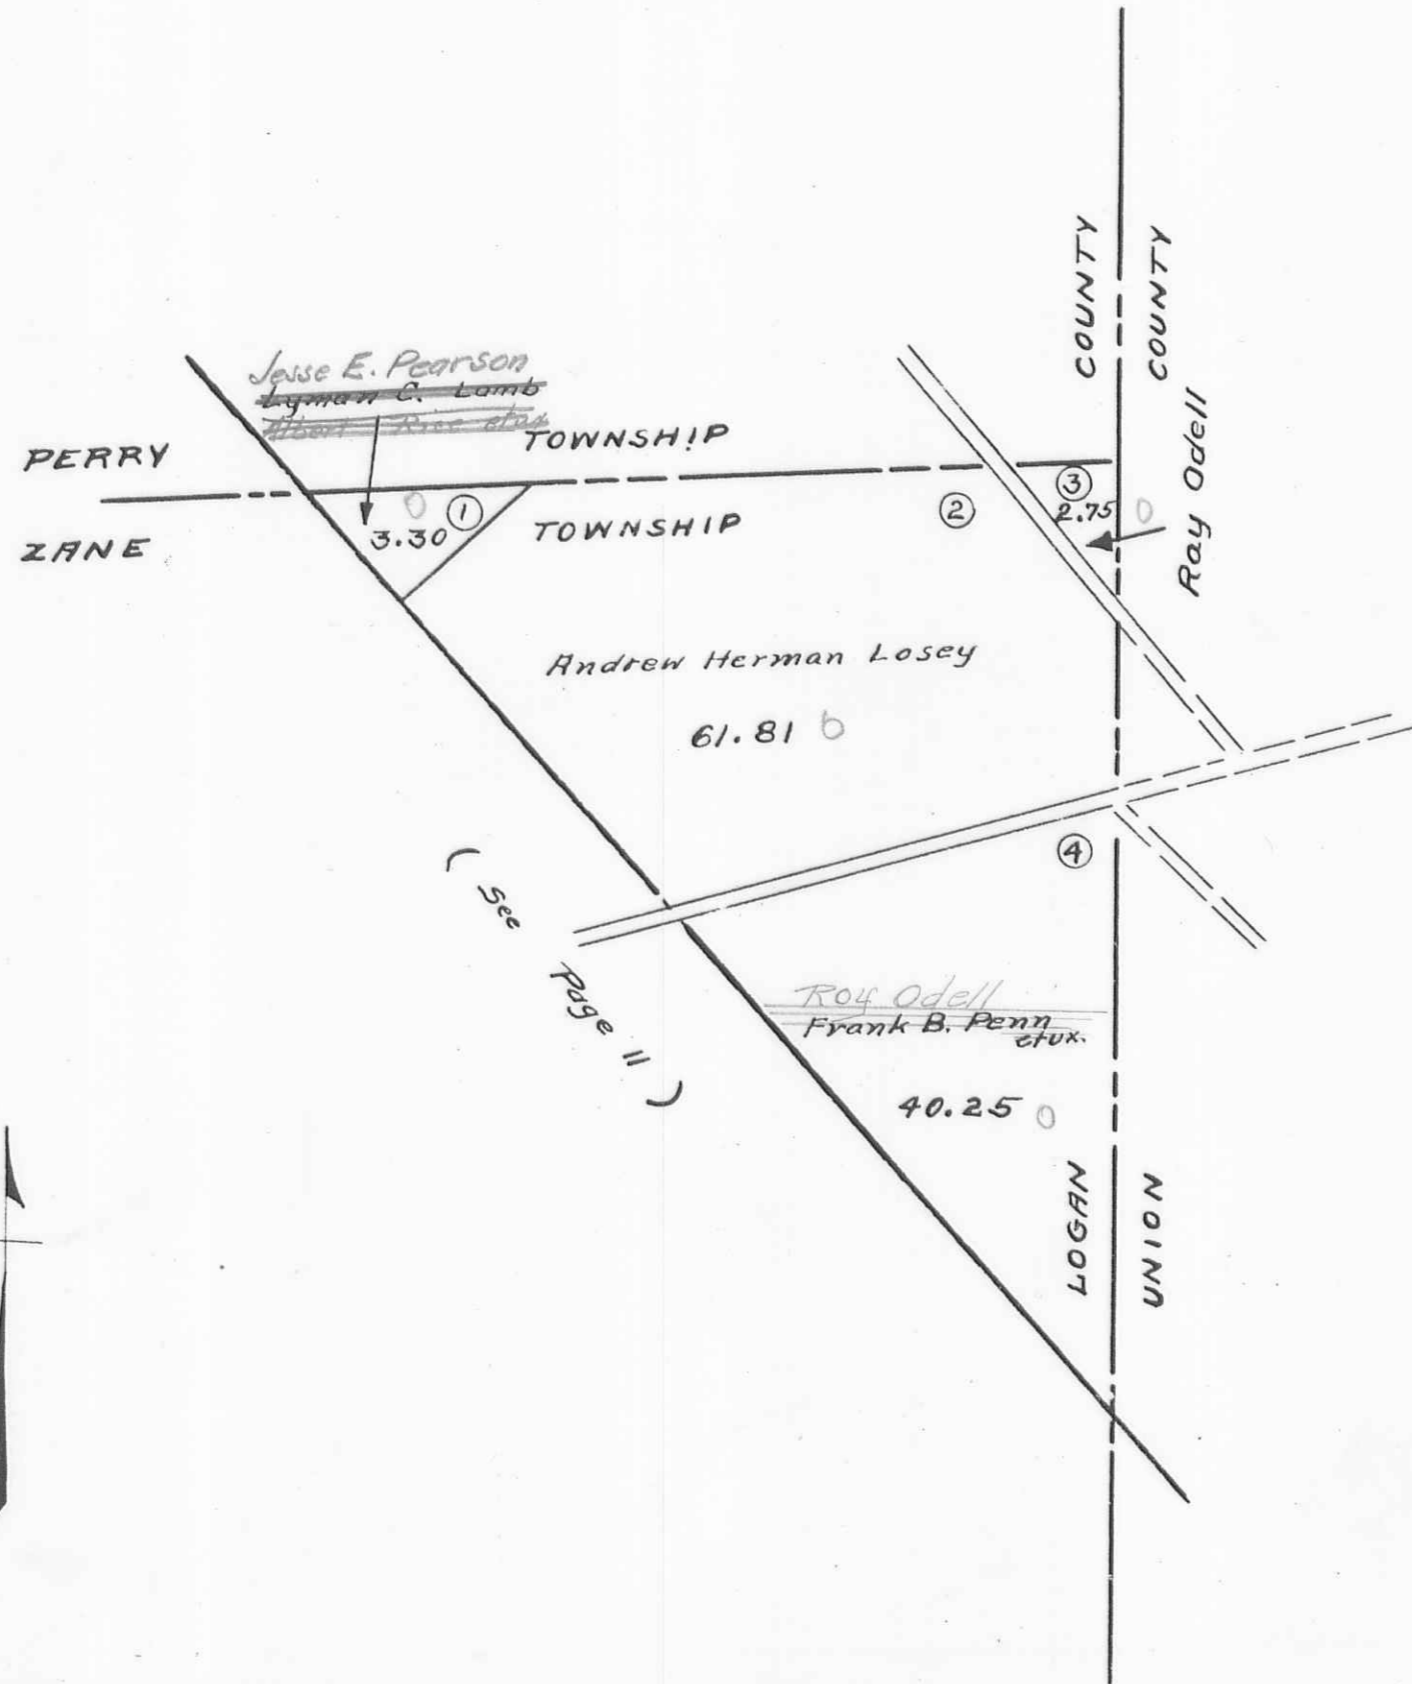


ZANE TOWNSHIP
 VIRGINIA MILITARY SURVEYS 3230
 3231

SCALE 10 CHAINS TO THE INCH

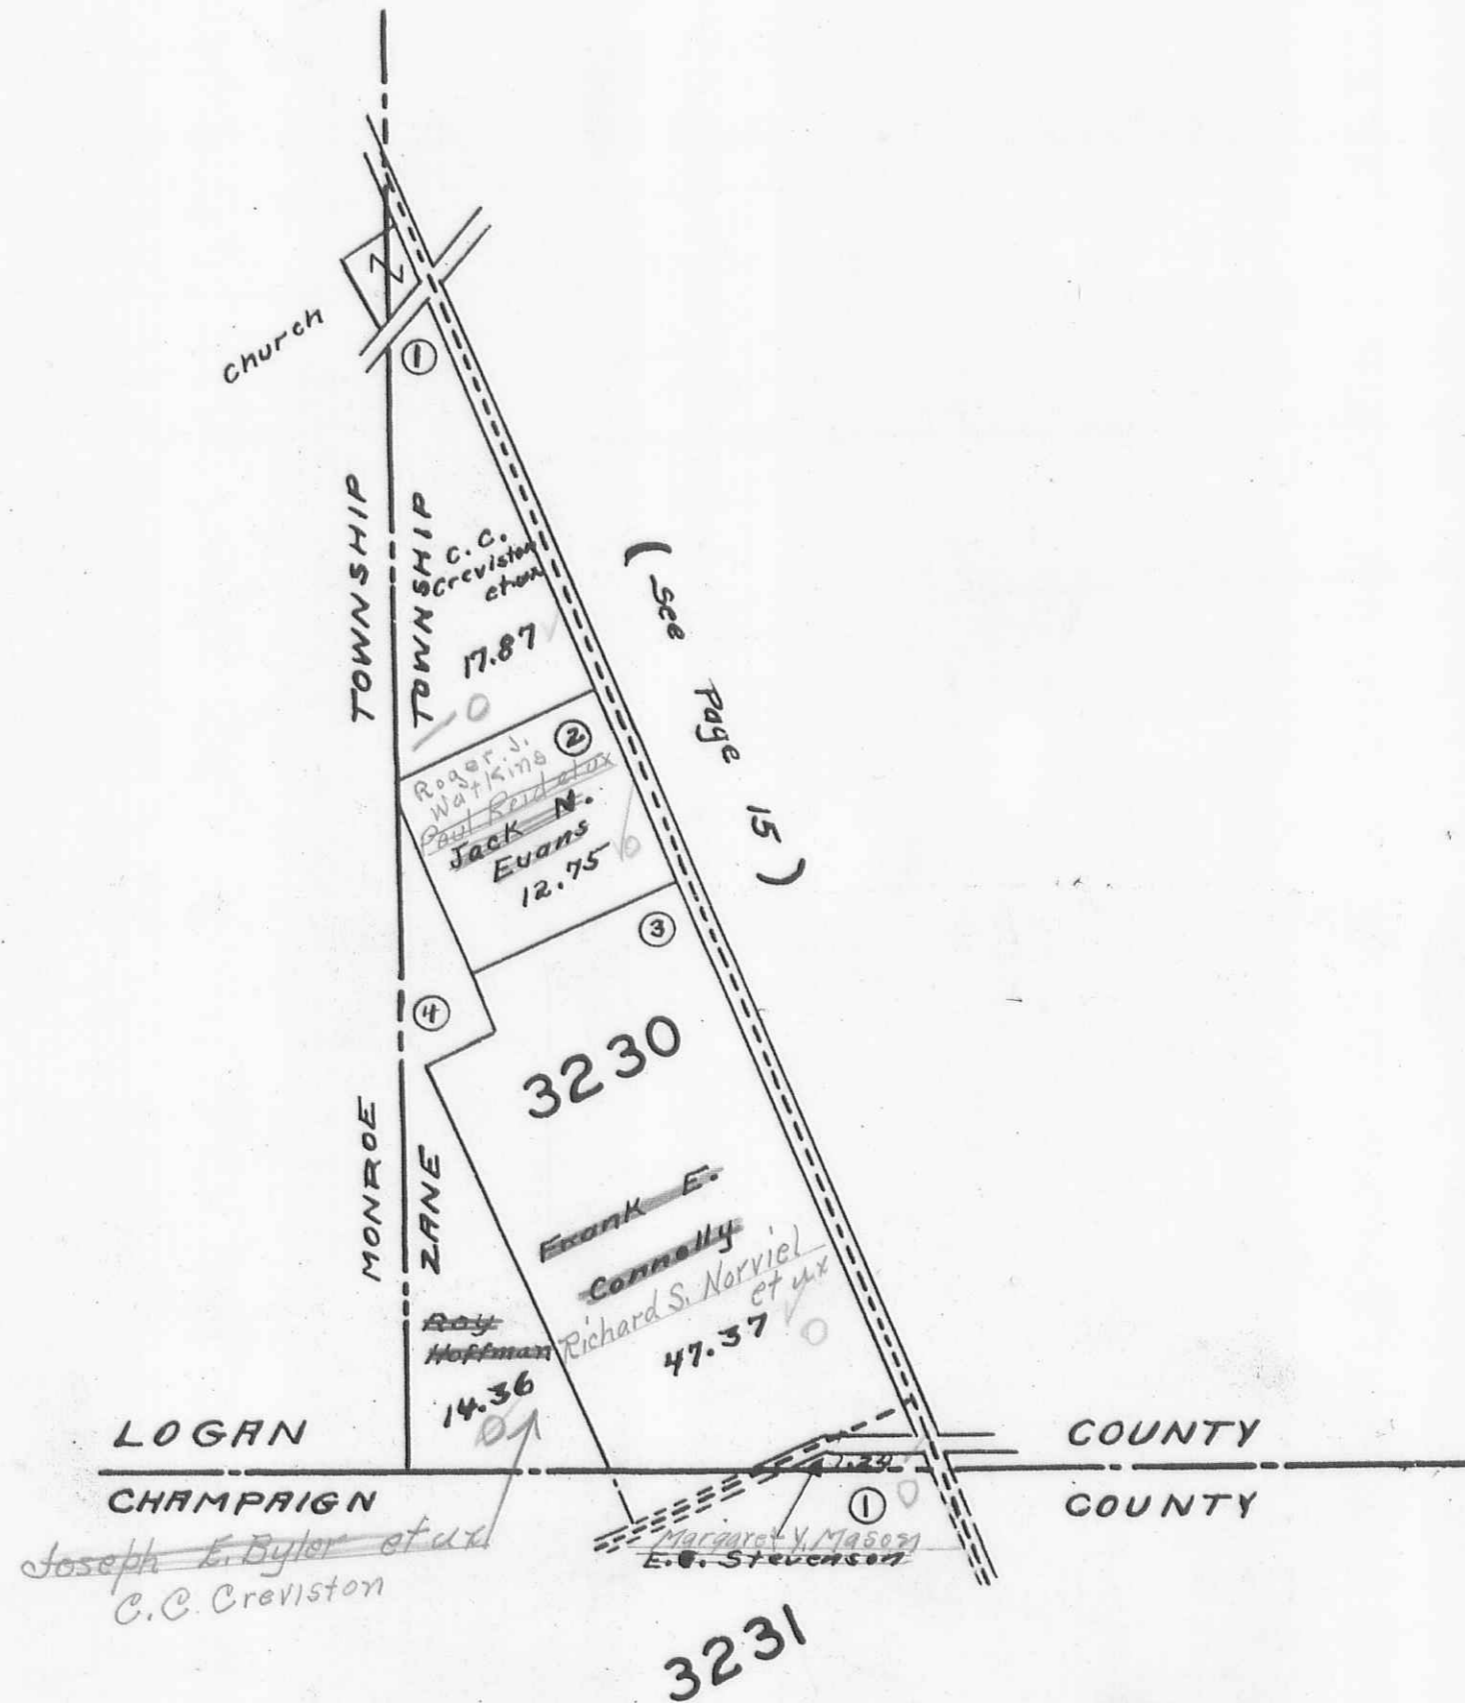

ZANE TOWNSHIP
 VIRGINIA MILITARY SURVEYS 9679
 SCALE 10 CHAINS TO THE INCH { 7117
 { 9657
 { 9740

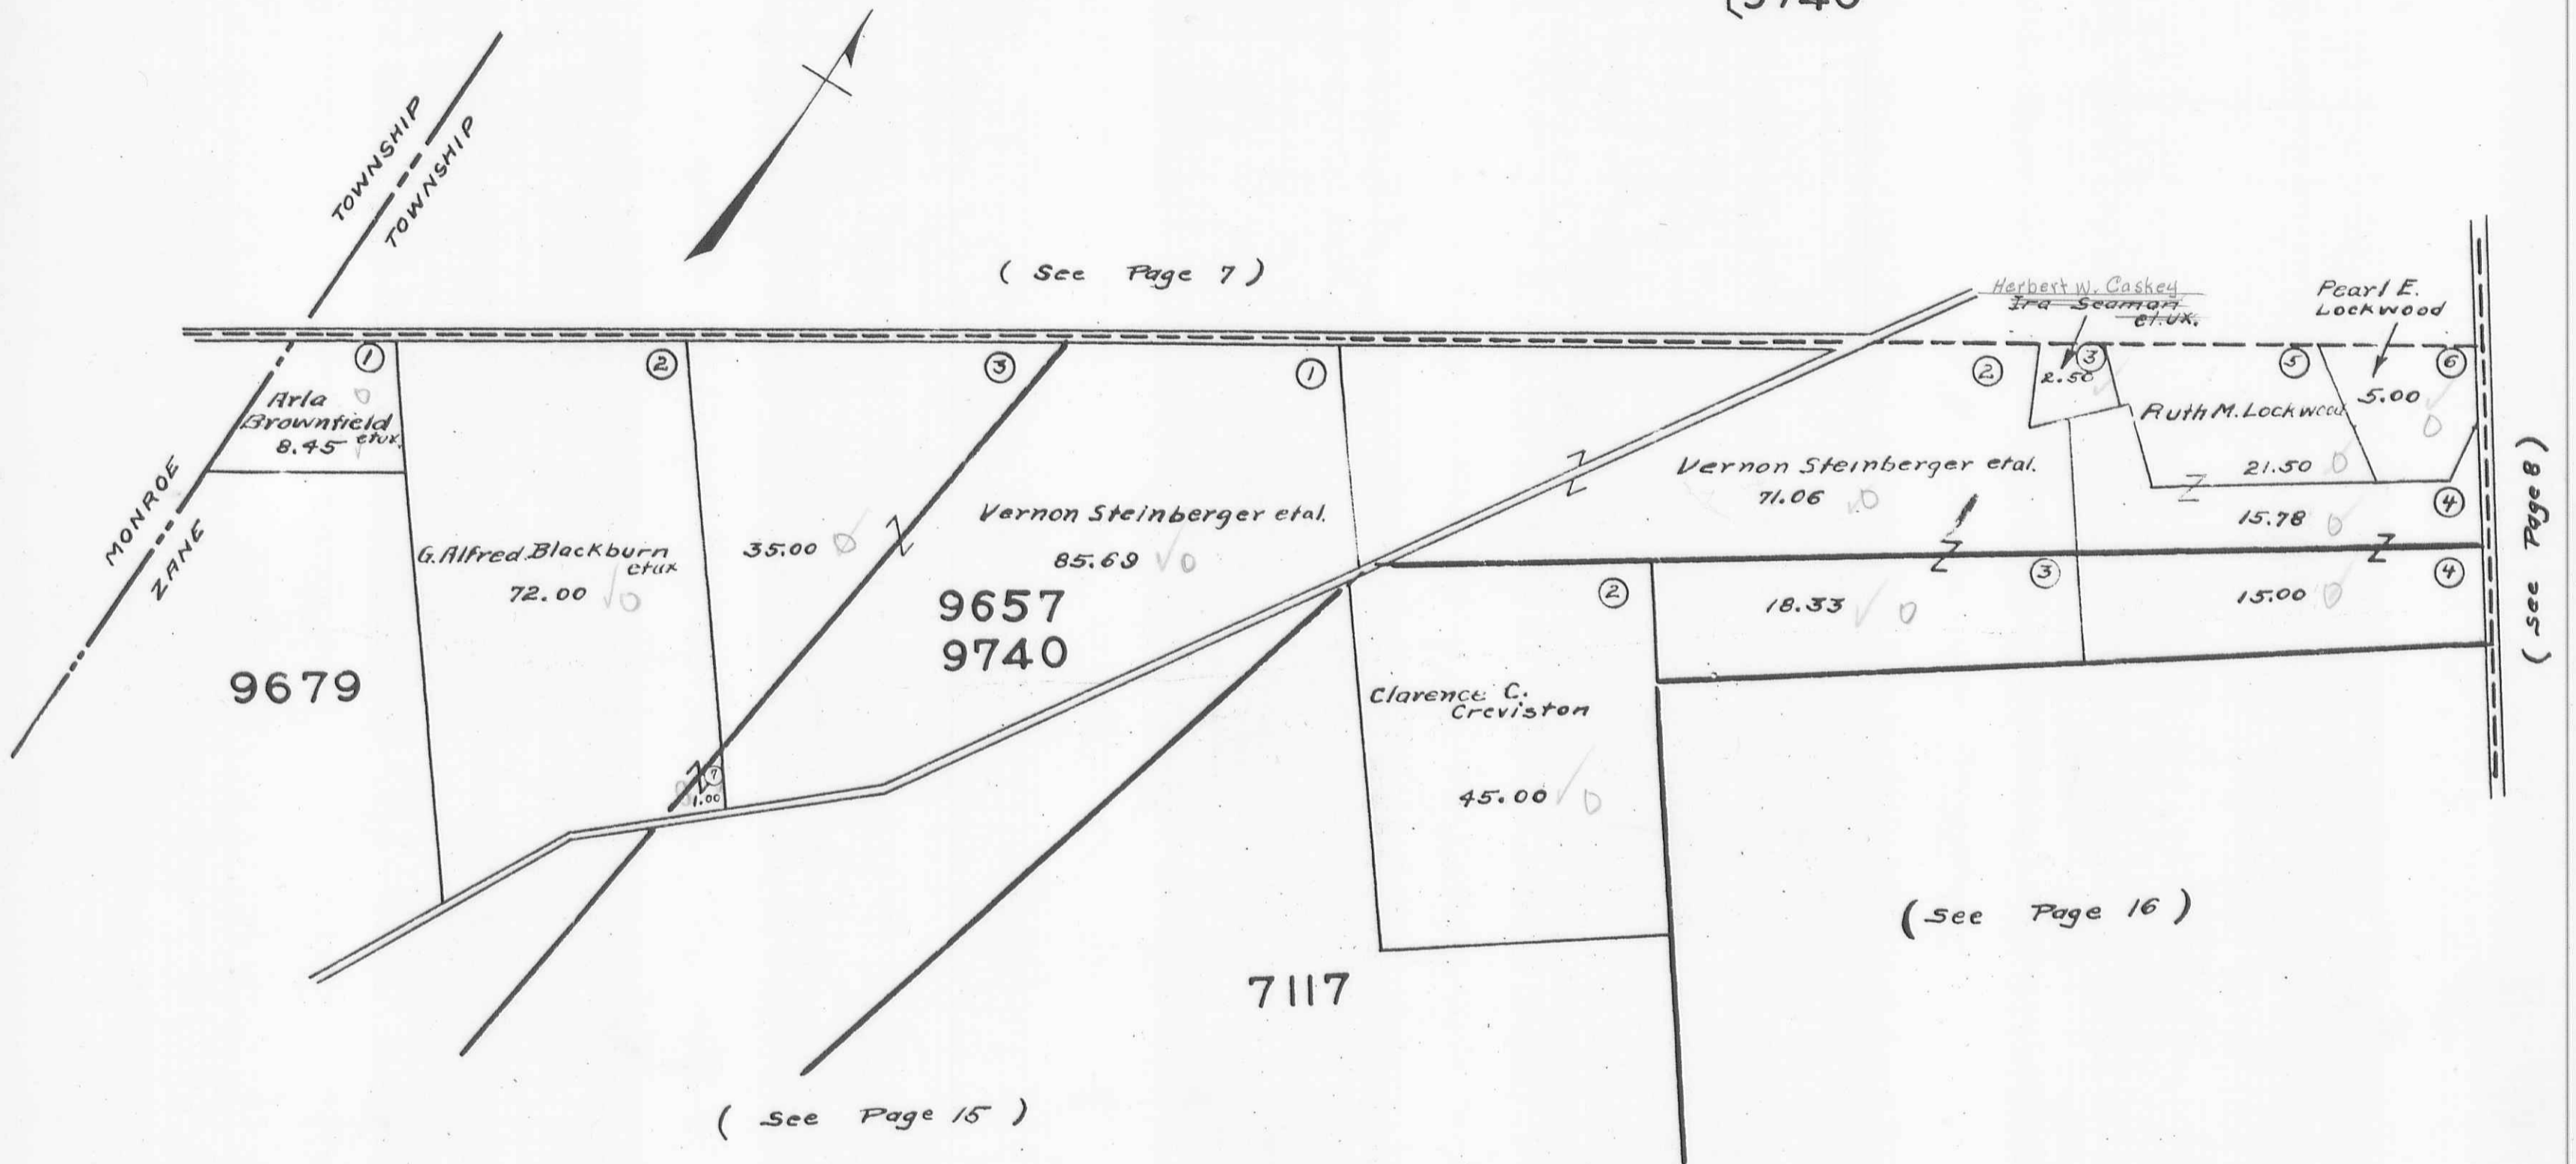


ZANE TOWNSHIP

VIRGINIA MILITARY SURVEYS

9679
7117
9657
9740

SCALE 10 CHAINS TO THE INCH

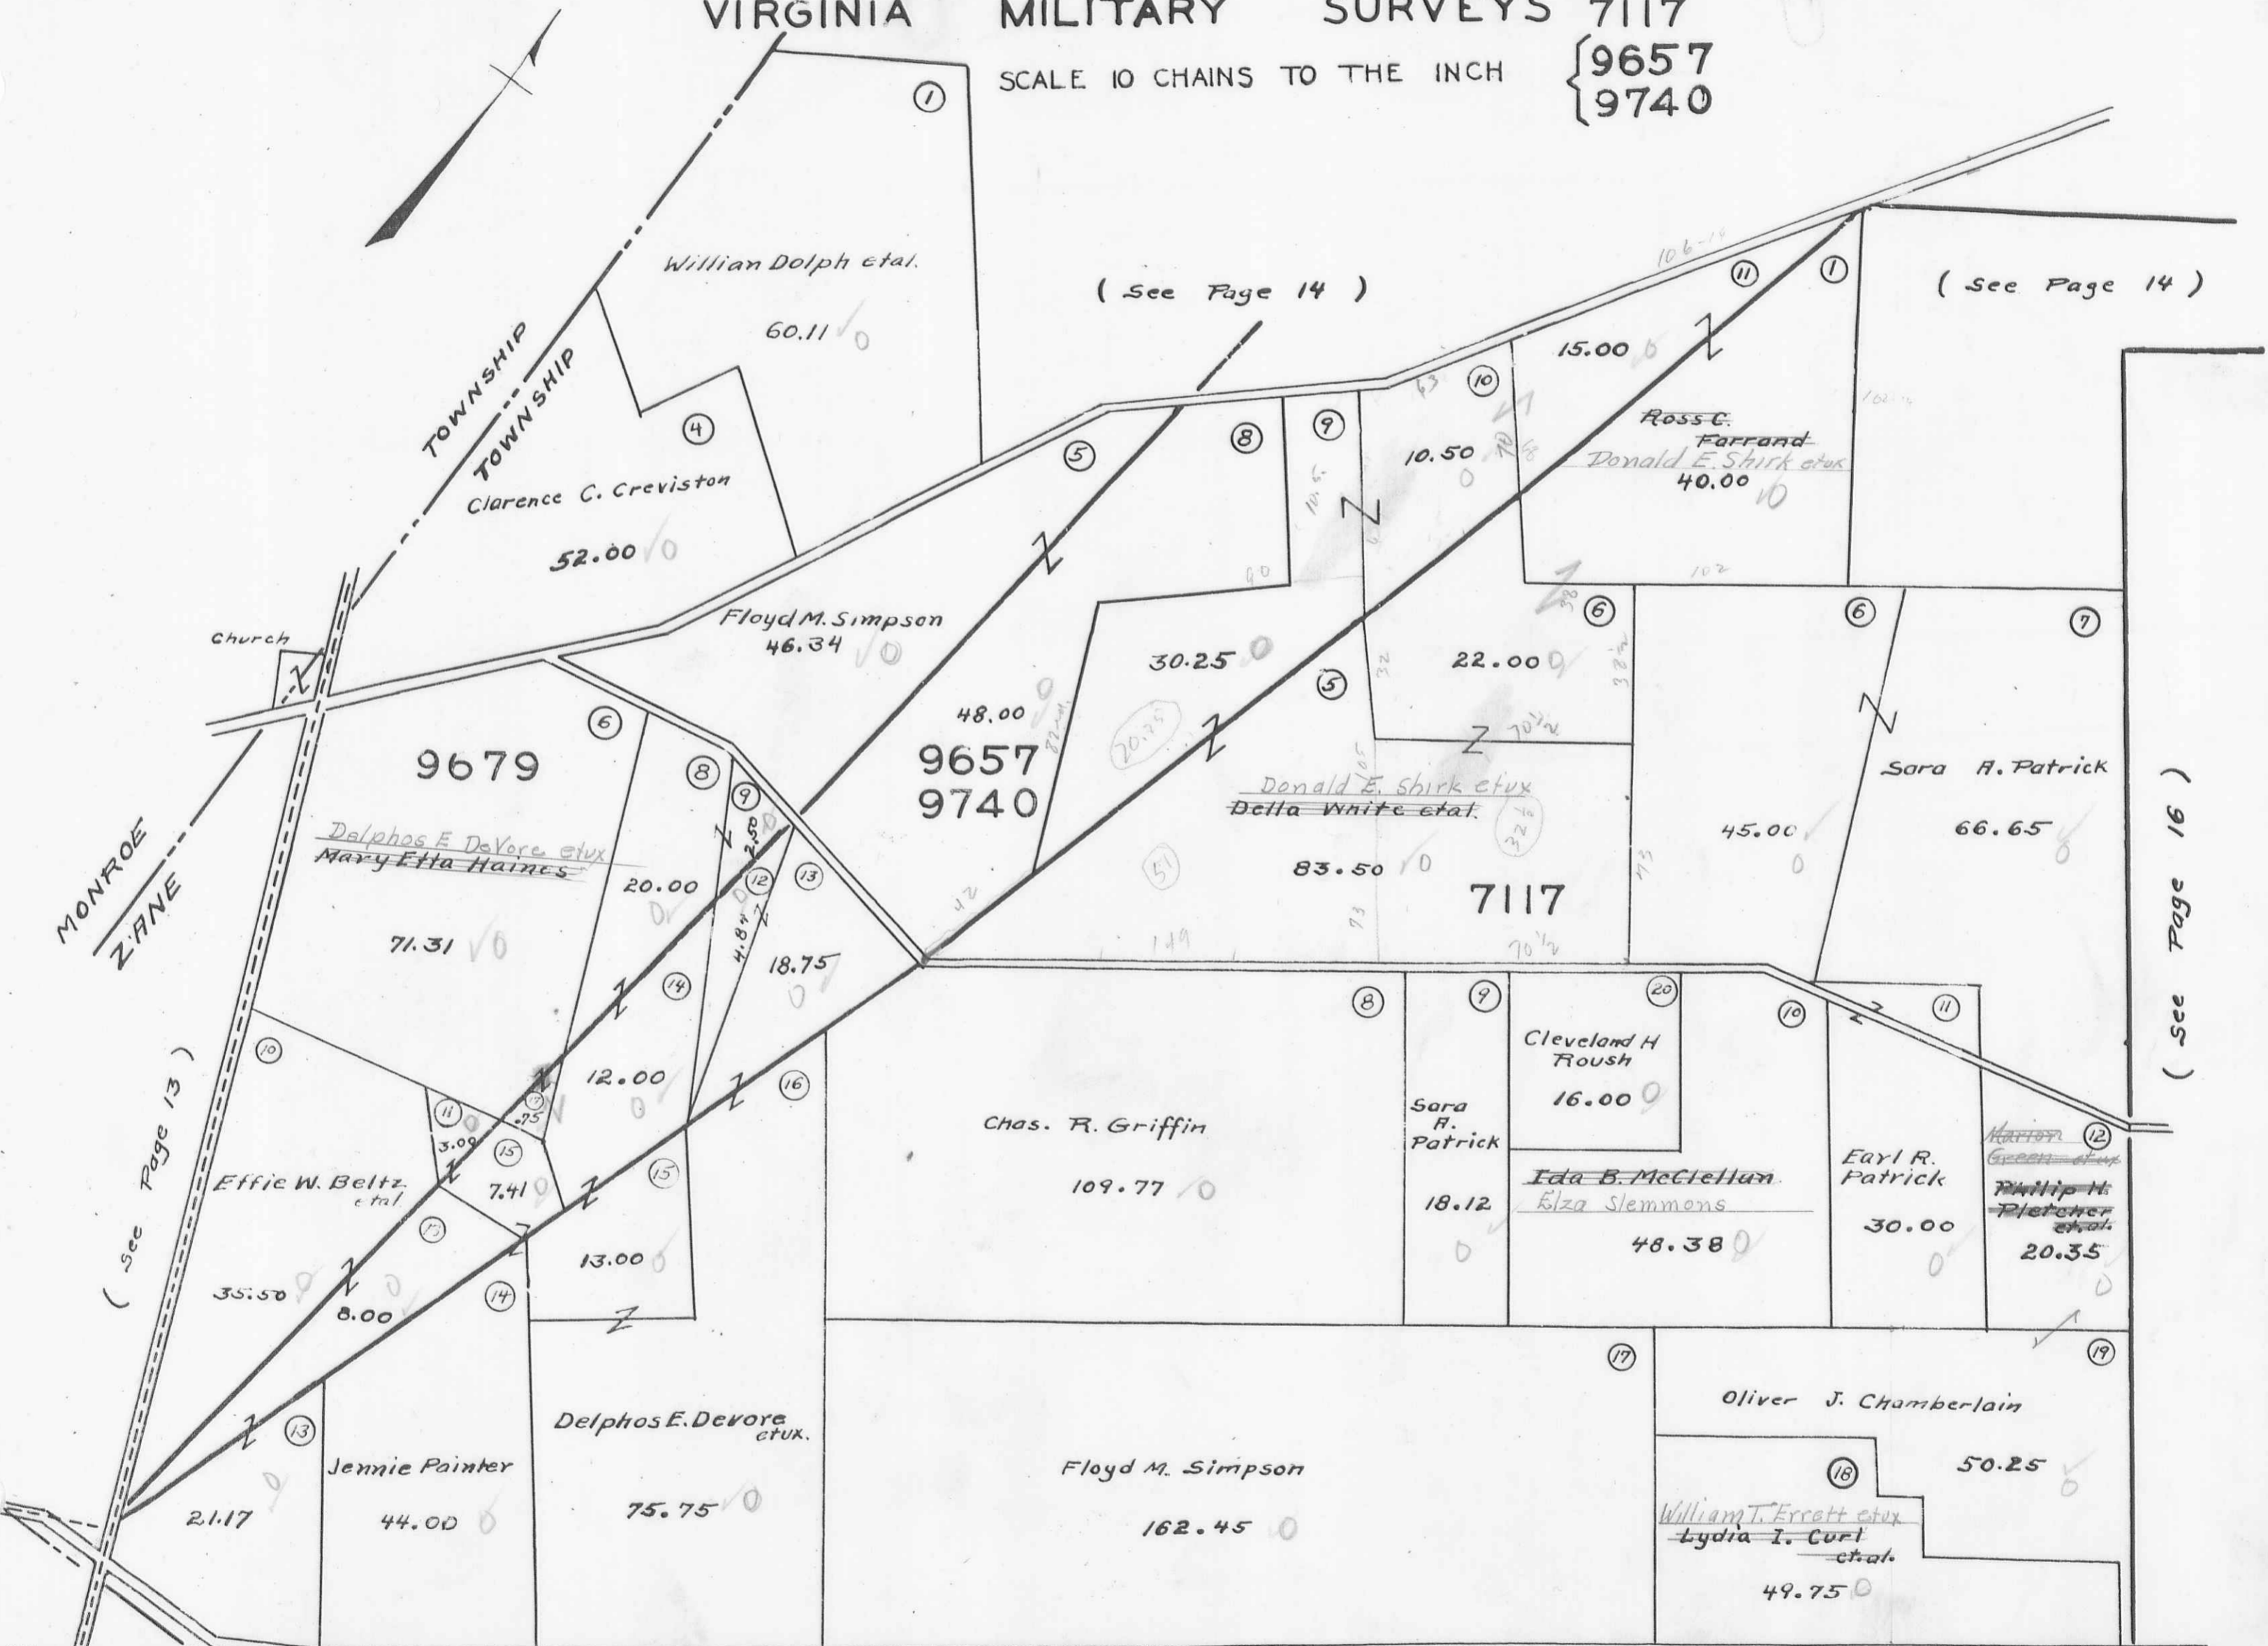

(See Page 14)

(See Page 14)

(See Page 16)

(See Page 13)

(See Page 19)

(See Page 20)


ZANE TOWNSHIP
 VIRGINIA MILITARY SURVEY 4953

SCALE 10 CHAINS TO THE INCH

(See Page 14)

(See Page 14)

(See Page 8)

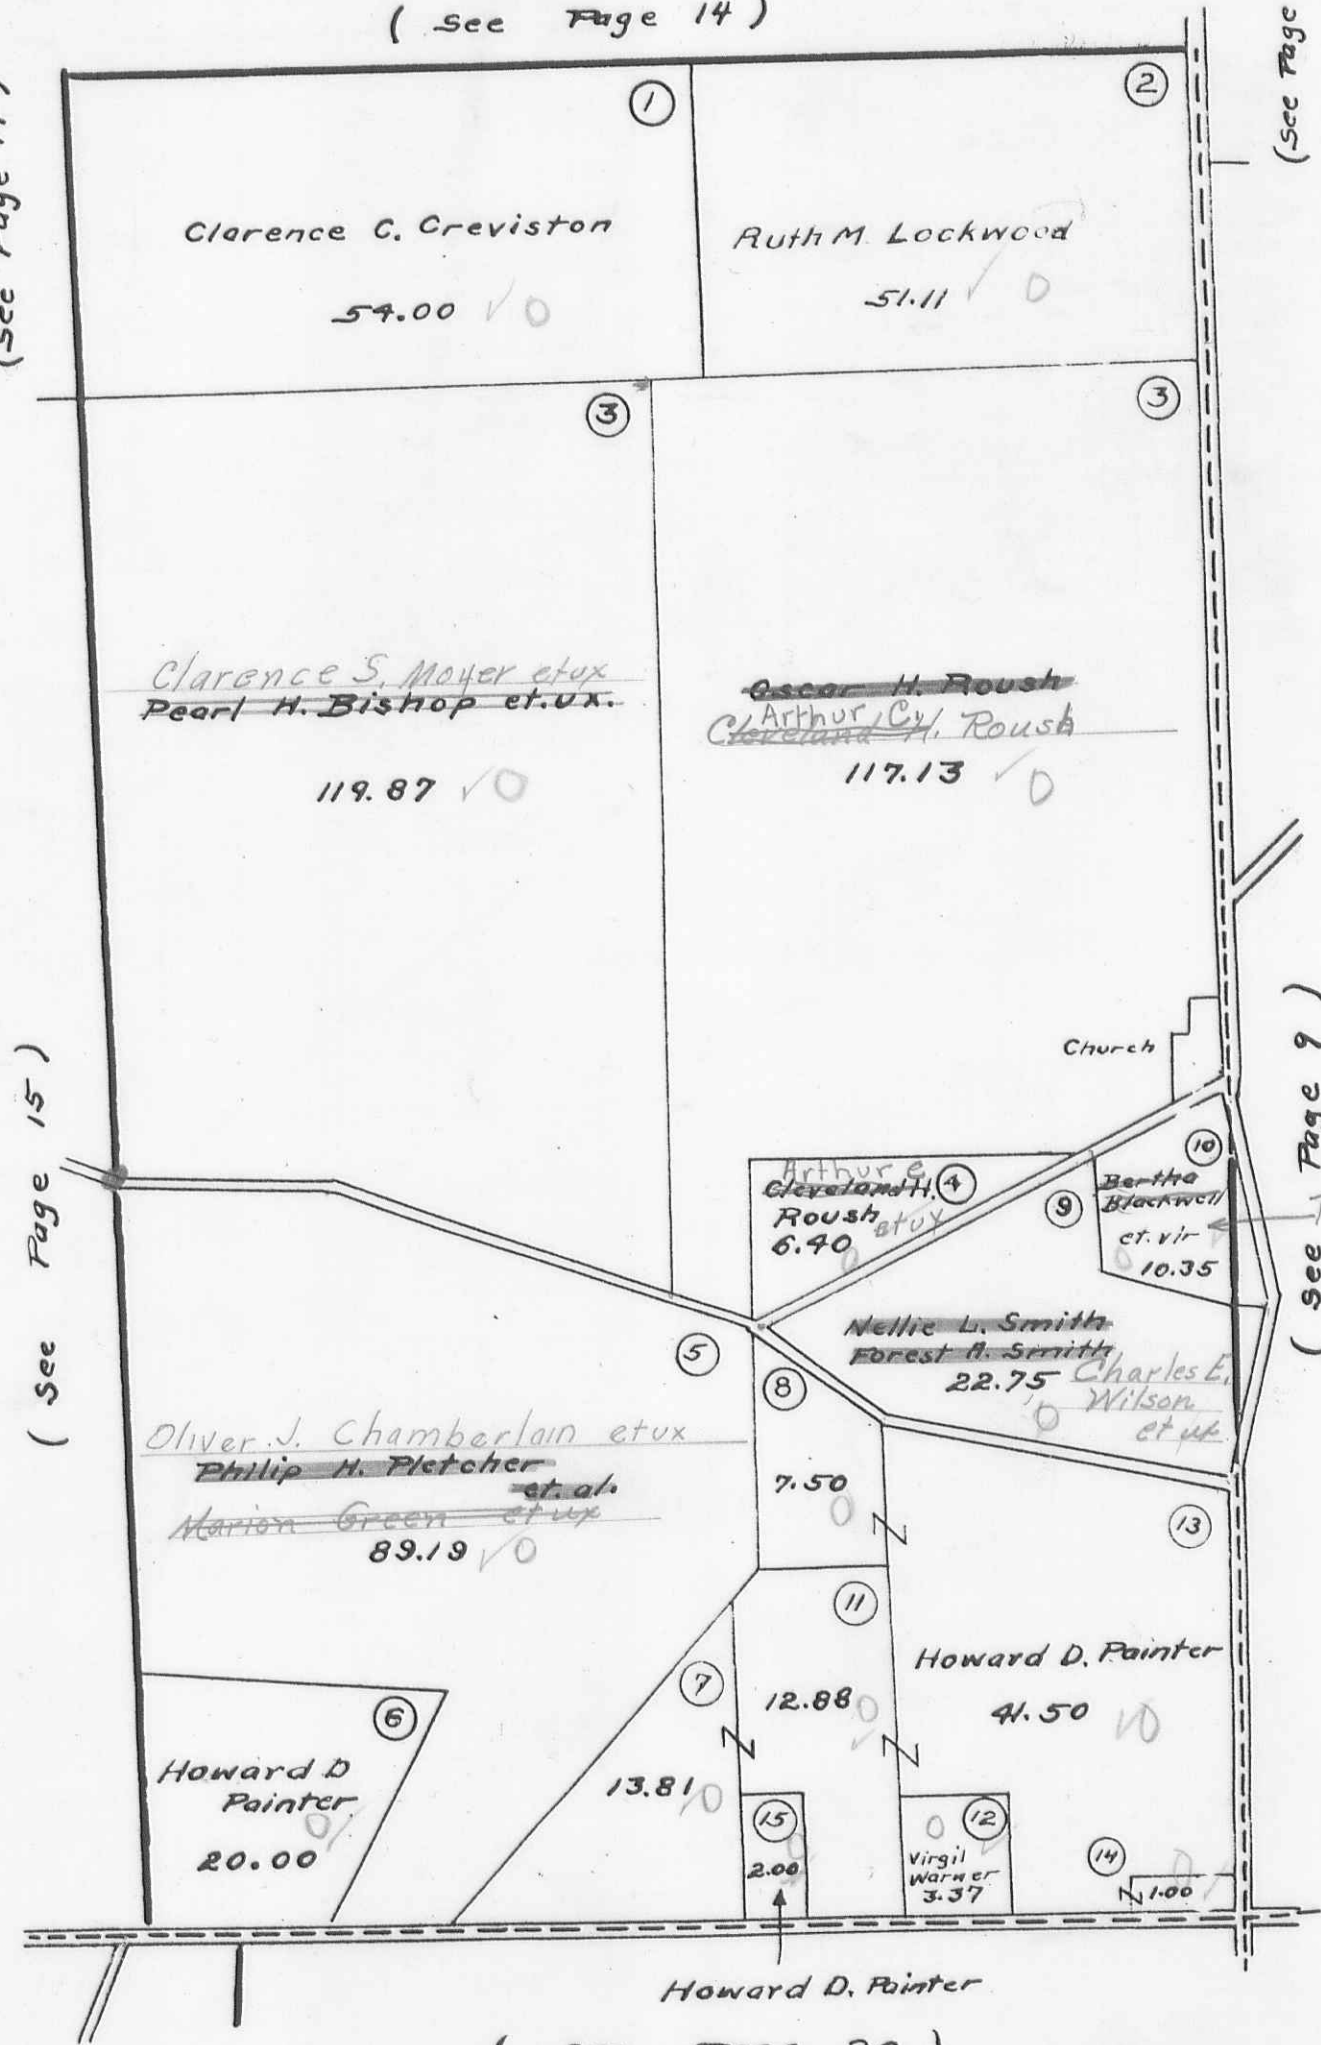

(See Page 15)

(see Page 9)

Thomas C. Lease et ux



119.87
 117.13
 236.00

(See Page 20)

ZANE TOWNSHIP
VIRGINIA MILITARY SURVEYS

3160
4606
12256

SCALE 10 CHAINS TO THE INCH
(See Page 10)

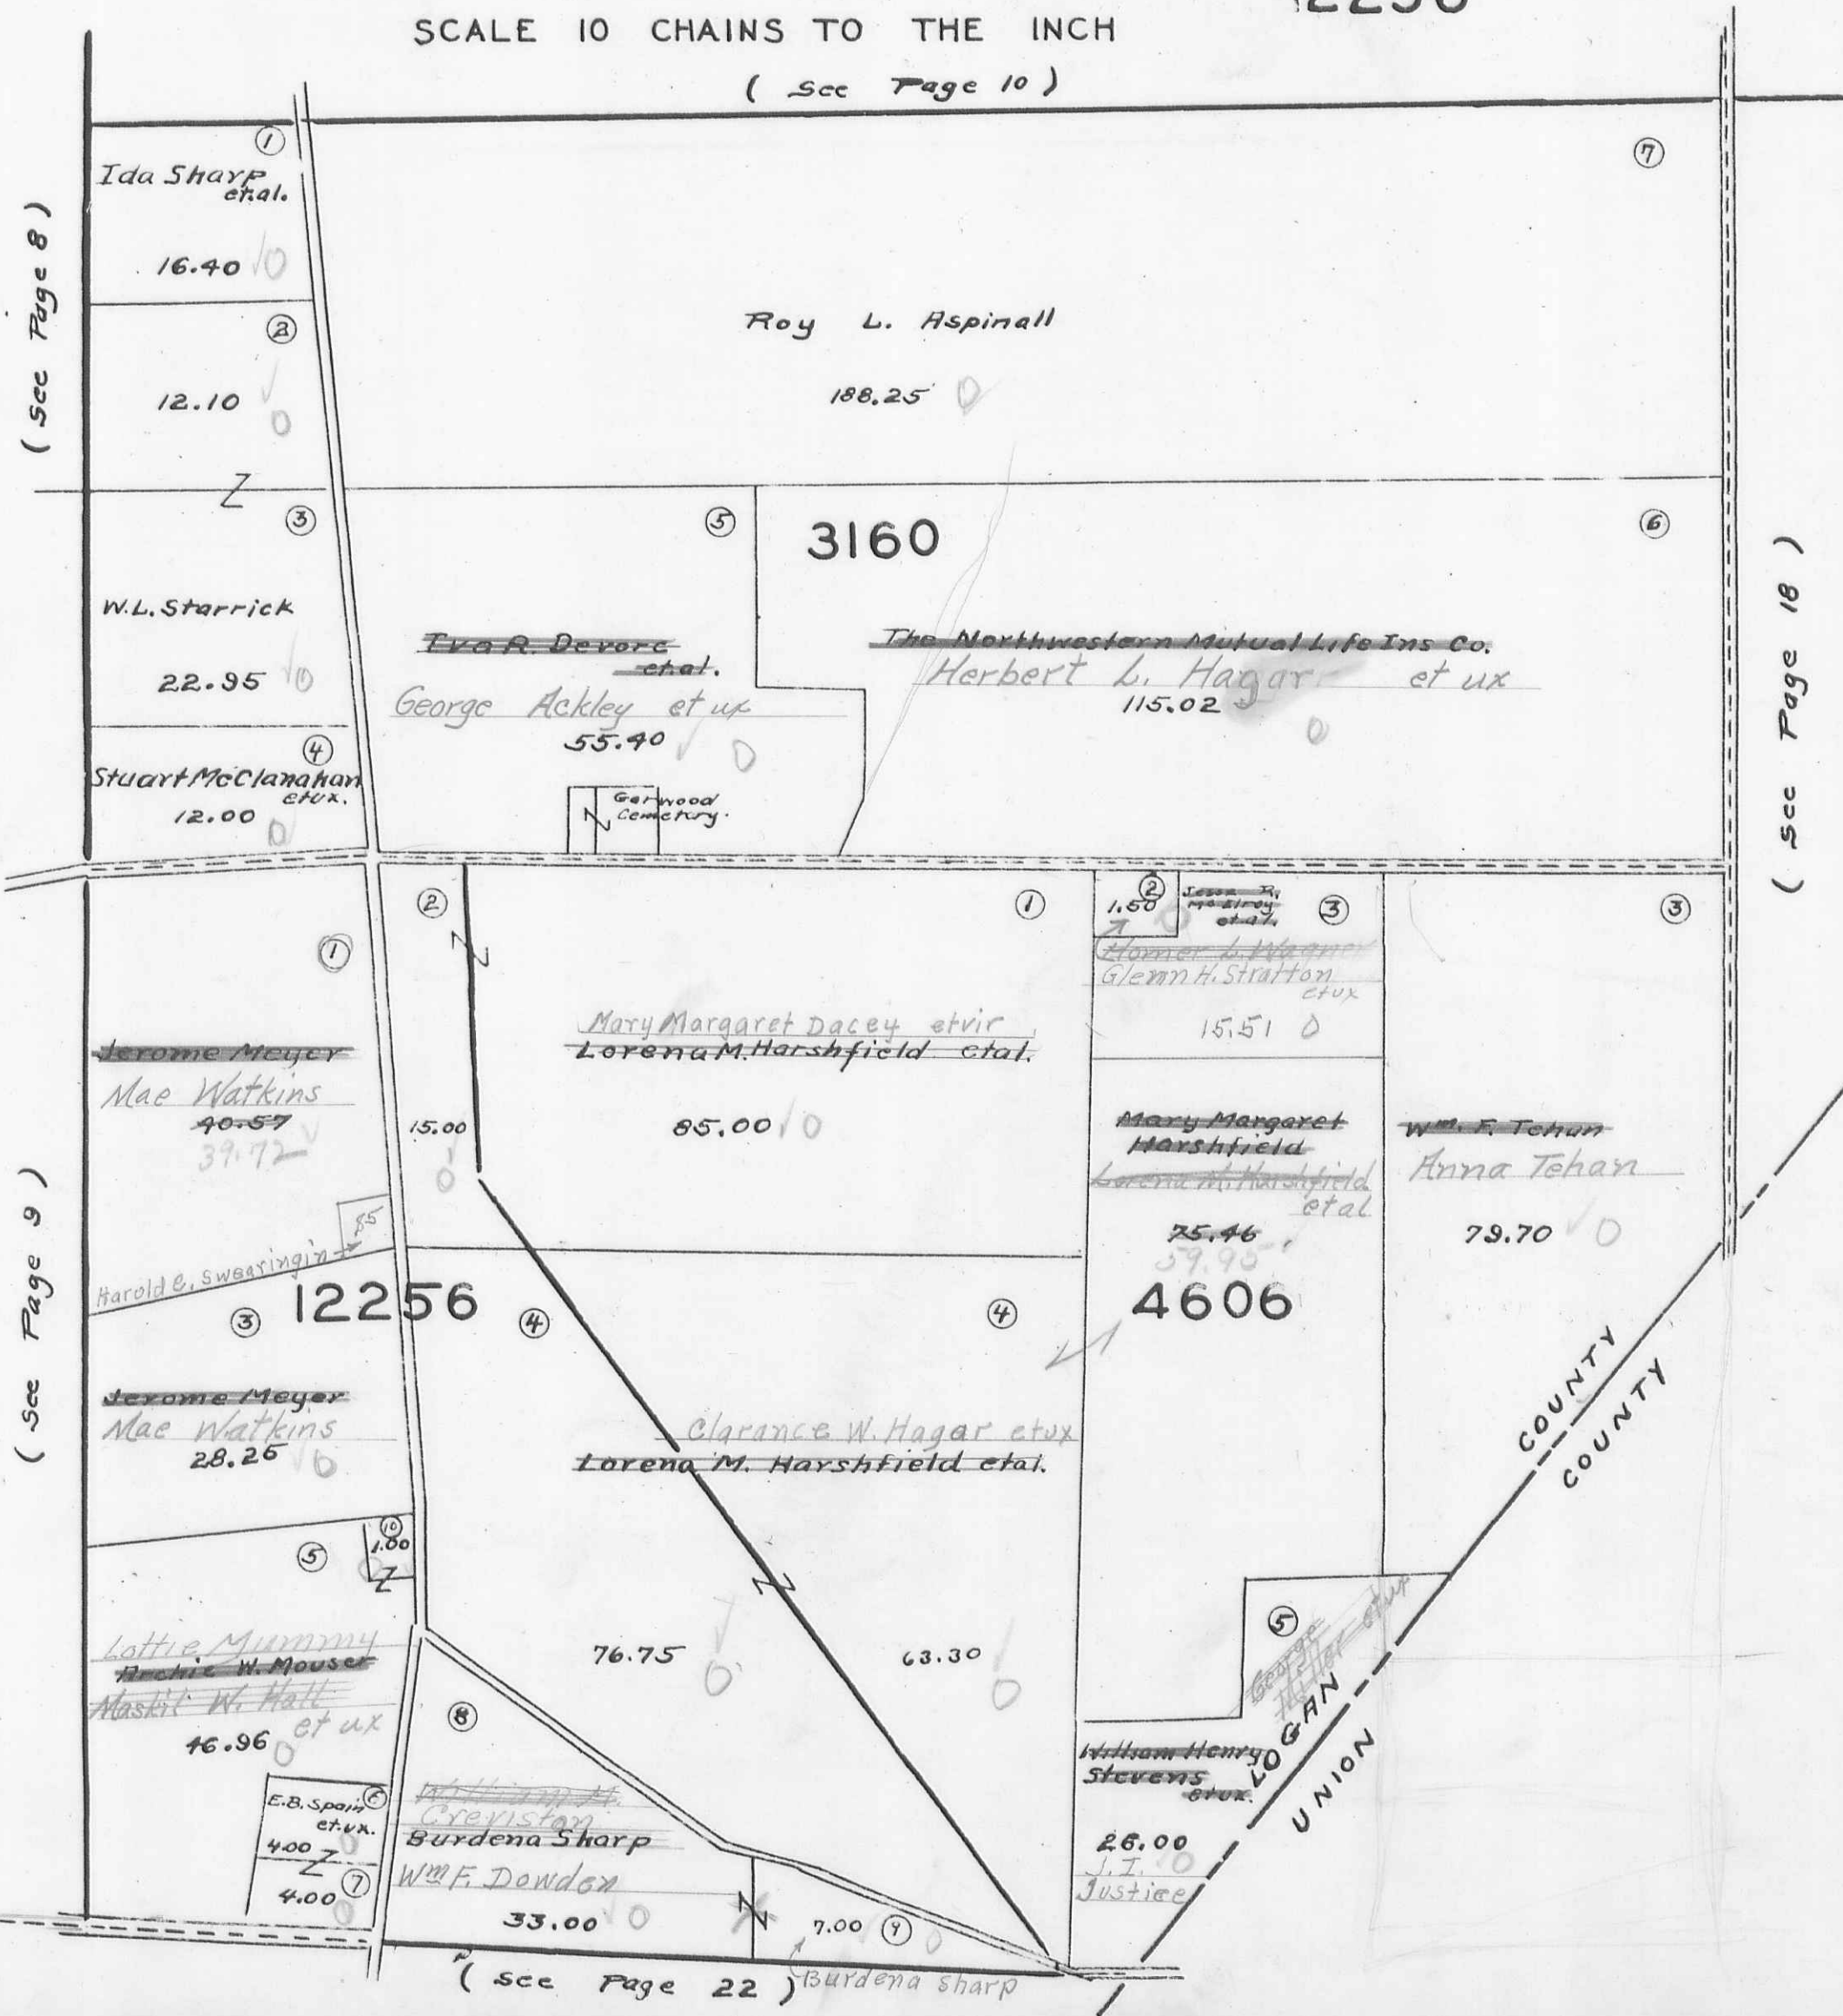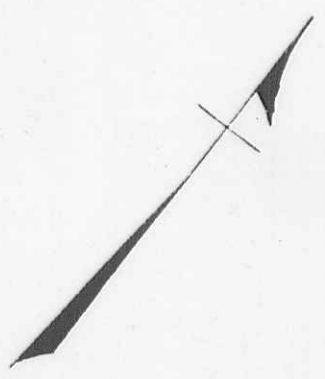

(See Page 8)


(See Page 18)

(See Page 9)

(See Page 22)

ZANE TOWNSHIP
VIRGINIA MILITARY SURVEY 4933

SCALE 10 CHAINS TO THE INCH

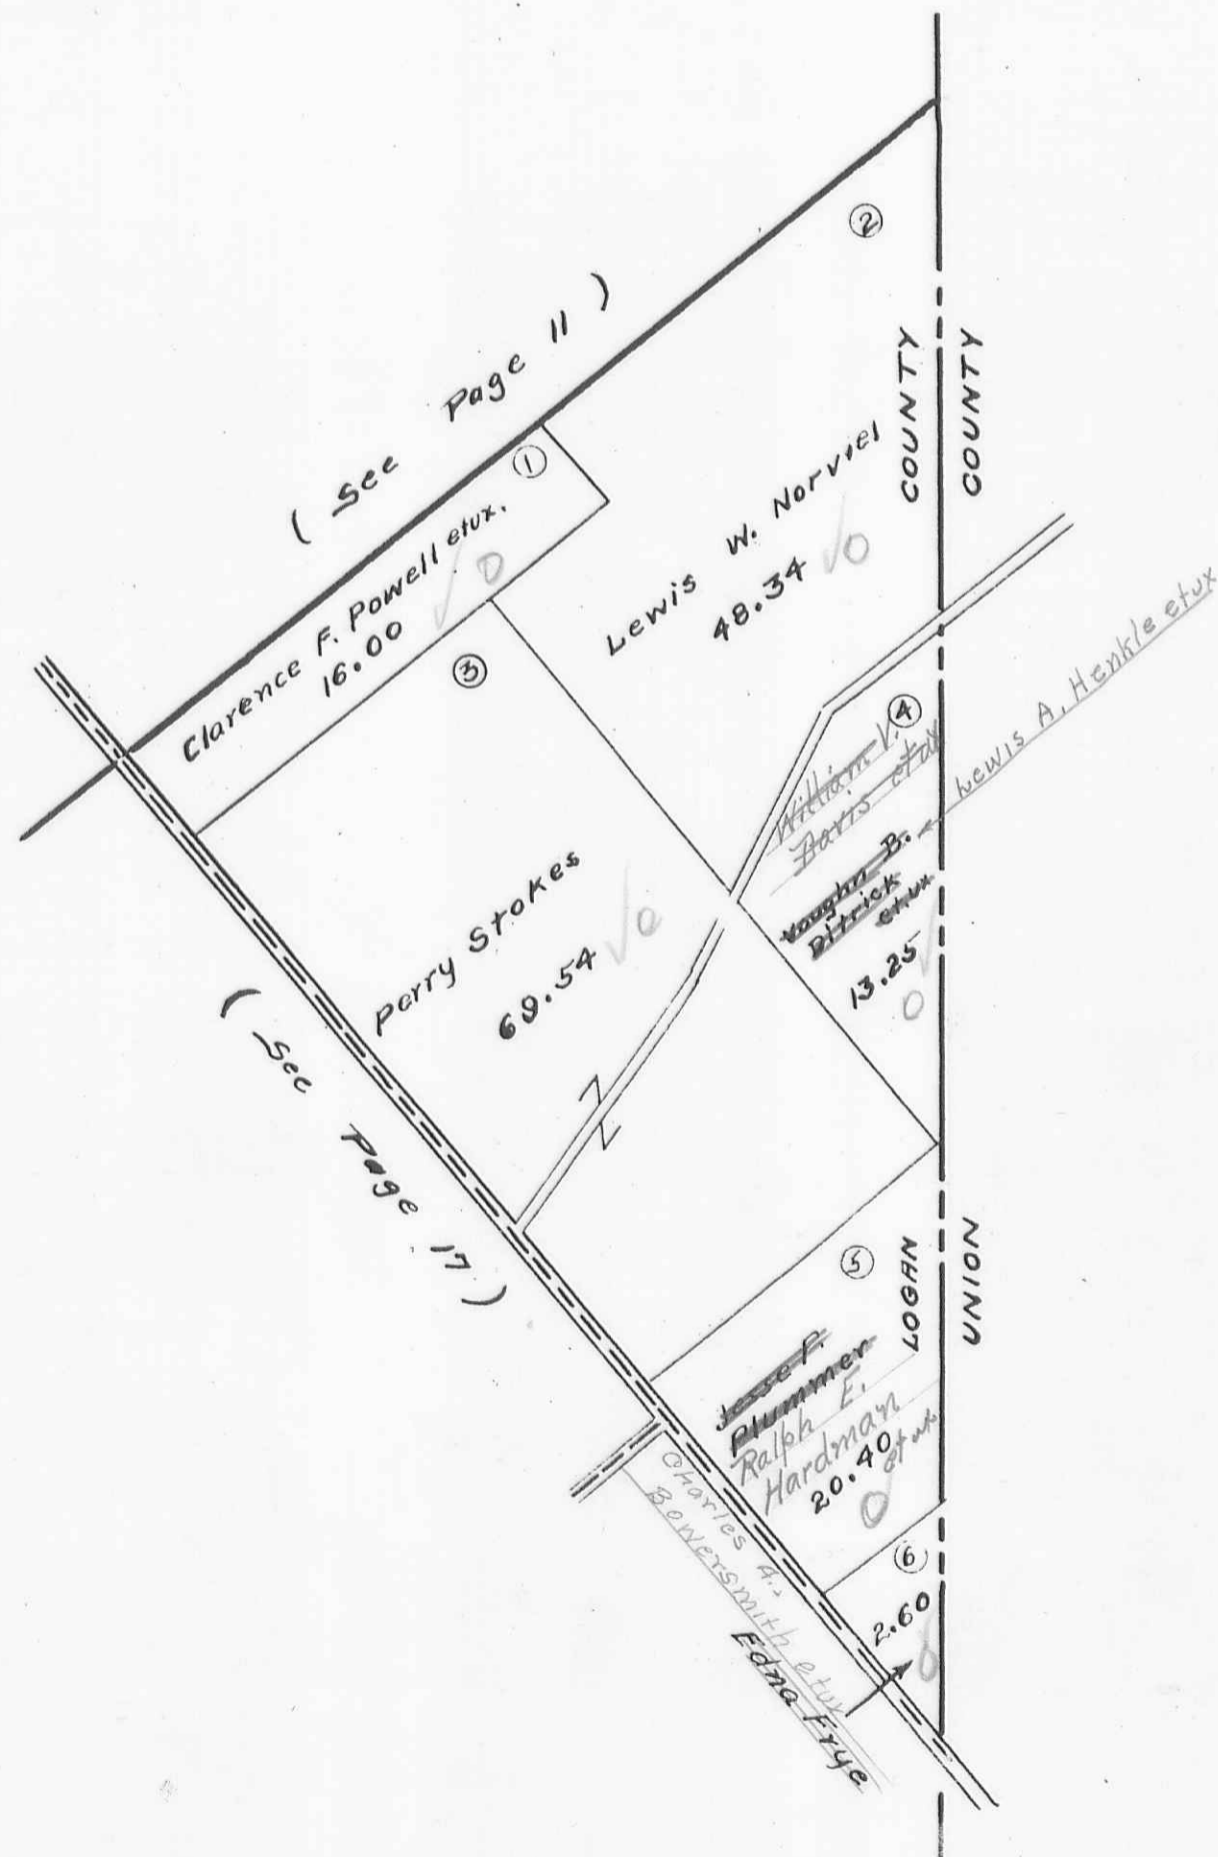


ZANE TOWNSHIP
 VIRGINIA MILITARY SURVEYS

4697
 5049

SCALE 10 CHAINS TO THE INCH

(See Page 15)

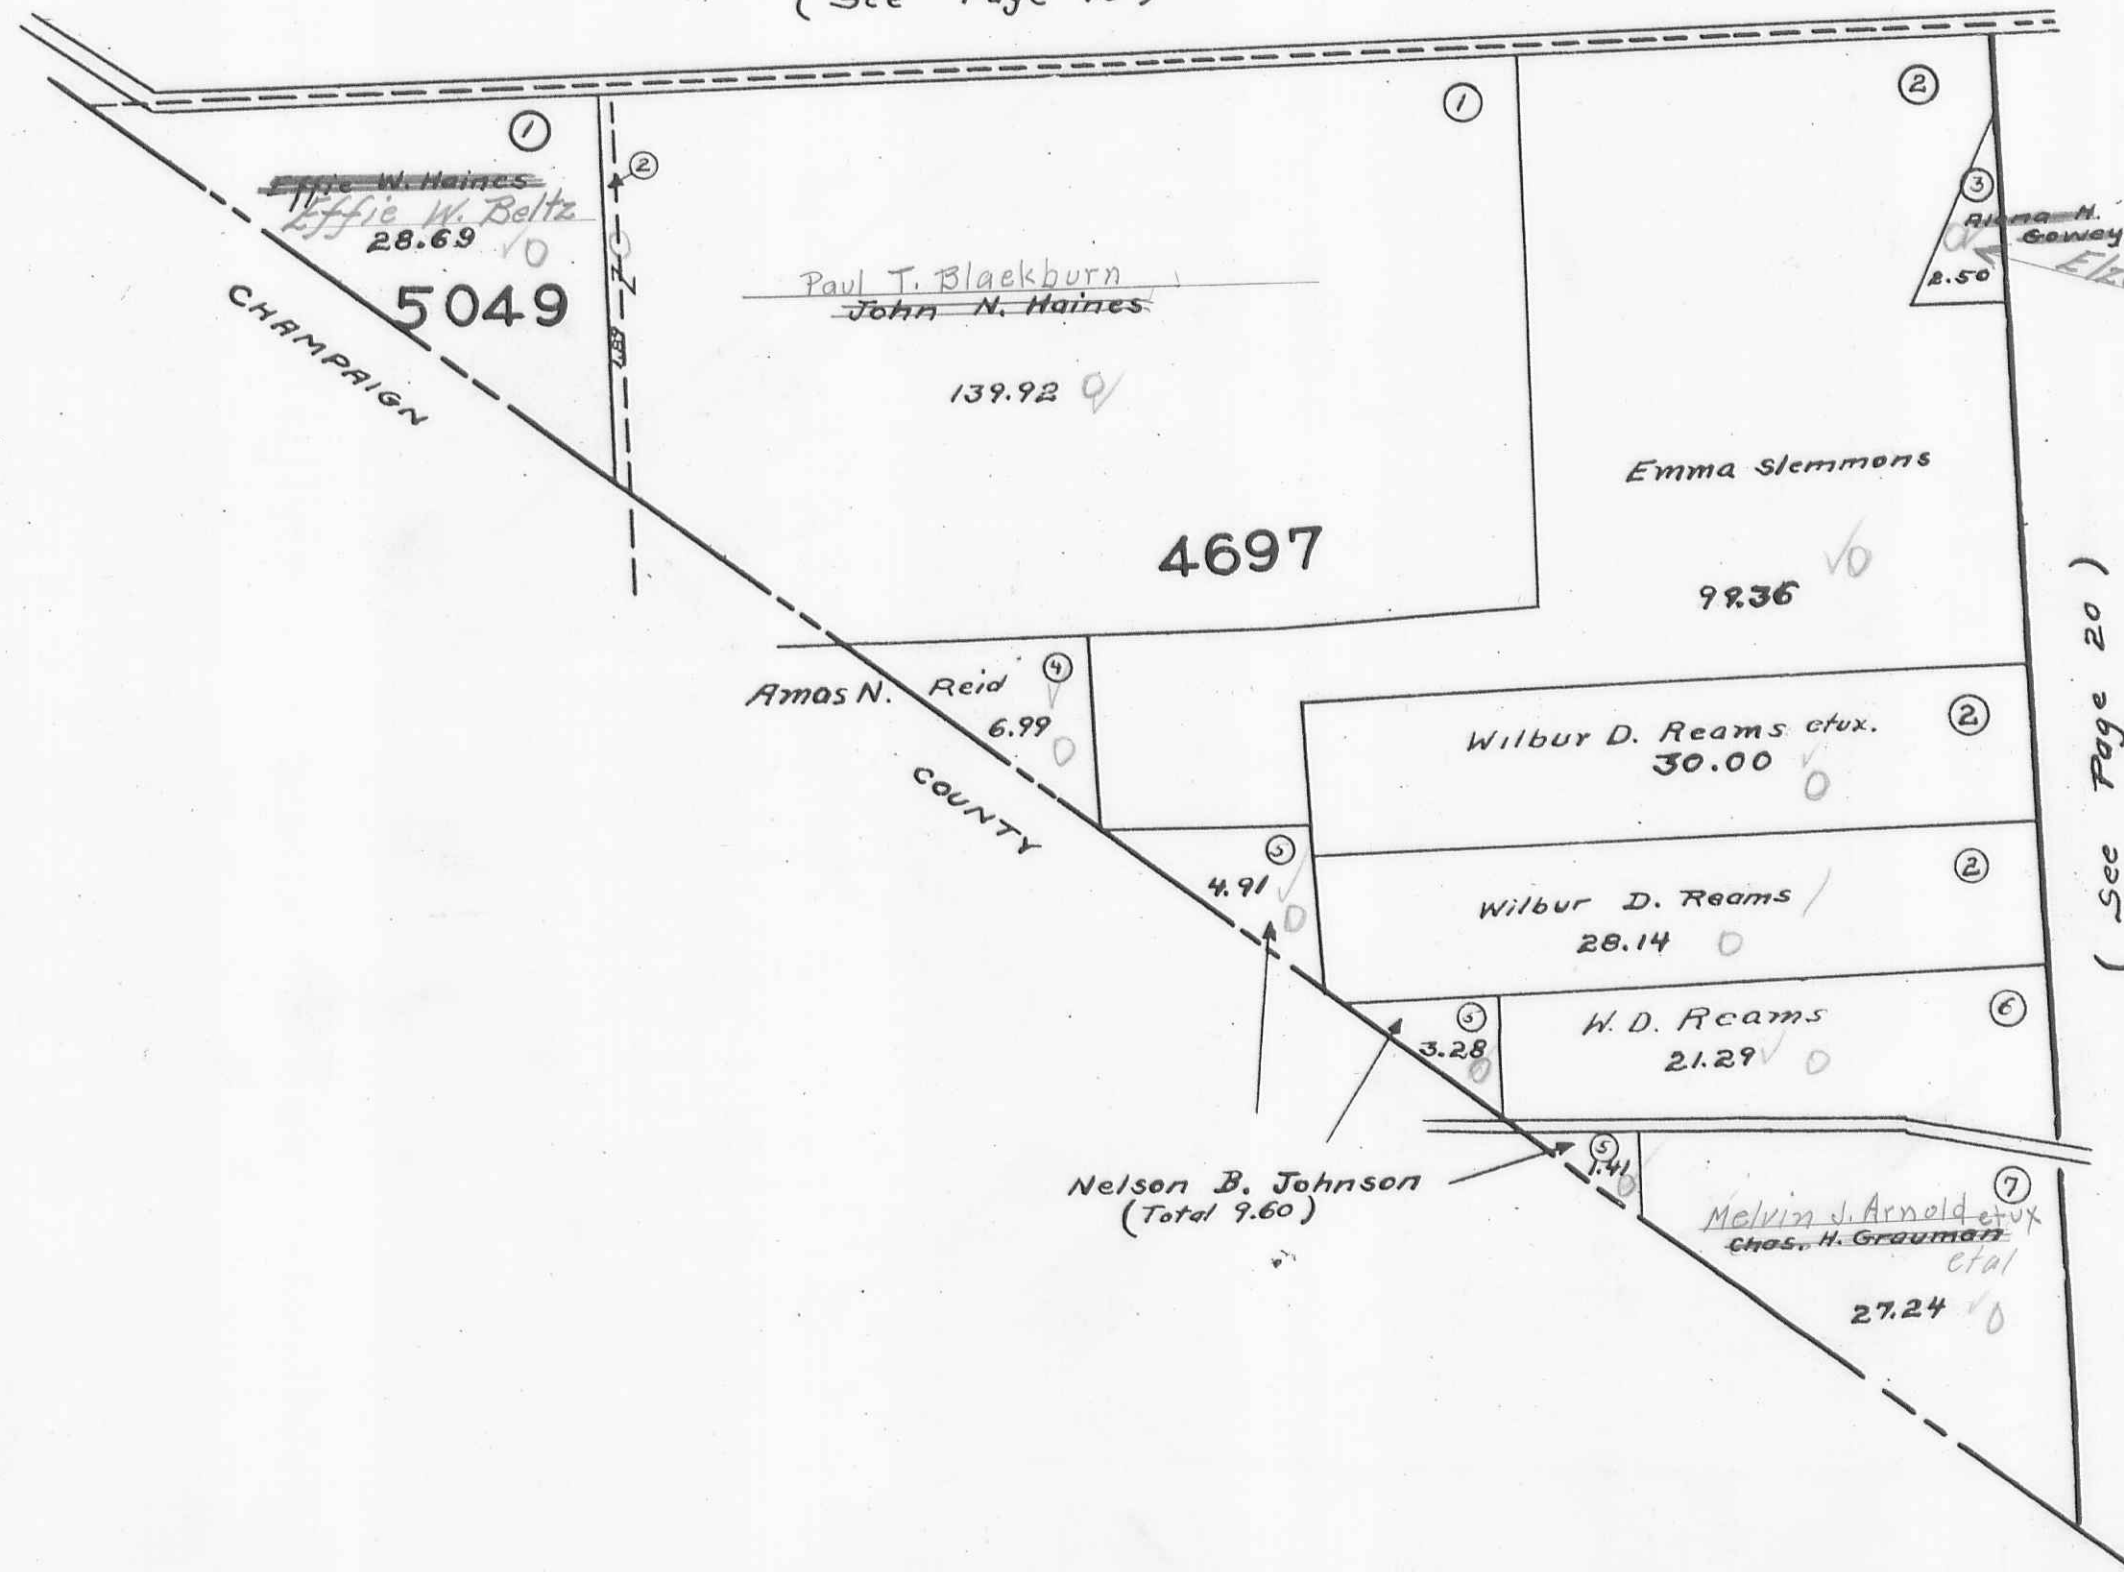


ZANE TOWNSHIP
VIRGINIA MILITARY SURVEYS

3688
4666
4859


SCALE 10 CHAINS TO THE INCH
(See Page 15)

(See Page 16)

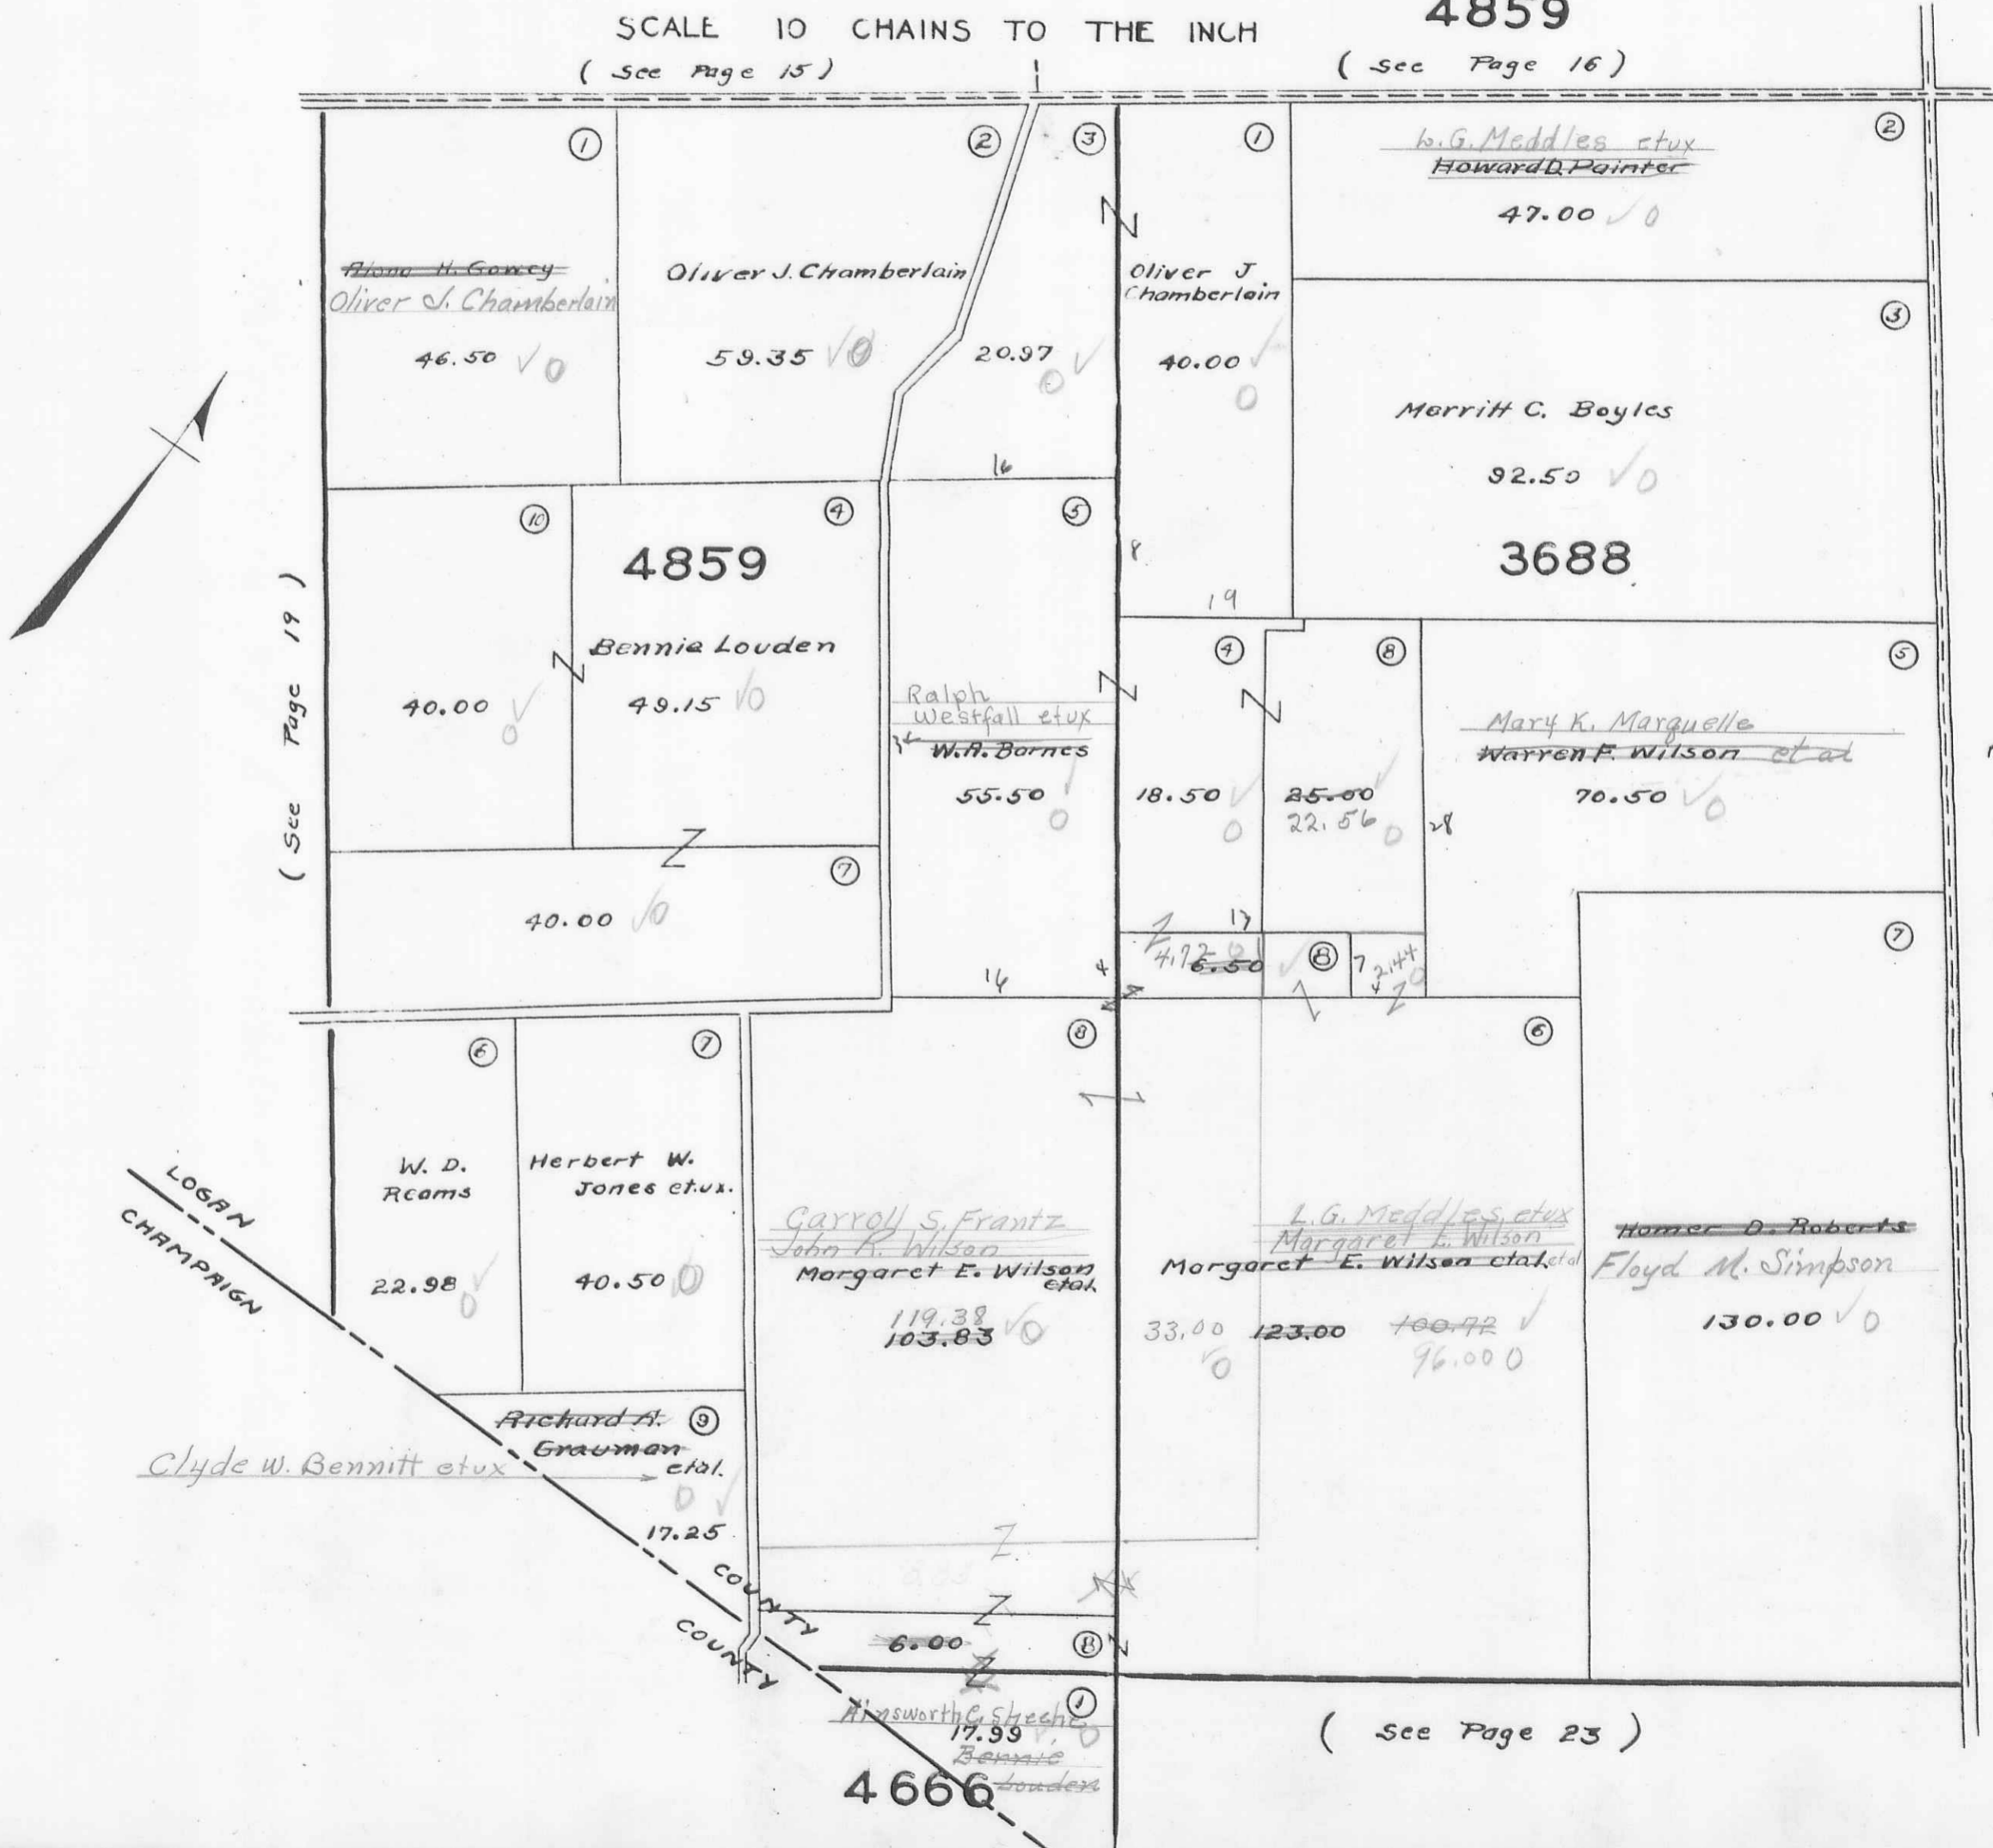

ZANE TOWNSHIP
 VIRGINIA MILITARY SURVEY 479

SCALE 10 CHAINS TO THE INCH

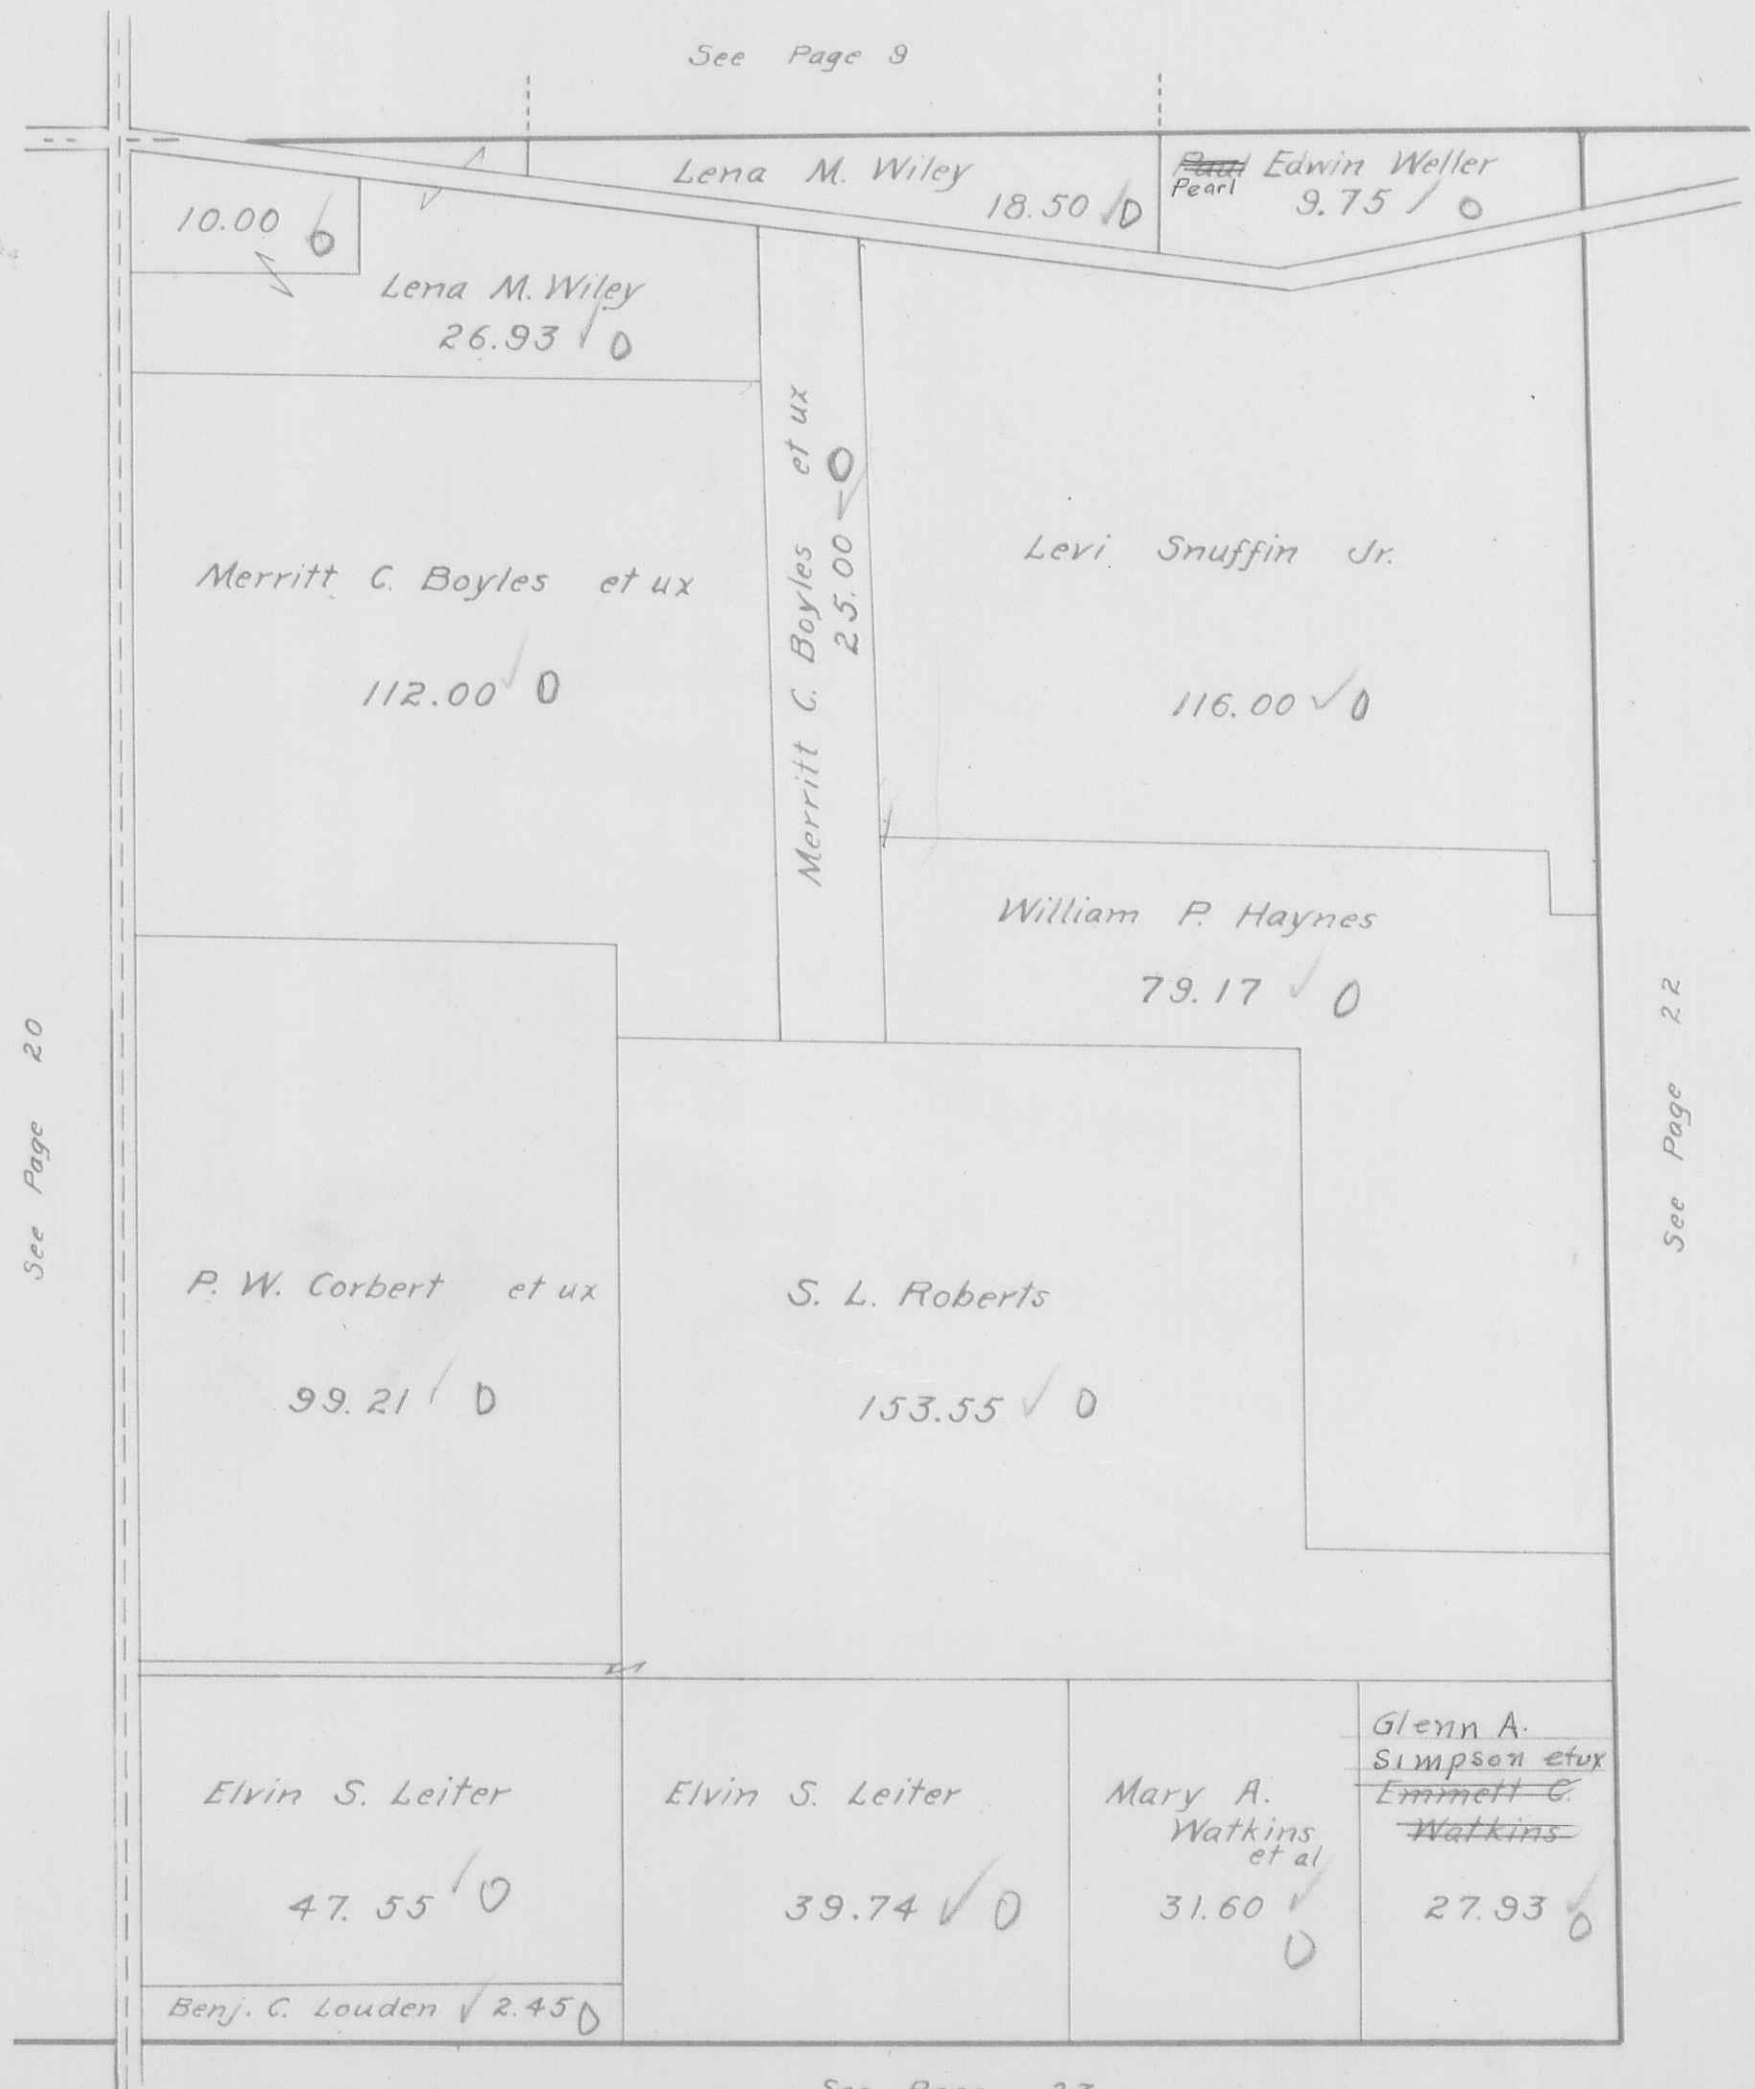


ZANE TOWNSHIP
VIRGINIA MILITARY SURVEYS

3163
3681
4880

SCALE 10 CHAINS TO THE INCH

(See Page 9)

(See Page 17)

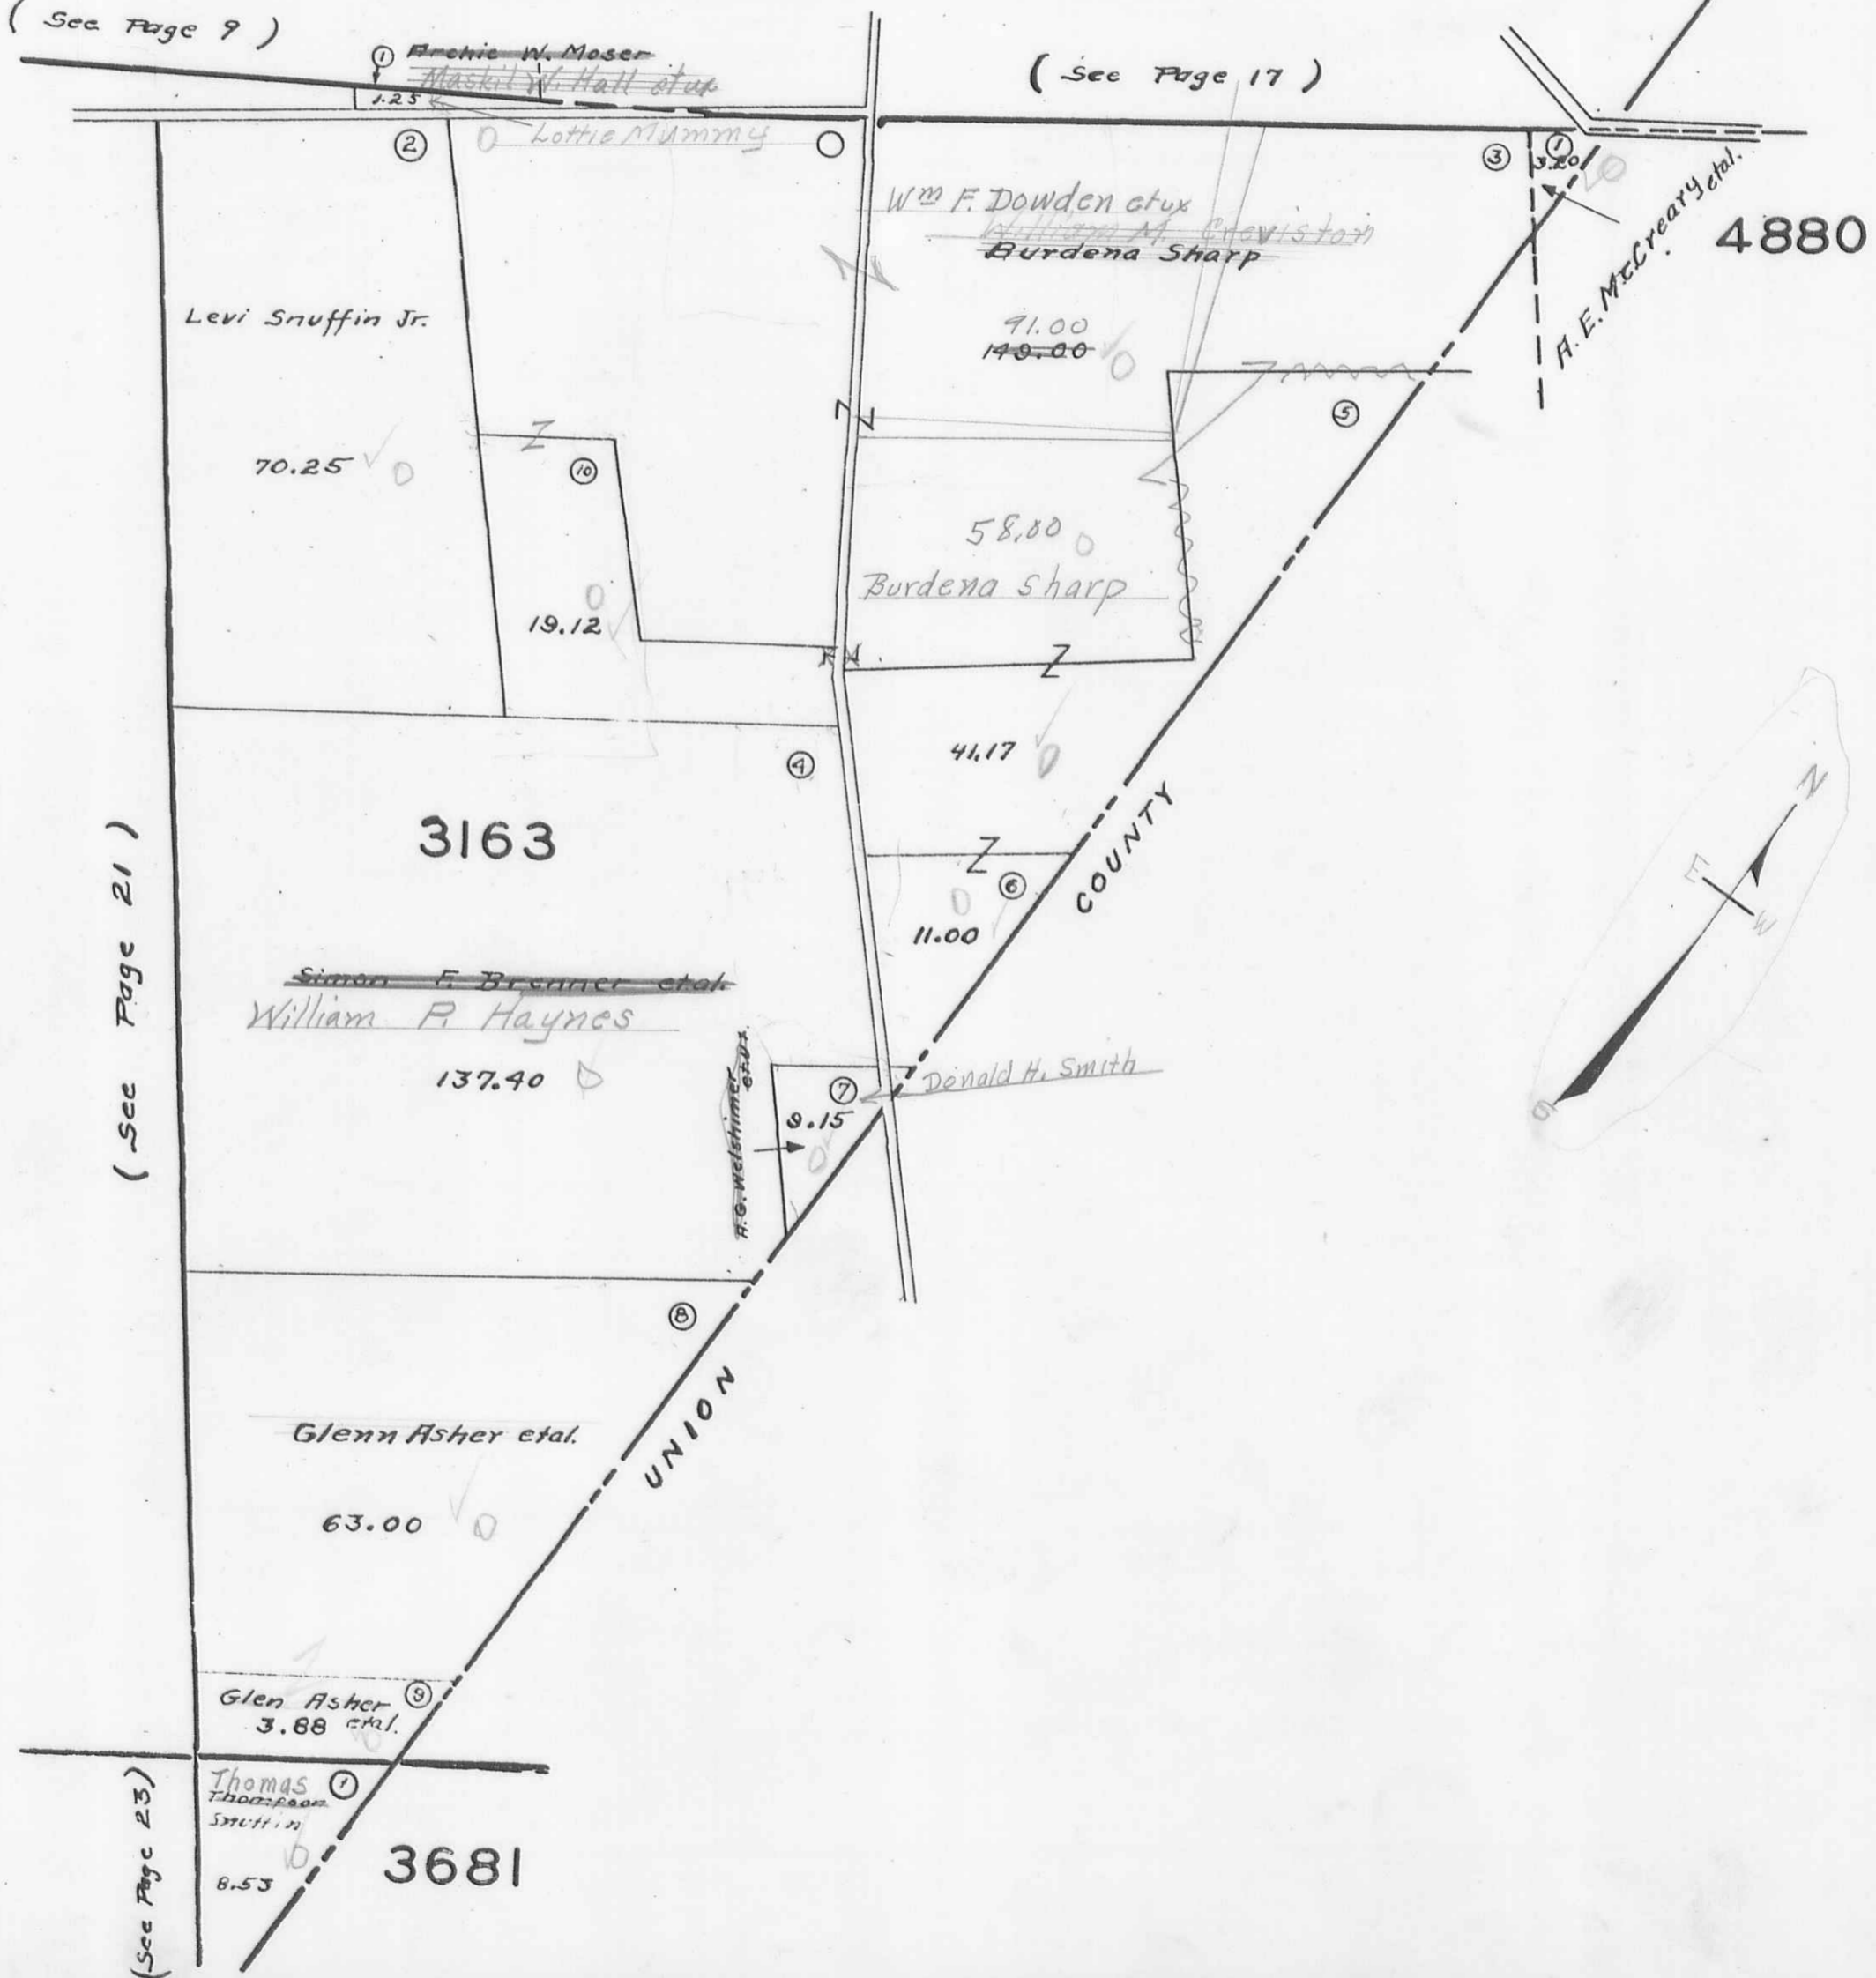

(See Page 21)

(See Page 23)

ZANE TOWNSHIP
VIRGINIA MILITARY SURVEYS

1502
4759
{4658
4678

SCALE 10 CHAINS TO THE INCH



ZANE TOWNSHIP
 VIRGINIA MILITARY SURVEY 3155

MIDDLEBURG

SCALE 200 FEET TO THE INCH

(See Page 5)


(See Page 6)

V.M.S. 3753

V.M.S. 3154

V.M.S. 3680

V.M.S. 3155

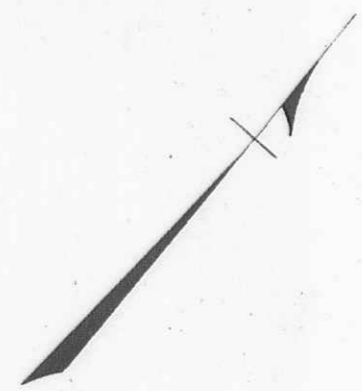

14
 Frank Norviel
~~John D. Black~~
 Glenn Carpenter
 Carrie M.
 Brugermeister
 2.45 ✓ .50

John C. Losey See page 6
 15.46 ✓
 3.51

James Teets et ux
 3.51 ✓ 15.46 0

76	75	74
		73
		72
		21

70	69
71	68
22	67

102
101
100

WESTERN STREET

STREET

77	20
78	19
79	18
80	17

23	66
24	65
25	64
26	63

99
98
97
96

(See Page 8)

John C. Losey

Bertha V. Miller

STREET

WATER

33	32	29
		16
		15
		14
34	31	30
		13

STREET

COLUMBUS

1	62
2	61
3	28
4	27

STREET

NORTH

95	
94	
69	59

(See Page 26)

35	36	37
		12
		11
		10
40	39	38
		9

5	51	52
6		
7	93	
8	92	

GREEN STREET

STREET


V.M.S. 3680

V.M.S. 3155

(See Page 25)

ZANE TOWNSHIP
 VIRGINIA MILITARY SURVEY 3155
 MIDDLEBURG

(See Page 24) SCALE 200 FEET TO THE INCH

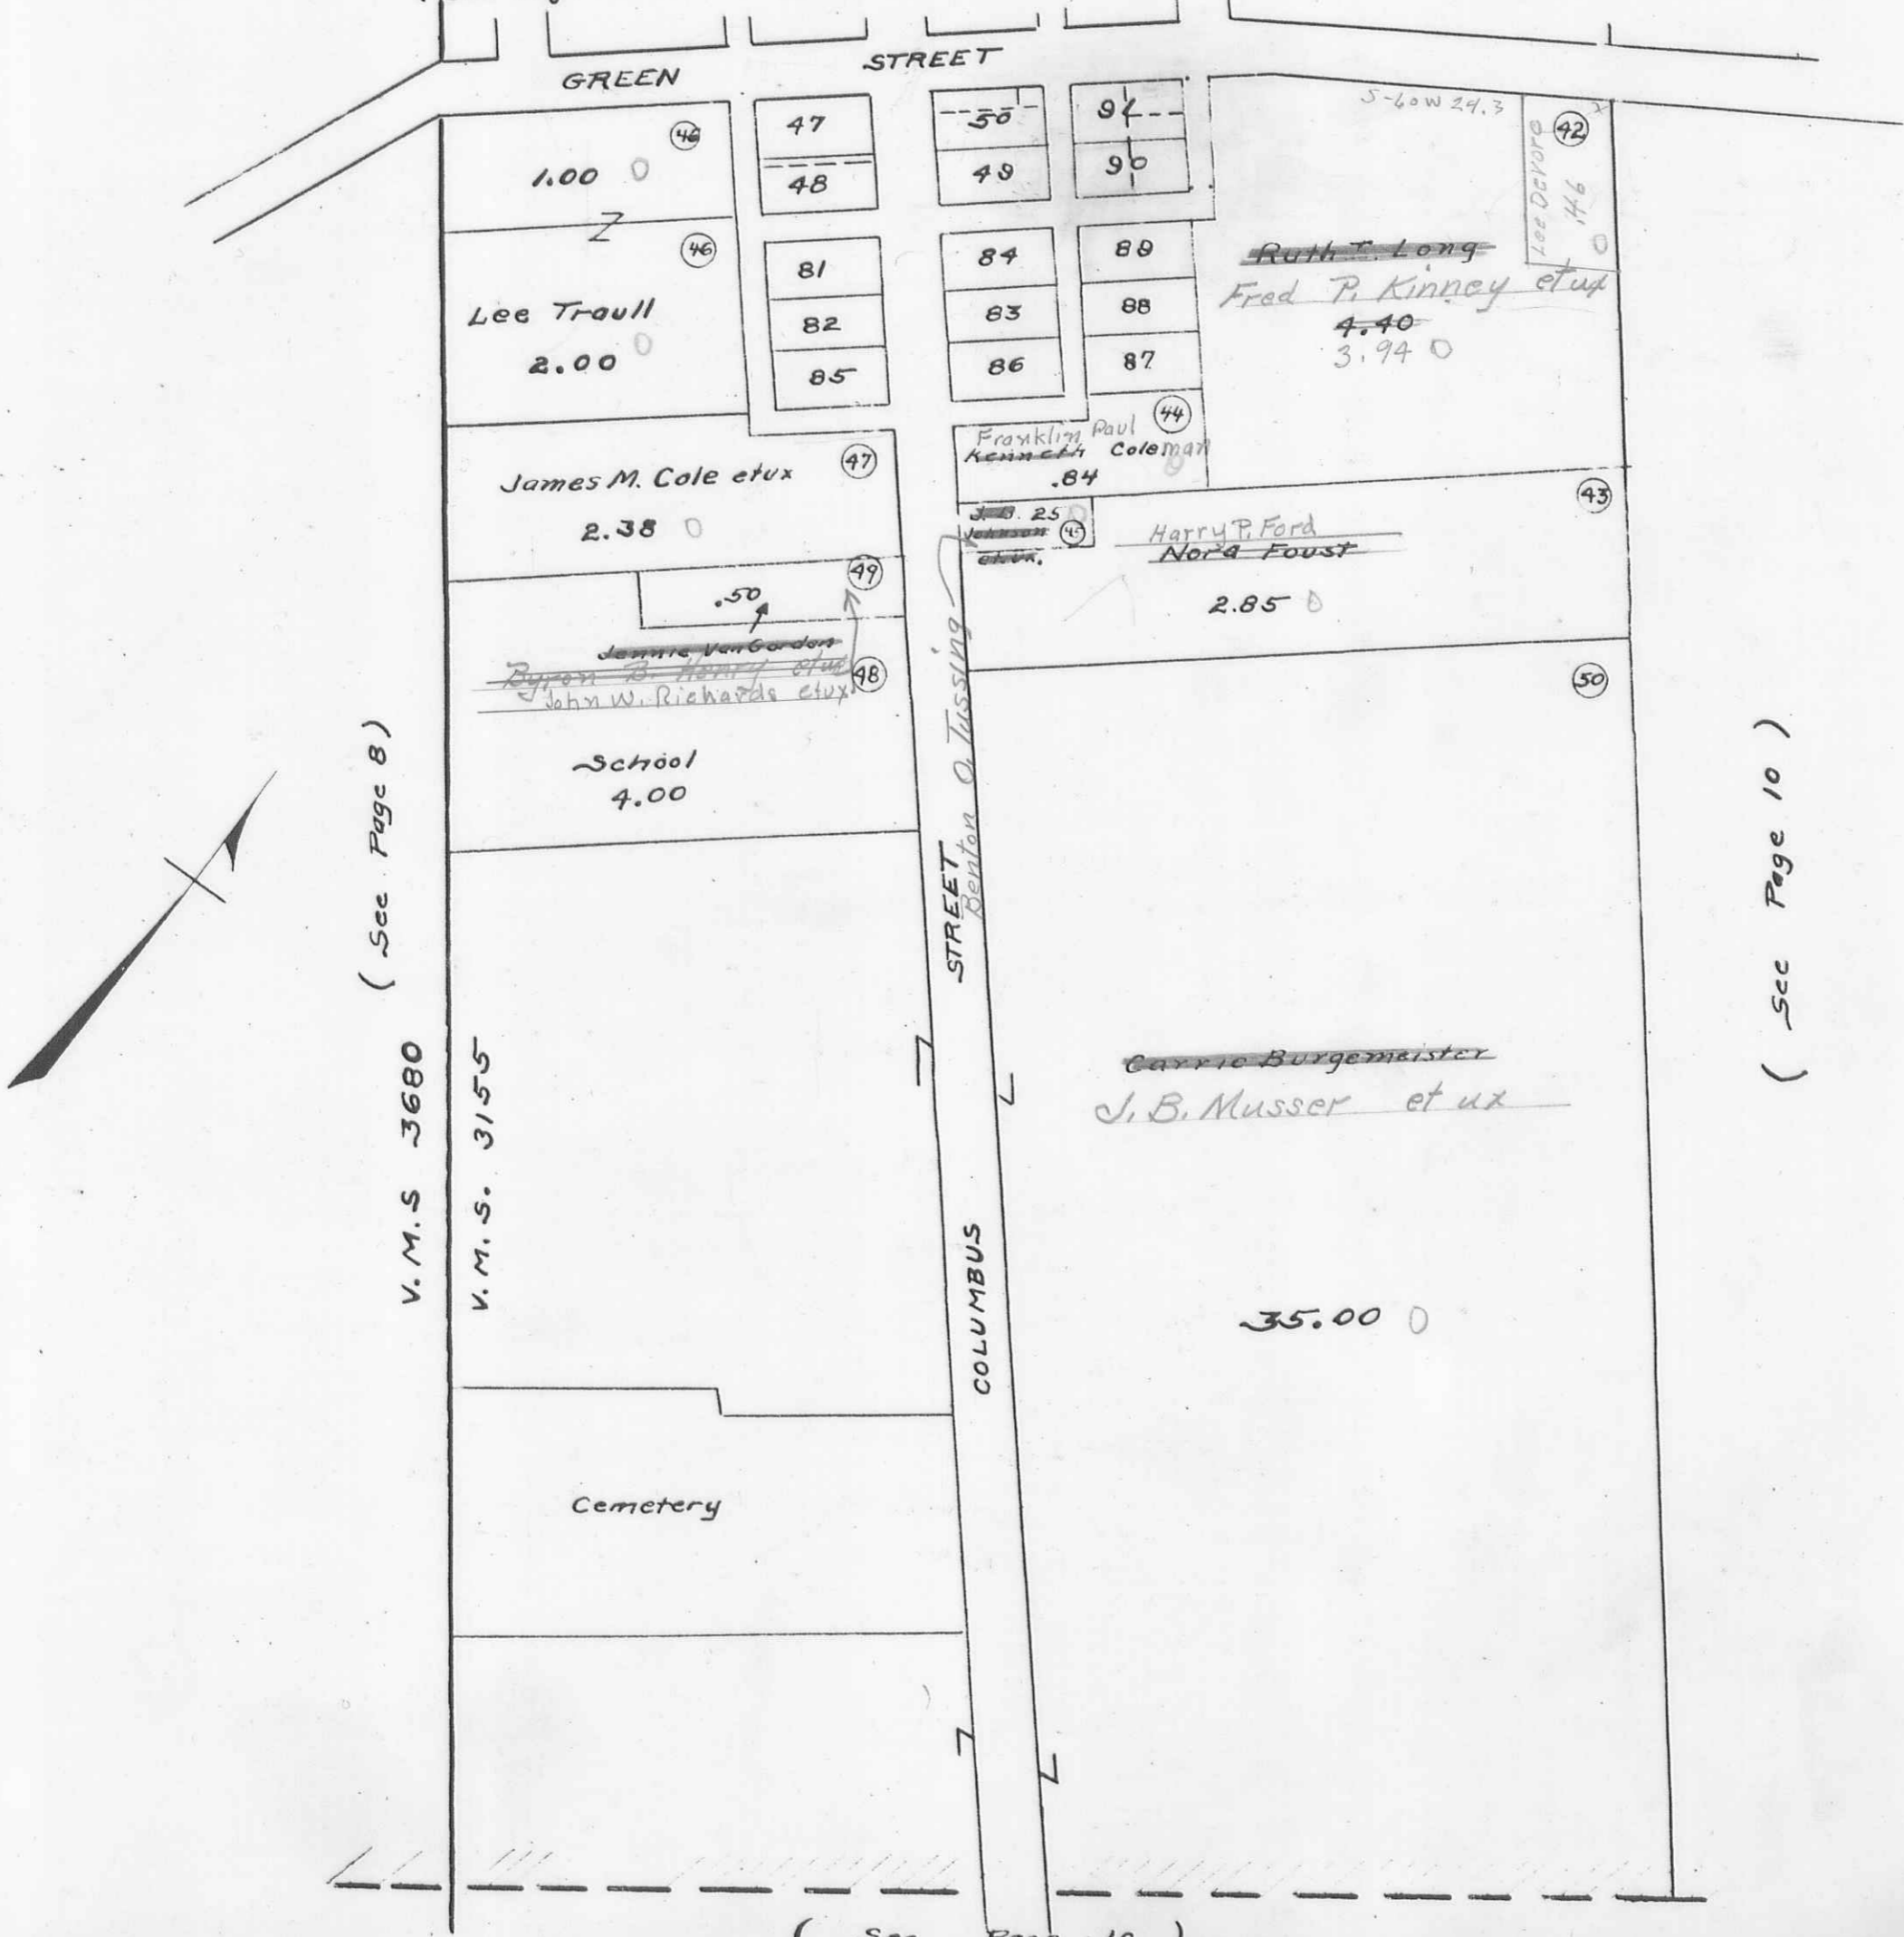

R.F.W. G.W.V.
 1853. 1113.

ZANE TOWNSHIP
VIRGINIA MILITARY SURVEY 3155
MIDDLEBURG

SCALE 200 FEET TO THE INCH

