
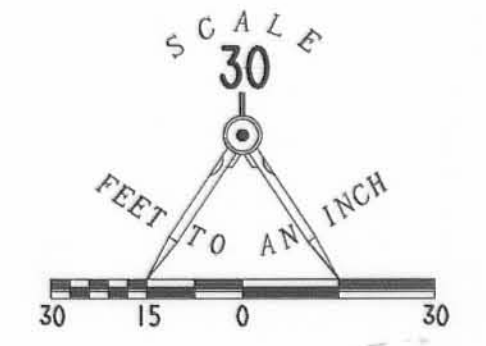


WHETSTONE COMMONS CONDOMINIUM

PHASE II

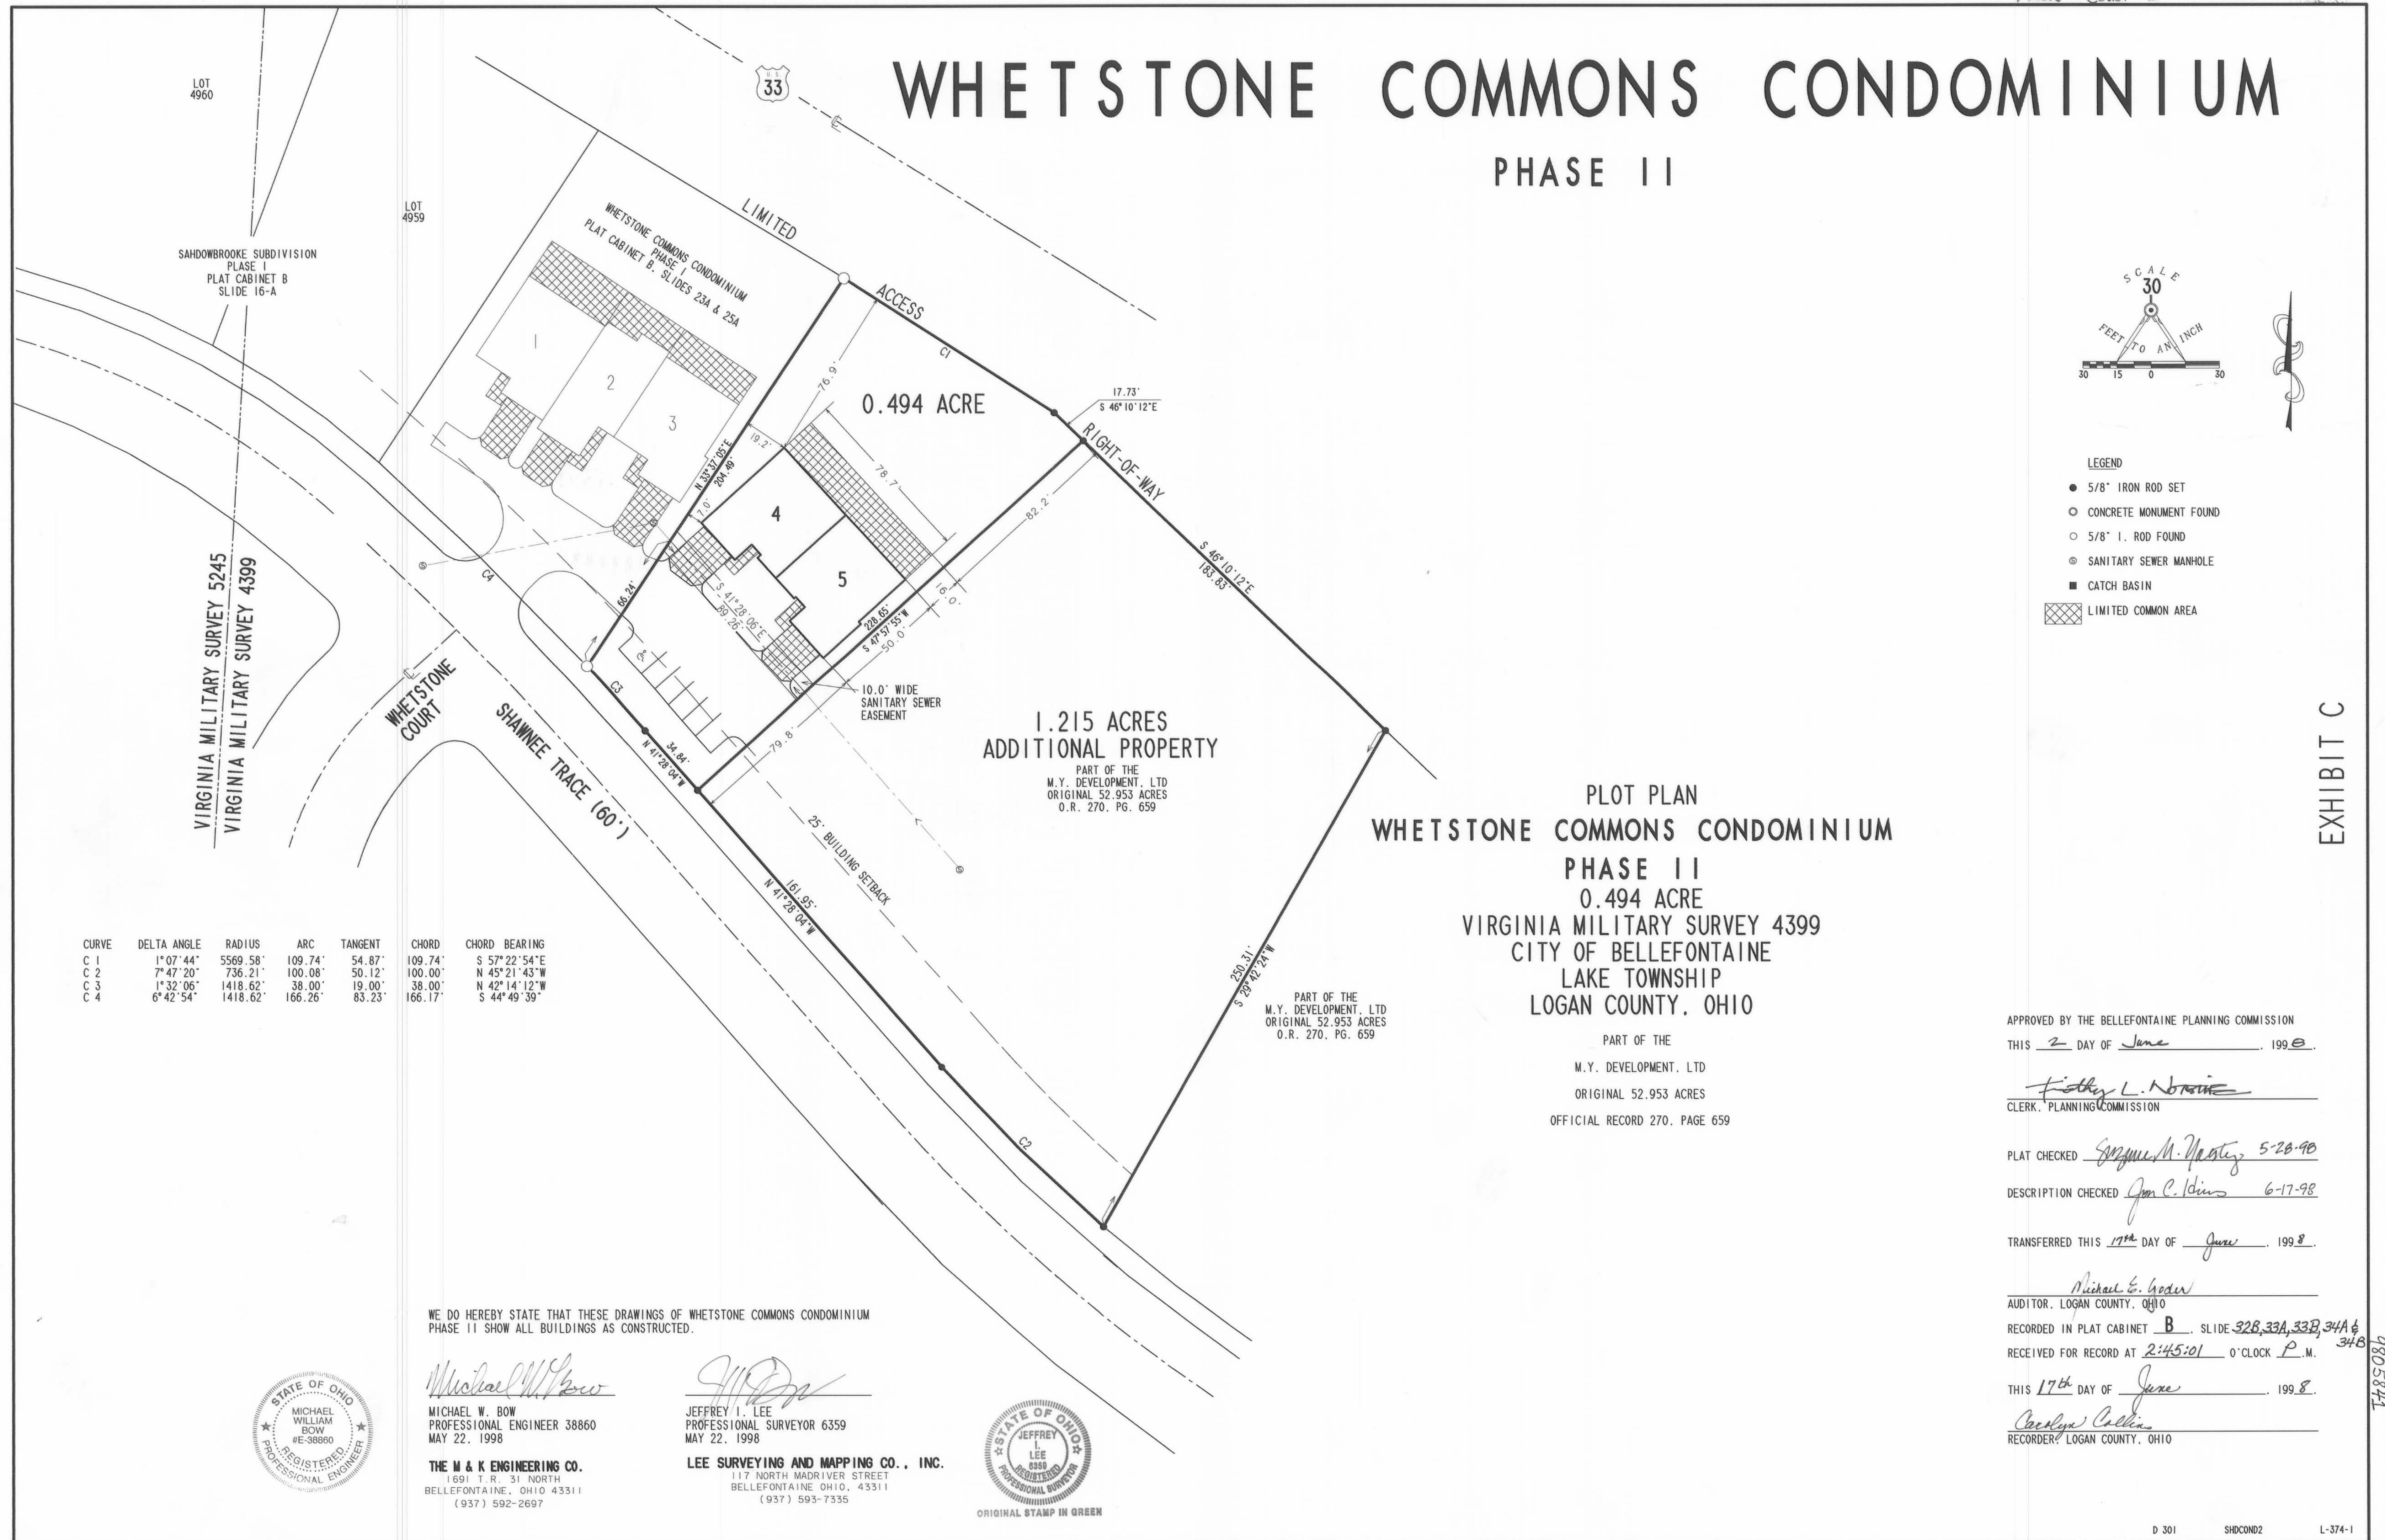

- LEGEND**
- 5/8" IRON ROD SET
 - CONCRETE MONUMENT FOUND
 - 5/8" I. ROD FOUND
 - ⊙ SANITARY SEWER MANHOLE
 - CATCH BASIN
 - ▨ LIMITED COMMON AREA

CURVE	DELTA ANGLE	RADIUS	ARC	TANGENT	CHORD	CHORD BEARING
C 1	1° 07' 44"	5569.58'	109.74'	54.87'	109.74'	S 57° 22' 54" E
C 2	7° 47' 20"	736.21'	100.08'	50.12'	100.00'	N 45° 21' 43" W
C 3	1° 32' 06"	1418.62'	38.00'	19.00'	38.00'	N 42° 14' 12" W
C 4	6° 42' 54"	1418.62'	166.26'	83.23'	166.17'	S 44° 49' 39" E

**1.215 ACRES
ADDITIONAL PROPERTY**
PART OF THE
M.Y. DEVELOPMENT, LTD
ORIGINAL 52.953 ACRES
O.R. 270, PG. 659

**PLOT PLAN
WHETSTONE COMMONS CONDOMINIUM
PHASE II
0.494 ACRE
VIRGINIA MILITARY SURVEY 4399
CITY OF BELLEFONTAINE
LAKE TOWNSHIP
LOGAN COUNTY, OHIO**

PART OF THE
M.Y. DEVELOPMENT, LTD
ORIGINAL 52.953 ACRES
OFFICIAL RECORD 270, PAGE 659

WE DO HEREBY STATE THAT THESE DRAWINGS OF WHETSTONE COMMONS CONDOMINIUM PHASE II SHOW ALL BUILDINGS AS CONSTRUCTED.



Michael W. Bow
MICHAEL W. BOW
PROFESSIONAL ENGINEER 38860
MAY 22, 1998

THE M & K ENGINEERING CO.
1891 T.R. 31 NORTH
BELLEFONTAINE, OHIO 43311
(937) 592-2697

Jeffrey I. Lee
JEFFREY I. LEE
PROFESSIONAL SURVEYOR 6359
MAY 22, 1998

LEE SURVEYING AND MAPPING CO., INC.
117 NORTH MADRIVER STREET
BELLEFONTAINE OHIO, 43311
(937) 593-7335



ORIGINAL STAMP IN GREEN

APPROVED BY THE BELLEFONTAINE PLANNING COMMISSION
THIS 2 DAY OF June, 1998.

Fisher L. Nottme
CLERK, PLANNING COMMISSION

PLAT CHECKED *George M. Mastey* 5-28-98

DESCRIPTION CHECKED *Jim C. Davis* 6-17-98

TRANSFERRED THIS 17th DAY OF June, 1998.

Michael E. Godwin
AUDITOR, LOGAN COUNTY, OHIO

RECORDED IN PLAT CABINET B SLIDE 32B, 33A, 33B, 34A & 34B

RECEIVED FOR RECORD AT 2:45:01 O'CLOCK P.M.

THIS 17th DAY OF June, 1998.


Carolyn Collins
RECORDER, LOGAN COUNTY, OHIO

EXHIBIT C

M. Y. DEVELOPMENT LTD.
 P. O. BOX 705
 WEST LIBERTY, OH 43887
 PH: 937-465-8526

SHADOWBROOKE
 VILLAS WEST STONE COMMONS
 BELLEFONTAINE OHIO 43311

DRAWING NAME
FOUNDATION PLAN
 SCALE 1/4" = 1'-0"

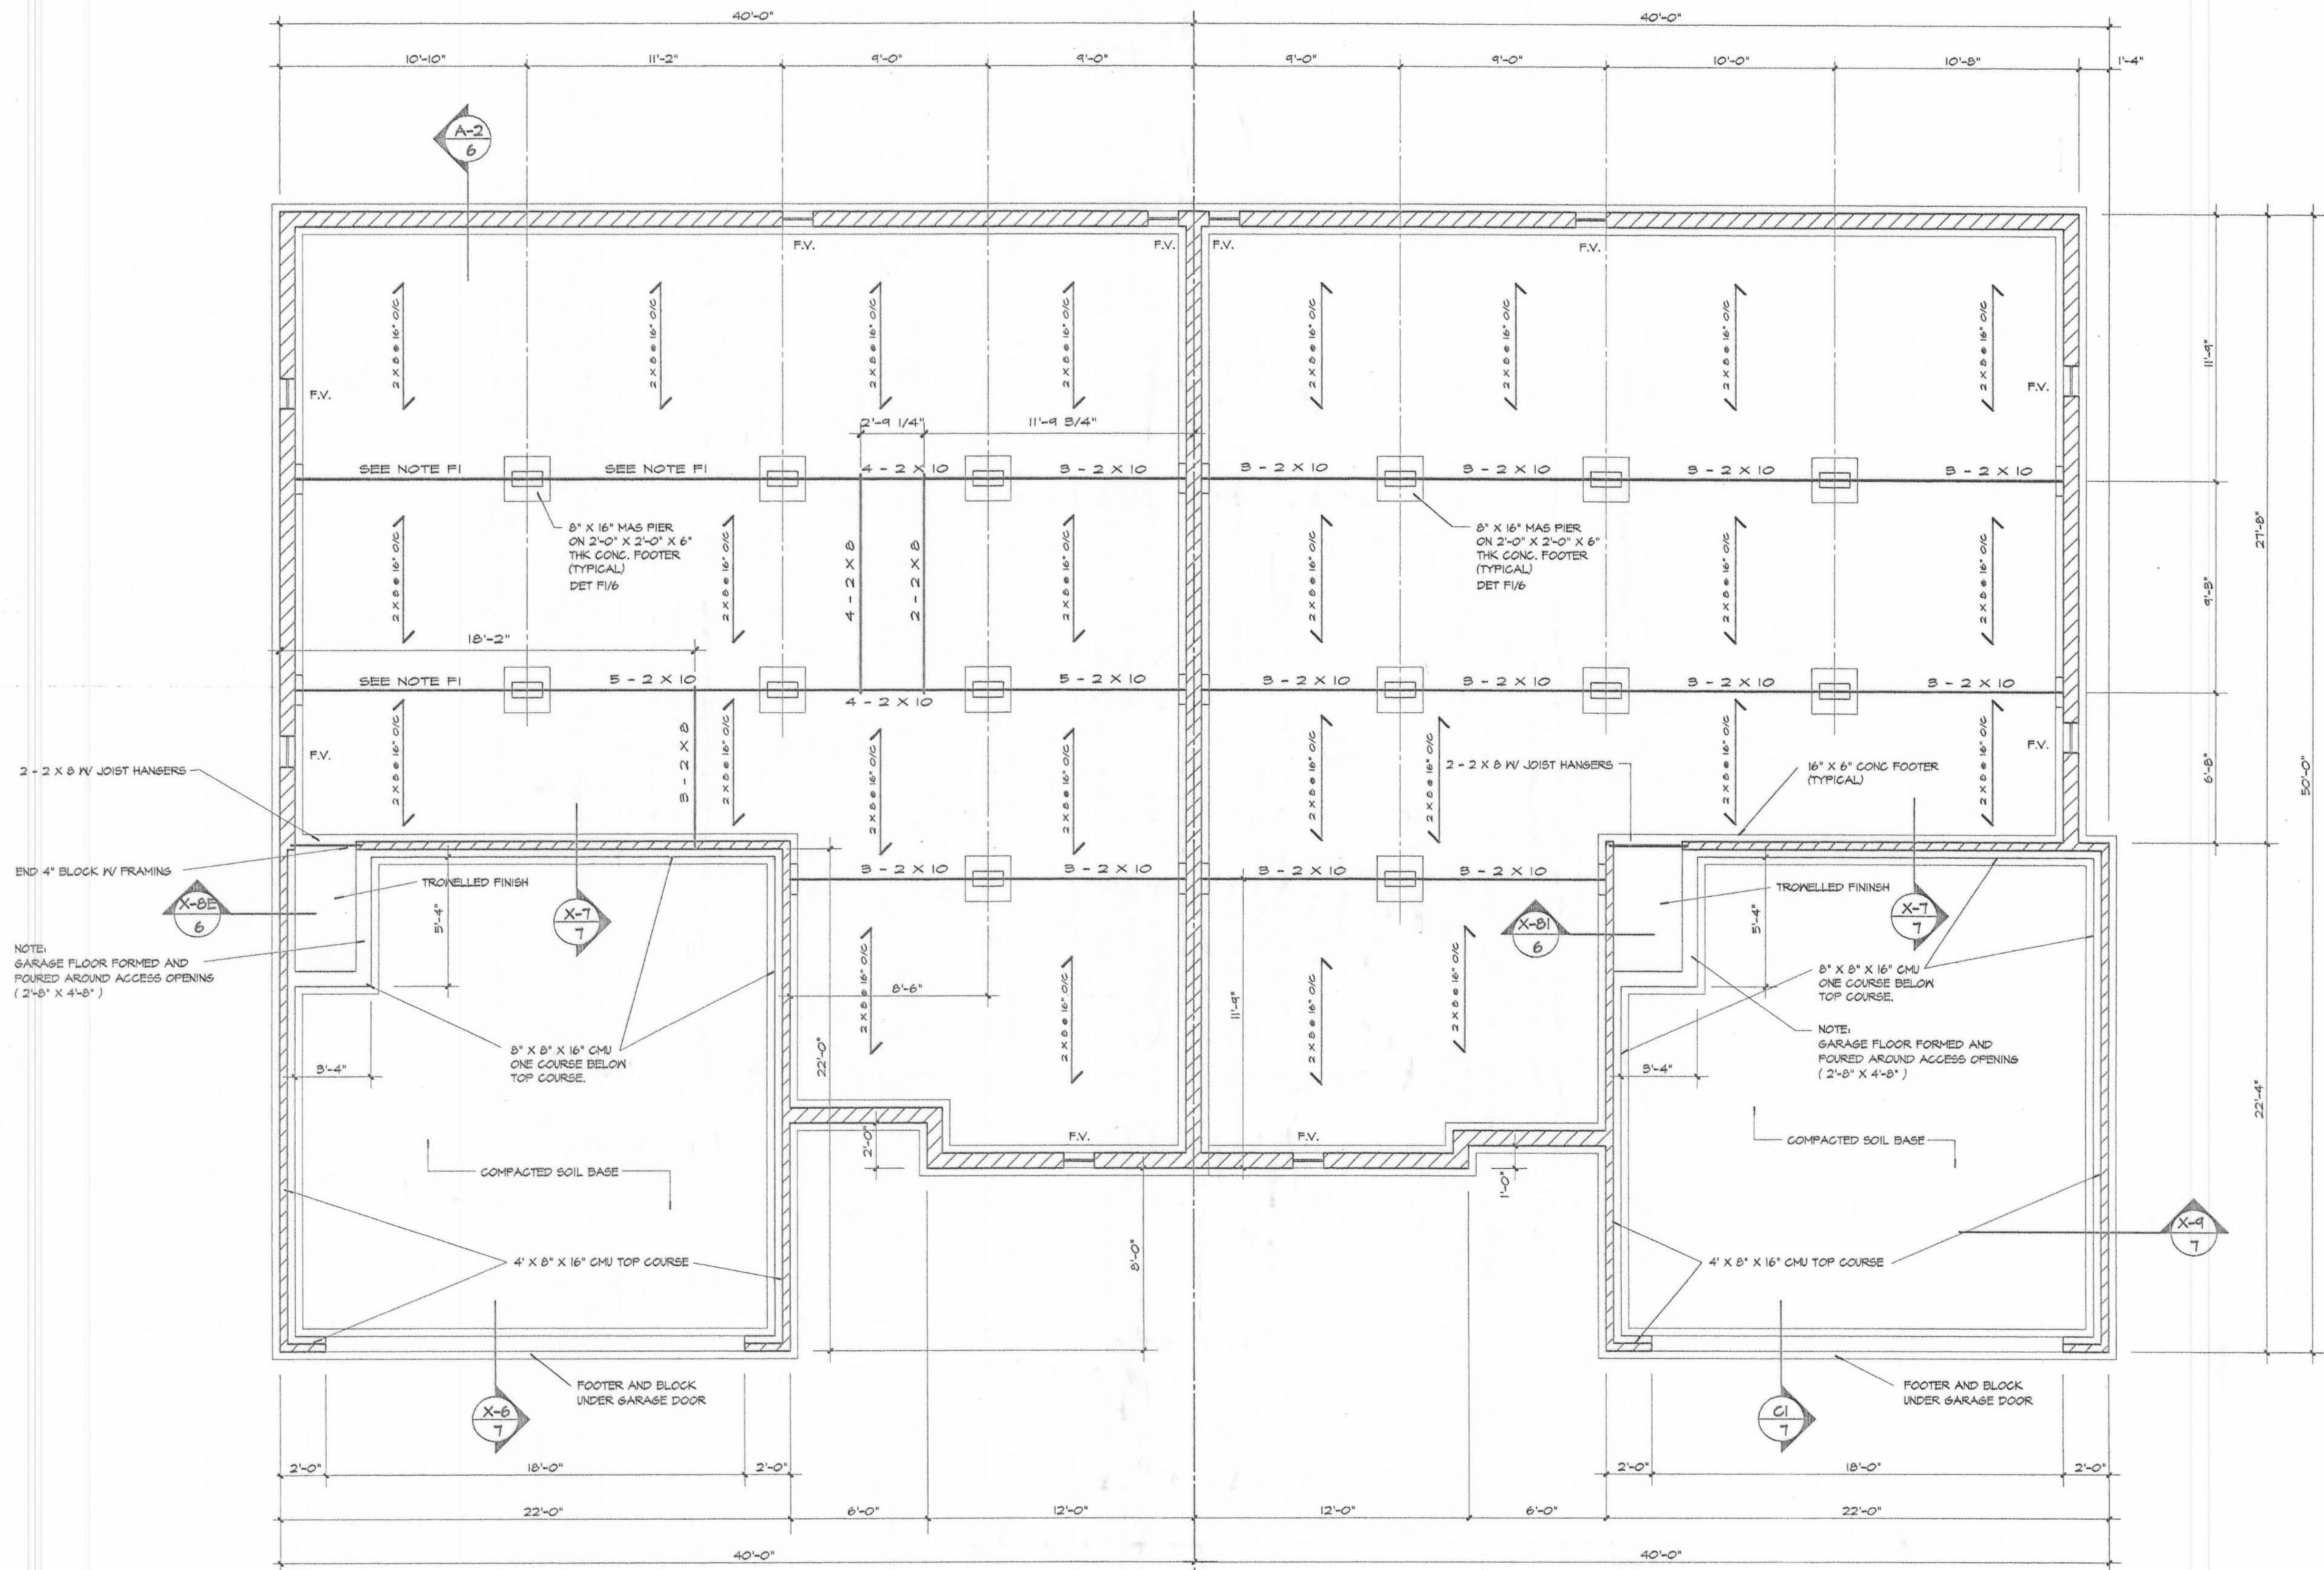

2 - 2 X 8 IV JOIST HANGERS
 END 4" BLOCK IV FRAMING
 NOTE:
 GARAGE FLOOR FORMED AND
 Poured AROUND ACCESS OPENING
 (2'-8" X 4'-8")

NOTE F1:
 B - 2 X 10 FOR STD PLAN
 4 - 2 X 10 FOR OPTIONAL BED ROOM

REVISION	DATE	CONSTRUCTION	DRAWN BY
		JANUARY	BPB

SHEET NO.

M. Y. DEVELOPMENT LTD.
P. O. BOX 705
WEST LIBERTY, OH 43087
PH: 937-465-8526




SHADOWBROOKE
VILLAS WEST STONE COMMONS
BELLEFONTAINE OHIO 43811

DRAWING NAME
FLOOR PLAN
SCALE 1/4" = 1'-0"

DRAWING NAME

REVISION
DATE
CONSTRUCTION PHASE
JANUARY 1998

SHEET NO.
2

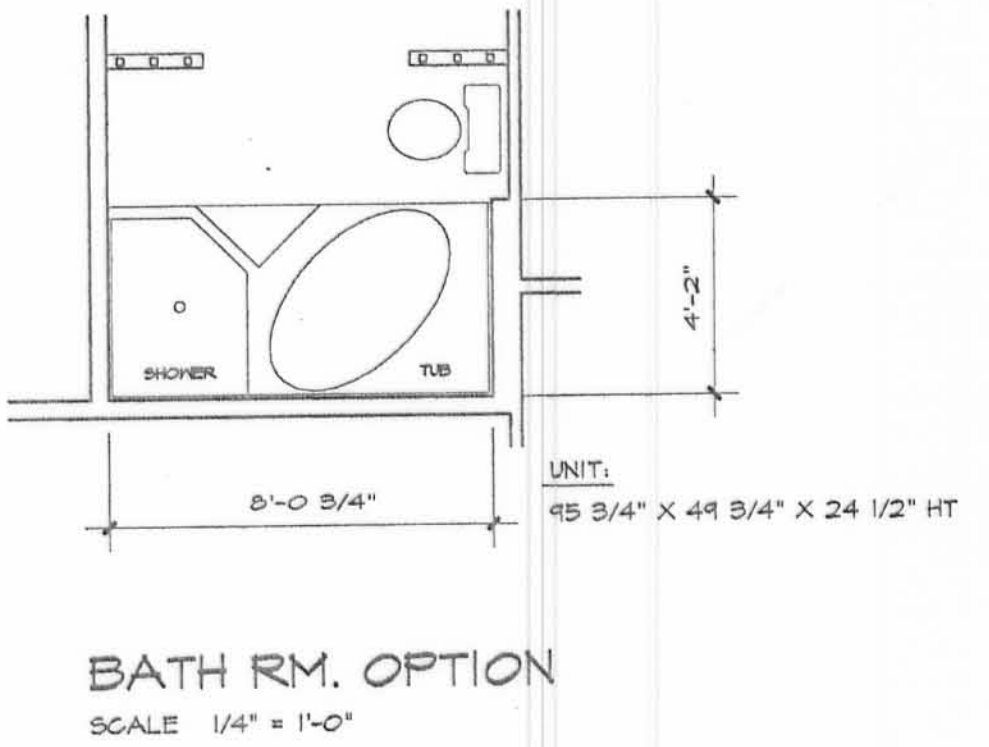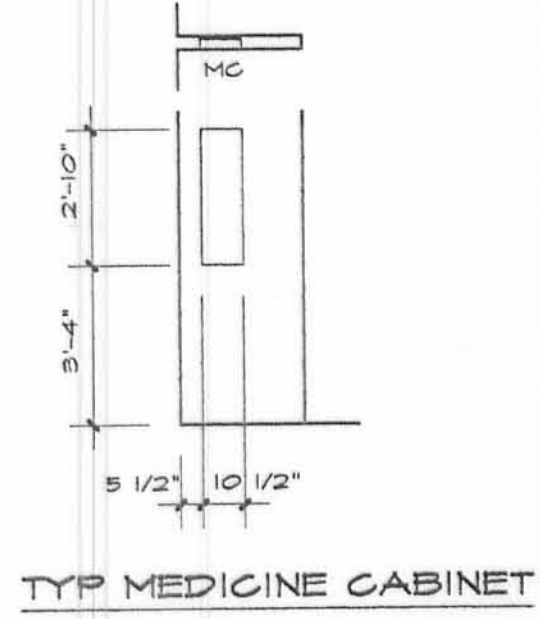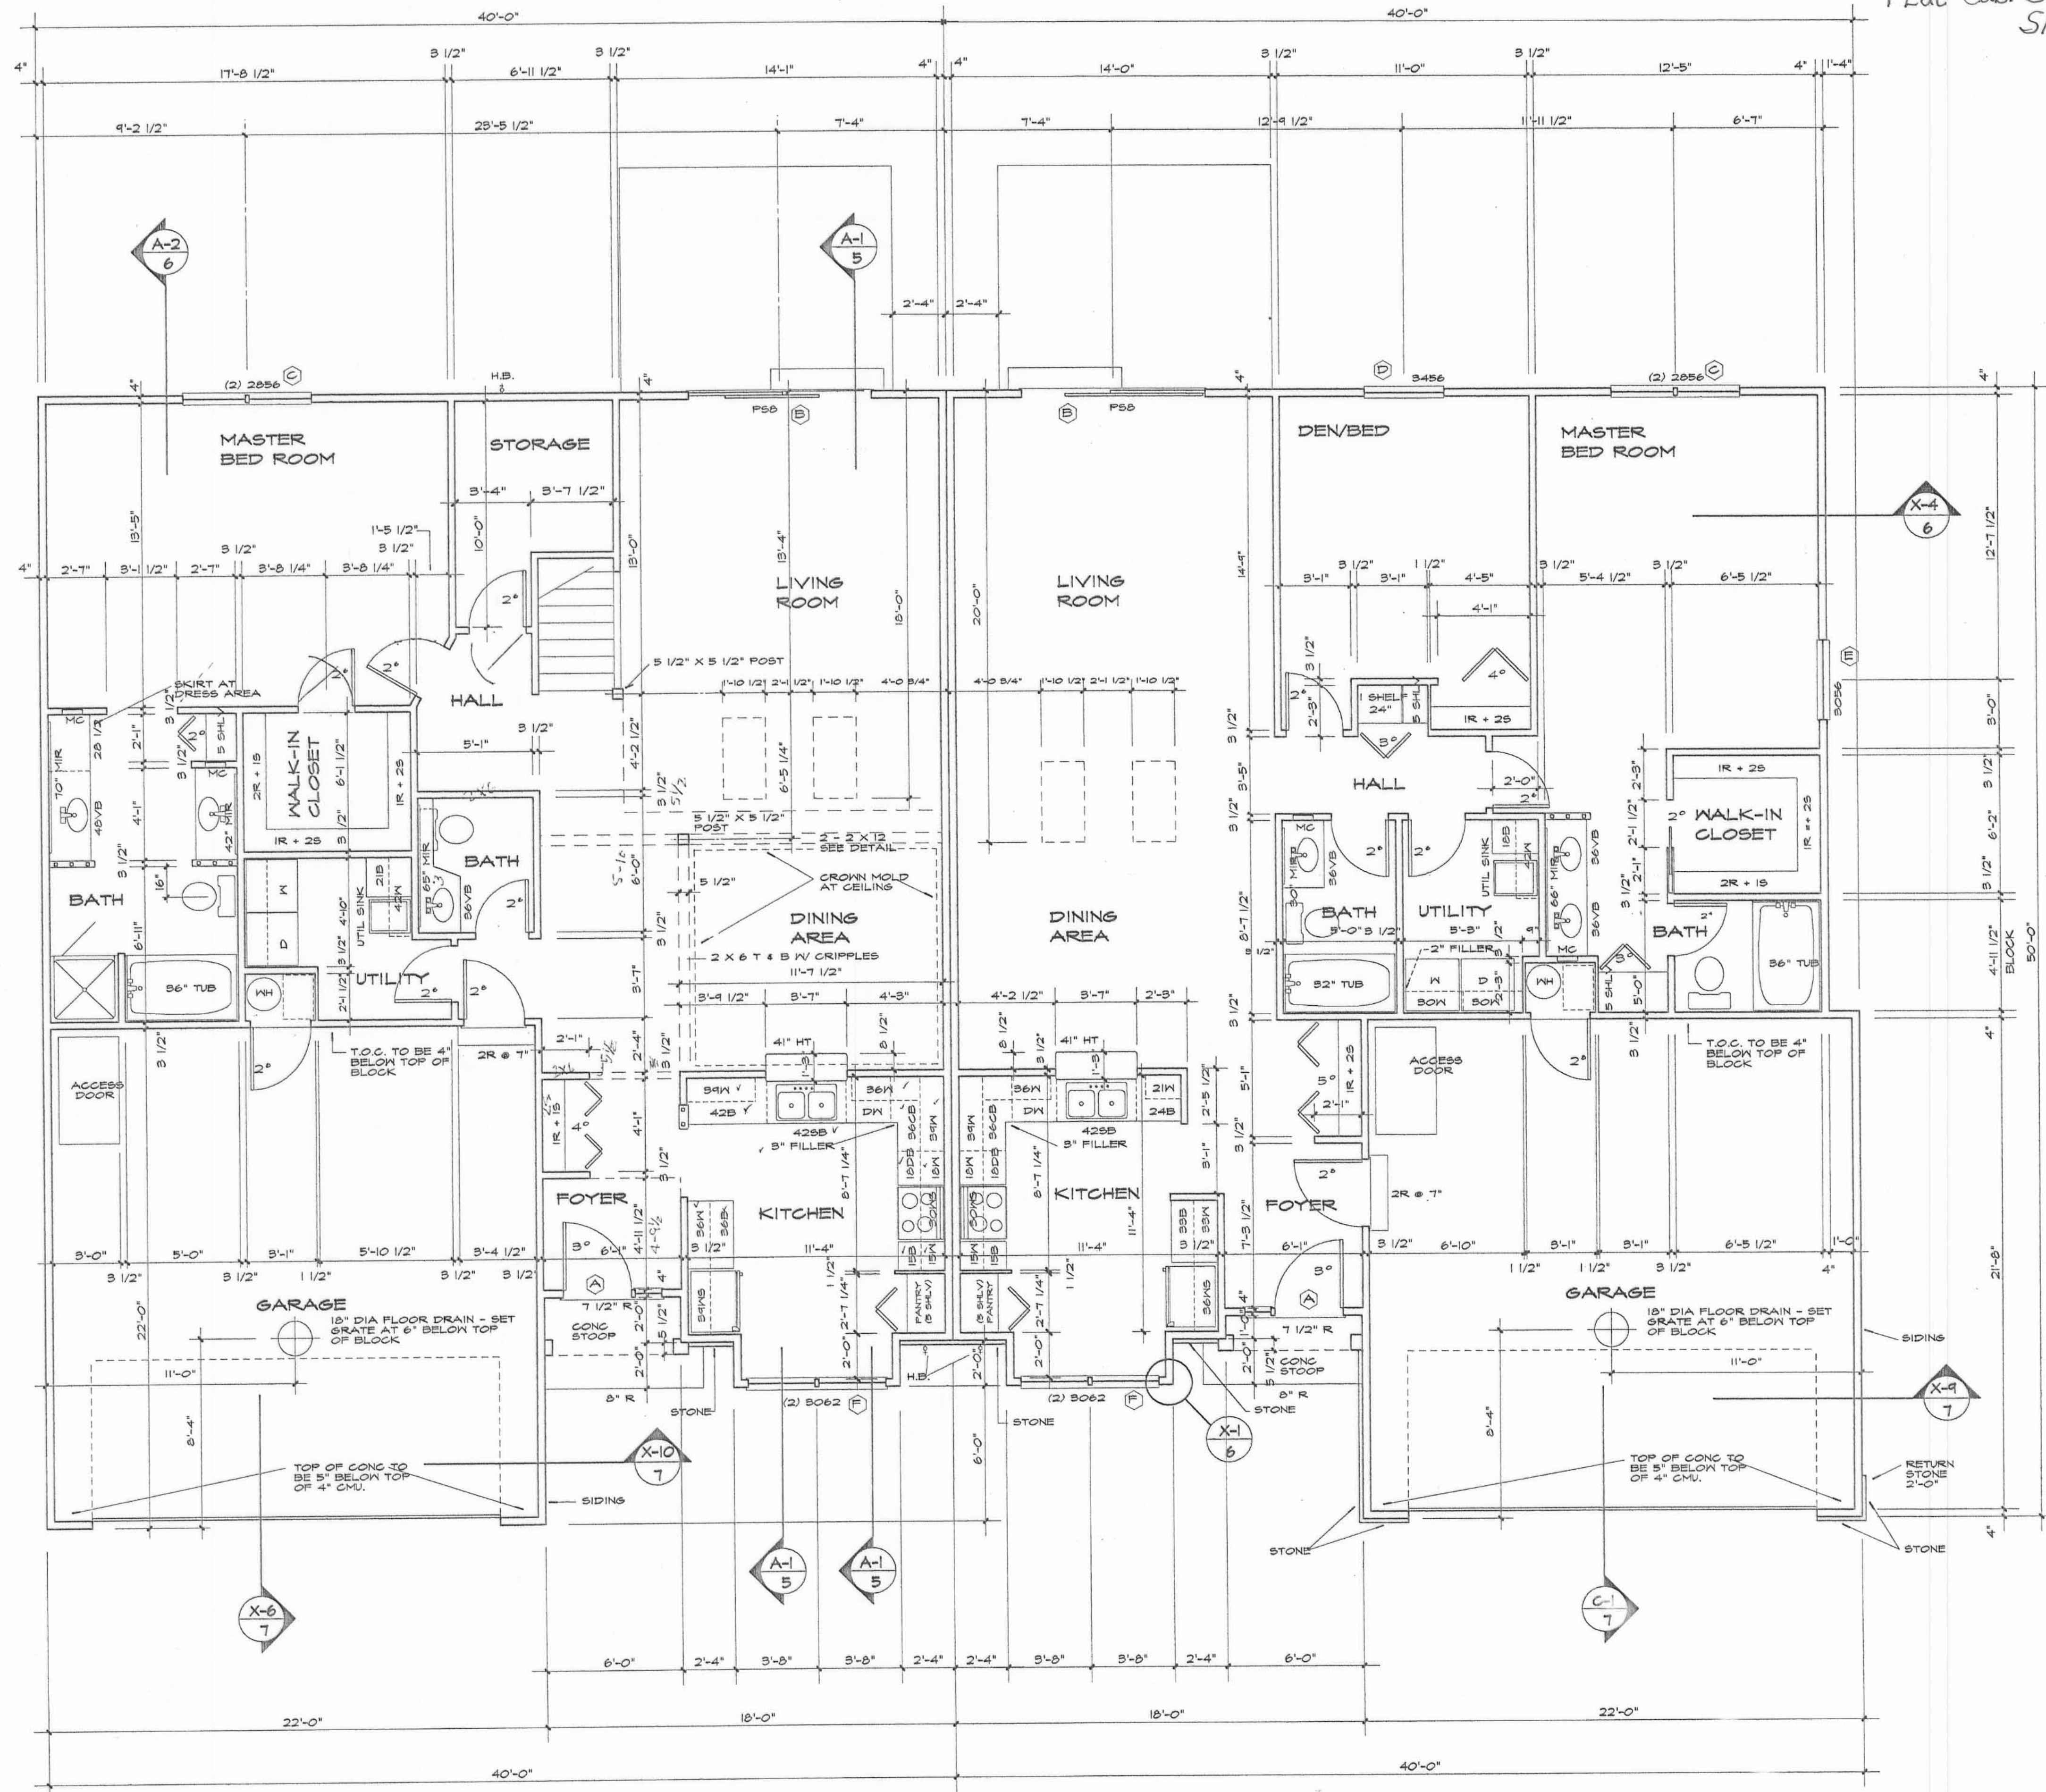


NOTES:

- ALL MIRRORS ARE 40" HT.
- SET TOWEL BARS AT 48" A.F.F.
- SET PAPER HOLDERS AS DIRECTED.


ROUGH FRAMED OPENING SIZES:

- (A) 52" X 82 1/2"
- (B) 8'-0 3/4" X 6'-11"
- (C) 5'-7 3/4" X 5'-1 1/4"
- (D) 3'-6 1/8" X 5'-9 1/4"
- (E) 3'-2 1/8" X 5'-9 1/4"
- (F) 6'-5 1/4" X 6'-5 1/4"

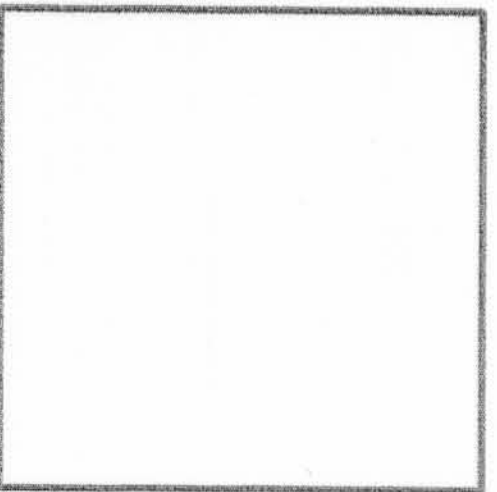

M. Y. DEVELOPMENT LTD.
 P. O. BOX 705
 WEST LIBERTY, OH 43087
 PH: 937-465-8526

SHADOWBROOKE
 VILLAS WEST STONE COMMONS
 BELLEFONTAINE OHIO 43111

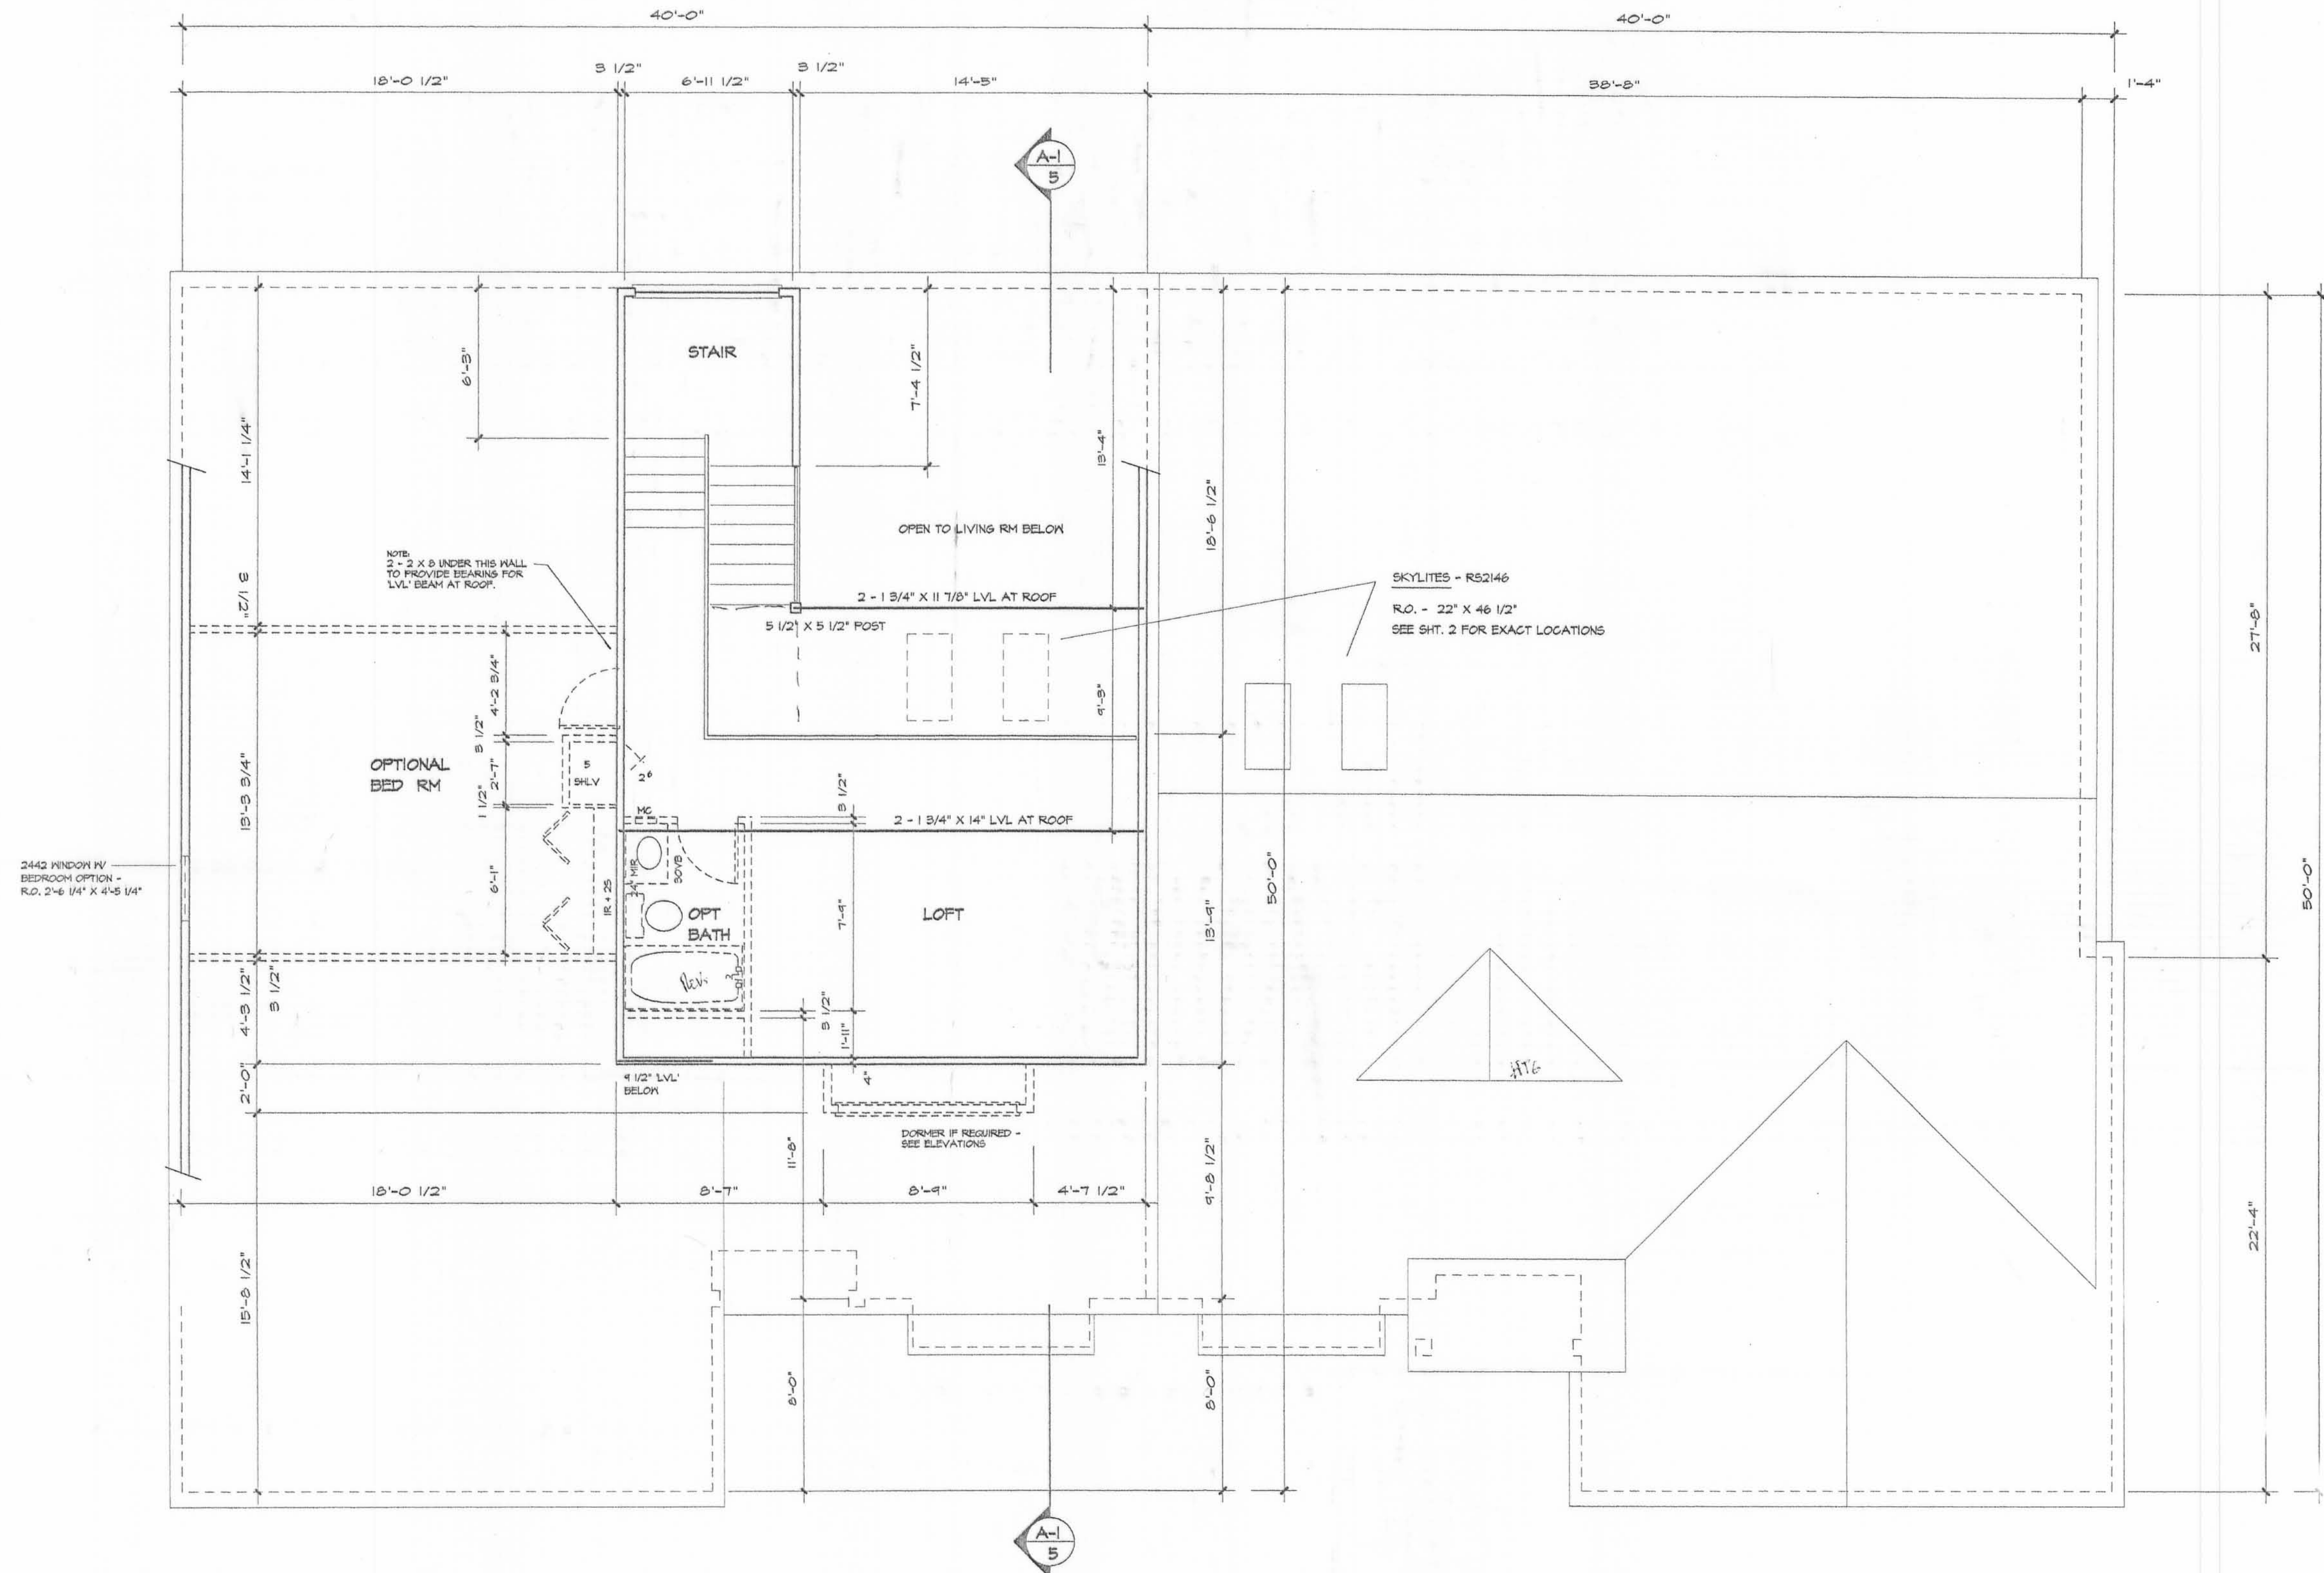


DRAWING NAME

UPPER PLAN

SCALE 1/4" = 1'-0"

REVISION
 DATE
 CONSTRUCTION DWG
 JANUARY 1998
 SHEET NO.



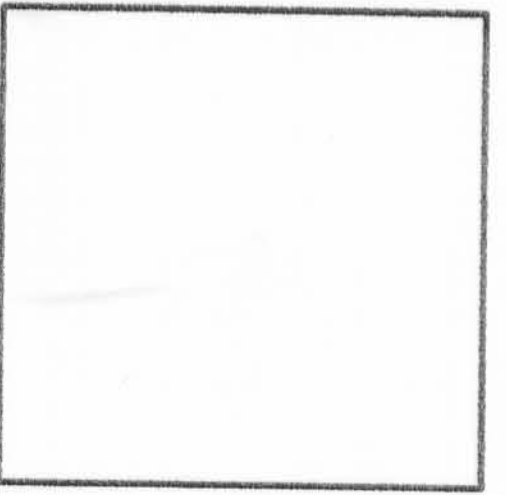


M. Y. DEVELOPMENT LTD.
P. O. BOX 705
WEST LIBERTY, OH 43357
PH: 937-465-8526


SHADOWBROOKE
VILLAS • WEST STONE COMMONS
BELLEFONTAINE OHIO 43311



FRONT

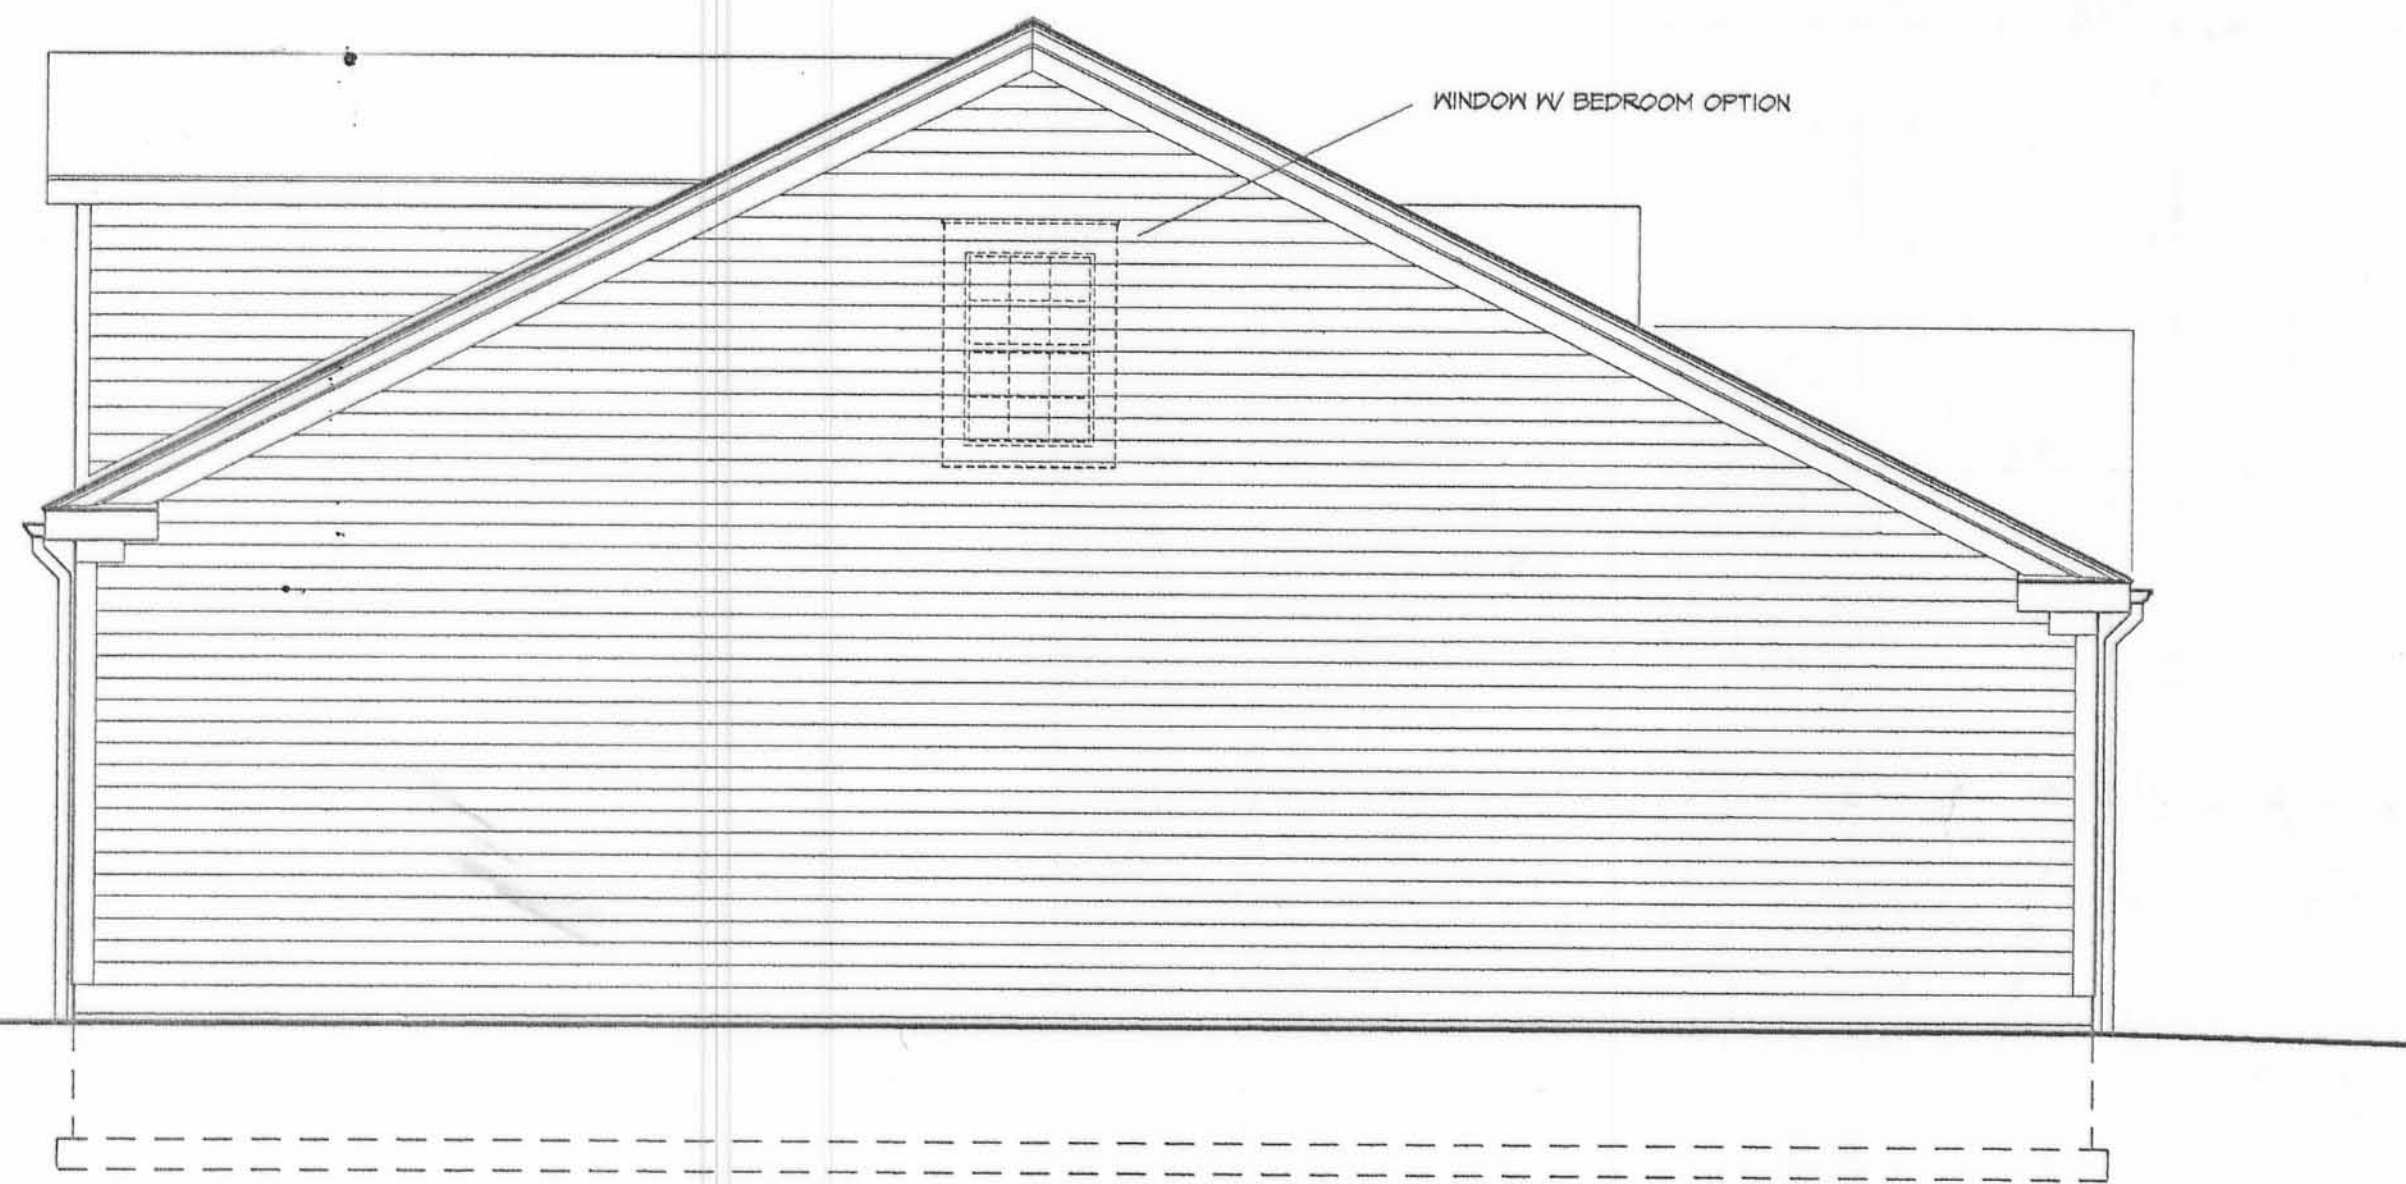

LEFT

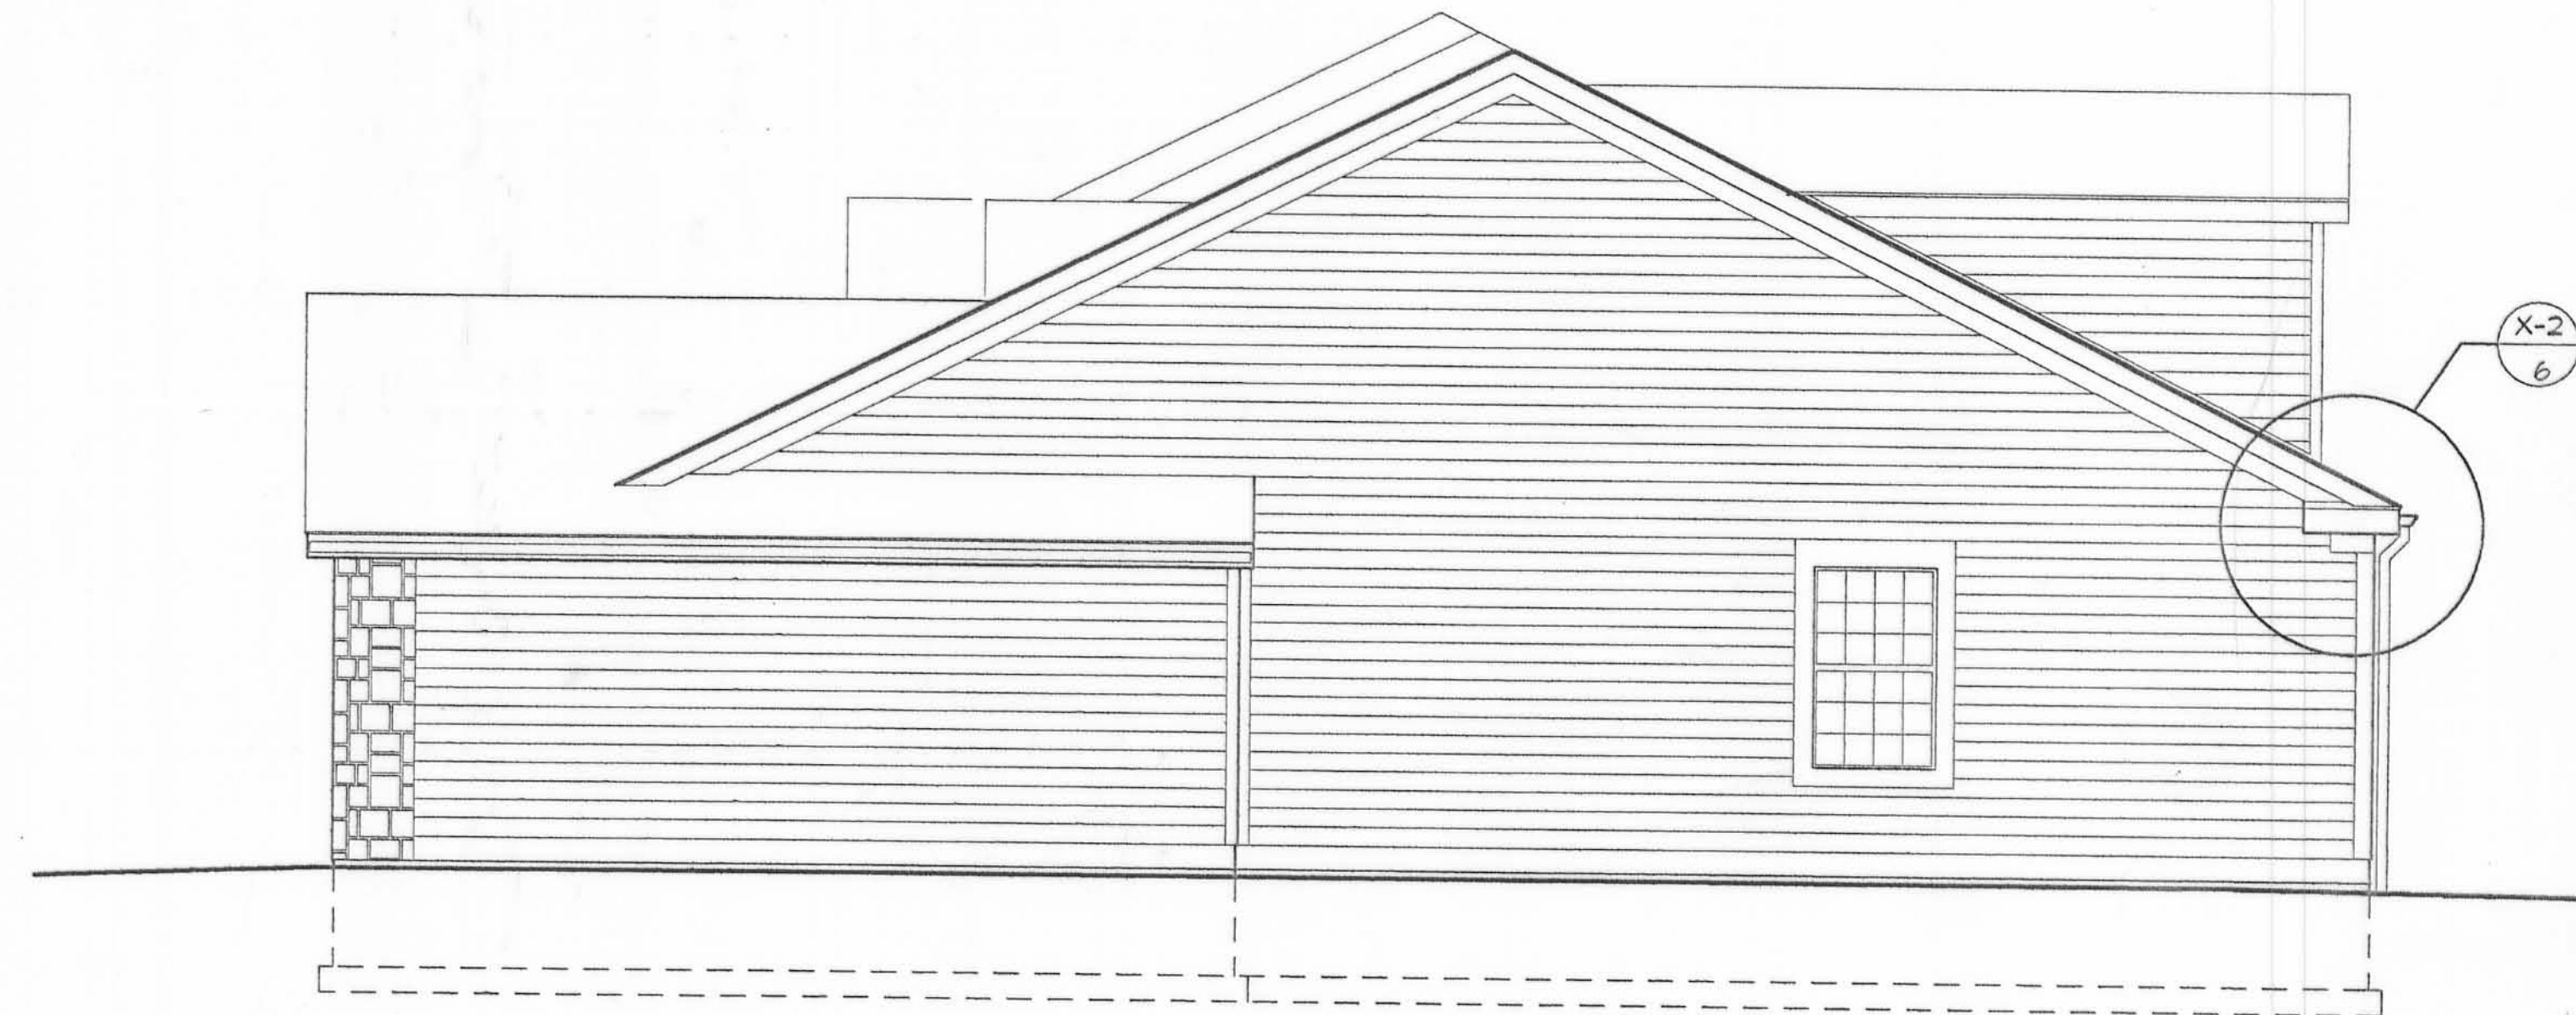

RIGHT



REAR

DRAWING NAME

ELEVATIONS

SCALE 1/4" = 1'-0"

REVISION
DATE
CONSTRUCTION DINGS
JANUARY 1991

SHEET NO.

4

A-157A

A-157A