



EXHIBIT B TO DECLARATION AND BYLAWS OF LUDLOW BRIDGE CONDOMINIUMS - PHASE IX

6.04 ACRE TRACT, 1.00 ACRE TRACT, 8.05 ACRE TRACT OFFICIAL RECORD 710, PAGE 550, TRACTS I, II AND III
0.868 ACRE TRACT OFFICIAL RECORD 740, PAGE 620

VIRGINIA MILITARY SURVEY 4990 CITY OF BELLEFONTAINE LAKE TOWNSHIP LOGAN COUNTY, OHIO

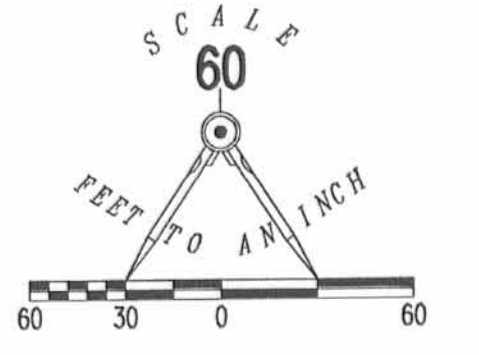

CURVE	DELTA ANGLE	RADIUS	ARC LENGTH	CHORD BEARING	CHORD LENGTH
C1	15°04'58"	88.00	23.17	S 76°42'24" E	23.10
C2	33°57'12"	100.00	59.26	S 22°03'33" W	58.40
C3	18°45'04"	50.00	16.36	S 14°27'29" W	16.29
C4	35°40'10"	88.00	54.78	S 22°55'02" W	53.90
C5	18°35'57"	62.00	20.13	S 14°22'37" W	20.04
C6	16°59'17"	88.00	26.09	S 49°14'46" W	26.00
C7	74°50'42"	62.00	80.99	S 32°20'24" E	75.35
C8	20°09'21"	62.00	21.81	N 84°26'59" W	21.70
C9	49°12'53"	62.00	53.26	N 21°01'05" W	51.63
C10	51°52'12"	112.00	101.39	N 84°18'09" E	97.97
C11	52°29'51"	88.00	80.63	S 83°59'20" W	77.84
C12	24°19'33"	112.00	47.55	S 70°31'50" W	47.20
C13	21°40'03"	62.00	23.45	N 05°45'04" W	23.31
C14	15°24'21"	162.00	43.56	S 12°47'08" W	43.43

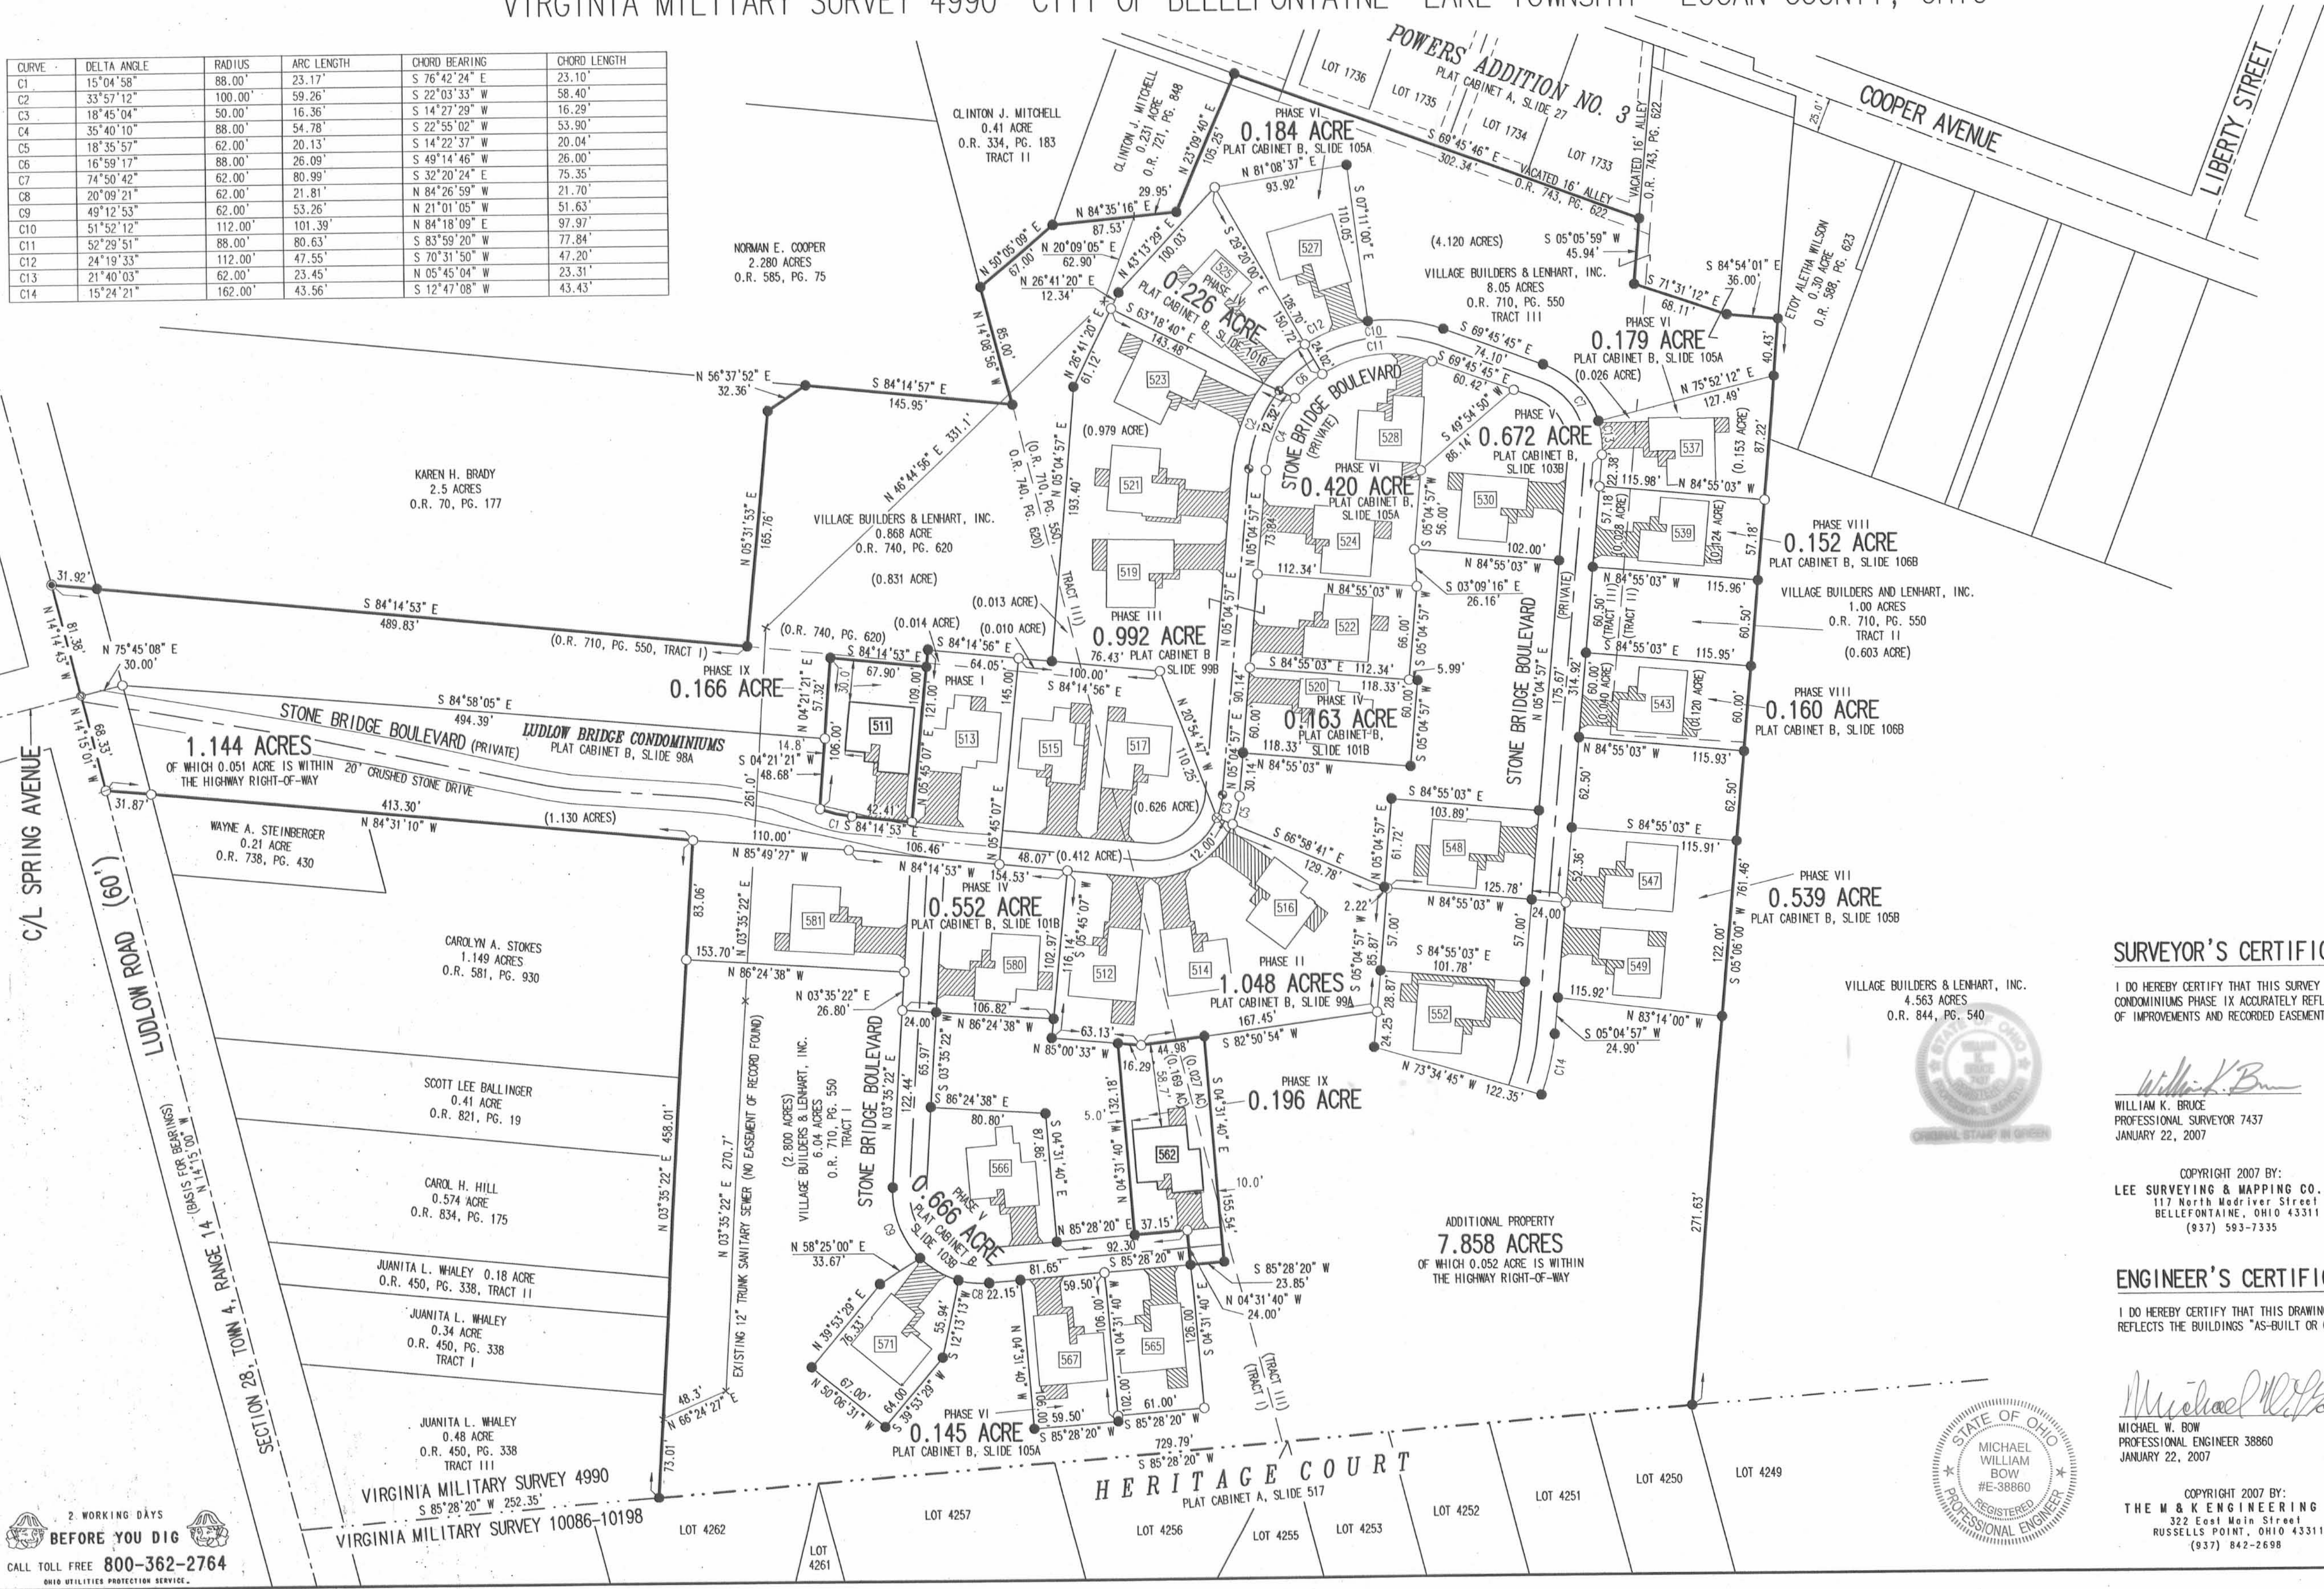

- LEGEND:
- ⊙ 1-1/4 INCH IRON PIPE FOUND
 - 5/8 INCH IRON ROD SET
 - 5/8 INCH IRON ROD FOUND
 - ⊙ MAG NAIL SET
 - ⊙ MAG NAIL FOUND
 - ⊙ RAILROAD SPIKE SET
 - ⊙ RAILROAD SPIKE FOUND
 - ▨ LIMITED COMMON AREA
 - 111 UNIT NUMBER

- NOTES:
1. EASEMENTS IF SHOWN ARE AS PROVIDED BY DEVELOPER. THE SURVEYOR DID NOT SEARCH FOR ADDITIONAL EASEMENTS.
 2. THE WORD "CERTIFY" IS INTENDED TO BE AS DEFINED IN OHIO ADMINISTRATIVE CODE 4733-35-04(C).
 3. BUILDING HEIGHT FROM PEAK OF ROOF TO GROUND:
UNIT 511 IS 19.8'
UNIT 562 IS 21.5'

SURVEYOR'S CERTIFICATION:

I DO HEREBY CERTIFY THAT THIS SURVEY OF LUDLOW BRIDGE CONDOMINIUMS PHASE IX ACCURATELY REFLECTS THE LOCATION OF IMPROVEMENTS AND RECORDED EASEMENTS.

William K. Bruce
WILLIAM K. BRUCE
PROFESSIONAL SURVEYOR 7437
JANUARY 22, 2007

COPYRIGHT 2007 BY:
LEE SURVEYING & MAPPING CO., INC.
117 North Madison Street
BELLEFONTAINE, OHIO 43311
(937) 593-7335

ENGINEER'S CERTIFICATION:

I DO HEREBY CERTIFY THAT THIS DRAWING ACCURATELY REFLECTS THE BUILDINGS "AS-BUILT OR CONSTRUCTED".

Michael W. Bow
MICHAEL W. BOW
PROFESSIONAL ENGINEER 38860
JANUARY 22, 2007

COPYRIGHT 2007 BY:
THE M & K ENGINEERING CO.
322 East Main Street
RUSSELLS POINT, OHIO 43311
(937) 842-2698

PRE-APPROVAL *J.C.H.* 2-15-07
PLAT CHECKED *J.C.H.* 2-15-07
TRANSFERRED THIS 15th DAY OF February, 2007
AUDITOR, LOGAN COUNTY, OHIO
RECORDED IN PLAT CABINET B, SLIDE 107A
RECEIVED FOR RECORD AT 10:45 O'CLOCK A.M.
THIS 15th DAY OF February, 2007
Sandra Hanson
RECORDER, LOGAN COUNTY, OHIO

2 WORKING DAYS
BEFORE YOU DIG
CALL TOLL FREE 800-362-2764
OHIO UTILITIES PROTECTION SERVICE

