

Robert Park } ch. cr. 1 day
J.B. Barger } 1 day

John^T Brennan axe 1 day

Viewers

Finley Reames

Charles Stevenson

Ely

1620

BRENNAN ROAD SURVEY

Road 32' wide
 Commenced center line
 in E Ludlow 16' N. Shawver
 N. Line. Drove Iron screw
 gate hinge.

S. 85 $\frac{1}{4}$ E on Stayrock

1000 ft get stake on E of
 N of S. Line
 Shawvers fence on S. Line

2000' stake on E of N Line


2266 to line John T. Brennan
 and D. E. Shawver

2480. to angle R. D. 32°
 stake on E of N. Line
 S 53 E

3126 to Line J. T. Brennan
 and Mary J. Barger 143' N of
 her S.W. corner
 On Barger

12/9, 1912

Mary J. Barger 3667

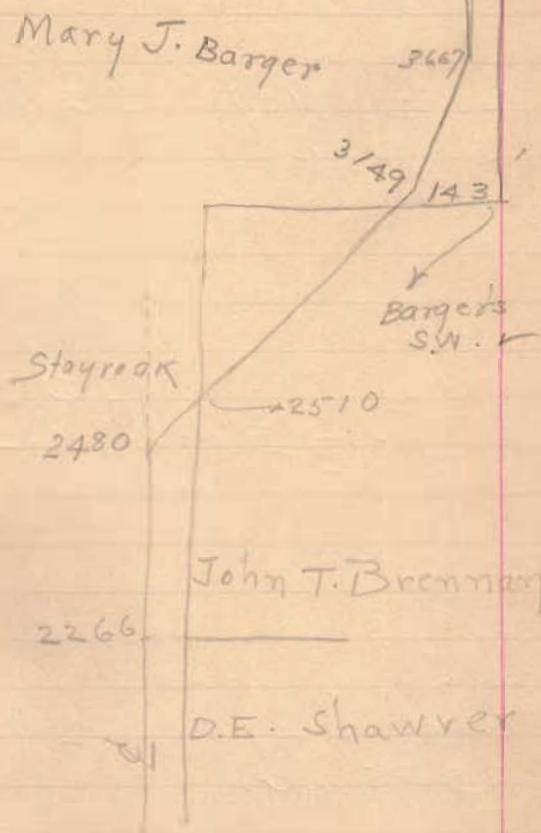


11620

Angle 3149 L.D. 2075'
S 73½° E

Angle 3667 L.D. 12°38'
16' N. of Barger's S. Line
S 86° E

Angle
Stake 4476 on α
S 85¼° E.

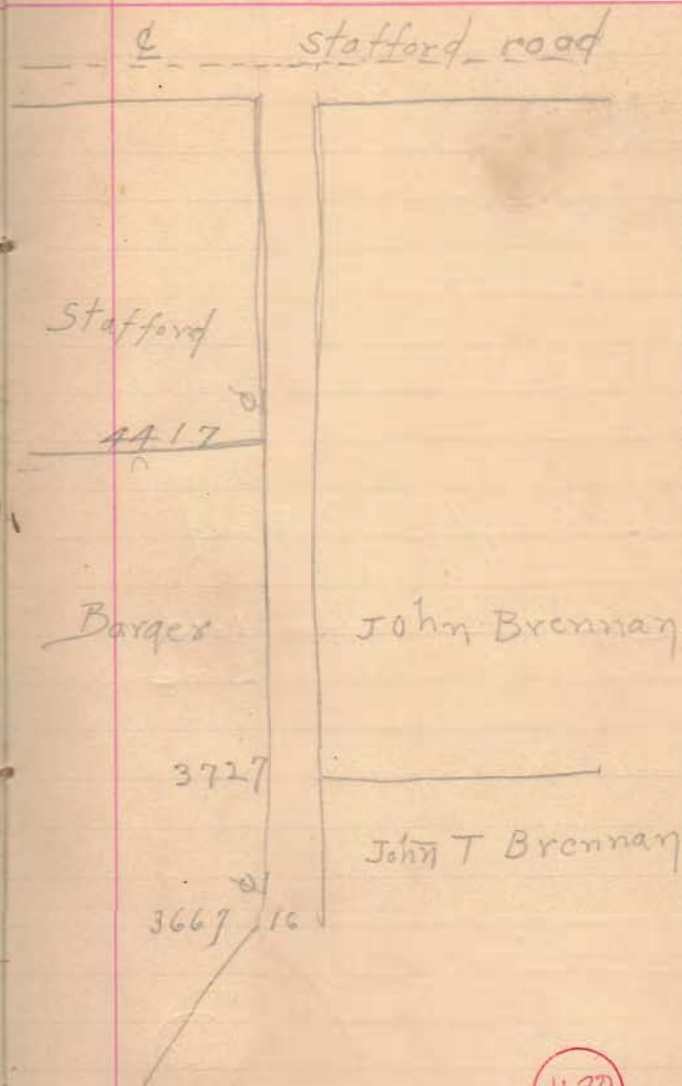

Angle
Stake 5414
S. 85 1/2 E

6220 to W Line Road

6234 to E Stafford Road
S Line Road is N. Line
Brennan
Drove R. R. spike

1620

6234
4417
1203
32
3606
5909
43560
57696 | 1.32
43560
141360
130680
106800 6220
4417
1803

2455
32
4900
7365
43560 | 1.90
78550
43560
349900
348480
14200

16.5) 2236. | 135.5
165
586 16.5) 1803
495 165
910 1530
825 1485
850 450
109.3

Shawver	Fence	135.5 rds
Stafford	"	109.3 "

1620