


Esch Survey  
w. Liberty

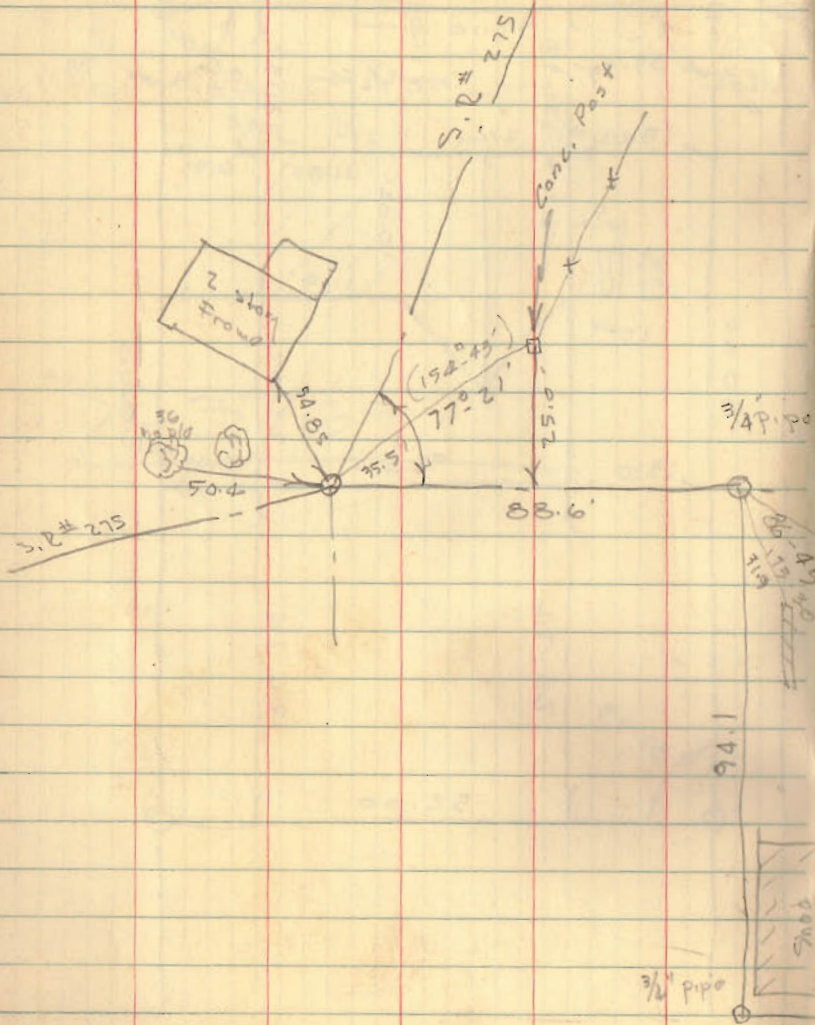

INDEXED ON MAP  
2945

Low Block  
meat store


Dodson  
Geastlin

8/27/60  
85°

2

~~#B 3/70~~

79.35
4.75
13.55
18.55

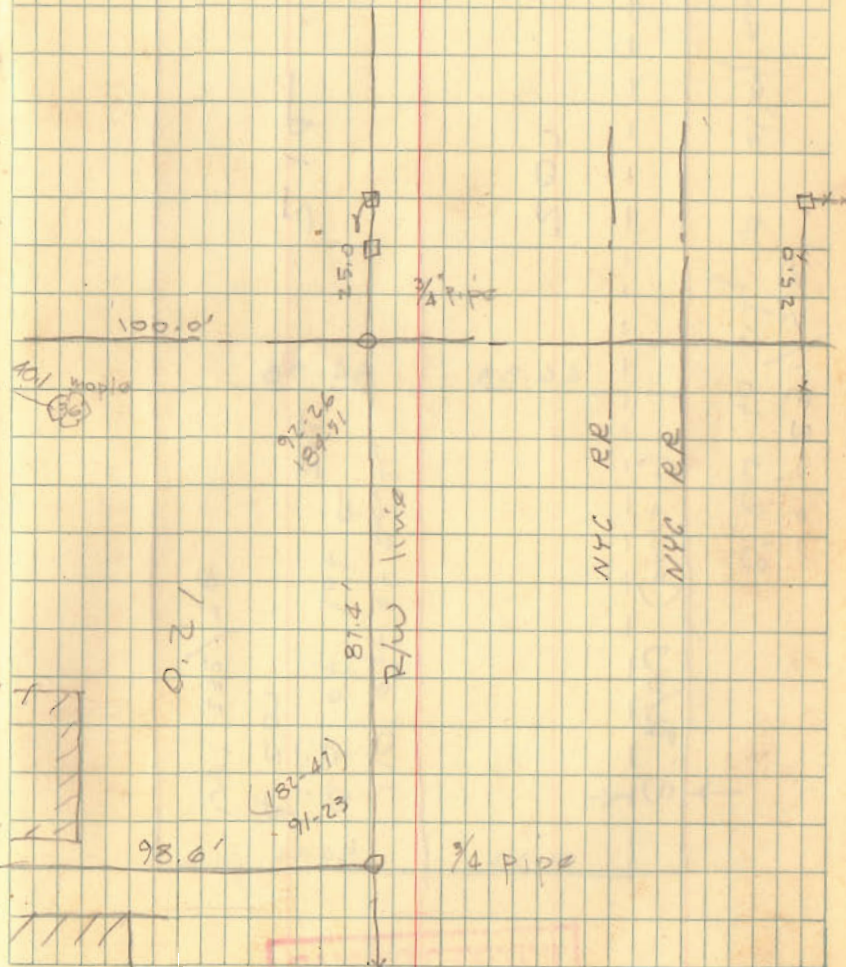

INDEXED ON MAP  
2945