


SHOOT'S SURVEY
 V.M.S. 3138
 JEFFERSON TWP.

26 Oct. 68
 Whitlow
 A115
 43°

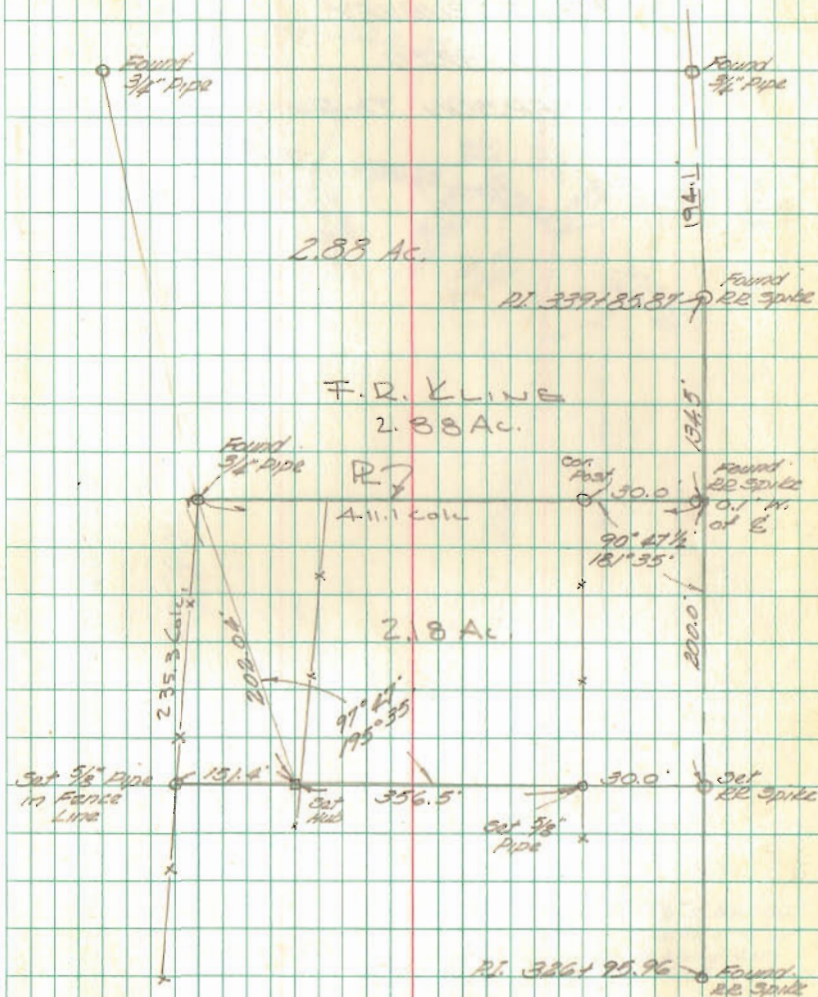


INDEXED ON MAP
 3869

BIBLE SURVEY
 V.M.S. 3220
 JEFFERSON TWP

INDEXED ON MAP
 7207

11.30.68

35°
 DODSON
 WILSON
 ARTS

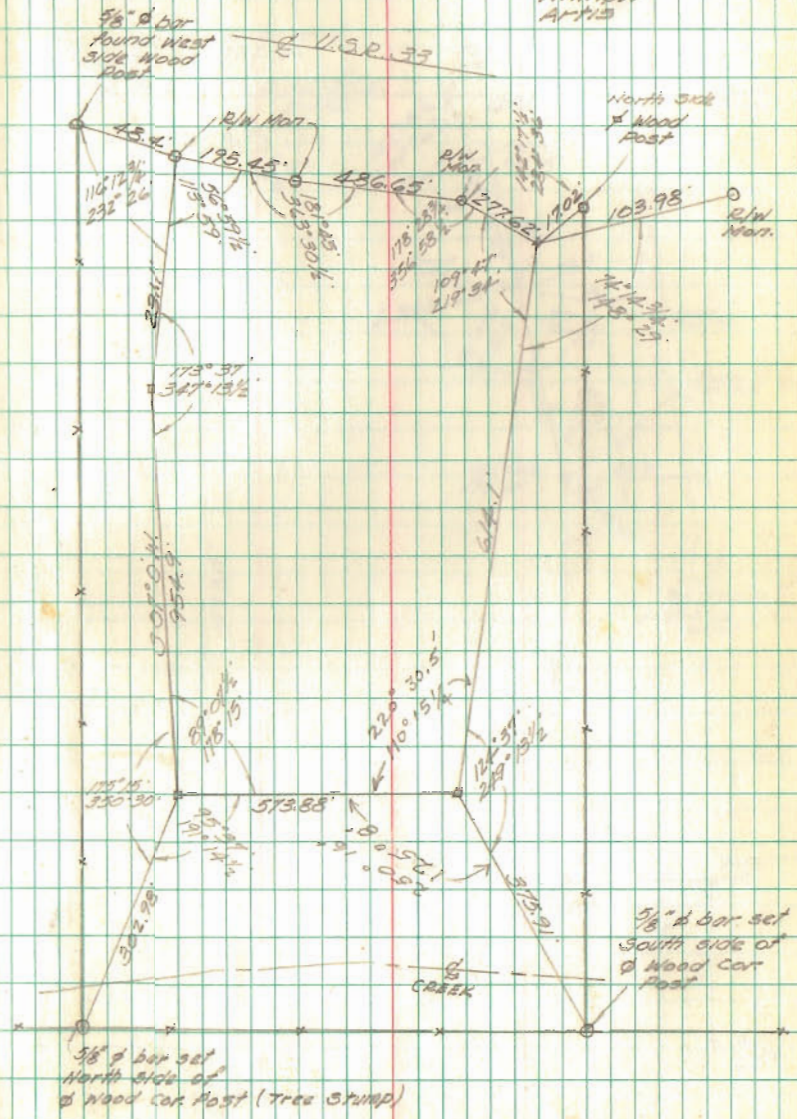


FERNWOOD SUBD
 LONG ISLAND
 LOT # 82

INDEXED ON MAP
 6225

2-1-69
 35
 Willow
 Aris

8

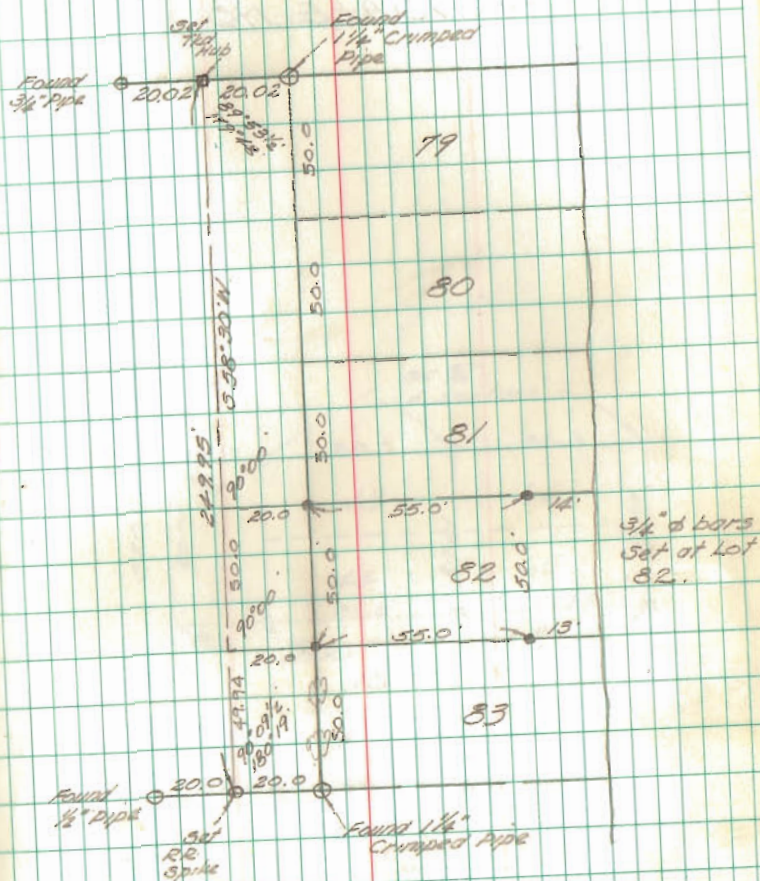

AVONDALE NO 2

INDEXED ON MAP
6532


2-8-69

35°

Adrian

Artis


9

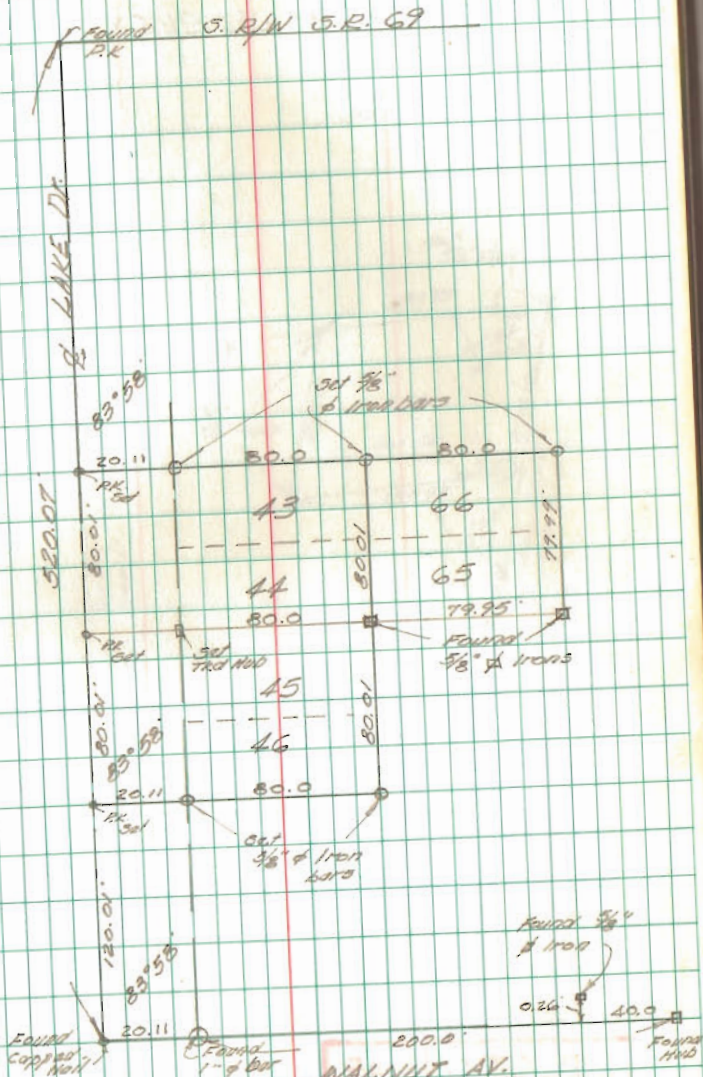

SNAPP SURVEY

2-15-69
White N
Artis
250

10

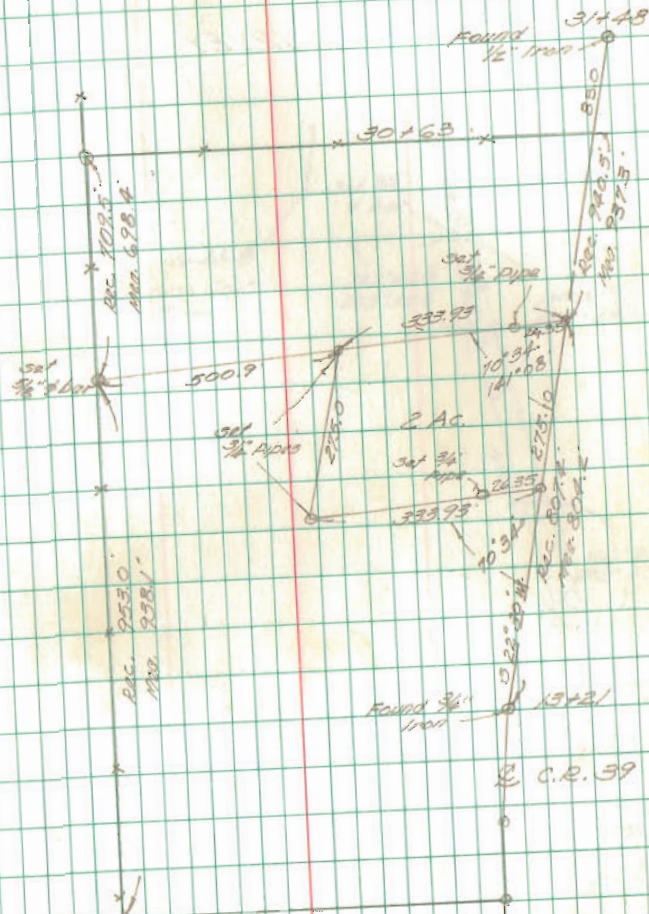


INDEXED ON MAP
6004

COWMAN SURVEY

INDEXED ON MAP
3439

2-22-69
Wittlow
Ar 119
41°

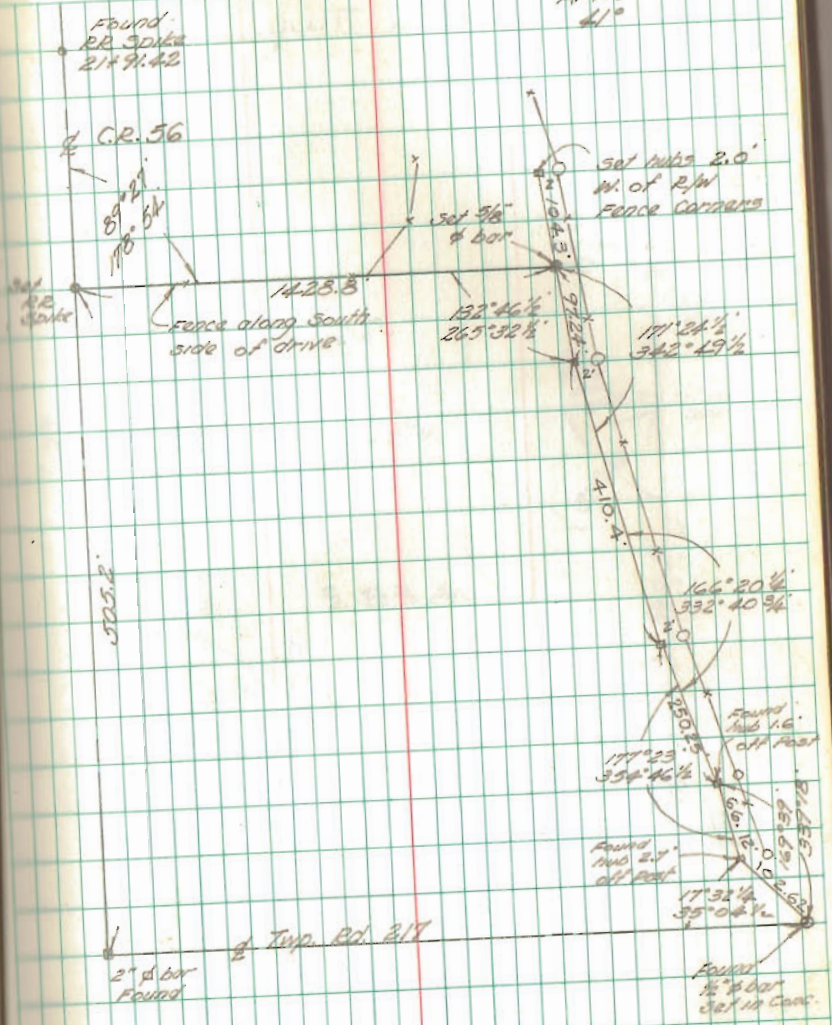

Mac Donald Survey

v.m.s. 4439


Jefferson Twp.

3-29-69

Winton

Arts

30°

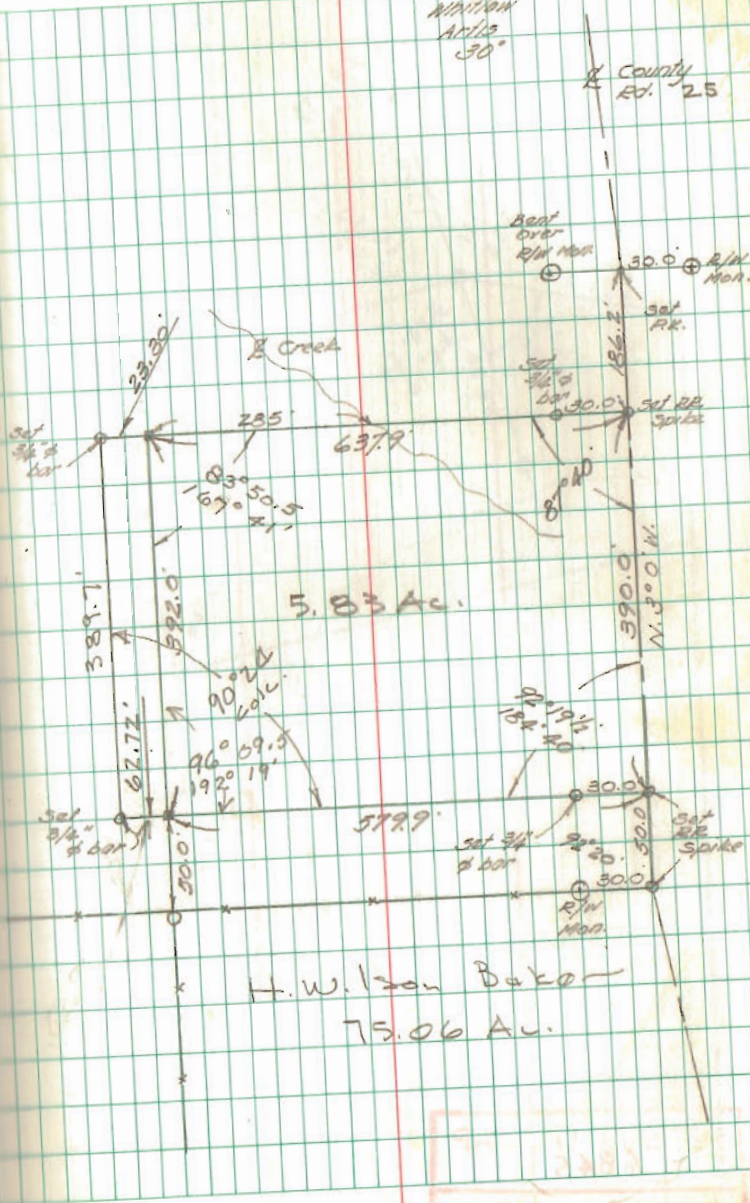County
Rd. 25

INDEXED ON MAP


4621

ZUPP SURVEY

Dodson
Nichols

Δ 14/69
60°

13

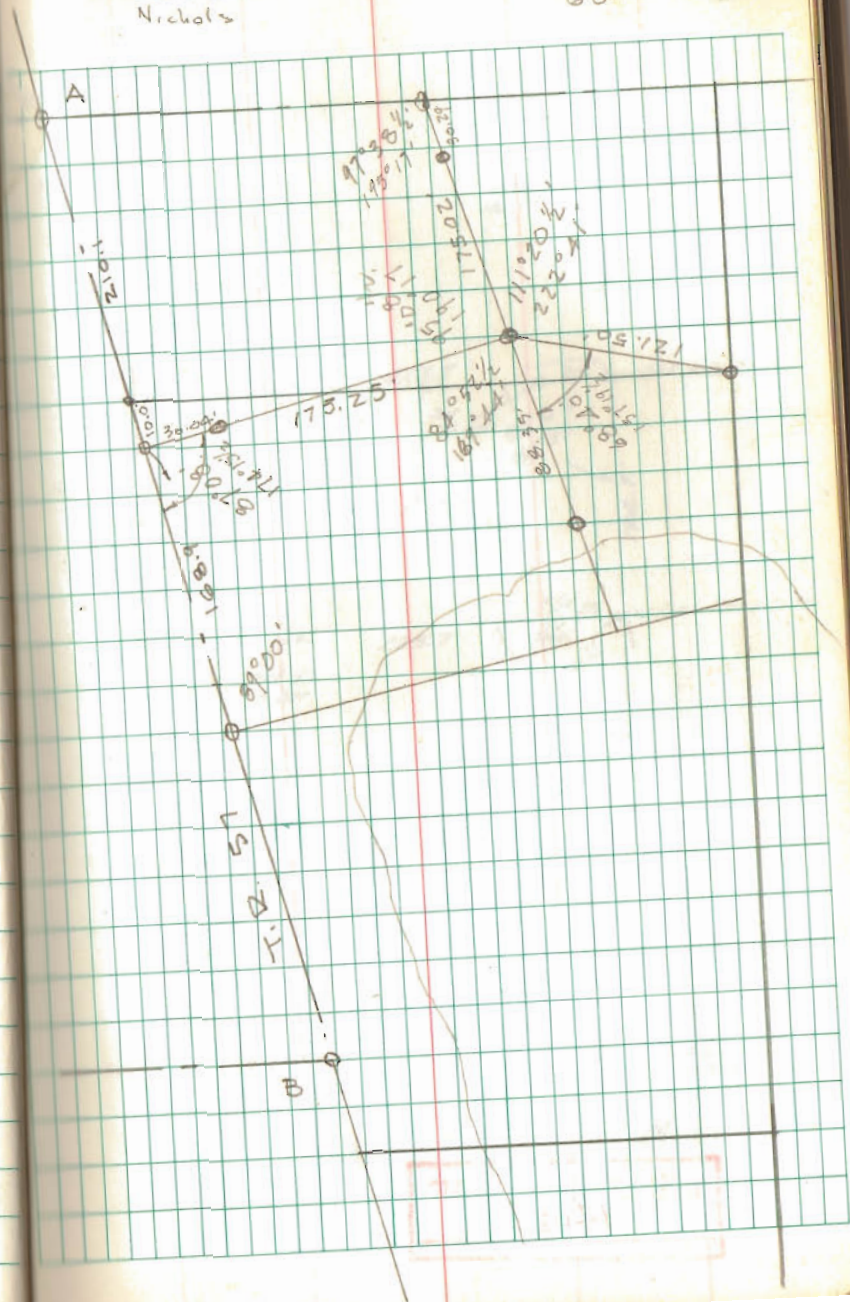

INDEXED ON MAP
6845


4-12-69

50°

Whitlow

Artis

14

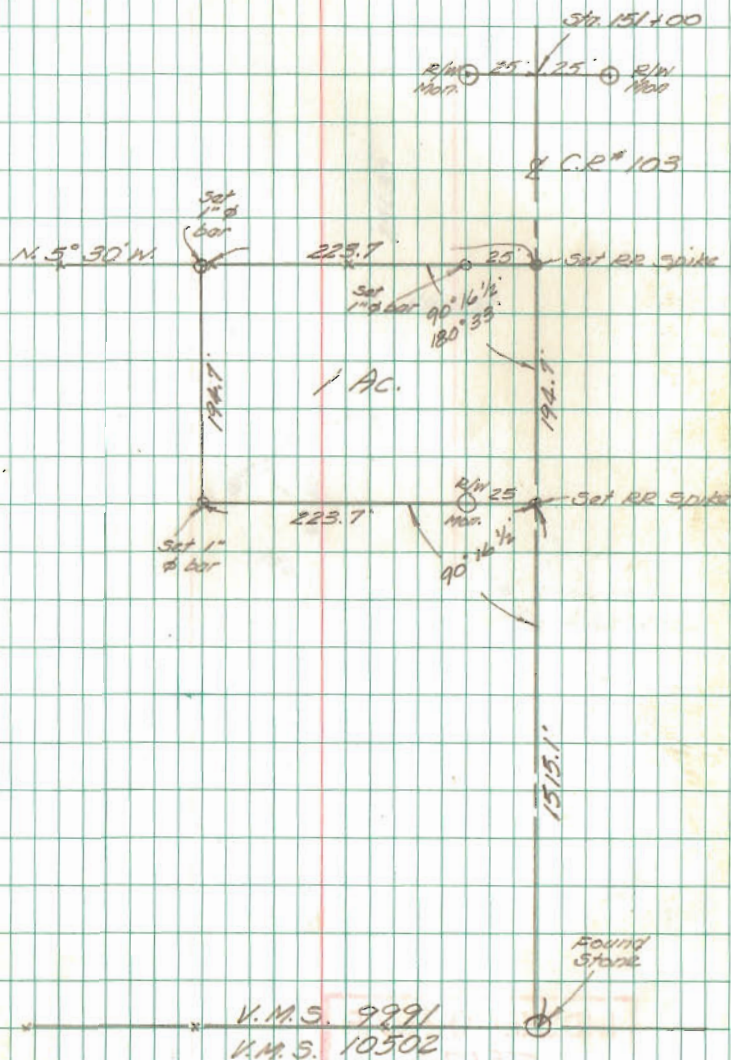

INDEXED ON MAP


1402

4-12-69

60°

Willow
Ave

15

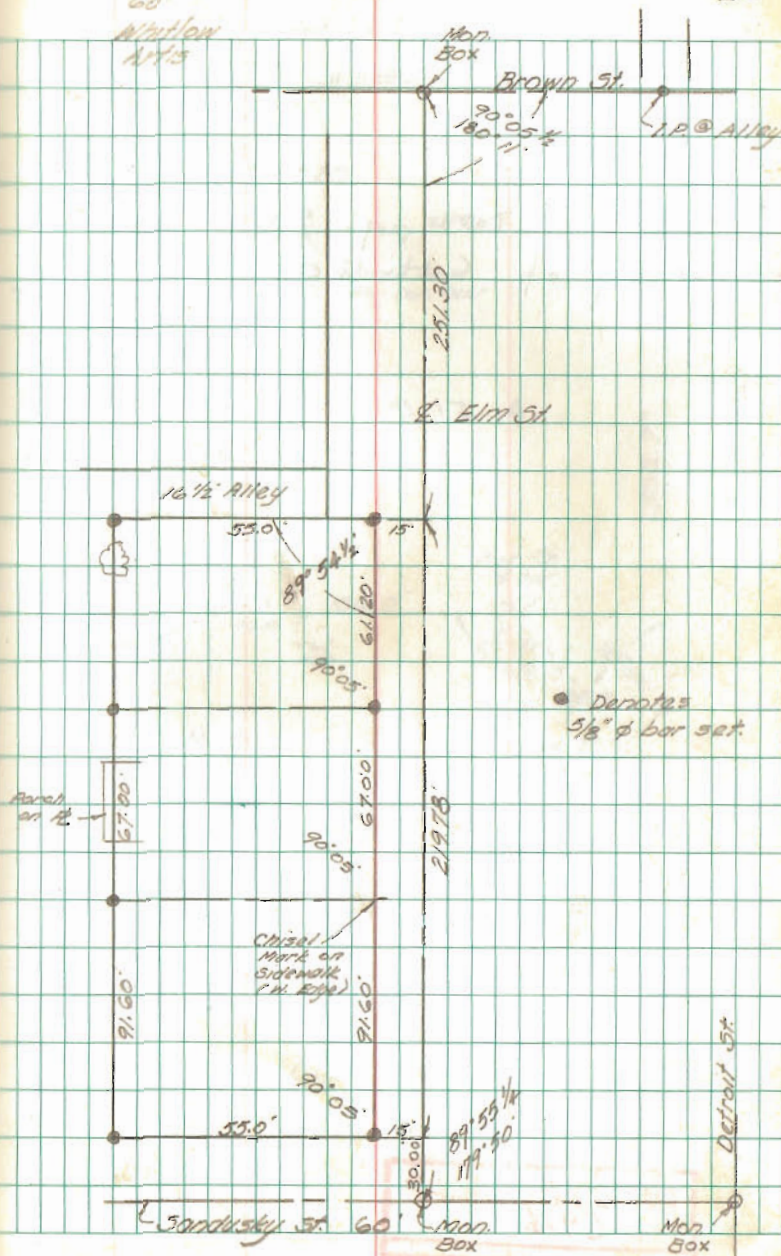


INDEXED ON MAP
7517

256
53.50
11/17

Longbrake Survey
v.m.s. 9912
BOKESCREEK TWP.

SEE F.B. 701 p. 58 For
Survey of C.H. 20

4-19-69
Whitlow
Artis

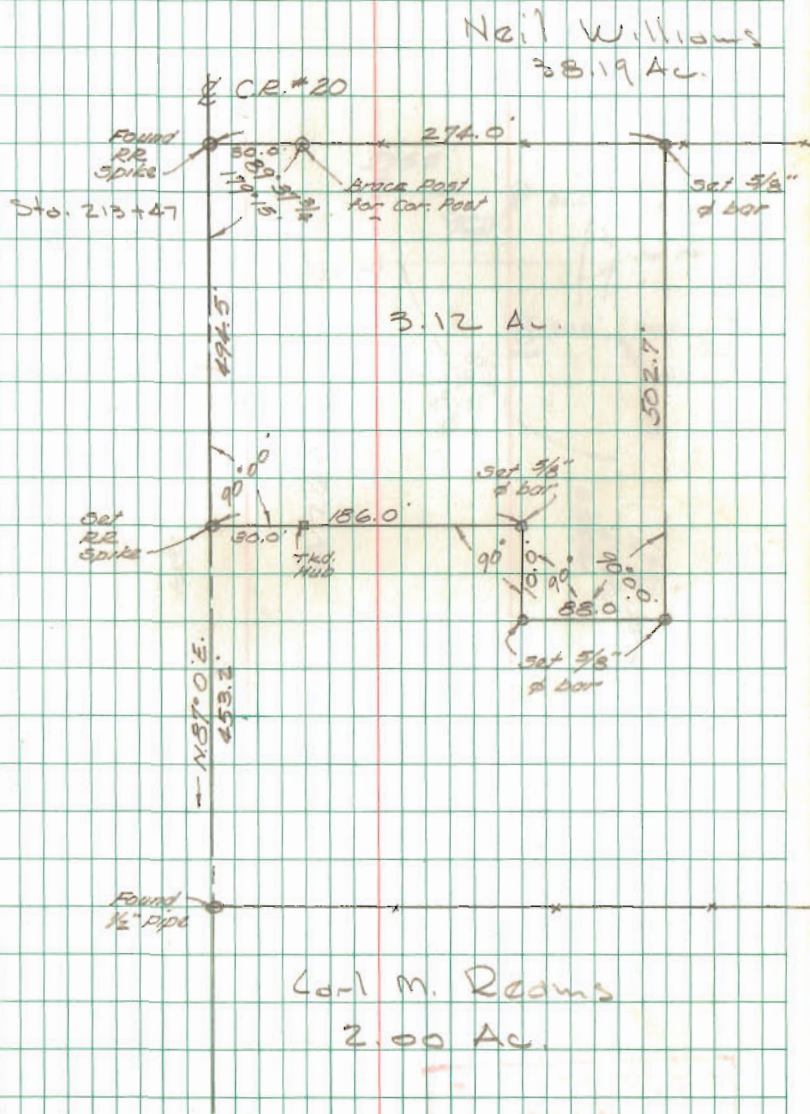


INDEXED ON MAP
6926

ZEDEKER SURVEY
 Sec. 29 T-4 R-13
 UNION TWP.

17

4-26-69
 Winton
 Art. 13

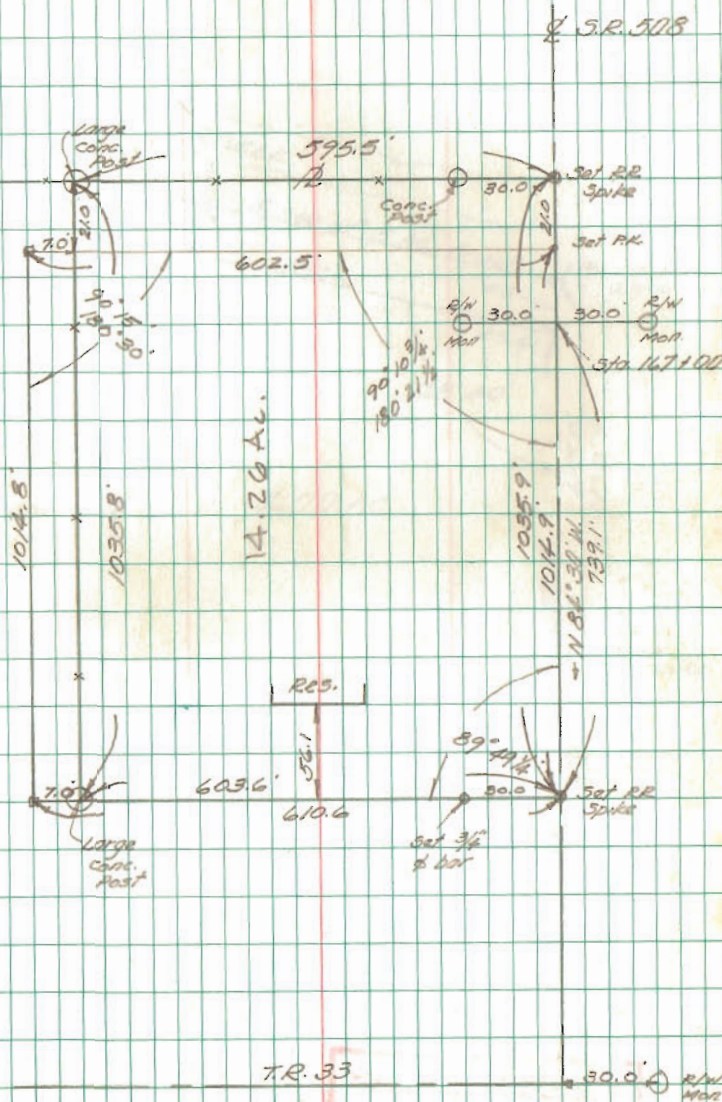


INDEXED ON MAP
 7454

SHIRK SURVEY
V.M.S. 3753
ZANE TOWNSHIP

INDEXED ON MAP
5500

4-26-69
Winton
Harris

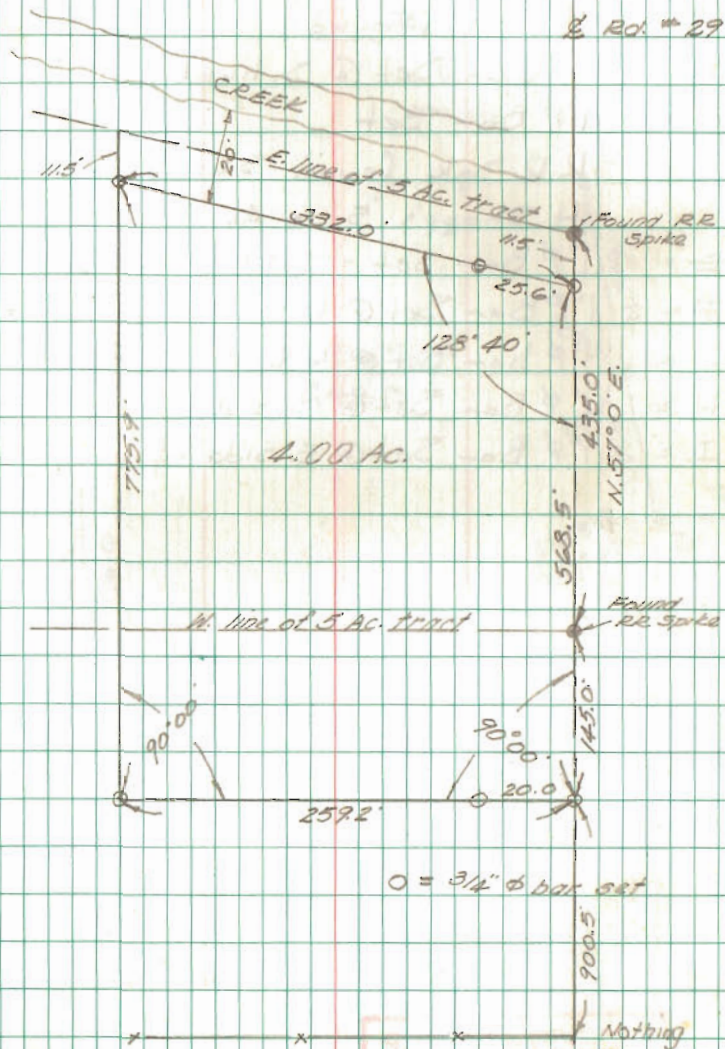


RUTHERFORD SURVEY
 V.M.S. 9907
 RUSHCREEK TWP

- A = 1" ϕ Bar Found
- B = 1" ϕ Bar Set @ S. line of 4.0 Ac. tr.
- C = 1" ϕ Bar Set
- D = R.R. Spk found - S.W. Corner
 H. Snapp's 5.00 Ac. tract
- E = 1" ϕ Bar Set - Split fences for E
- F = 1" ϕ Bar Set @ W. side of Cor. post
- G = 1" ϕ Bar Set @ N.E. Cor of Cor. post
- H = 1" ϕ Bar Set @ S. side of Cor. post
- I = 1" ϕ Bar Set @ E. side of Cor. post

INDEXED ON MAP
 9441

Whitlow
 Artis


May 3, 1969
 10° 19

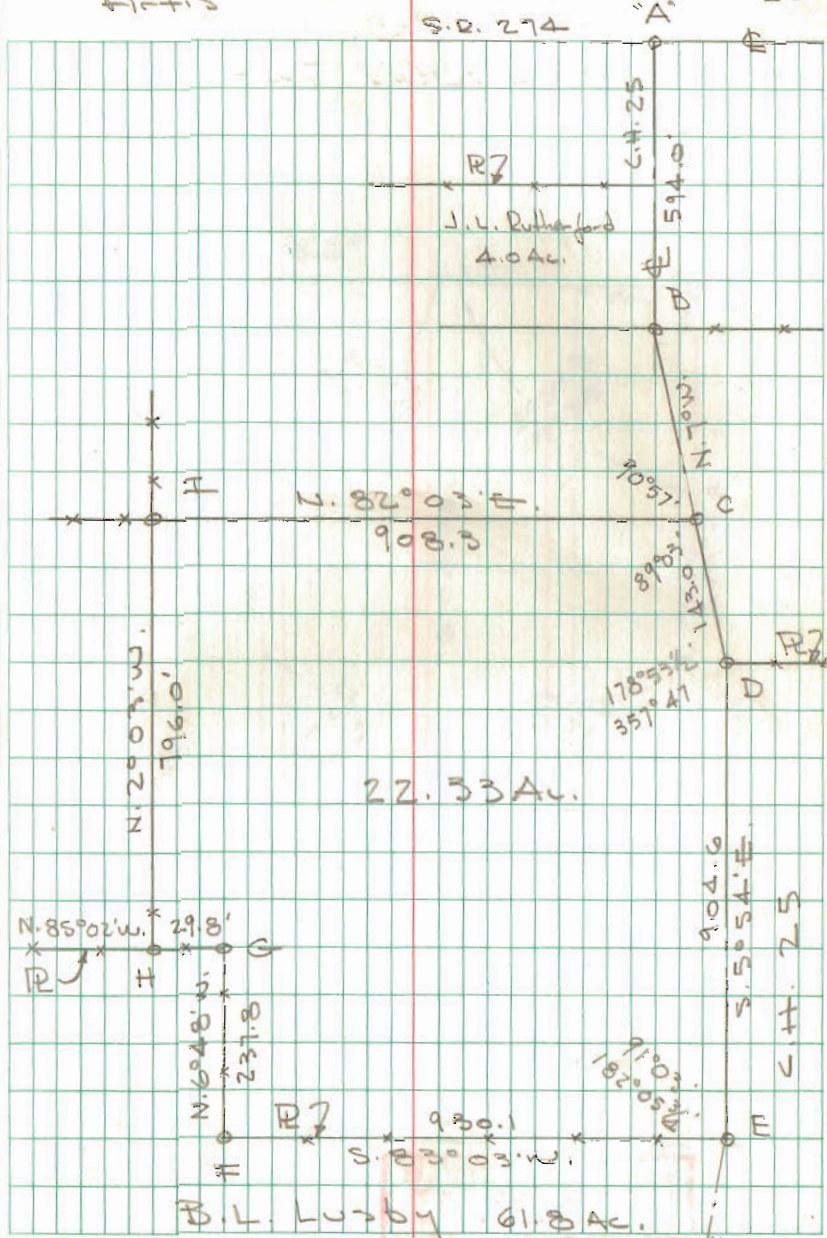

EWING SURVEY
 SEC. 9, T-3, R-14
 HARRISON TWP.

20


5-10-67
 Whitlow
 A.M.C.

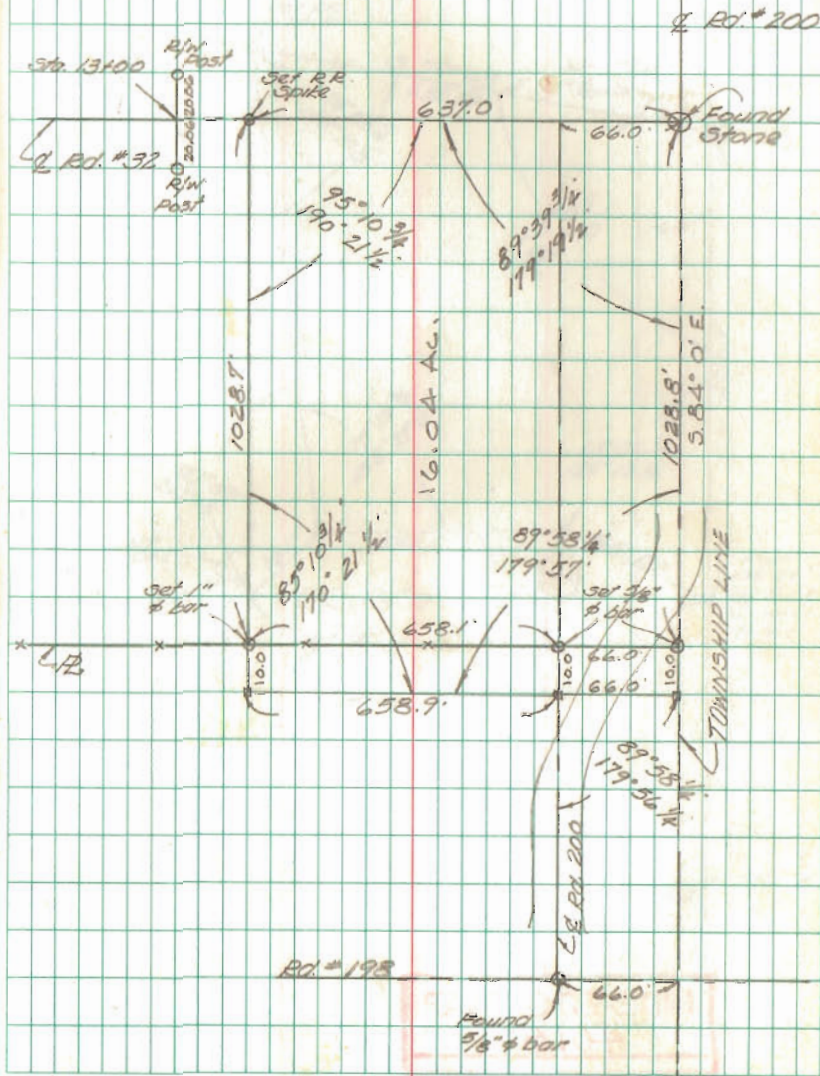

INDEXED ON MAP
 6932

BURRERY SURVEY
 V.M.S. 4477
 JEFFERSON TWA


17 MAY 69
 WITLOW
 ARTIS

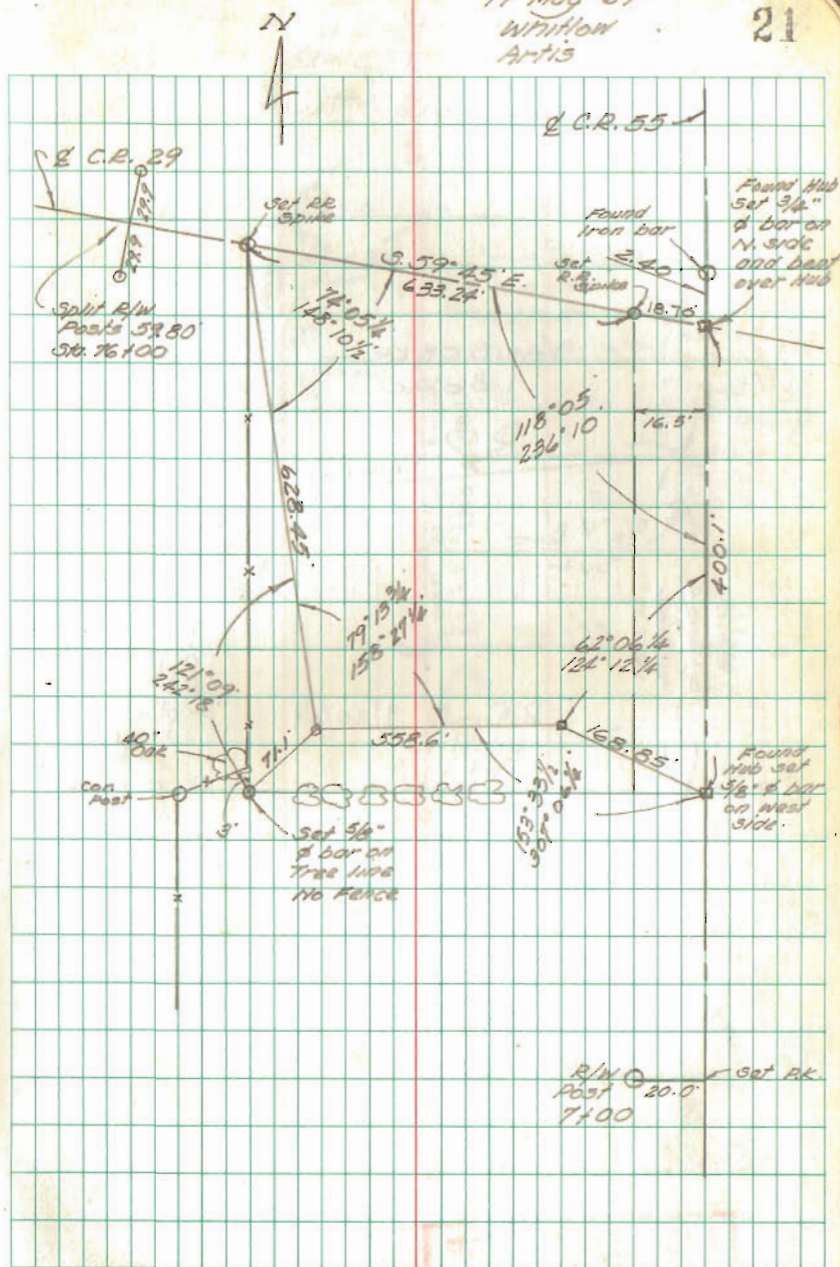

INDEXED ON MAP

4615

BURKER SURVEY
 SEC. 5 T-3 R-14
 HARRISON TWP.

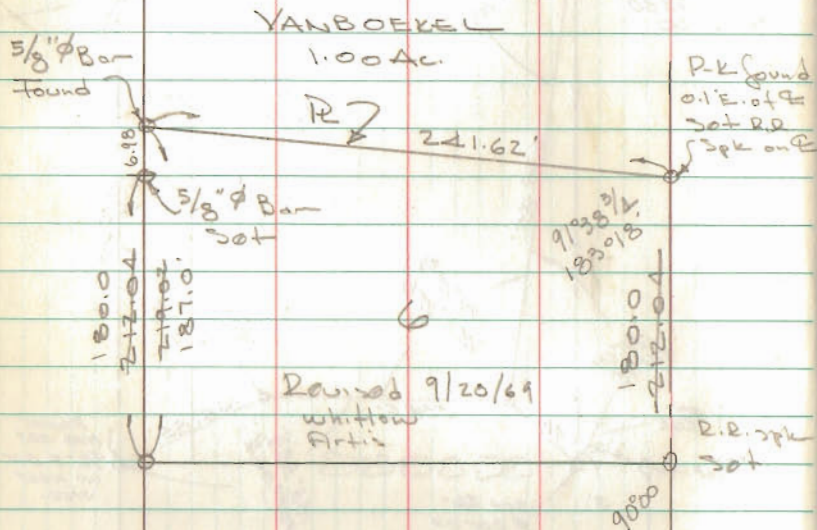


INDEXED ON MAP
 4919

Dodson
 Whitlow
 Nichols

5/24/69

22

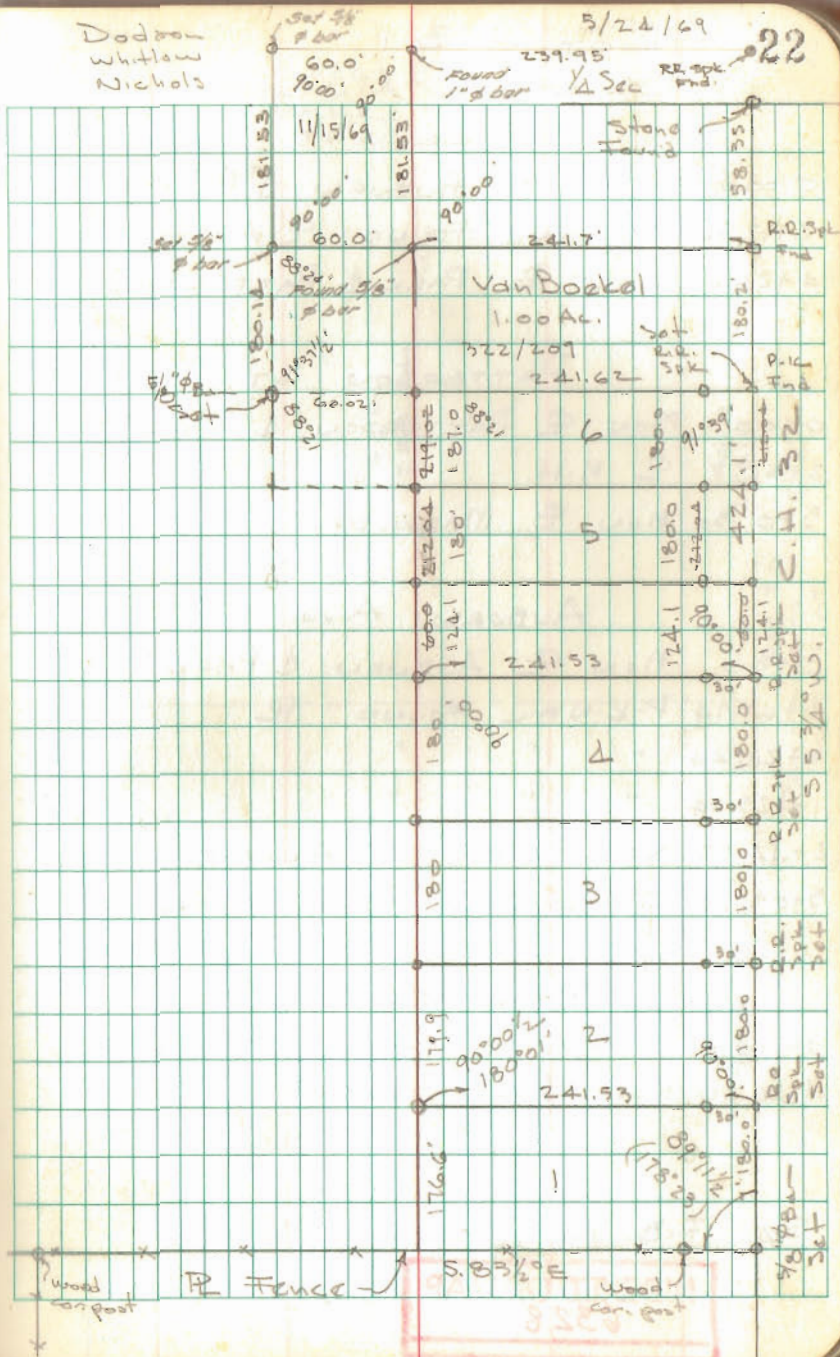

INDEXED ON MAP
 8559

18

LOT 481
BELLEFONTAINE
- PARK ST

0+00 MON @ AUBURN & PARK
2+12.92 P-K NAIL FOUND @ ALLEY
4+26.00 MON @ PARK & PATTERSON ST.

PATTERSON ST.

0+00 MON. @ PATTERSON & PARK
2+22.7 @ N.H.
5+01.30 MON @ MADRIVER

AUBURN AVE

0+00 MON @ AUBURN & PARK
0+67.74 P-K NAIL FOUND @
1+20.44 " " "
1+25.44 " " "
2+44.57 NAIL FOUND @ ALLEY
5+03.25 " O" BOLT FOUND @ MADRIVER ST.

MADRIVER ST.

0+00 " O" BOLT @ AUBURN & MADRIVER
4+26.00 MON @ PATTERSON


See F.B. 14 pg. 36

INDEXED ON MAP
6328

Dotson
Nichols

6-7-69

23

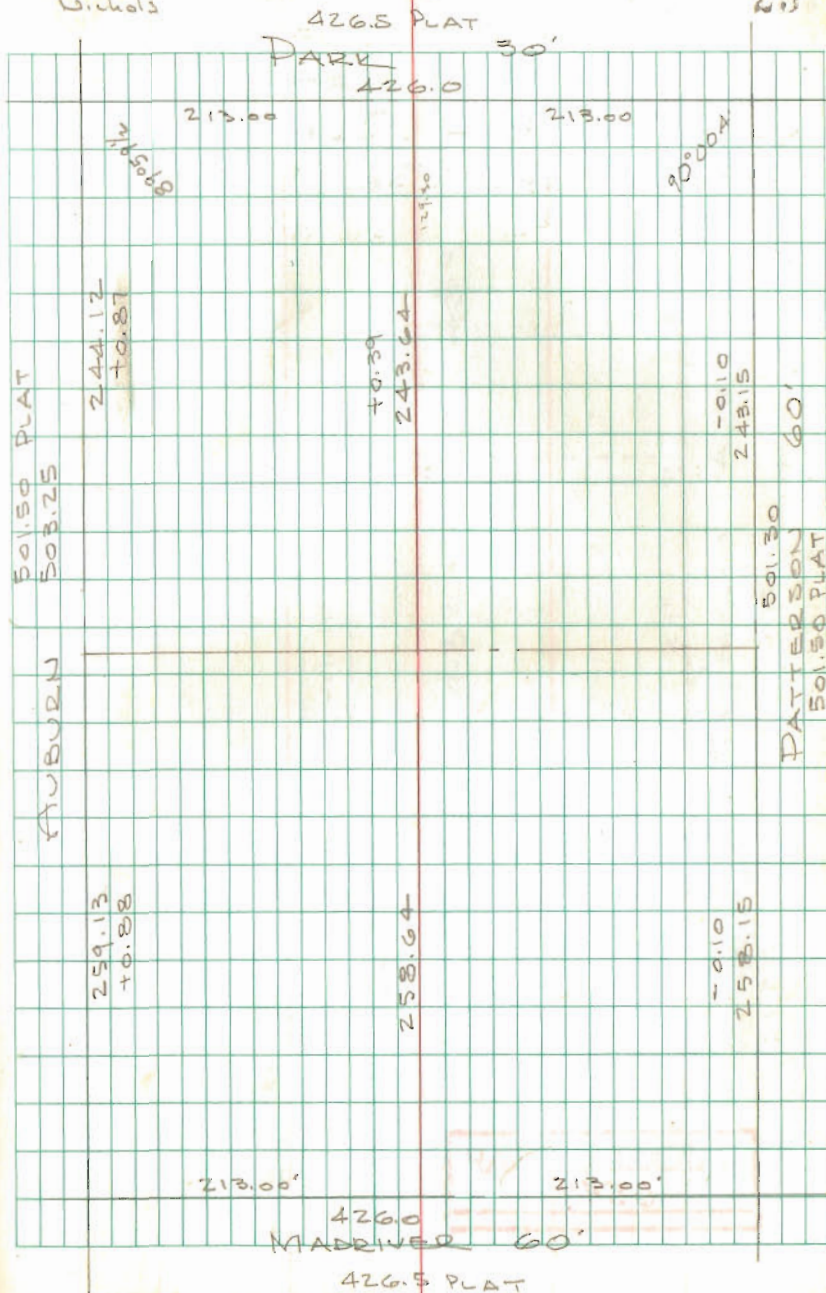

15

Lot 481 Cont'd.

○ = 5/8" φ Bar Set

□ = 4kd Hub Set


INDEXED ON MAP

6549

Dodson
O. Dodson

6/29/69

24

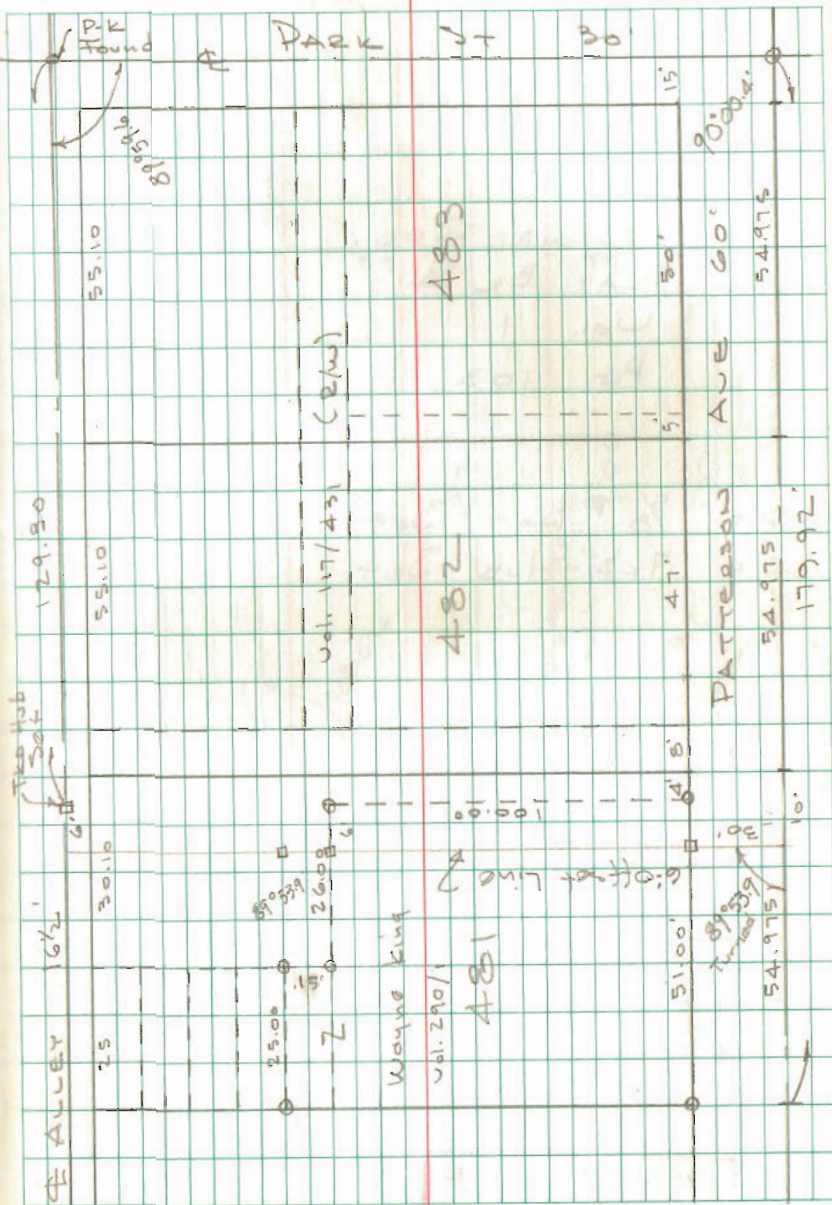

Lot 201-202
QUINCY, OHIO


Leuchs App.
PLAT BK A
Vol. 1
Pg. 103

O = 5/8" ϕ Bar Set
□ = T&B. Hub Set

INDEXED ON MAP
4962

Dodson
D. Dodson

6/29/69
80° 25

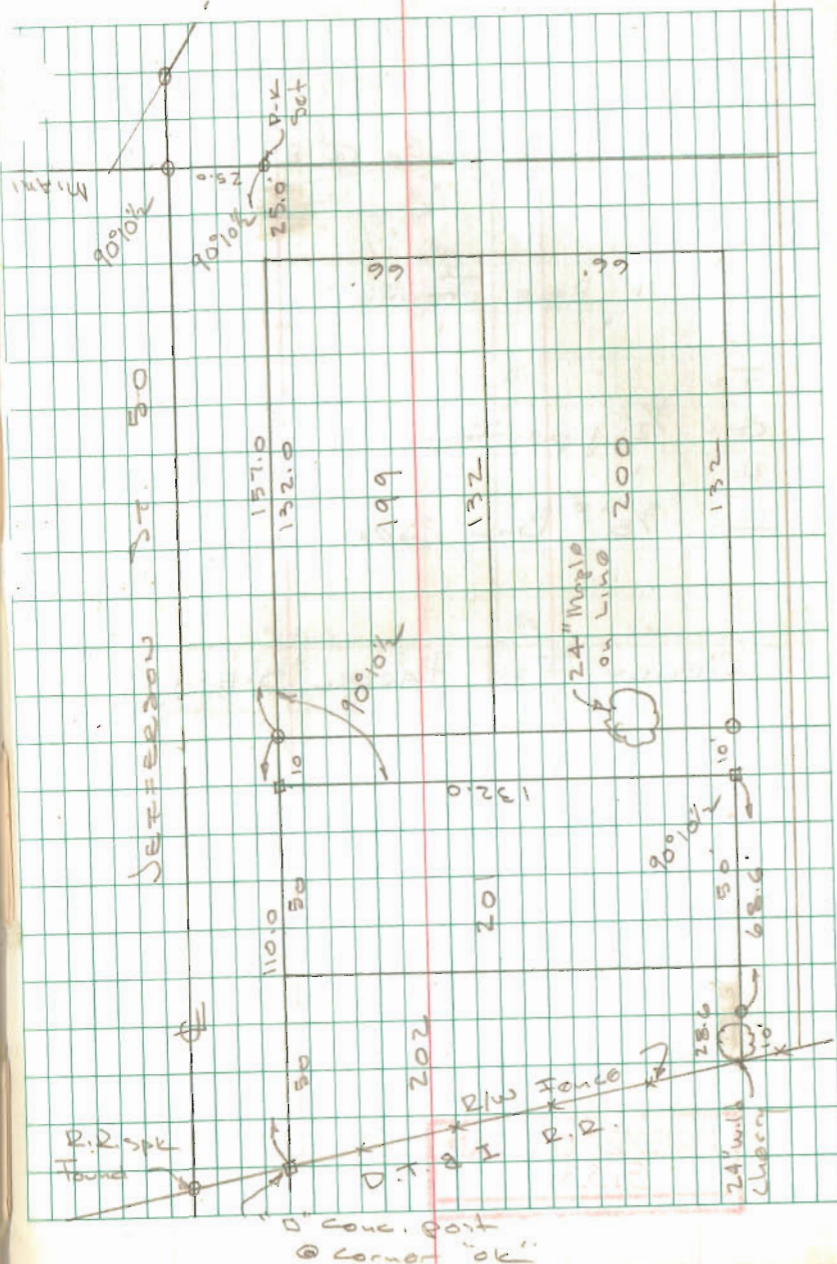

BURKE SURVEY
QUINCY, OHIO

- A = 1/2" pipe found @ E edge Conc. walk
- B = " " " "
- C = " " " "
- D = 1" Pipe Found
- E = " " " "
- F = " " " "
- G = 1/2" pipe found in fence
- H = " " " "
- I = 3/8" Bar Set

SURVEY FOR PARCEL "D-E-H-I"


William Burke Sr.
Box 164
Quincy, Ohio

INDEXED ON MAP
3133

Dodson
D. Dodson

7/1/69
75°

26

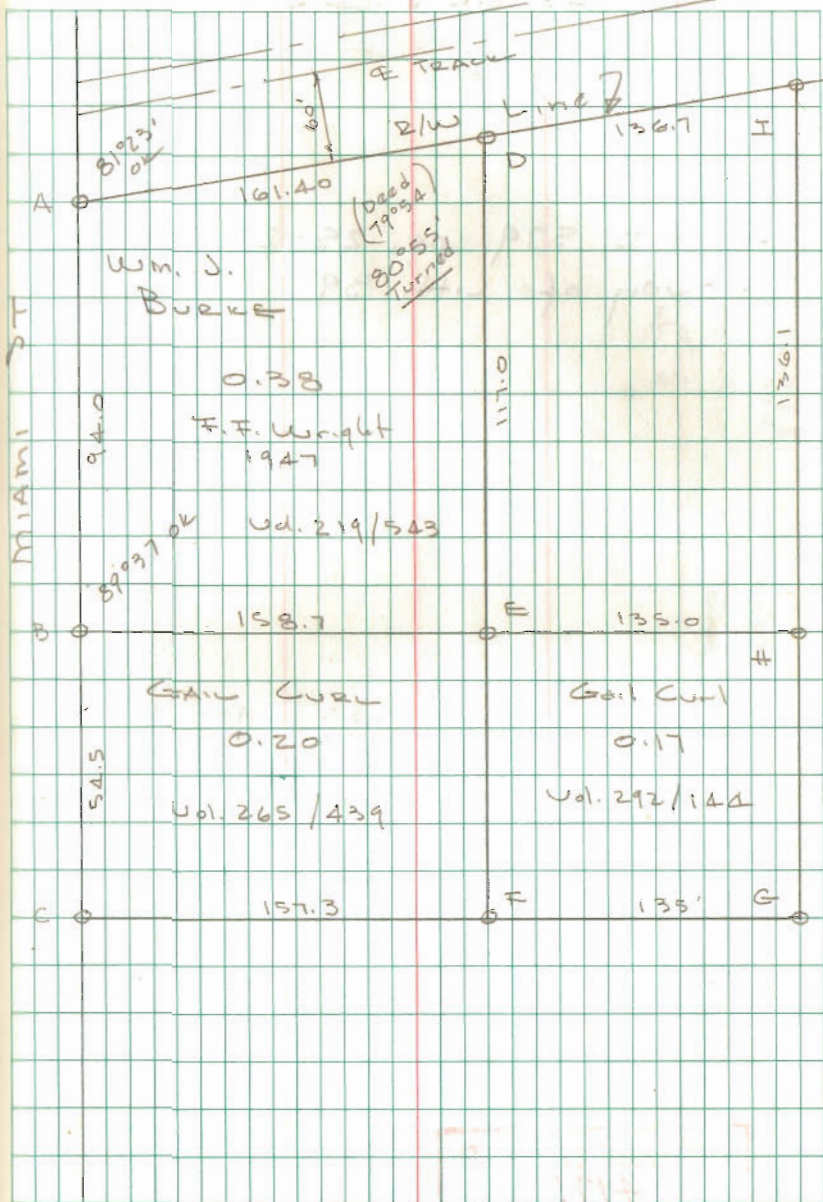

78

WILLIAMS SURVEY
NEW RICHMOND


See F.B. 579 pg. 25-27 for
Survey of C.H. 39

168.5	194.0
22.3	190.8
190.8	3.2

INDEXED ON MAP
4977

Dutton
Atlas

719/69 27

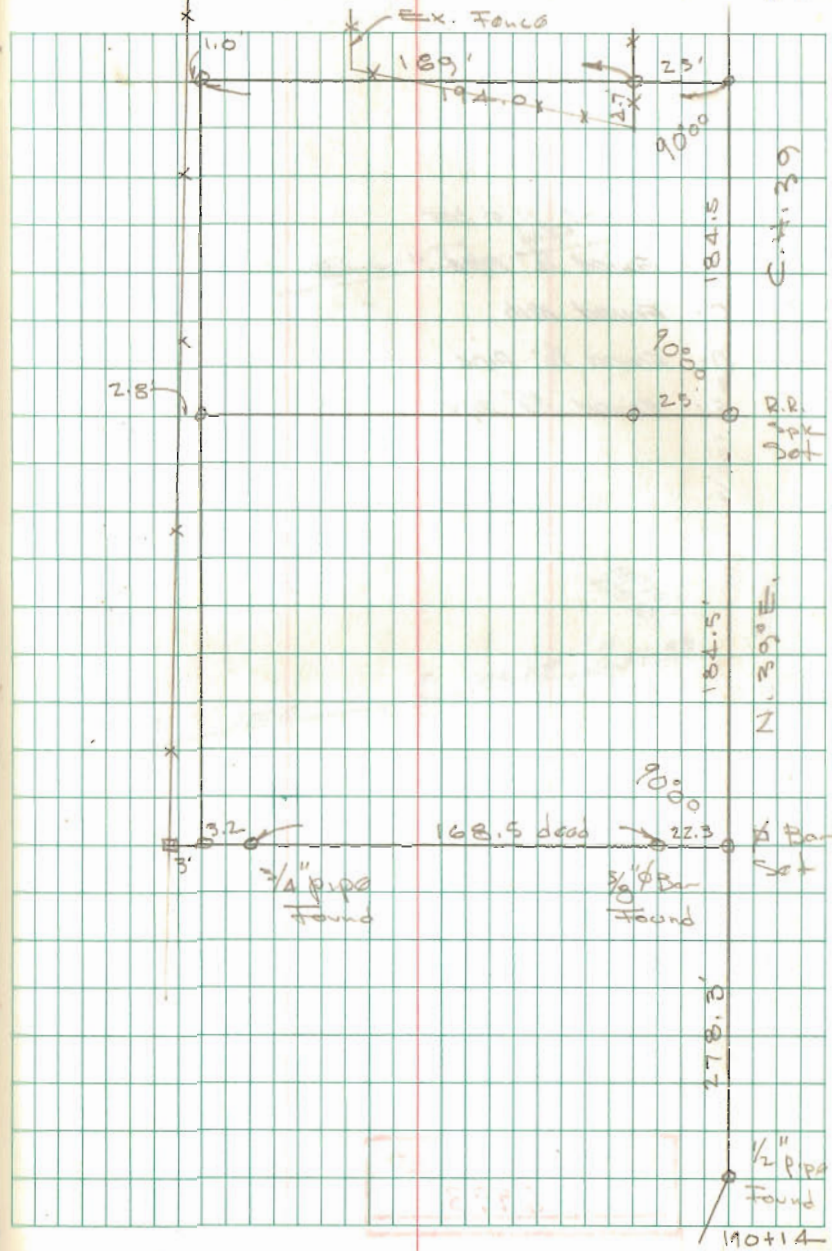


FARMERS BANK TOPO
RUSSELLS POINT

- A - Found 1" ϕ bar
- B - Found $\frac{1}{2}$ " Pipe
- C - Found Hub
- D - Found $\frac{1}{2}$ " Pipe
- E - Found $\frac{3}{4}$ " Pipe

INDEXED ON MAP
6993

Dutton
Wallow
Artis


July 29, 1969 28

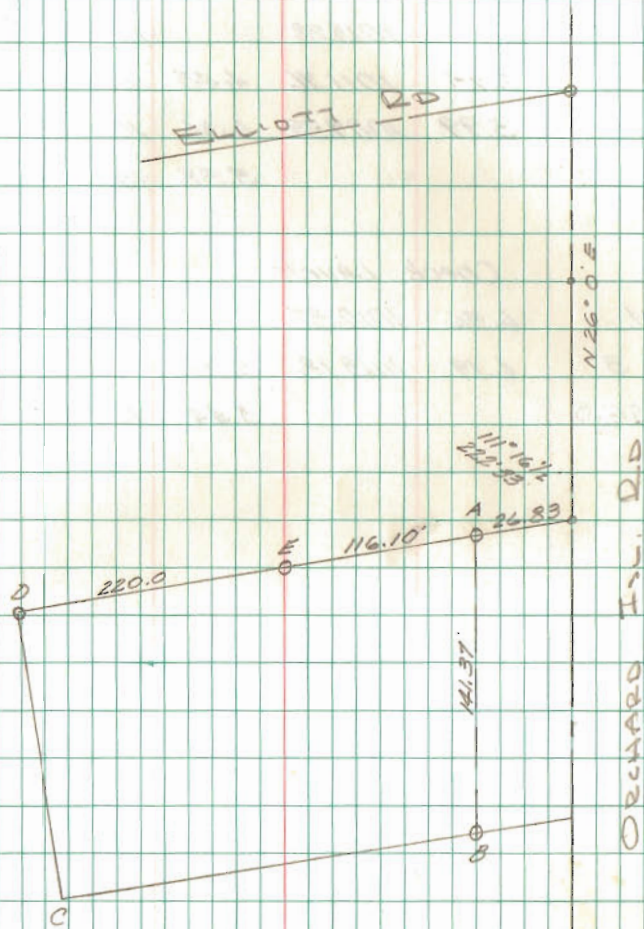

LOGAN COUNTY LUMBER TOPO
LAKE @ DETROIT

Whitlow
Artis

8/16/69 34

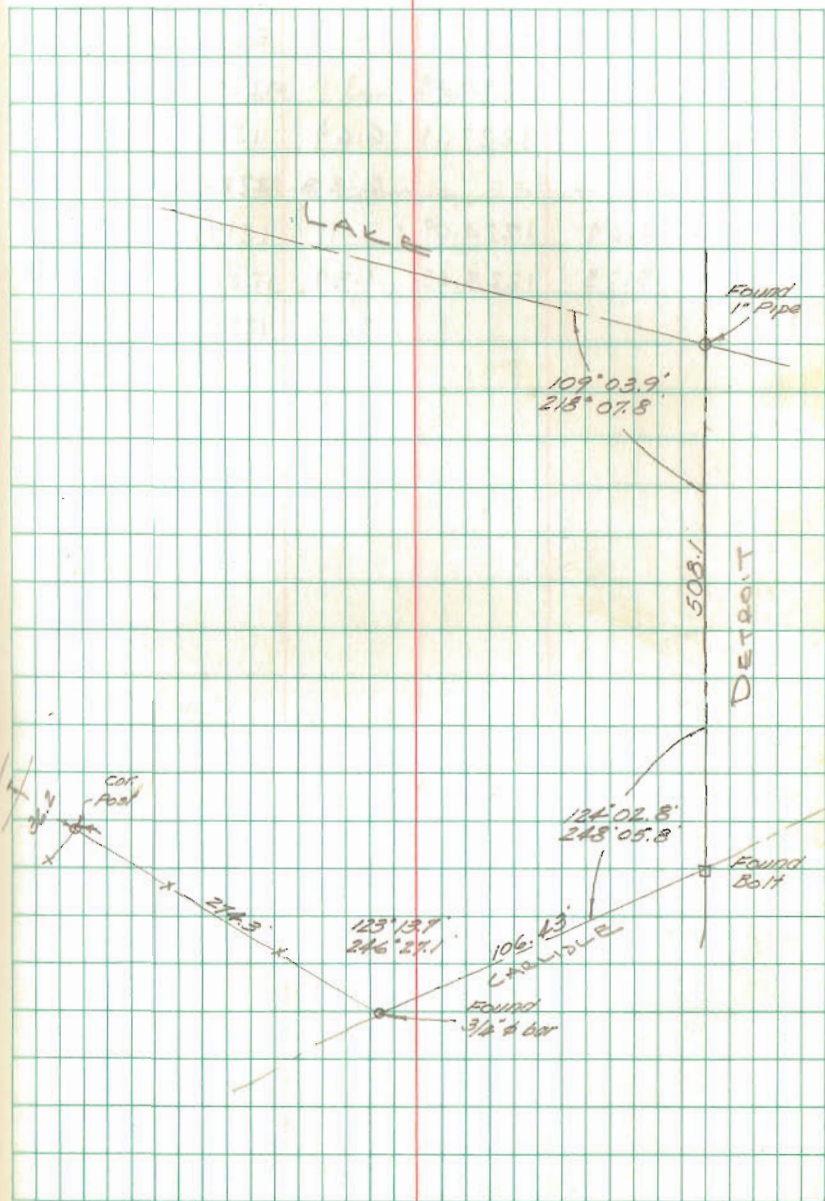

INDEXED ON MAP
3696

BATES SURVEY
PERRY TWP.

T.R. No. 141


INDEXED ON MAP
3865

Whitlow
Doris

Aug. 30, 1969

750

45

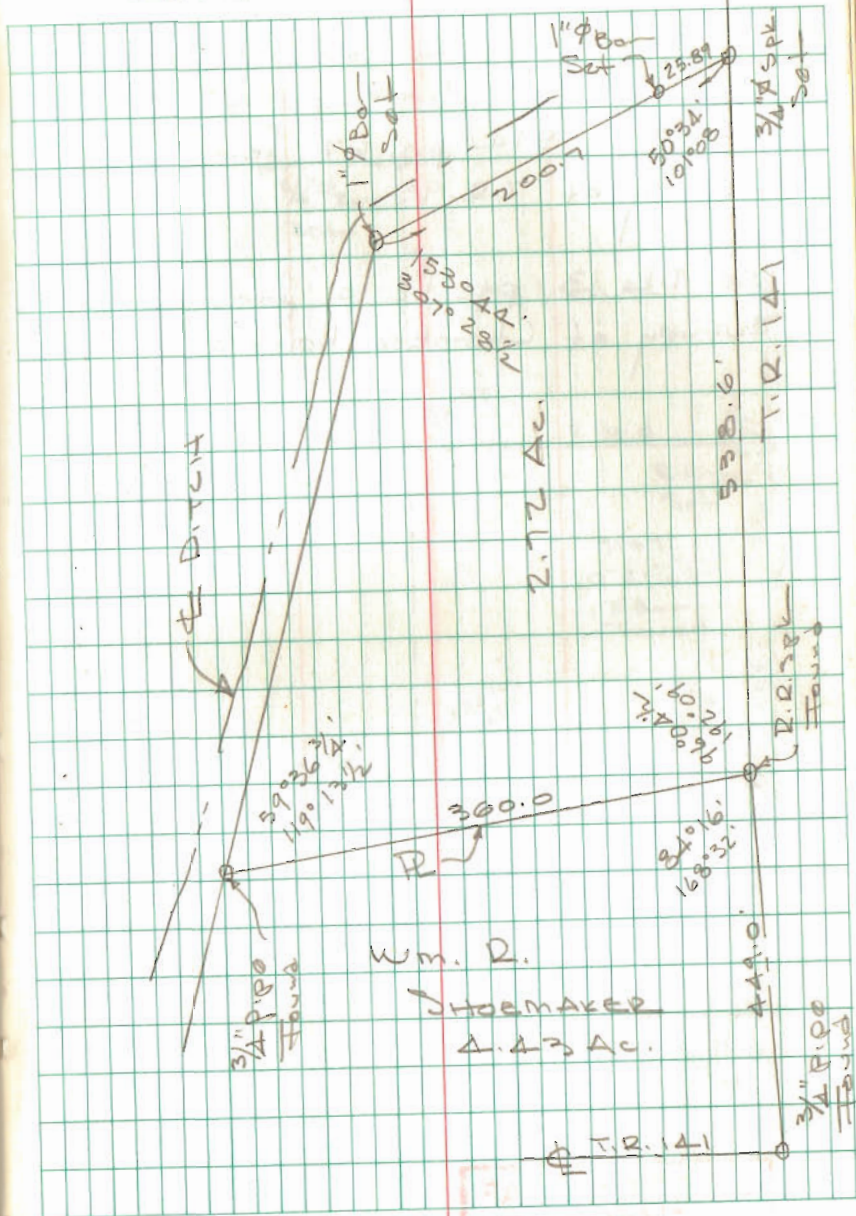

INDEXED ON MAP
3865

TRACY Survey


See F.B. 574 pg. 67 for
Survey of T.R. 95

See BK 13 pgs 1 & 10 for
Survey of Cherokee Heights Subd.

Dedron
Artis

SEPT. 2, 1969 46
70°

CHEROKEE Heights
SUBD No. 1

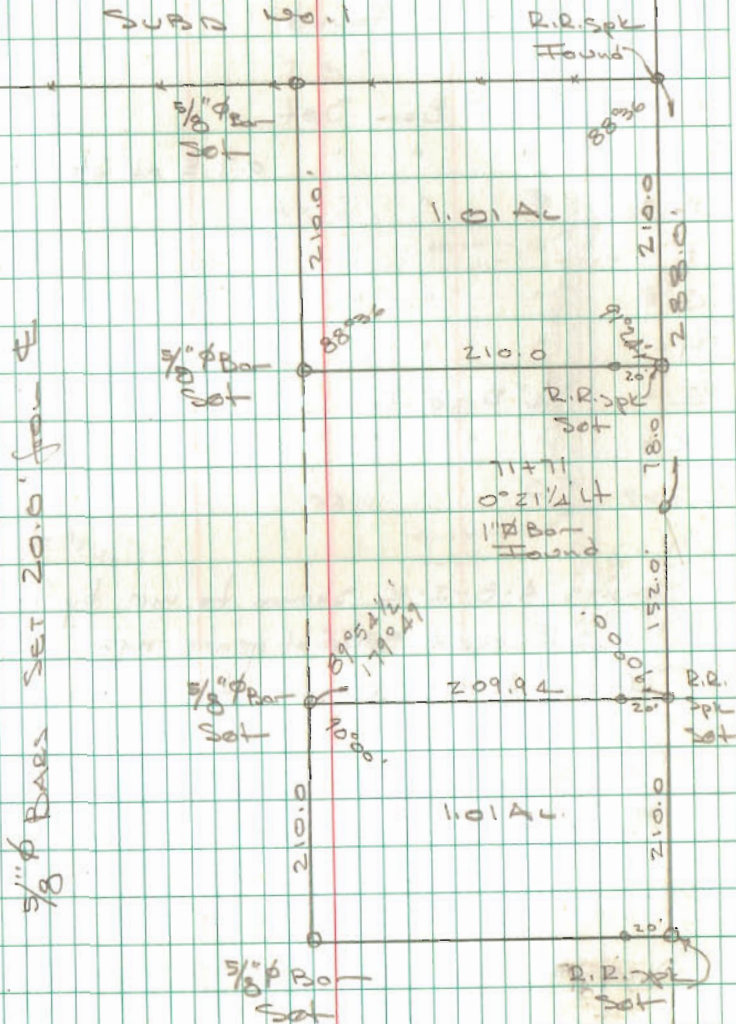

INDEXED ON MAP
7436

Map @
Twp Line 1985 1985'

LOT 26
DEGRAFF OHIO

- A = 3/4" pipe Found
 B = " " "
 C = 5/8" ϕ Bar Jet
 D = " " " 0.7' E. of Stonewall
 E = " " "
 F = " " "
 G = " " "
 H = " " "
 I = 3/4" Pipe Found
 K = " " "


Points A-B-I-K shown to me by owner
 lot surveyed several years ago
 used these point to stake lot 26

All points fit occupation very good
 but they don't check anything else.

Survey to split lot 26 as shown.

Dodson
 Nichols

9/13/69 47

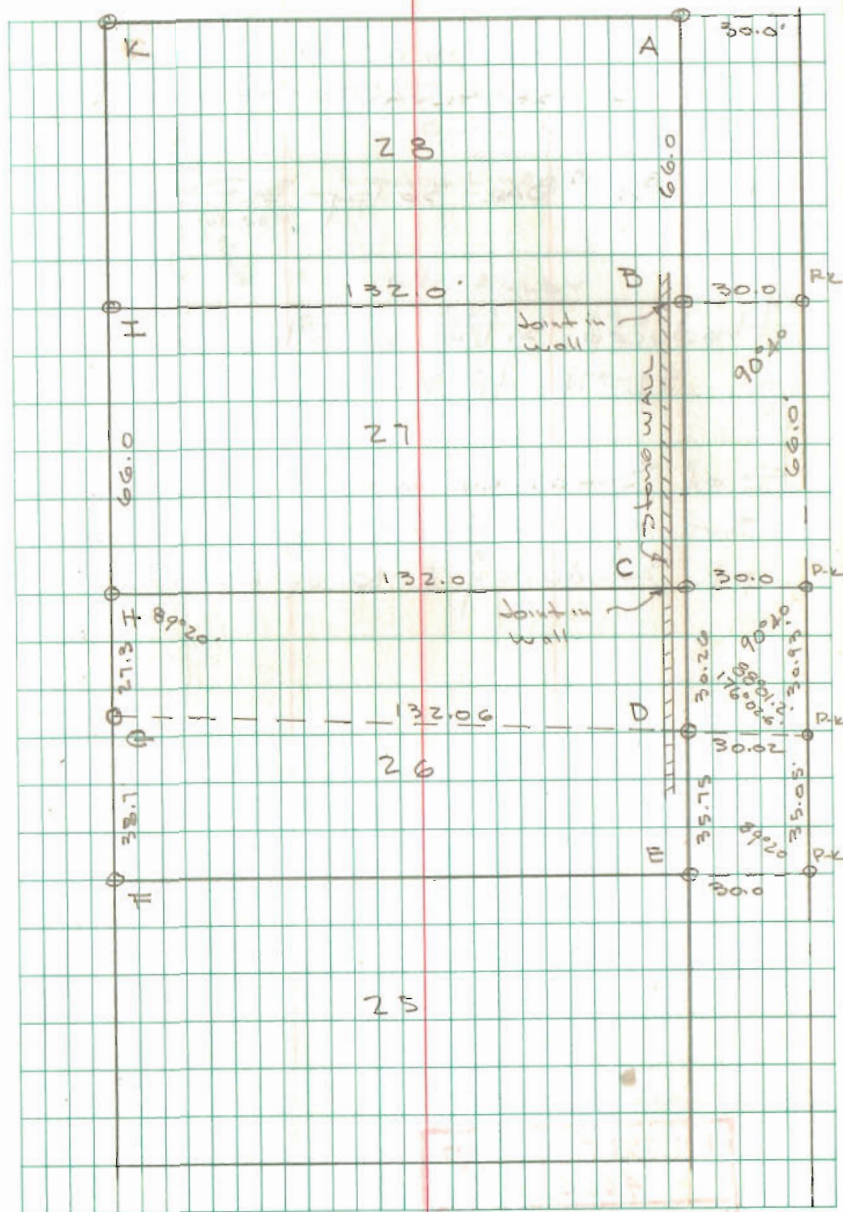

INDEXED ON MAP
 5851

KERN'S SURVEY


SANDUSKY ST.
PENNSYLVANIA

□ = 3/4" A BAR 36" long SET

Produced S. line of alley along lots
59-71 to E of Sandusky St.E of Sandusky does not fit road
survey but it does fit lots E.
of Sandusky & N. of Railroad St.INDEXED ON MAP
4656Dodd
Nichols

9/23/69 48

Martha L. Kerns 1.46 Ac.

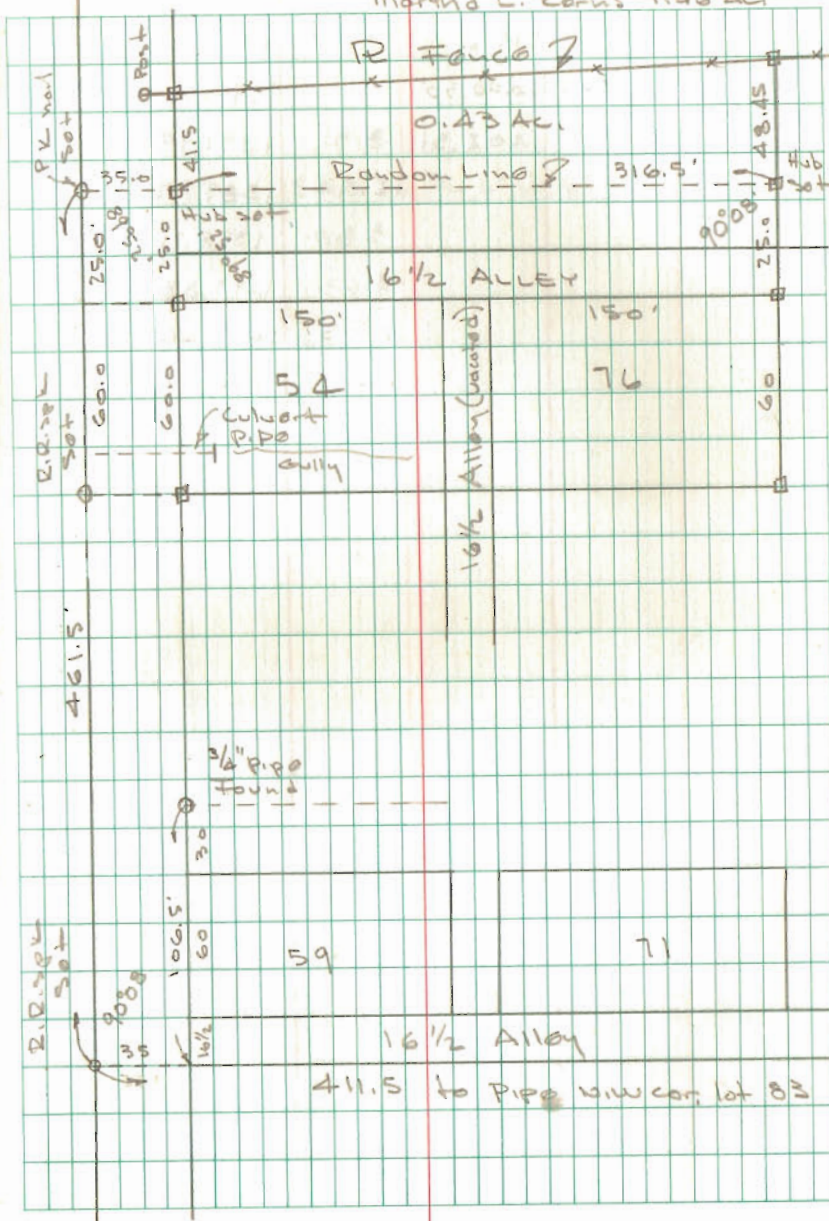


SMITH SURVEY

10-18-69

55°
Whitlow
Artis

50

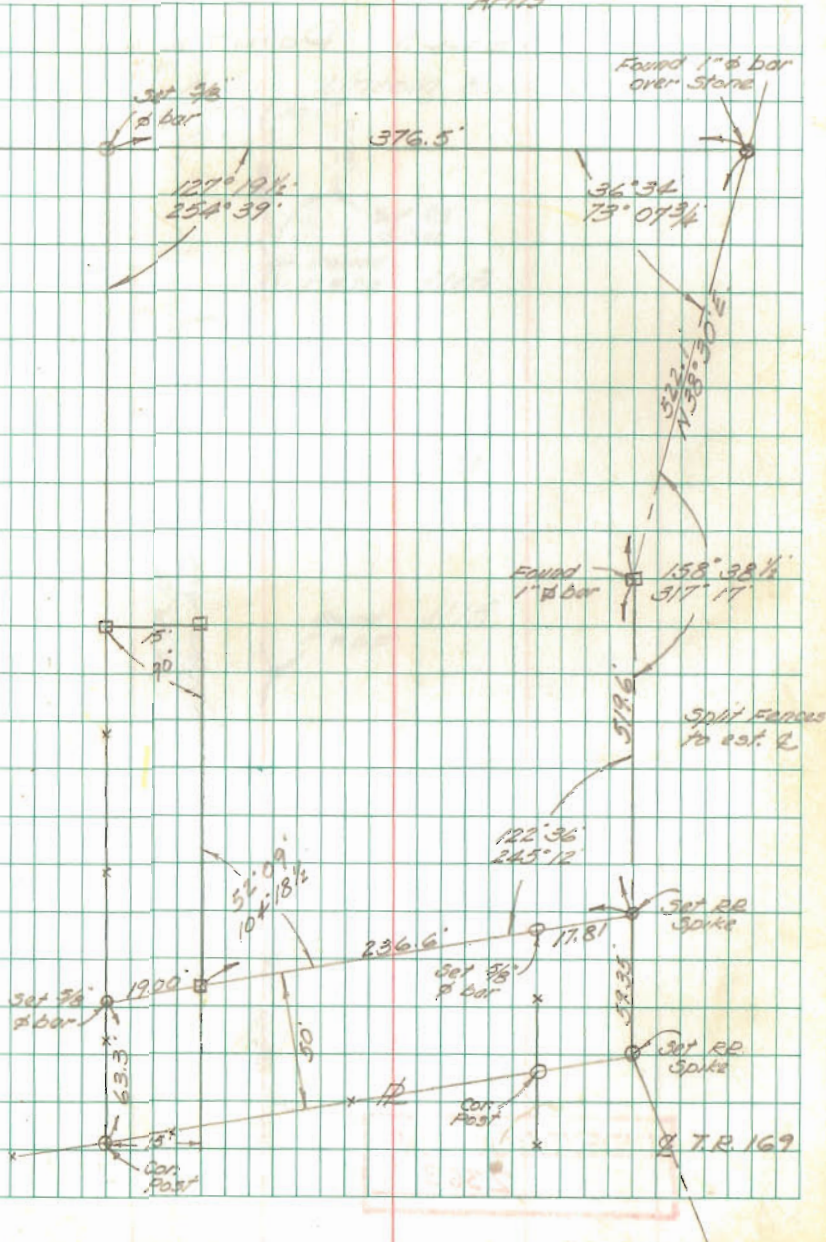


INDEXED ON MAP

4288

OAK ACRES
 WASHINGTON P.
 RUSSELLS POINT


J. Whitlow
 D. Artis

10/25/69
 70°

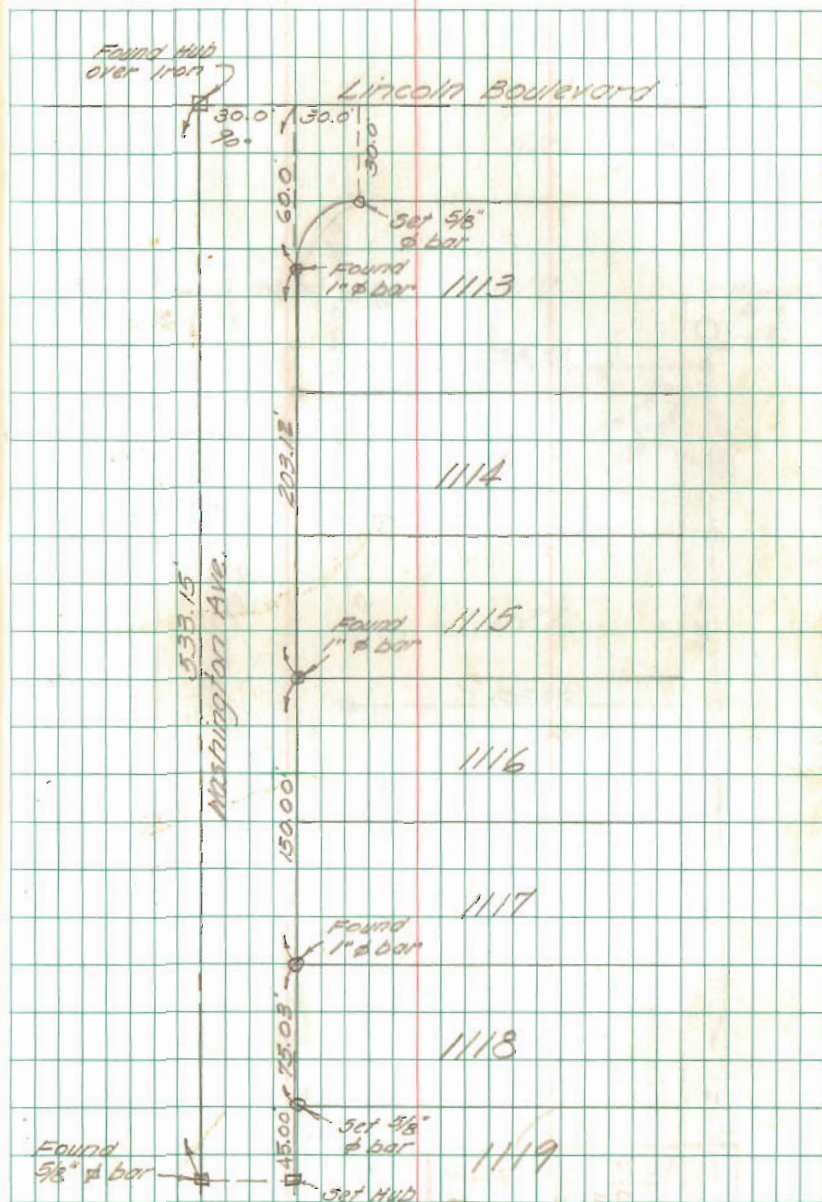

INDEXED ON MAP

2363

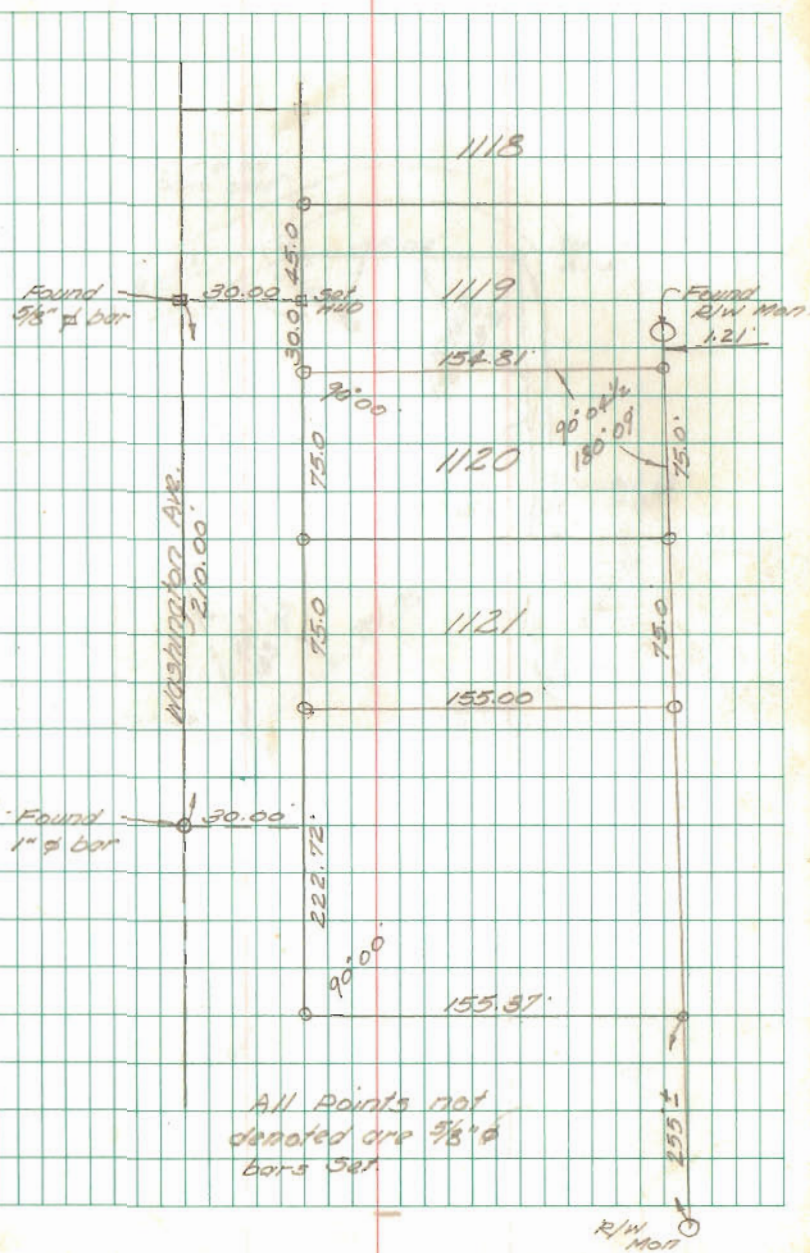

INDEXED ON MAP
2363

FOSTER SURVEY
QUINCY

200 pg. 28, this book

179.60
79.20.3


100.39.7

DOOBON
NICHOLS

12/6/69
350

55

JEFFERSON ST.

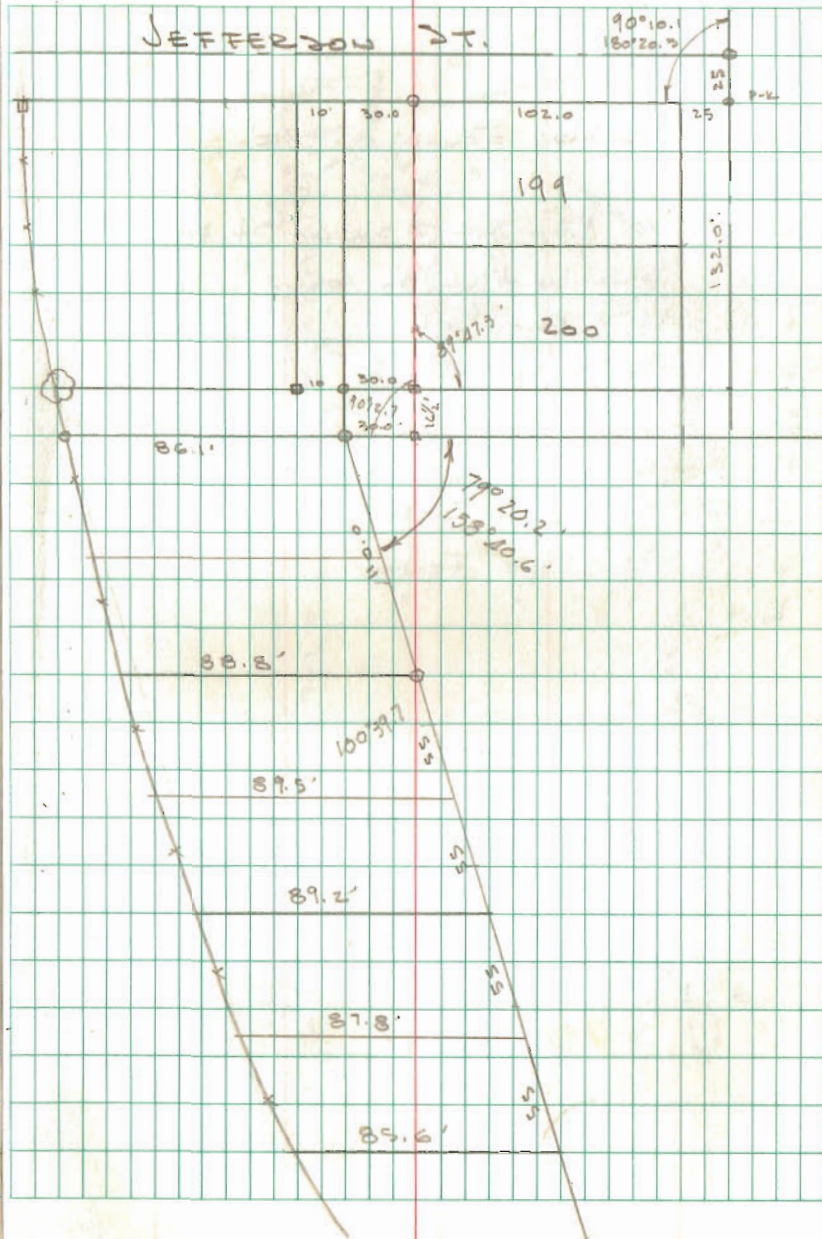

INDEXED ON MAP
4962

117


LOTS 530-531-532 & W¹/₂ of 533
 PICKERELLTOWN ROAD
 WEST LIBERTY

- A = Remains of old Hub found
 See D Bk 2 pg 73
- B = Remains of old Hub found - "F"
 Bk 2 pg 73
- C = 3/4" pipe found "G" Bk 2
- D = 3/4" ϕ Bar found "A" Bk 2
- E = 5/8" ϕ Bar Set
- F = 5/8" ϕ Bar found Bk 2 pg 74
- G = 1/2" pipe found " " "
- H = 5/8" ϕ Bar found
- I = " " " "
- J = 5/8" ϕ Bar Set
- K = Tkd Hub Set - projected A-B to K
- L = P-K nail Set @ Alley @ E North St.
- M = " " " @ North @ N. Line
 of Pickerelltown Rd.

INDEXED ON MAP
5581

Dodson
 Arrie

June 6, 1970
 57

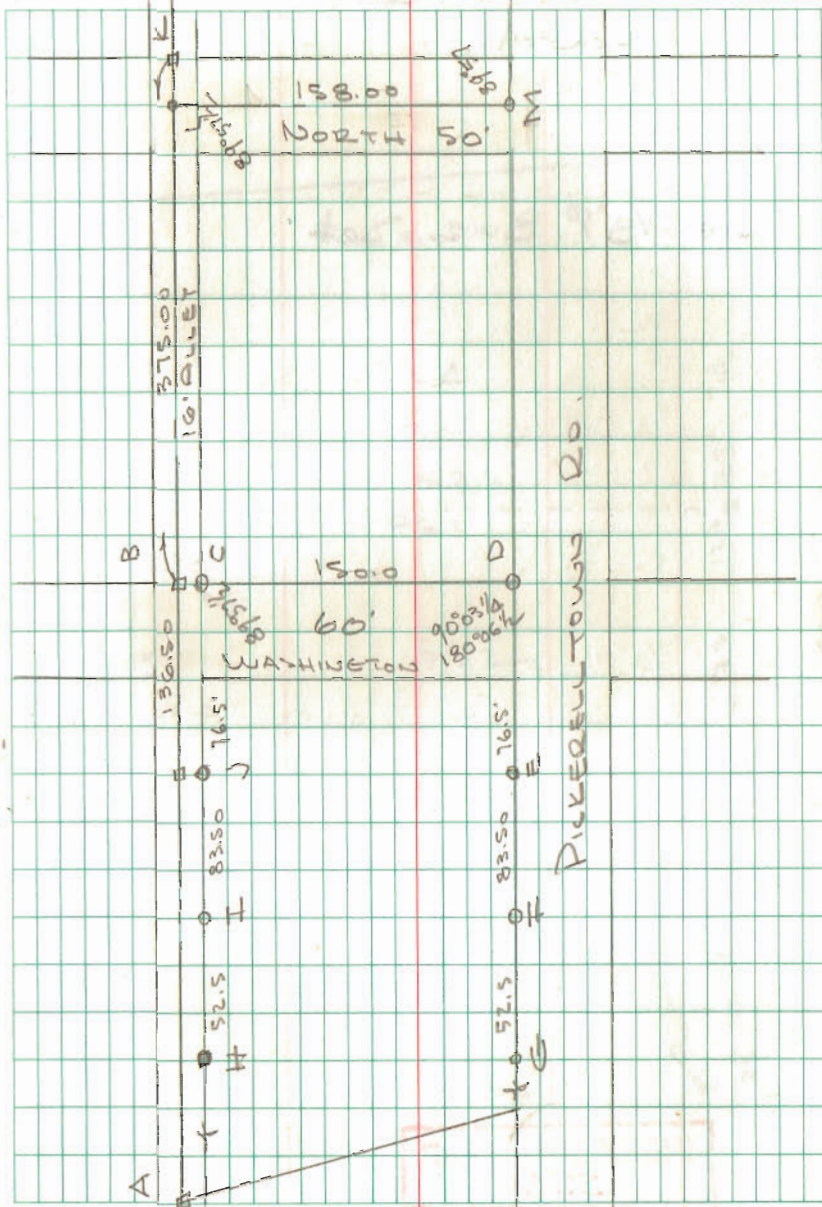


98
Lots 530-531-532-533
WEST LIBERTY
COUNTY.

02 5/8" ϕ BAR Jet

INDEXED ON MAP
5581

June 6, 1970 58

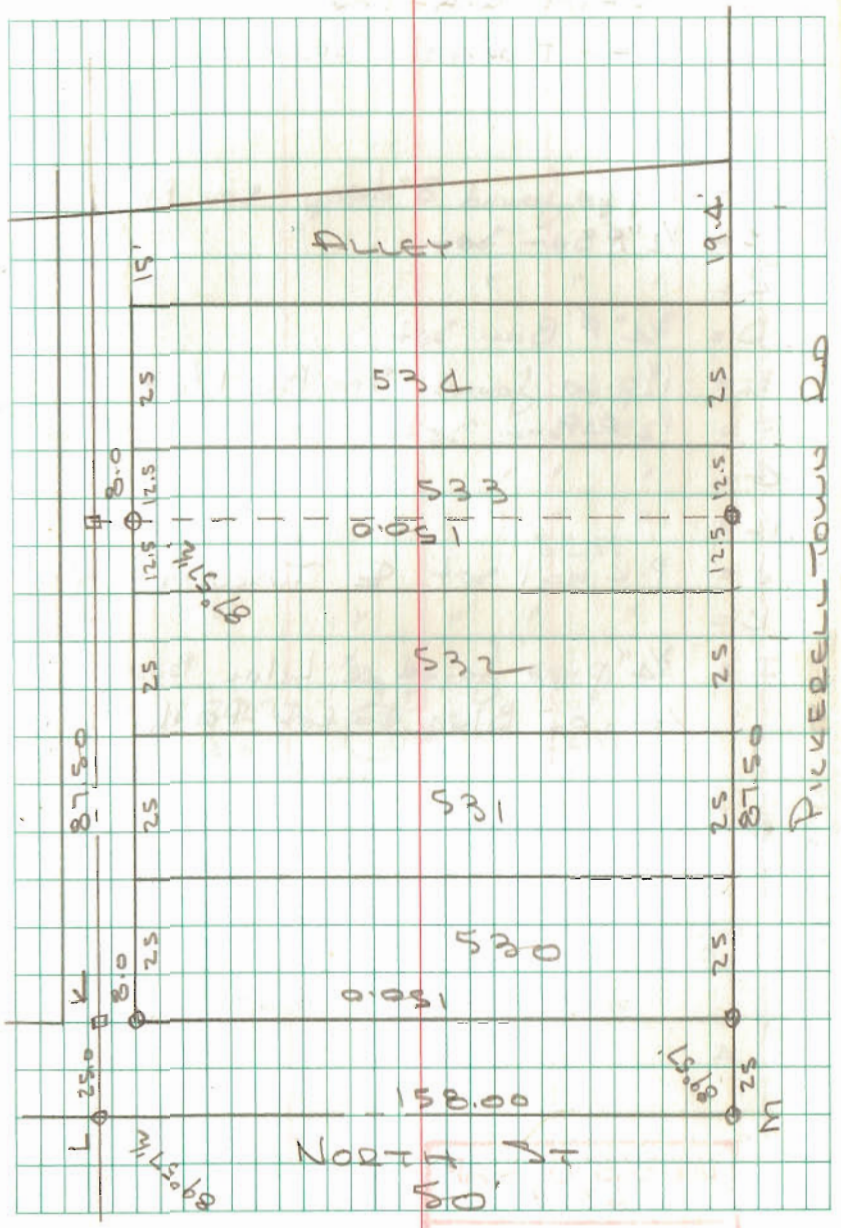

48


LOTS 2209-2278 & S/2 2277
CHIPPEWA PARK 3
For Everett SANDY

- A = 1/2" pipe found 8" deep see Bk 1/68
- B = 1/2" P Bar Set
- C = " " "
- D = 3/4" P Bar Set
- E = 1 1/2" pipe found see Bk 1/68
- F = 1/2" P Bar Set
- G = " " "
- H = " " "
- J = P-K nail set @ Tuscorora Path
- K = " " " " " "
- I = 3/4" pipe found in Lilac Bush
Cor. of Blue Jacket Path

INDEXED ON MAP
6309

Dodson
Art's

6/20/70
650 58

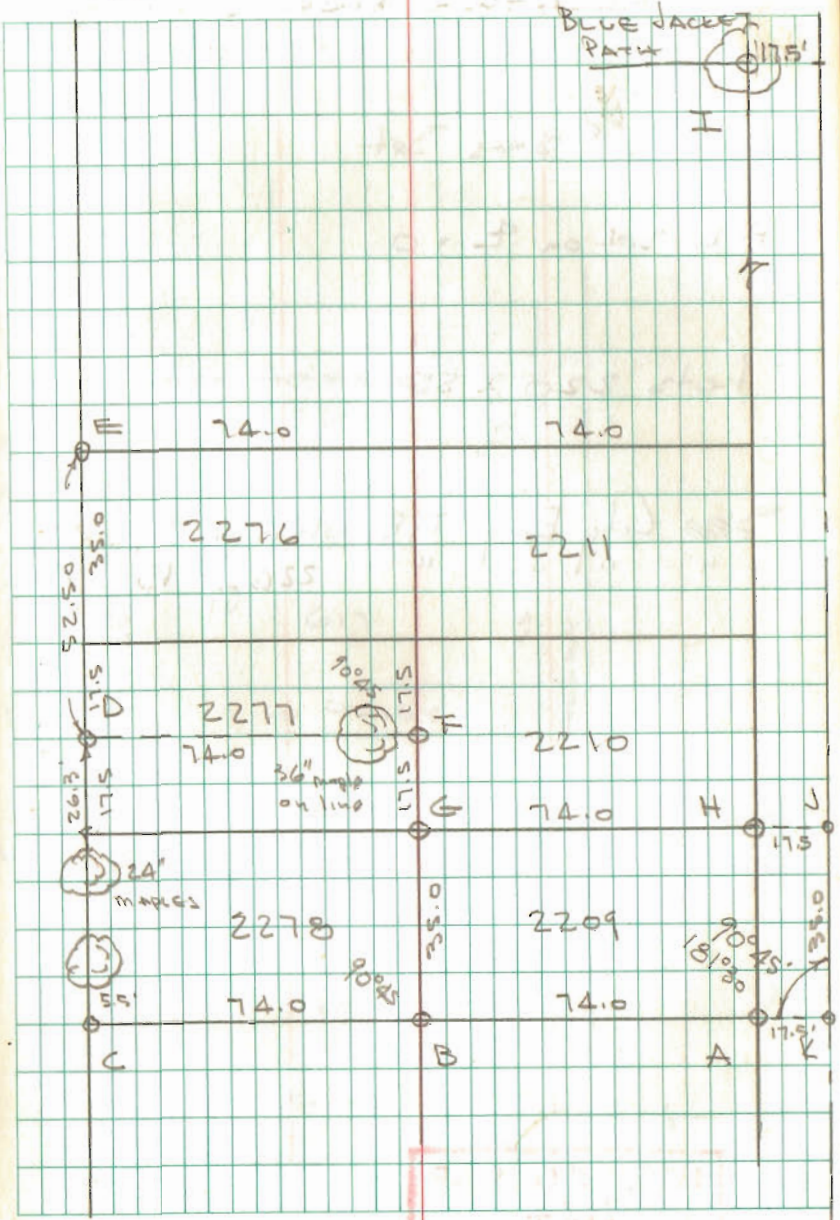

117

Lot 616
BELLFONTAIN, OHIO

02 5/8" ϕ Bars Set


P-K set on $\phi = 0$

Lots 220 x 55

See City Eng F.B. 192 pg. 59
" " " " 226 pg. 13

Dolson
A.C. Co

6/27/70
70° 60

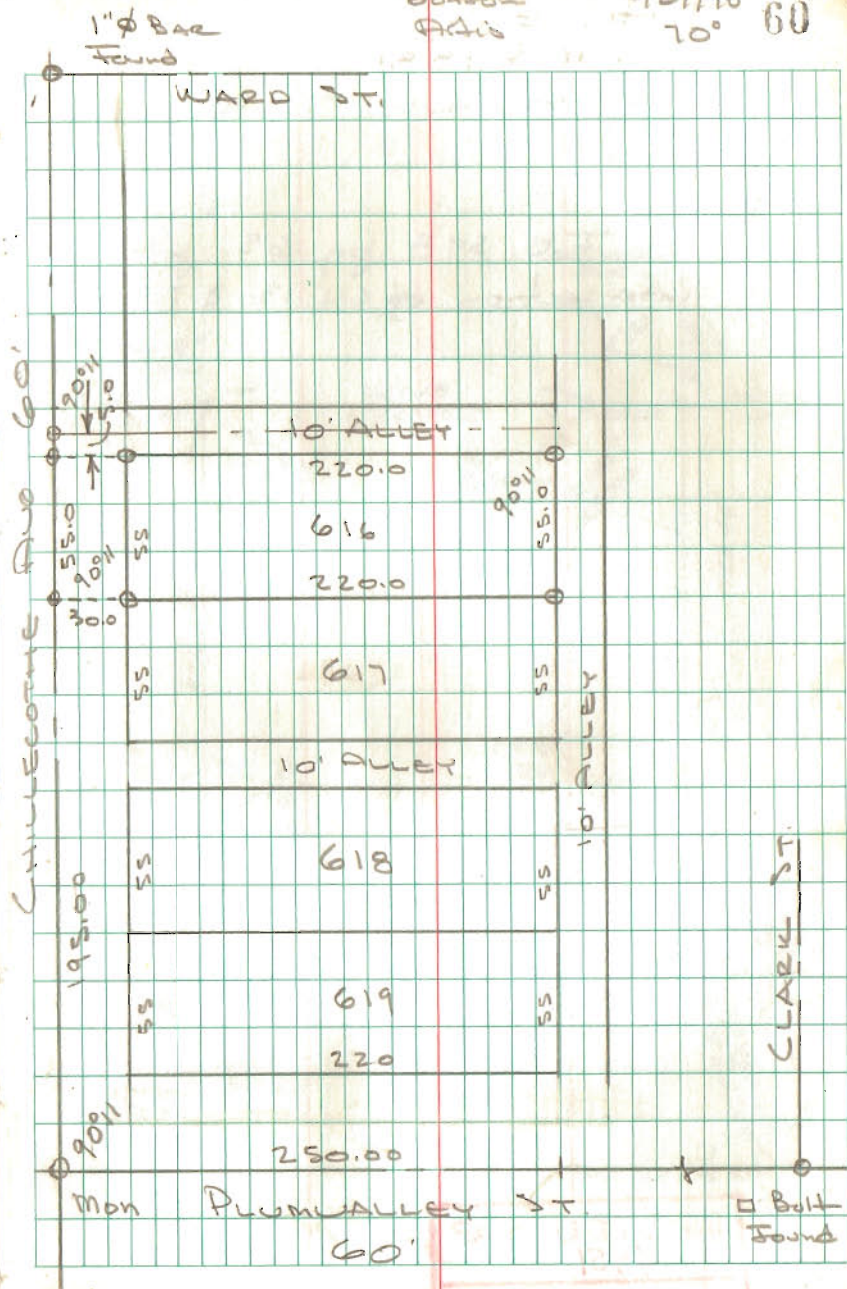


INDEXED ON MAP
9624

HERFORD SURVEY
 V.M.S. 9881
 McARTHUR TWP.

See F.B. 598 pg 65 for
 intersection of C.H. 130 & T.R. 57

Whitlow
 Artis


Oct. 30. 1971
 70°E 61

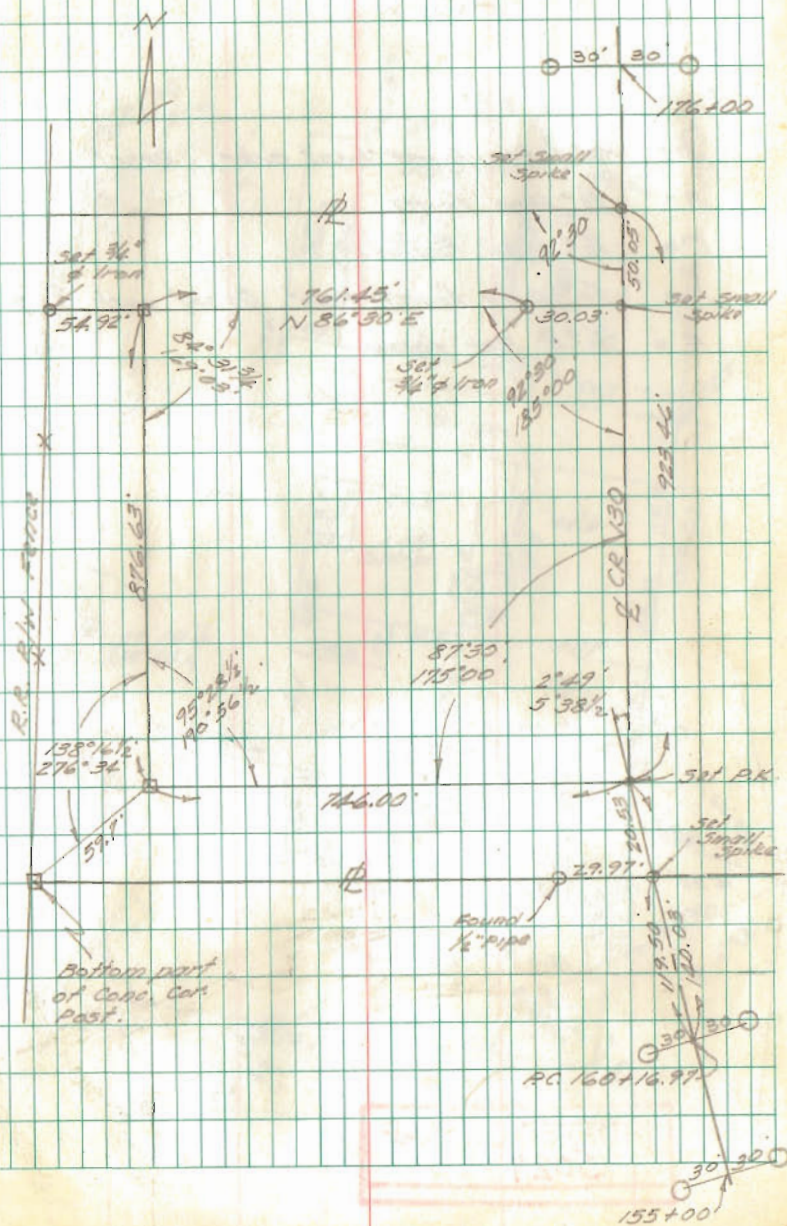


INDEXED ON MAP
 4951

LOT 14 & 15
SHAWNEE ISLAND

- A = $\frac{3}{8}$ " ϕ Bar found bent over. Reset it.
- B = $\frac{1}{2}$ " Pipe found
- C = $\frac{1}{2}$ " Pipe found
- D = $\frac{1}{2}$ " Pipe found Bent. Reset with $\frac{3}{8}$ " ϕ bar
- E = $\frac{3}{8}$ " ϕ Bar found

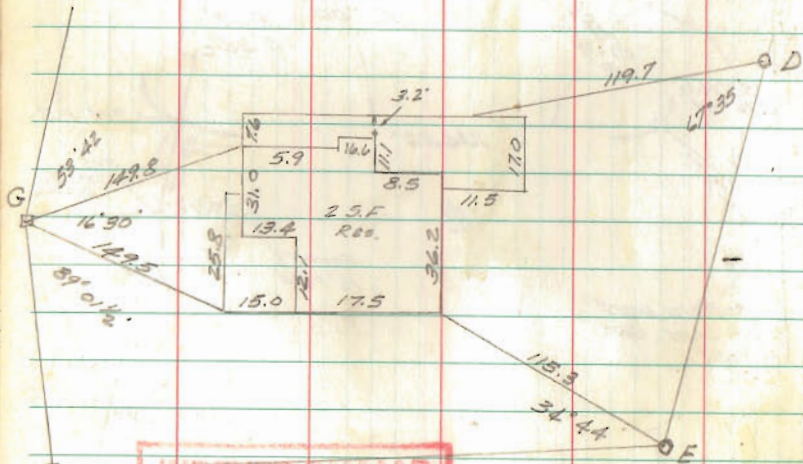

11-13-71
Whitton
A-715 62

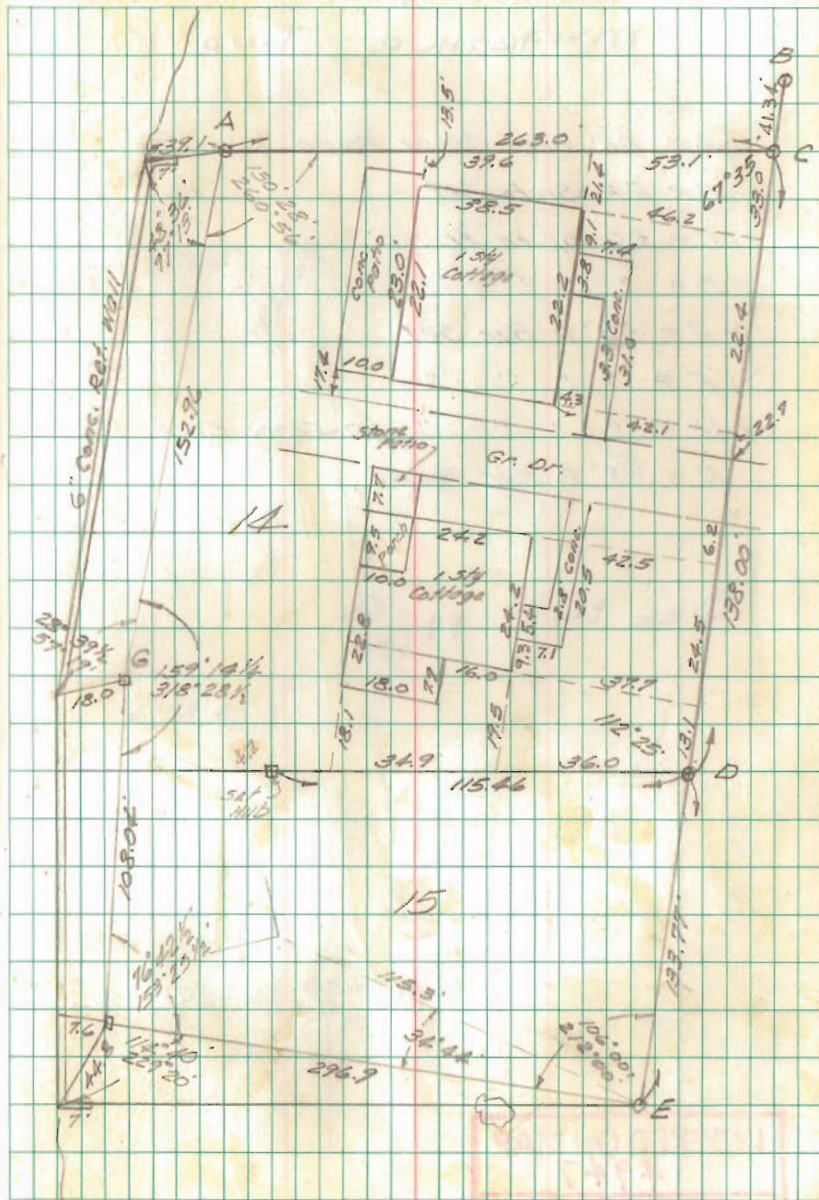



LATHAM SURVEY
V.M.S. 3438

JEFFERSON TWP

INDEXED ON MAP
3512

Pts. A, B, C & D = $\frac{3}{4}$ " ϕ Iron Set


See Plat p. 46

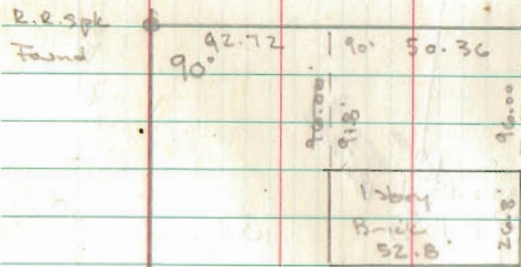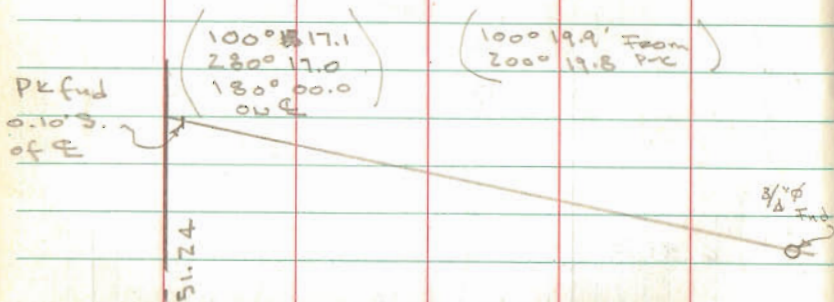

12/28/76
Dodson
Harris
McCurdy

11-20-71
Whitlow
Artis

64

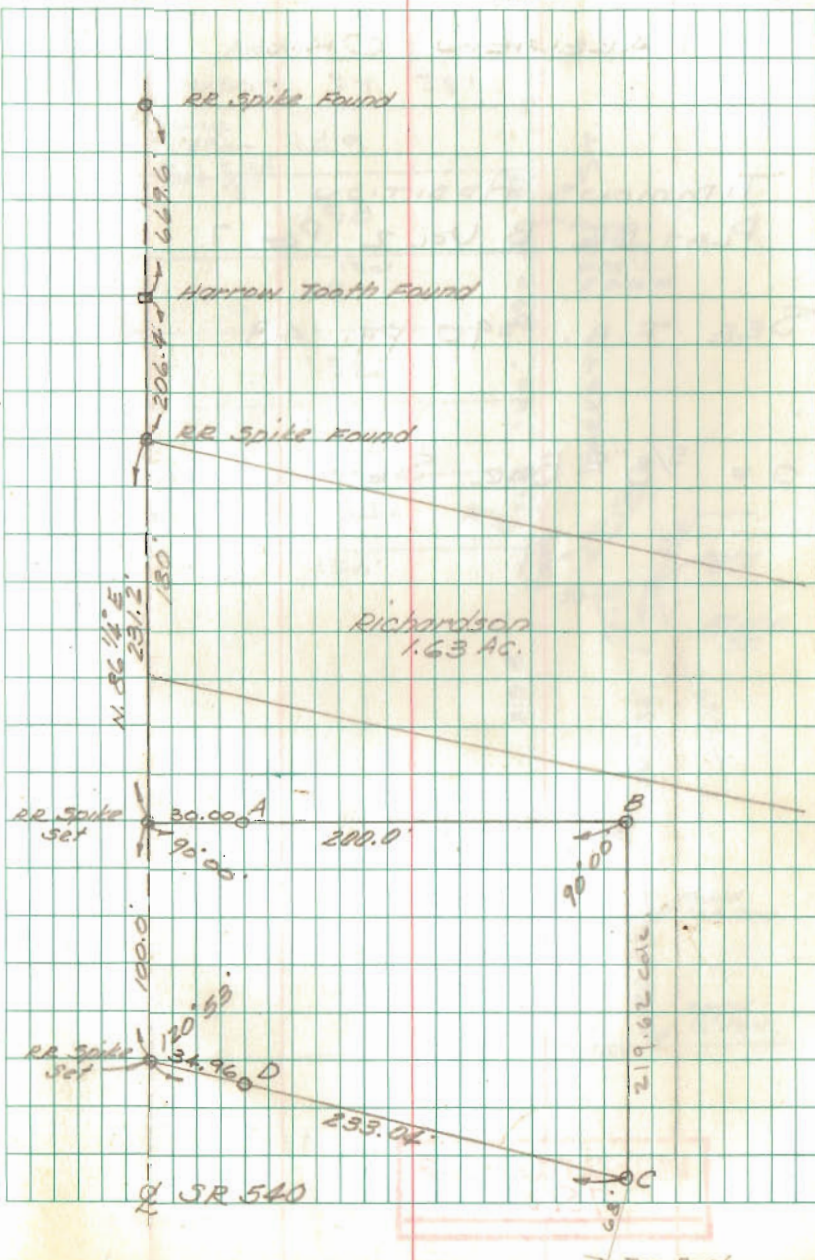

LOTS 149 - 154

LAKEVIEW, OHIO

TIMMONS ADDITION
PLAT BK B VOL 2 PG 7


SEE F.B. 390 pg. 43

O = 5/8" ϕ BAR SET

Whitlow
Arts

11/27/71
35°

65

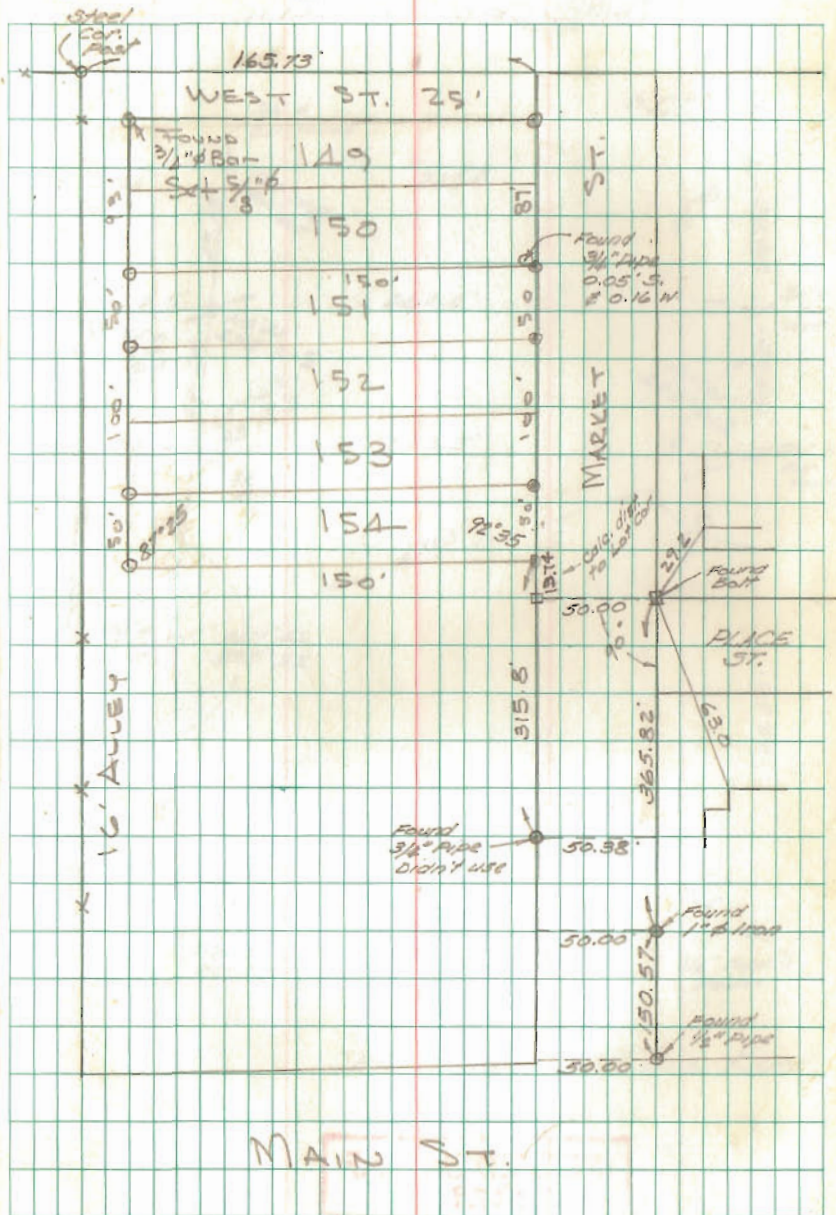


INDEXED ON MAP
7510

LOT 14 & 15
SHAWNEE ISLAND

1-22-12
15"
W. H. H. W.
ARTS

66

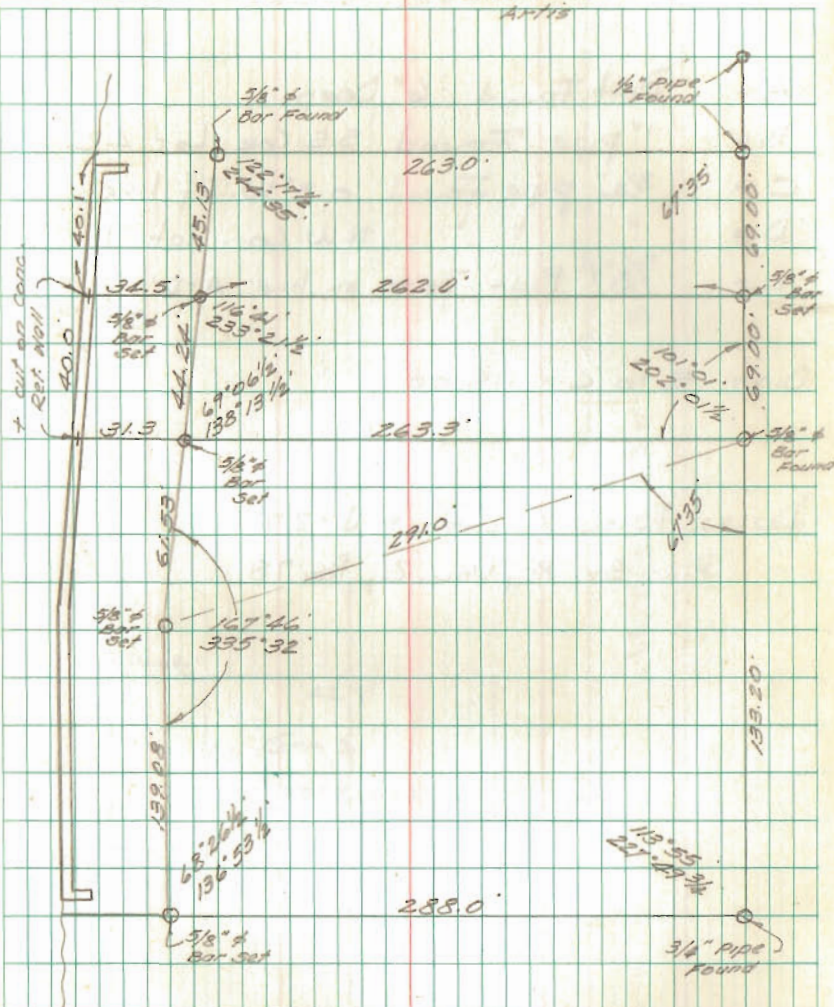

SEE PAGE 69 THIS BOOK

INDEXED ON MAP

5029

INDEXED ON MAP

Lot 1 & 2
Dunn's Pond Allot.

- A = Bolt Found 6" Deep
- B = 1" pipe Found S.E. Cor Lot 42
- C = 3/4" pipe Found 0.3' W. of line
- D = " " " N.W. Cor. lot 7
- E = 5/8" ϕ Bar Set on line A-D


DIST E TO C = 115.00

Dunn's Pond Allot = J-27
PLAT BK B, Vol. 2, Pg. 78

Whitlow
Arts

12/18/71

67

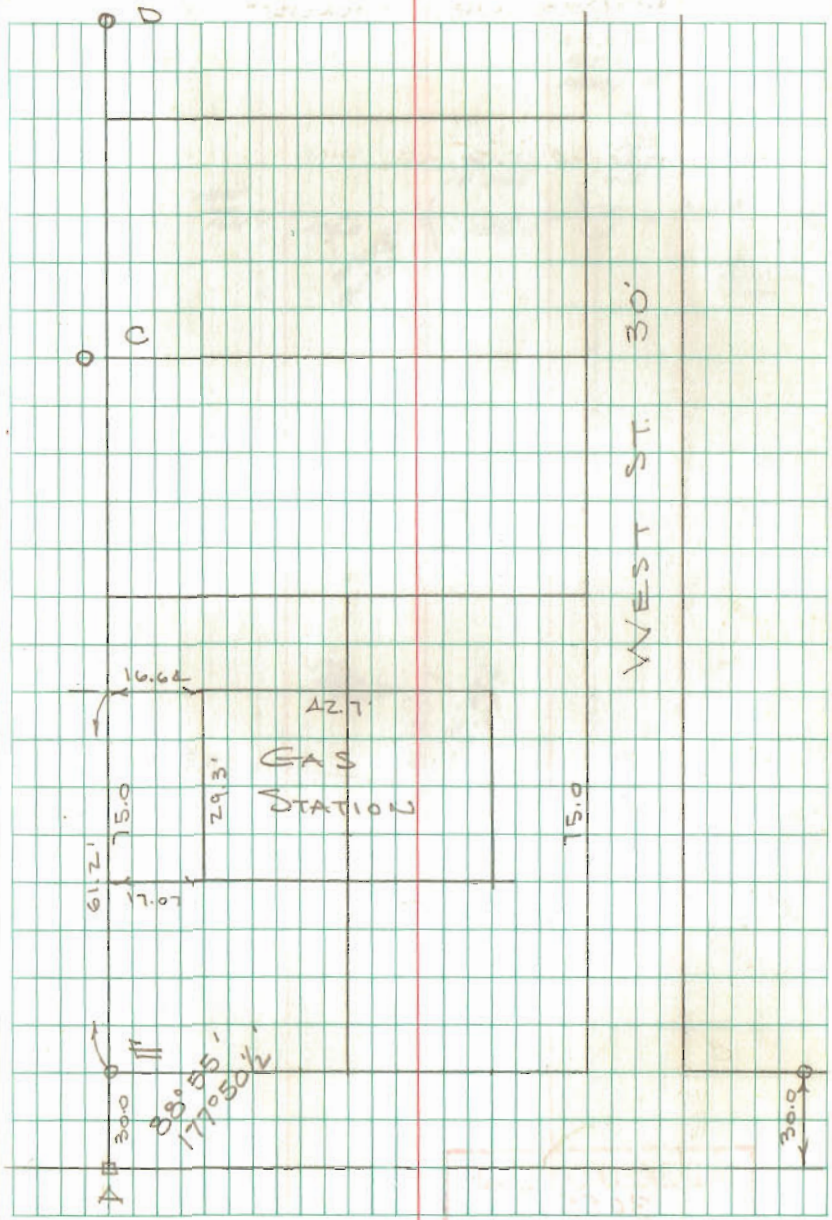


INDEXED ON MAP
2393

WELLS SURVEY
McARTHUR TOWNSHIP

68


3-11-72
Mistlow
Arctic
Windy 40°

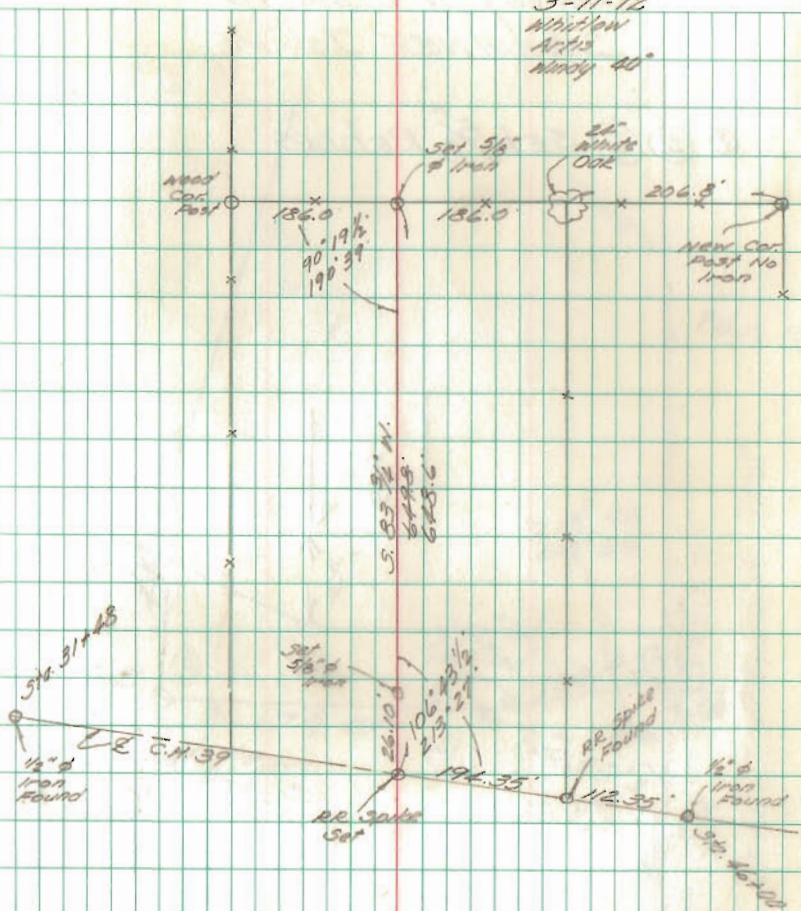

INDEXED ON MAP
3055


SURVEY PT. Lot 15
SHAWNEE Island

① ② ③ SET 5/8" REBARS

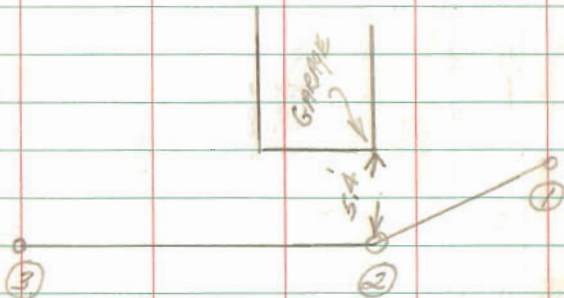

INDEXED ON MAP
5029

FEB 3, 73
Artis Shes
McCurdy
30°

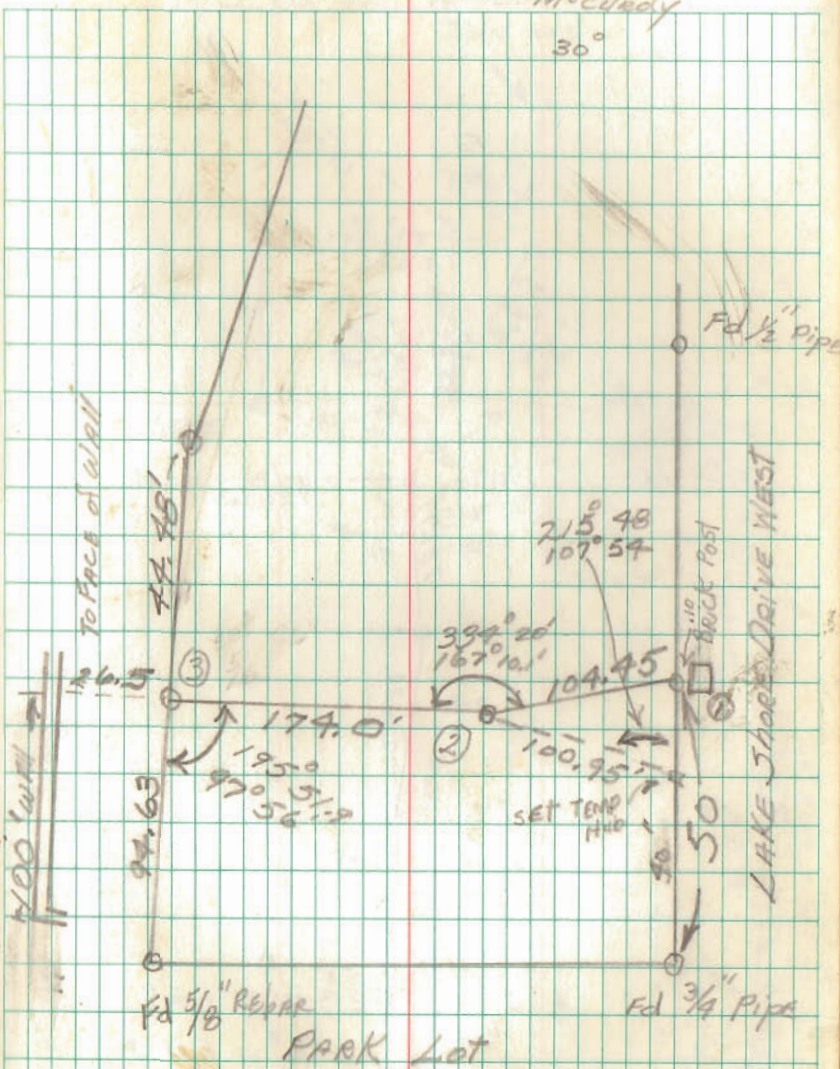

SEE PAGE 66 This Book