

NICHOLSON'S 1ST ADD.
 RusSELLS POINT, OHIO


- A = $\frac{3}{4}$ " pipe found Bend - Replaced with 1" pipe
- B = $\frac{1}{2}$ " pipe found 12" deep
- C = $\frac{1}{2}$ " pipe found 8" deep
- D = Old very rusted $\frac{3}{4}$ " pipe found replaced with 1" pipe 36" long
- E = R.R. Spk. Set 20.00' N. of A on line A-C
- F = R.R. Spk Set
- G = " " "
- H = " " "
- I = " " "
- J = $\frac{3}{4}$ " Pipe Found
- K = $\frac{5}{8}$ " Bar Set 11.00' S. of C on line A-C
- L = R.R. Spk Set
- M = " " "
- N = " " "
- O = Harrow tooth Set E. WARDEN & Center
- P = R.R. Spk Set
- Q = " " "
- R = " " "

INDEXED ON MAP
 6446

Dodson
 Art's
 McCurdy

5/6/73

02

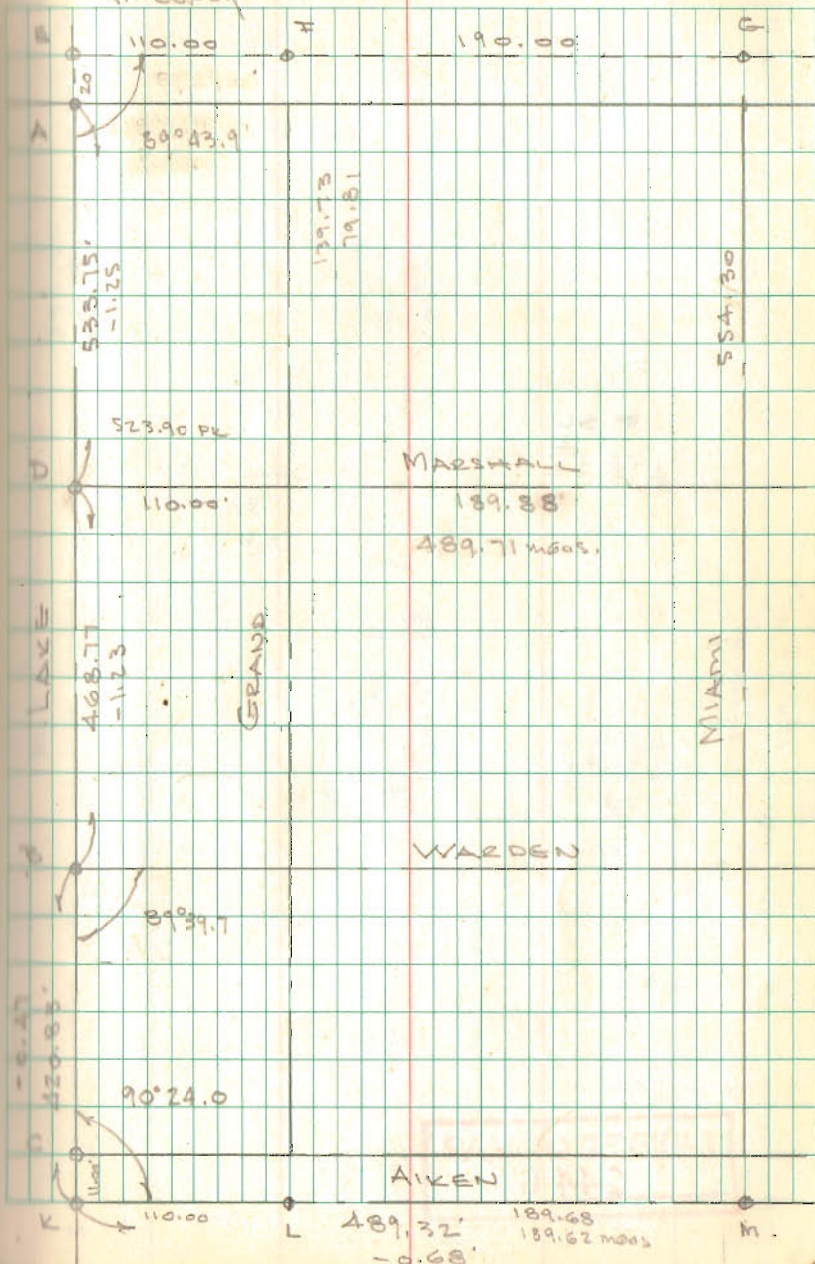


Dodson
Art
McLund

June 2, 1973

70°

04

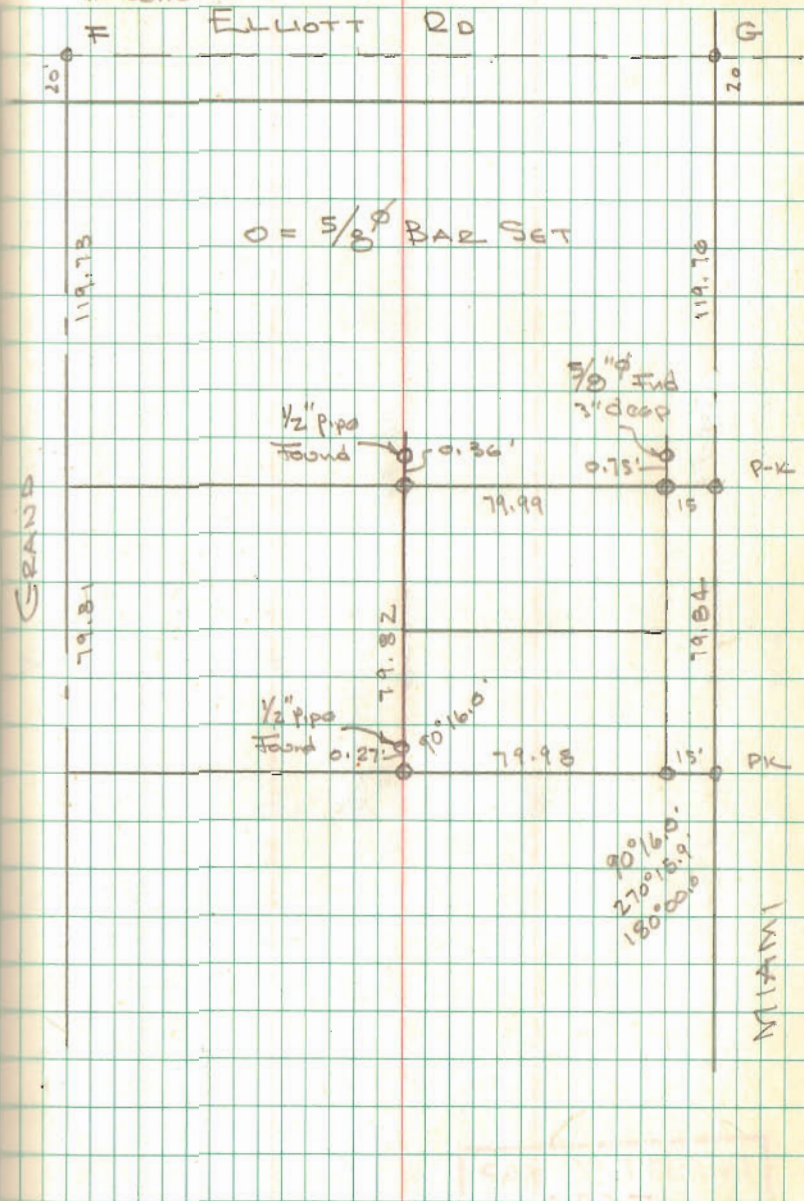


INDEXED ON MAP

7102

Dodson
Artis
McCurdy

6/2/79

05

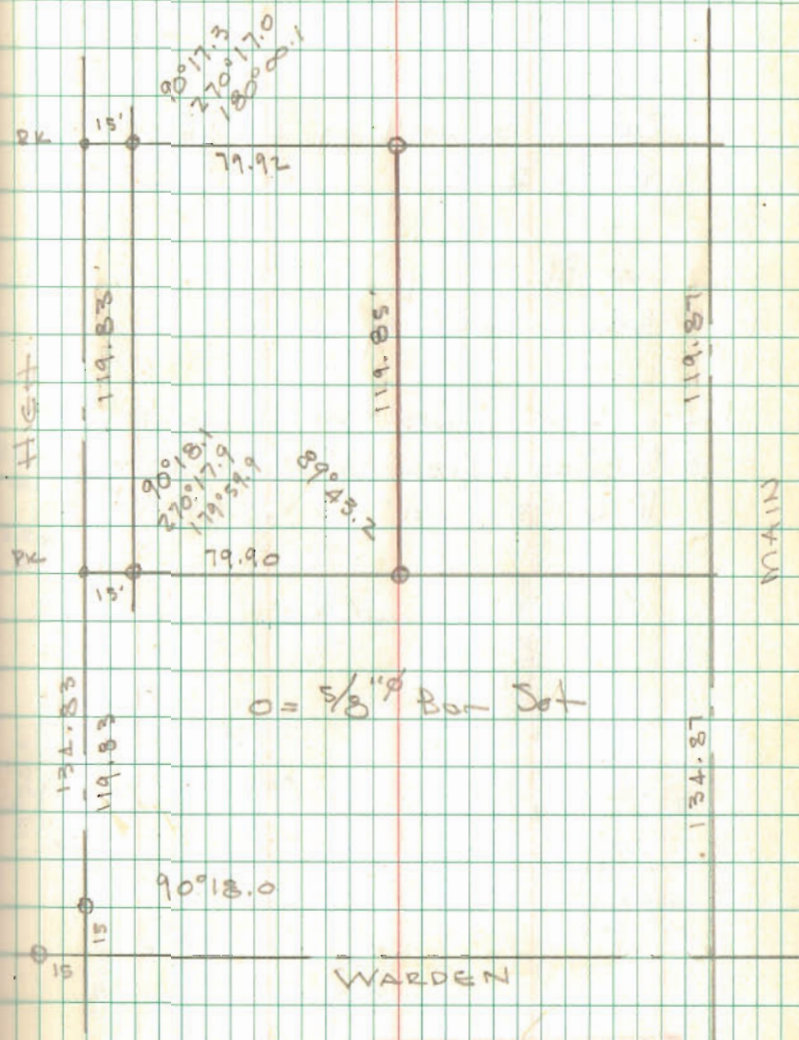

INDEXED ON MAP

7497

TURNER SURVEY
V.M.S. 9883

McArthur Twp

See F.B. 687 pg. 24 for
E.T.R. 37

See Bk 3 pg. 36 for
Hower Survey


Note R.R. spikes set @ 210.00' &
215.00' from 3/4" P @ Sta. 331+29
R @ 215.00'

INDEXED ON MAP
5323


Dutton
Artes
McCounty

MAY 22, 1973.
70°
RAW

06

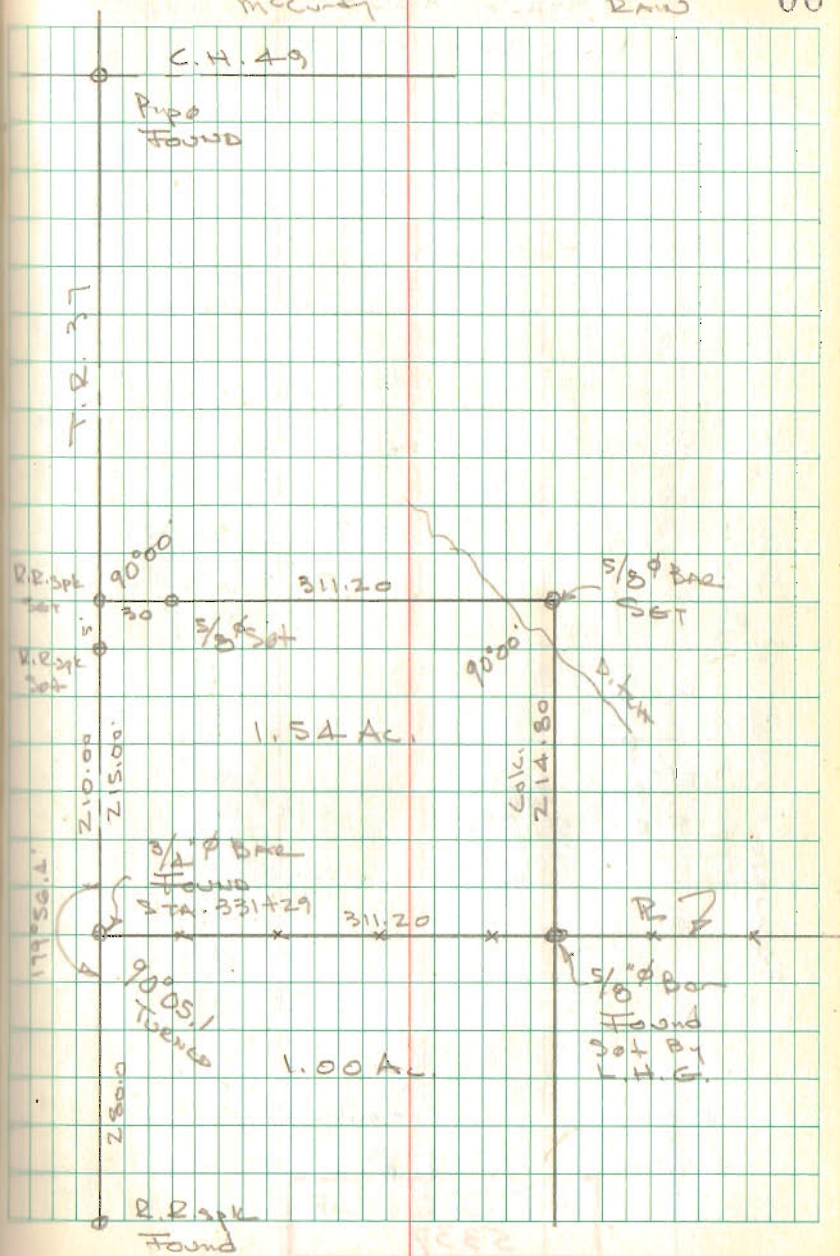

LOT 121-122-140
MYERS ADDITION
HUNTSVILLE

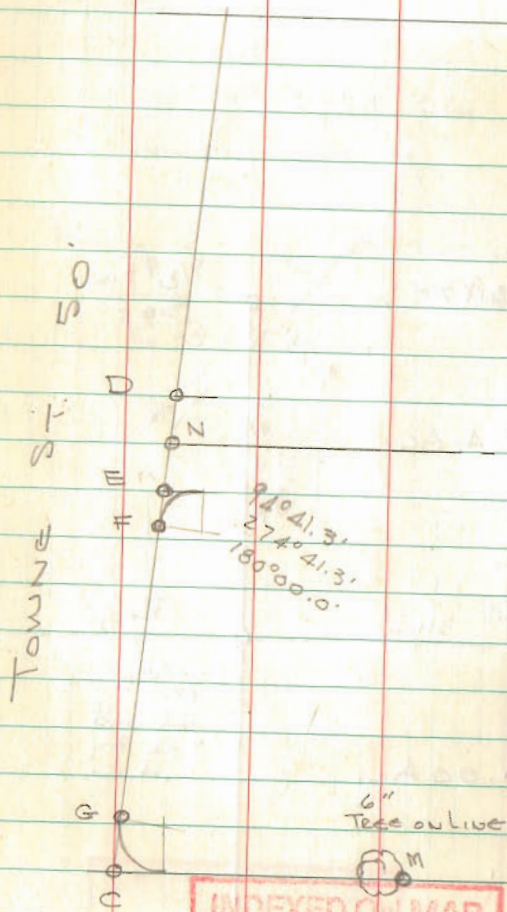


INDEXED ON MAP
5337

Dodson
Antis
McCurdy

MAY 24, 1973

07

VINE ST. 50'

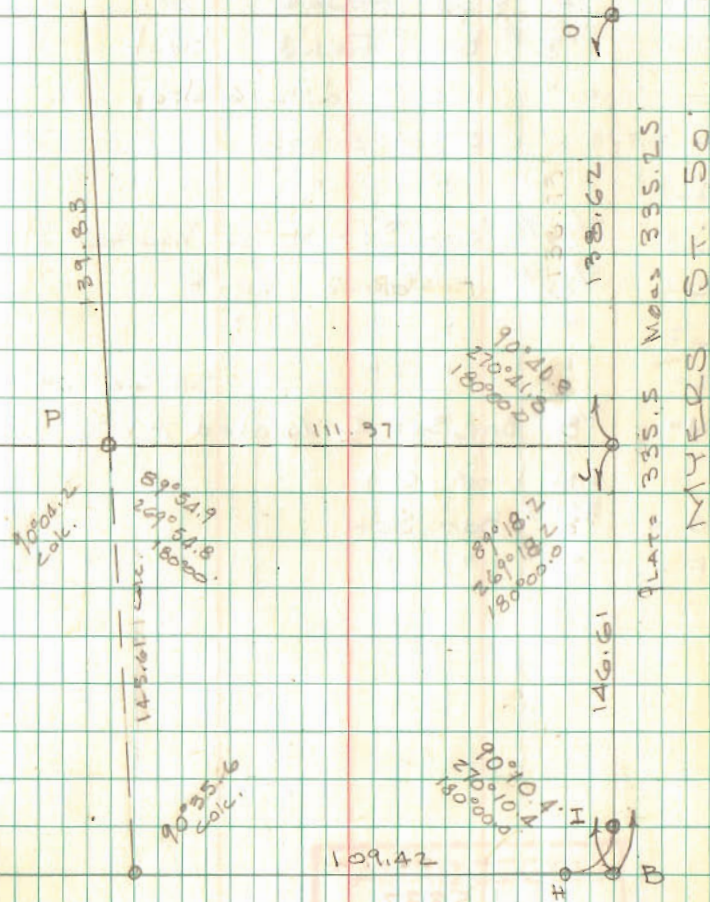

INDEXED ON MAP
5337

Lot 121-122-140
COUNT

- A = 5/8" ϕ Bar Found (Set By D. Gilbert)
 B = 3/4" Pipe Found
 C = 5/8" ϕ Bar Found 6" deep
 D = " " " bent
 E = 3/4" Pipe Found
 F = 5/8" ϕ Bar Found bent
 G = " " " 6" deep
 H = " " " "
 I = " " " "
 J = 5/8" ϕ Bar Set ϕ of Vacated Alley
 K = 5/8" ϕ " Found Bent
 L = " " " "
 M = " " " " S.S. Coe 119
 N = 5/8" ϕ Bar Set ϕ of Vacated Alley
 on line C-D.
 O = 5/8" ϕ Bar Set
 P = " " " "

5/25/73
70°
Rain

08

From	To	MEAS DIST	PLAT DIST	
A	B	335.25	335.5	-0.25
D	E	16.48		
E	F	5.50'		
E	C	136.06		
C	G	10.66		
E	N	8.27		
J	N	292.01	292.2	-0.19
C	B	302.05	302.3	-0.25

INDEXED ON MAP
5337


HARRIS SURVEY
STOKES TWP
R.R. 2 LAKAVIEW

- A = R.R. Spk Found
B = " " "
C = 5/8" Bar found - "D" Bk 3/29

Dodson
Artis
McCurdy

5/31/73

09

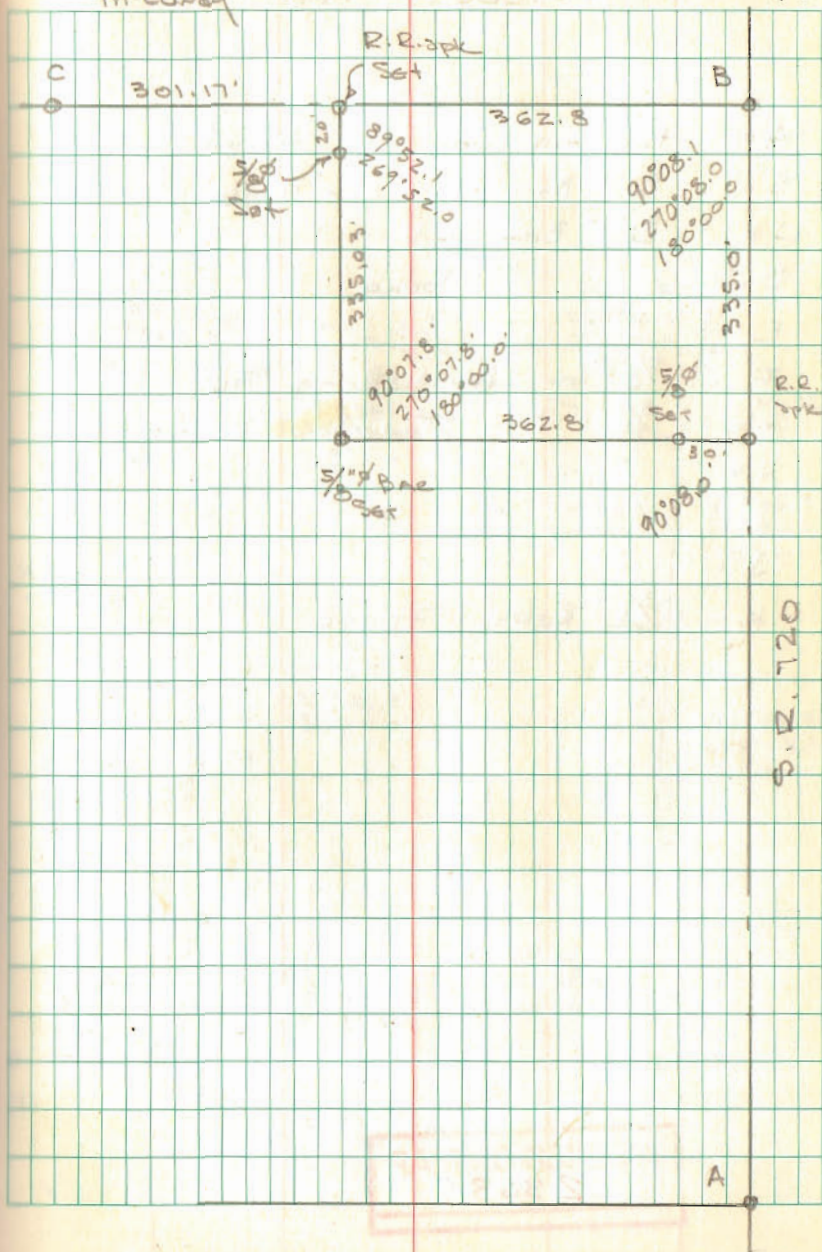

INDEXED ON MAP
5446

OAK ACRES
Russell's Point

- A = 4" Hub over iron Found
 B = 3/4" ϕ Bar Found 12" deep
 C = 3/4" ϕ Bar Set
 D = " " " Found
 E = " " " "
 F = 5/8" ϕ Bar Found Ring on Top
 G = 3/4" ϕ Bar Found
 H = " " "
 I = " " "
 J = " " "
 K = 3/4" Rebar Found


83.00

INDEXED ON MAP
2363

Dodson
Arts
McCurry

6/9/73

10

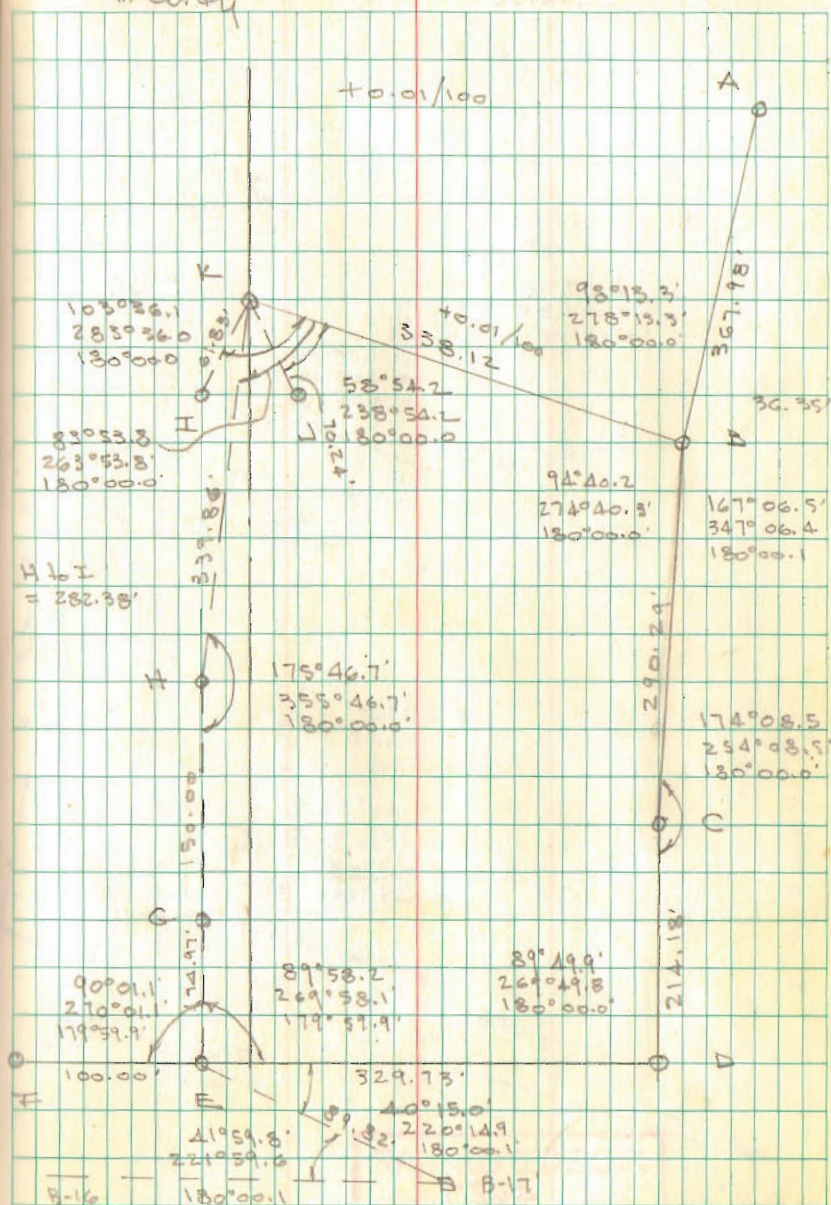

CURRENT SURVEY
ZANE TWP


146°46.2
107°07.7
106°06.1
359-60.0

INDEXED ON MAP
4627

Dodson
Artis
McCurdy

6/11/73

11

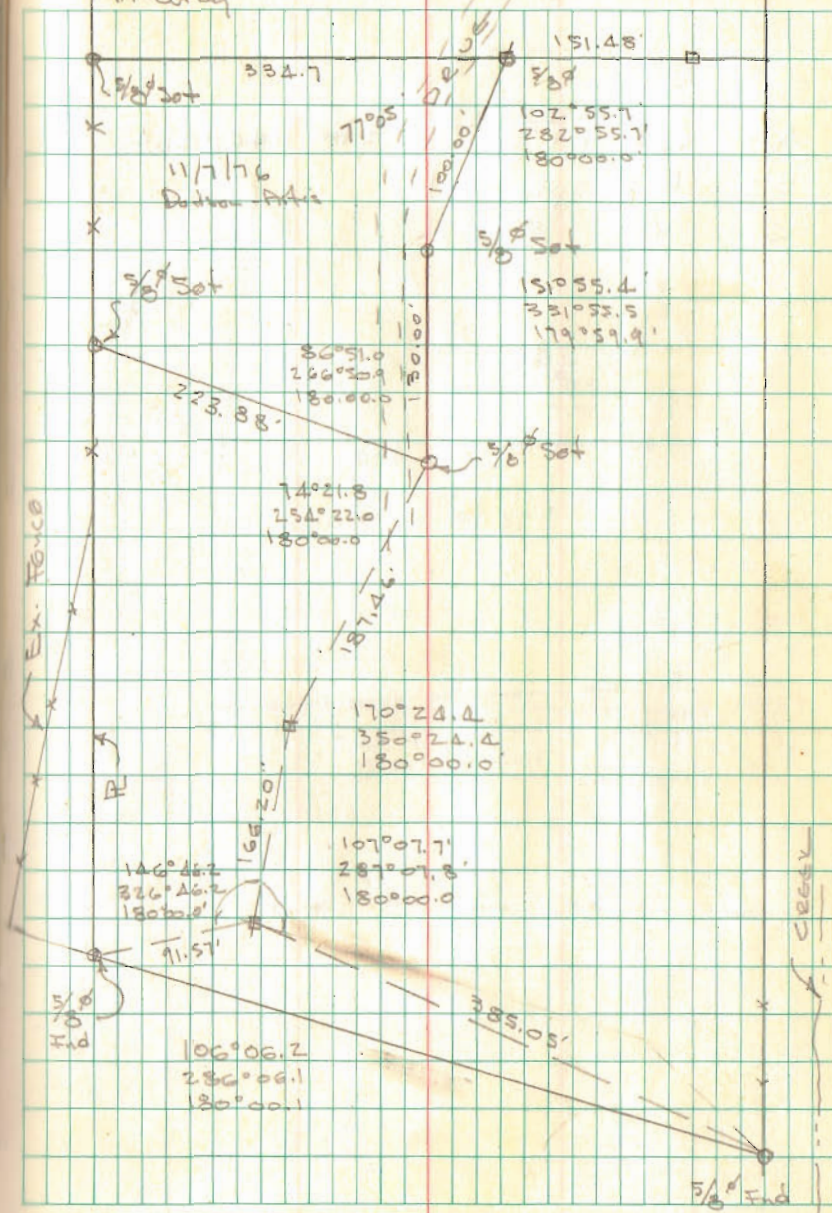


SHARK SURVEY
WOLF ISLAND

- A = $\frac{5}{8}$ " ϕ Bar Found
- B = " " "
- C = $\frac{5}{8}$ " Bar Set 17.04 from A
- D = $\frac{3}{2}$ " Pipe Found
- E = 2" ϕ Steel Post - Angle in Fence
- F = Tkd Hub Set
- G = $\frac{3}{4}$ " Pipe Found
- H = 2" ϕ Steel Post - End of Fence
- J = PL Set

6/28/73
Rain

14

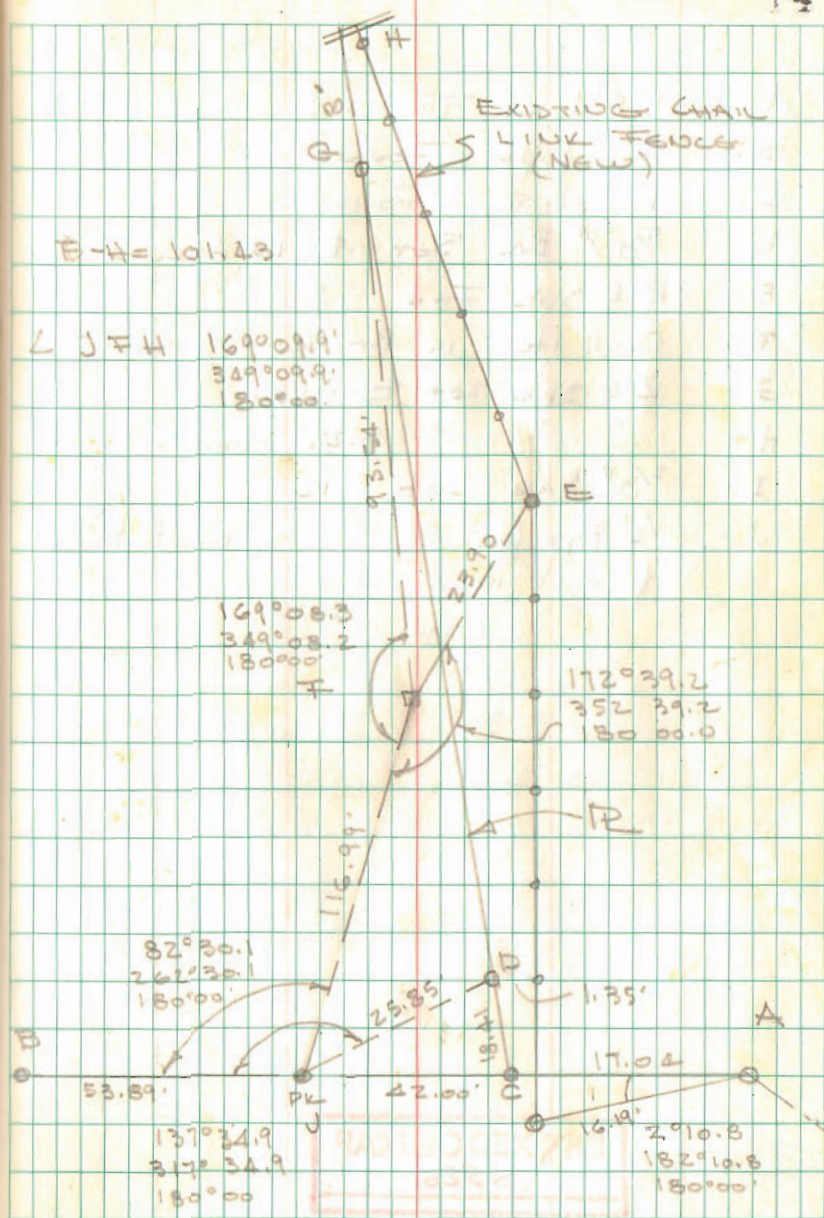

INDEXED ON MAP
3575

Lot 2979-2980-2981
 BELLEFONTAINE Ohio

- A = Nail in walk FOUND
- B = 3/4" pipe FOUND
- C = 3/8" Bar Set 32.84 from E
- D = " " "
- E = " " " 25.50 from E
- F = Chiseled + cut in Conc. walk @
 N.W. Cor lot 2979

601.99 + 0.015/100

224.04
 .24
 223.80

Projected A-B to E Semhole means to
 Mon 223.80' should be 223.39'
 line 0.41' west of true line


Found nail in walk 50.07' east
 of nail @ A 0.43' W. of true line

500 City Eng F.B. 246/20-21

INDEXED ON MAP
 6500

Dodson
 J. Souza

July 2, 1973
 July 10, 1973

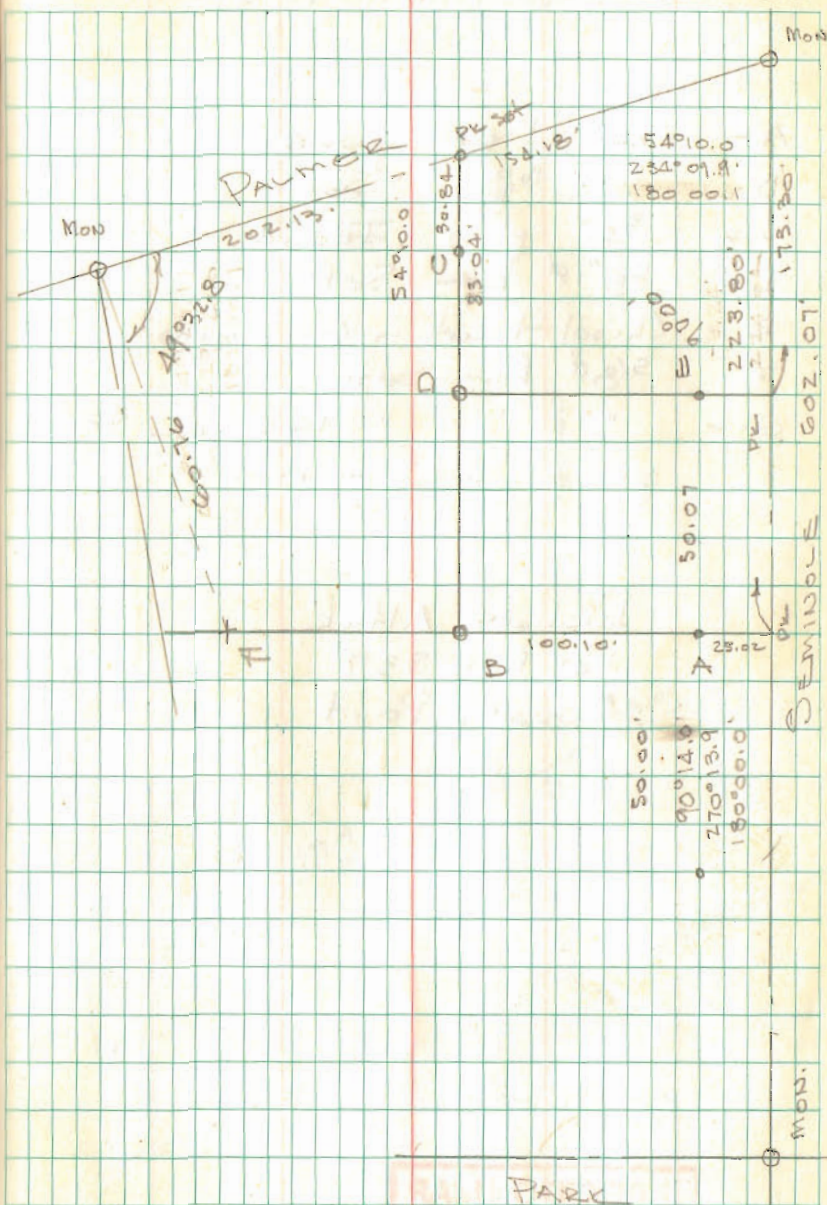

PARK
 1750

Lot 1095
Russells Point

- A = 3/4" Pipe found
- B = 5/8" Bar Set
- C = 3/4" pipe found
- D = 5/8" Bar Set
- E = Chisel + cut in Conc. wall
- F = 5/8" Bar Set
- G = " " " 14'0" from F
power pole @ 15.0

Richard Altick
PO. Box 537
Russells Point


INDEXED ON MAP
8677

Richard
Altick
member

July 5, 1973


80°

17

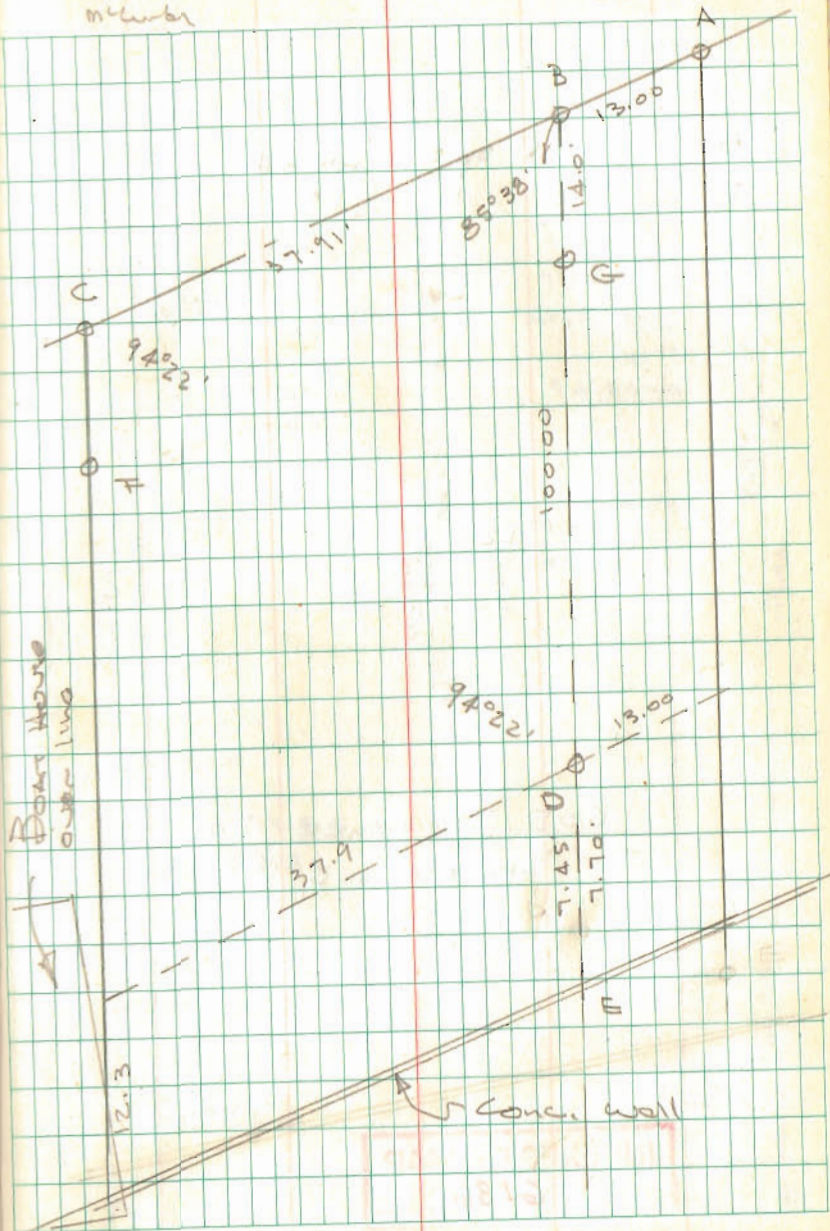

SHIRK SURVEY
ZANE TWP.


- 0.0100 / 100

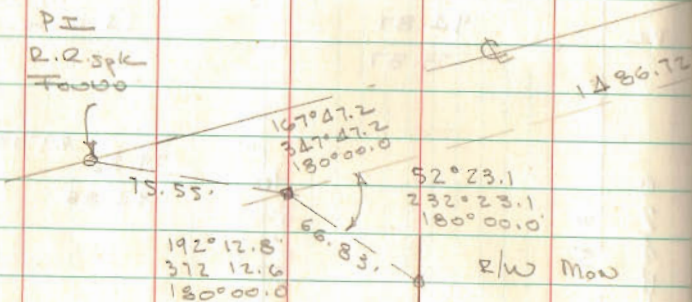

Dodson
Artis
McCurdy

7/8/73
85°

10

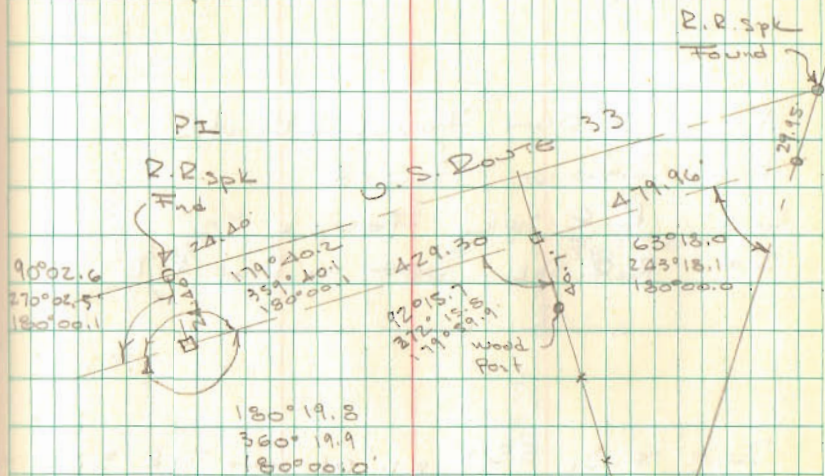


INDEXED ON MAP
5217

Lot 311-312
CHIPPewa No. 1

35.01
17.3

52.51

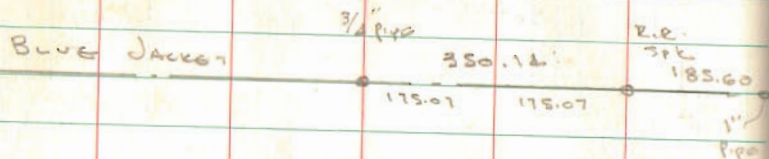


CHICKOKEE

TECOMSEH

BIG BEAR


HIWATHA

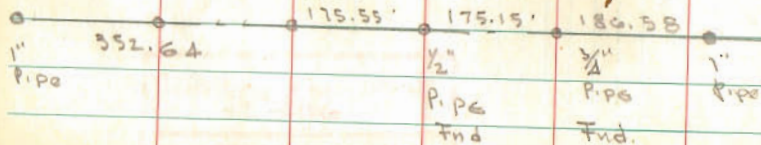

Dodson
Rick Bruce

8/21/73

21

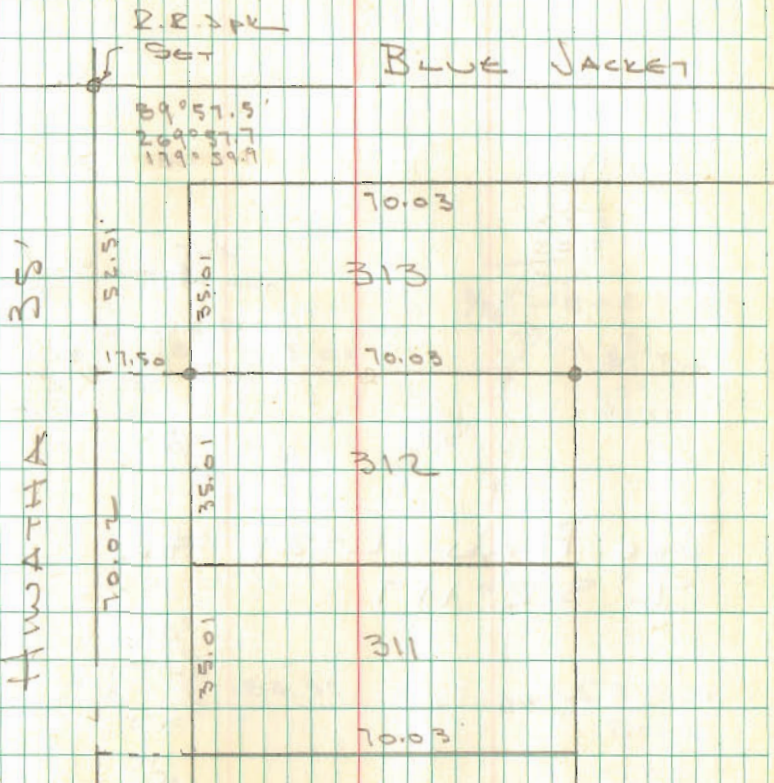

INDEXED ON MAP
9079

Lot 6-7
Ben A. Lot No. 2

194.28	375.00	62.55
243.30	62.55	123
<u>431.58</u>	<u>437.55</u>	<u>187.55</u>

194.28	125.00
187.55	6.73
<u>6.73</u>	<u>118.27</u>

200.00
<u>30.57</u>
163.43


123.90	200.00
	<u>123.90</u>
	76.10

	∠	Dist	C	D
Lt	12°36'	44'		
"	40°57"	54		
"	44°23'	104		
Lt	51°11'	120		
Rt	14°09'	49		
	62°31'	73		
	74°44'	104		


INDEXED ON MAP
7312

Dodgeon
Art's

8/30/73 23

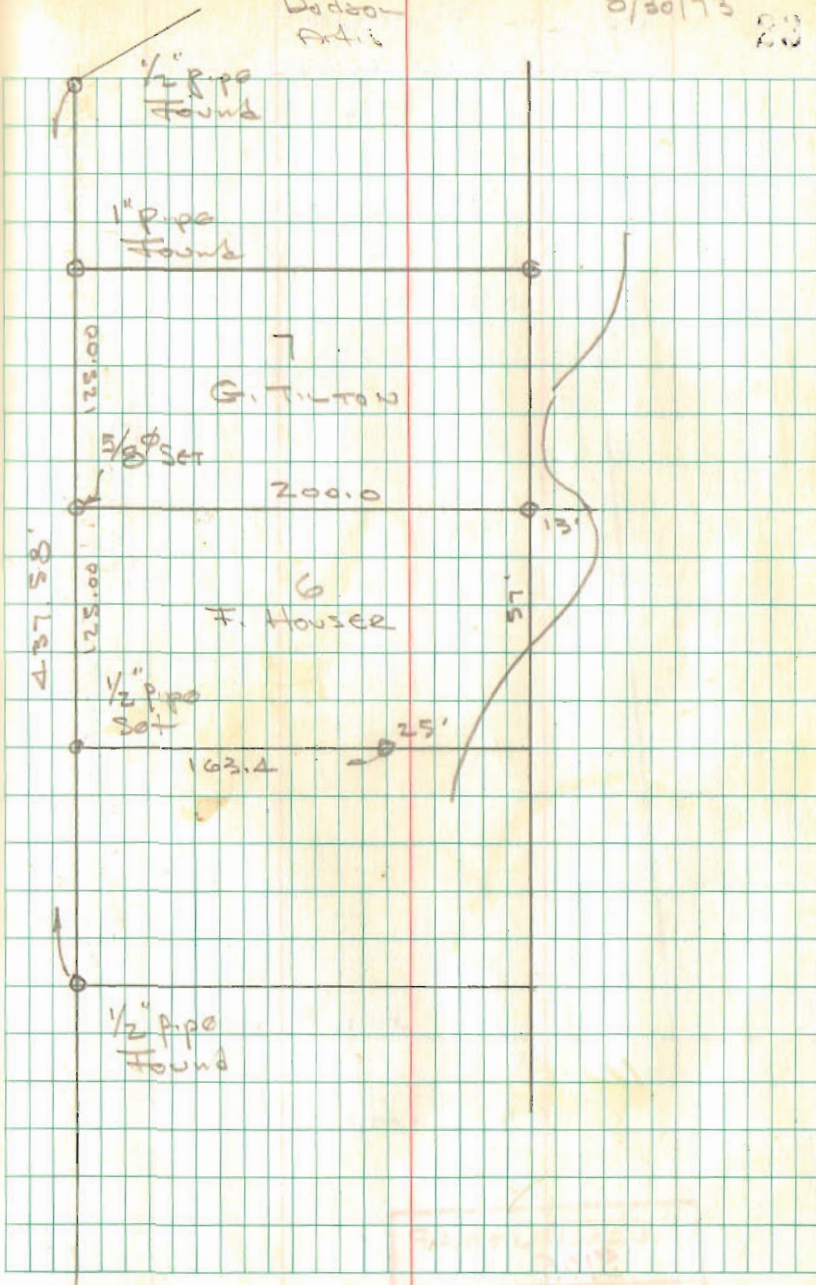

WOLF SURVEY
BELLEFONTAINE

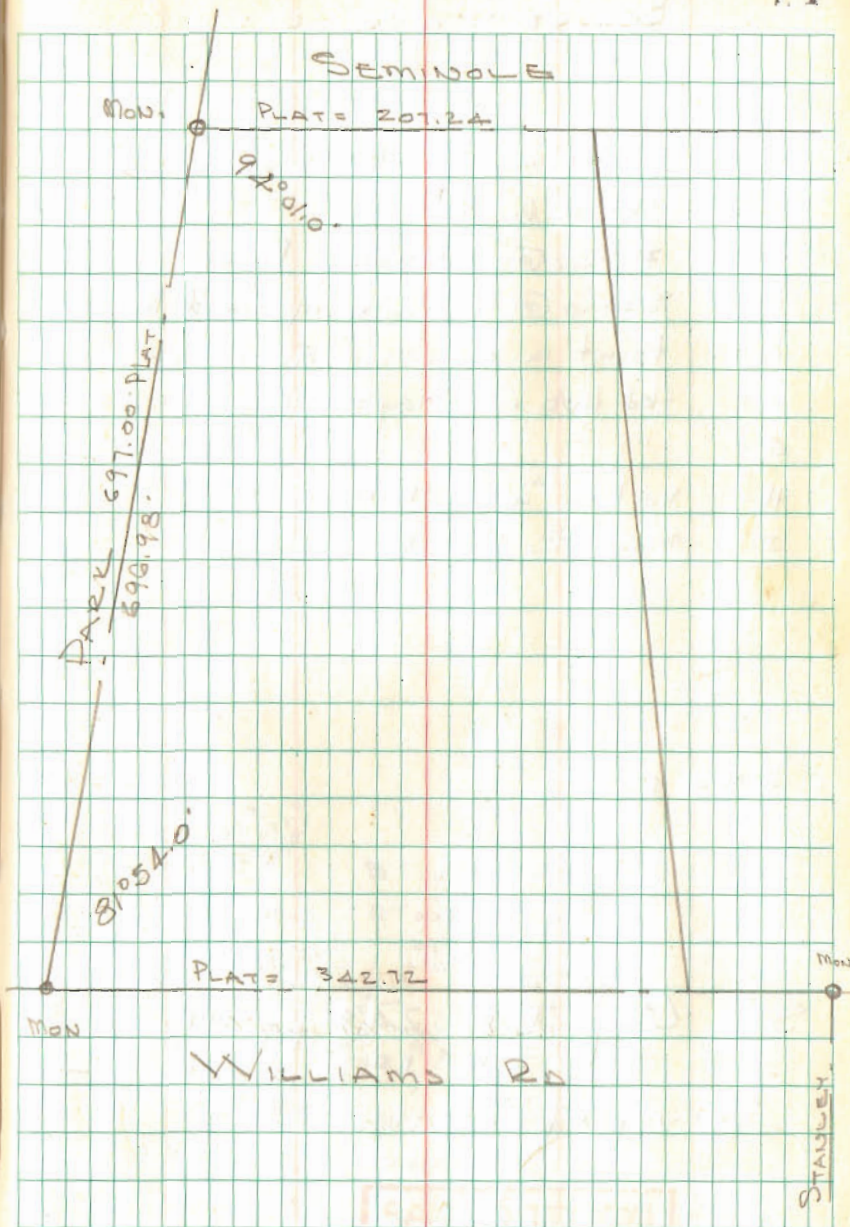

INDEXED ON MAP
3105

3105

WOLF SURVEY
BELLEFONTAINE OHIO


- A = P-K Nail Set & Williams
- B = tkd Hub Set
- C = Fence @ Sidewalk R. wolf-Kinnard
- D = Stone @ Sidewalk opposite R.
- E = Point in old fence Approx. cor.
- F = tkd Hub in Alley - set
- G = " " "
- H = Nail in walk N.W. Cor lot #
- I. moor E. Park & Journals

C to D = 47.7'

See City F.B. 248 pg. 41
" " F.B. 189 pg 52 for
Survey of Stanley Add.

INDEXED ON MAP
5105

9/6/73
70° 25

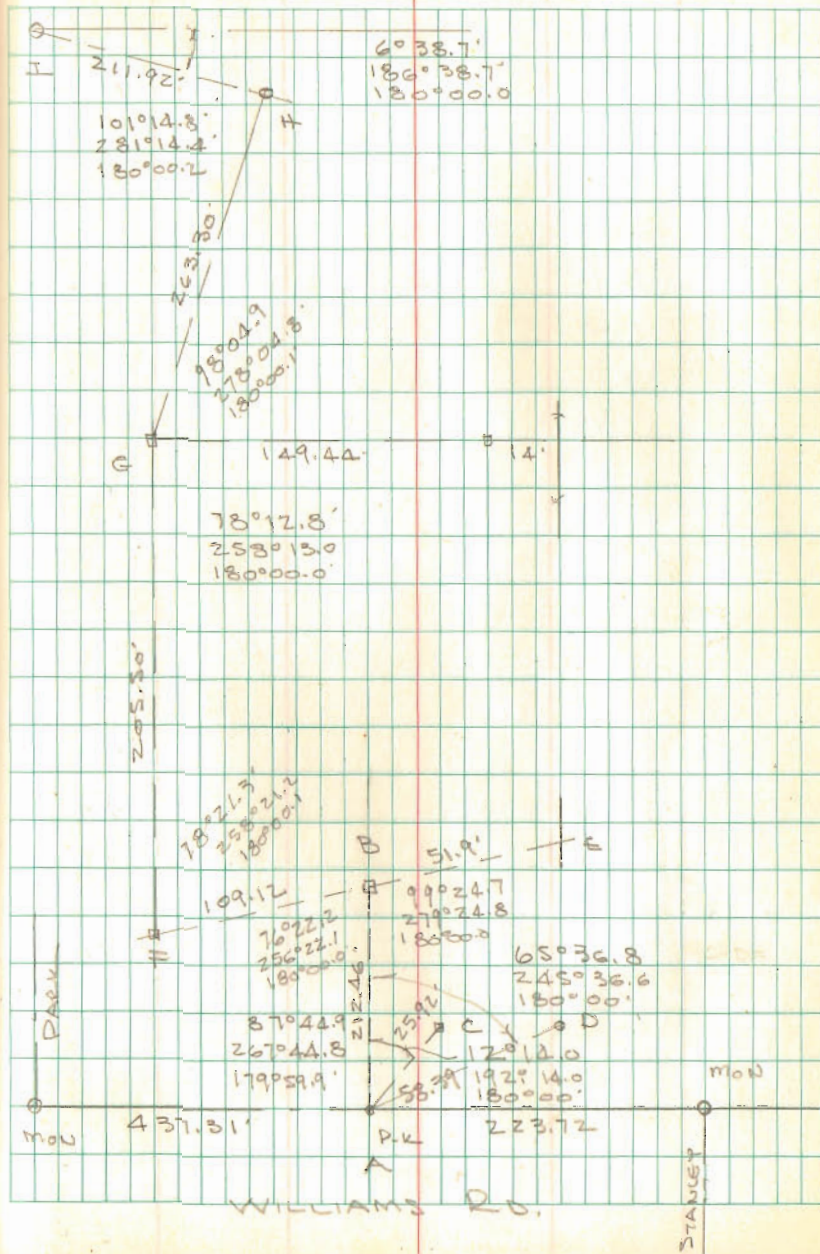

Stiles - Black Hawk
EVA BROWN TRACT

- A = 1" Pipe Found
- B = R.E. Spk Found = "L" BK 1/50
- C = 1/2" Pipe Found "J" " "
- D = P-K Set
- E = 1/2" Pipe Set

Mr. Robt Stiles indicated Point "A" to
be Cor. of Prop. set by State of Ohio

485.0	706.21
	106.30
	69.98
	882.49


Black Hawk Tractor Sales
R.R. 2
Lokaview

INDEXED ON MAP
1984

Dodson
McCurdy

9/29/73

33

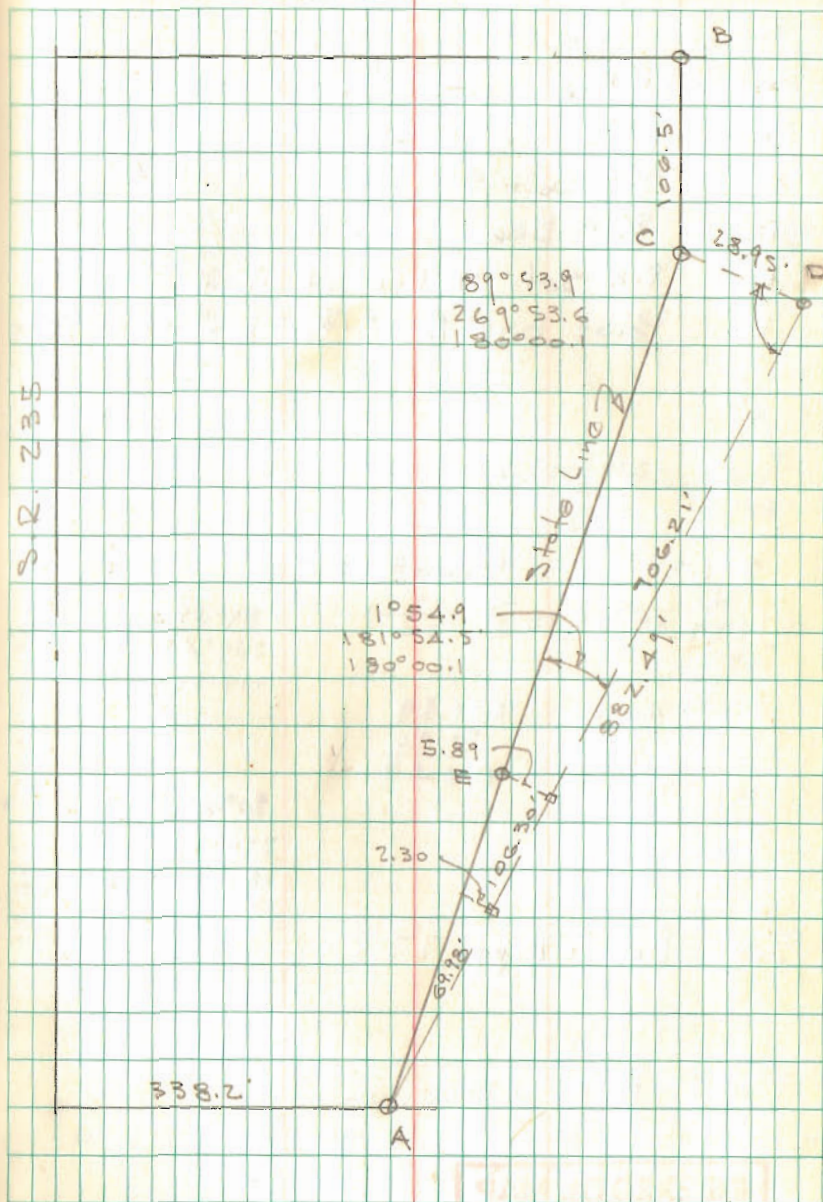

Lot 774-773-772
BELLEFONTAINE

- A = 1" ϕ Bar City Mon
- B = 1" ϕ " " "
- C = 1" ϕ Bolt " "
- D = $\frac{5}{8}$ " ϕ Bar See Bk 15/25
- E = P.K. Set N. line of Alley
- F = Point 0.15' S of $\frac{5}{8}$ " ϕ Bar Bk 15/25

259.29
23
23

272.39	30000	
45	259.48	
227.39	45.48	89°43.0
20	40.52	269°43.1
27		117°59.1
23	46.12	90°49.0
25	227.39	270°49.1
20	90.96	180°00.0
38.36	136.43	
39		


See Bk 17 pg. 77

Pat Wiseman
1115 W. Col.

INDEXED ON MAP
7519

Dodson
Art's

10/16/73
60° 134

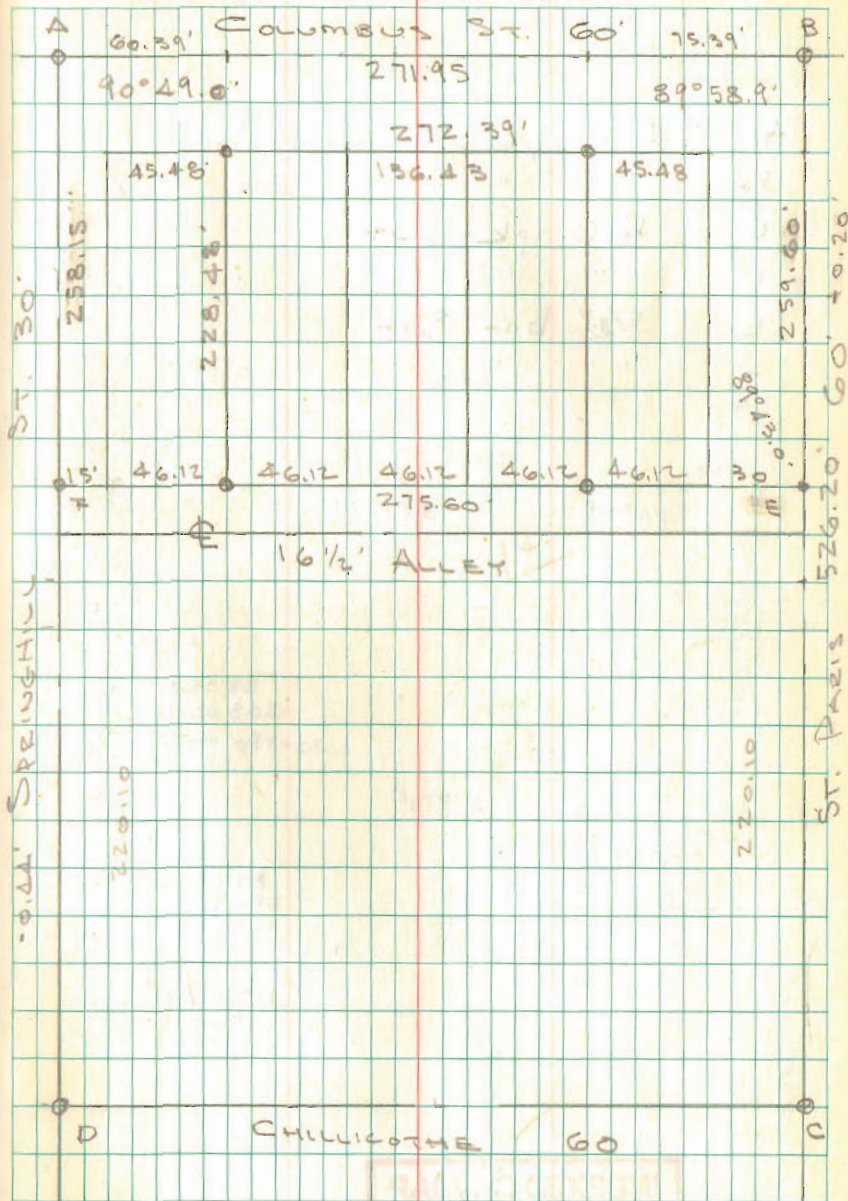

CHILLICOTHE 60

INDEXED ON MAP
7519

WILLIAMS SURVEY
RICHLAND TWP

A = R.R. spk Found
 B = " " "
 C = R.R. spk Set
 D = " " "
 E = 5/8" Bar Set
 F = " " "

88°03.1
 268.02.9
 180°00.1

89°28.2
 269.28.0
 180°00.1

115°05.0
 275.05.1
 179.59.9


INDEXED ON MAP

7088

DODSON
RICHLAND
TWP

10/20/73
65°

35

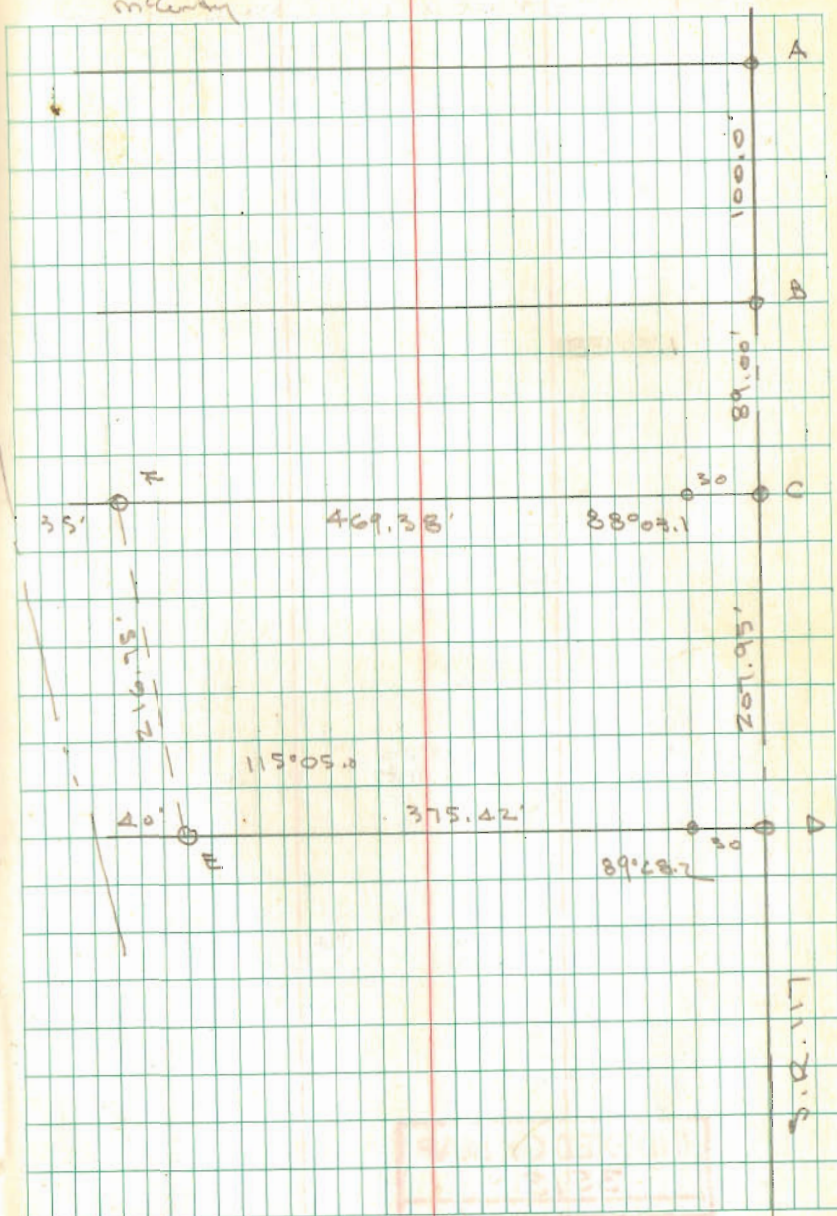


YOUNG SURVEY
 ↓
 JEFFERSON Twp

INDEXED ON MAP
 3513

Dodson

10/20/73

36

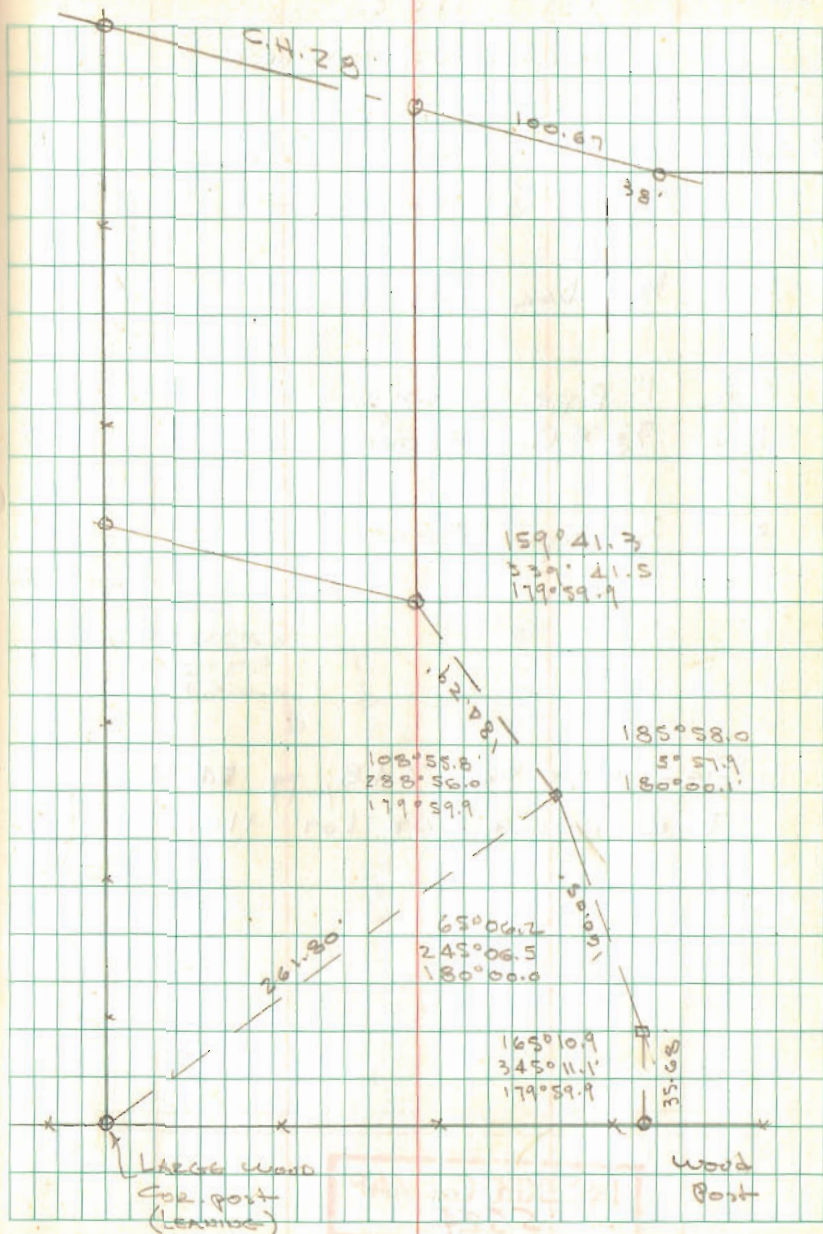

SURVEY OF NORTH LINE
 LOT 1168
 BELL FOUNTAIN

A = Remains of Hub Found
 Set $\frac{5}{8}$ " Bar

B $\frac{5}{8}$ " Bar Set

C = 1" Pipe Found

D = $\frac{5}{8}$ " Bar Found


E = $\frac{1}{2}$ " pipe Found

See City Bk 248, pg 54-55
 For Survey of Lot 1168

INDEXED ON MAP
 5524

Dodson
 Artis
 McCurdy

11/3/73

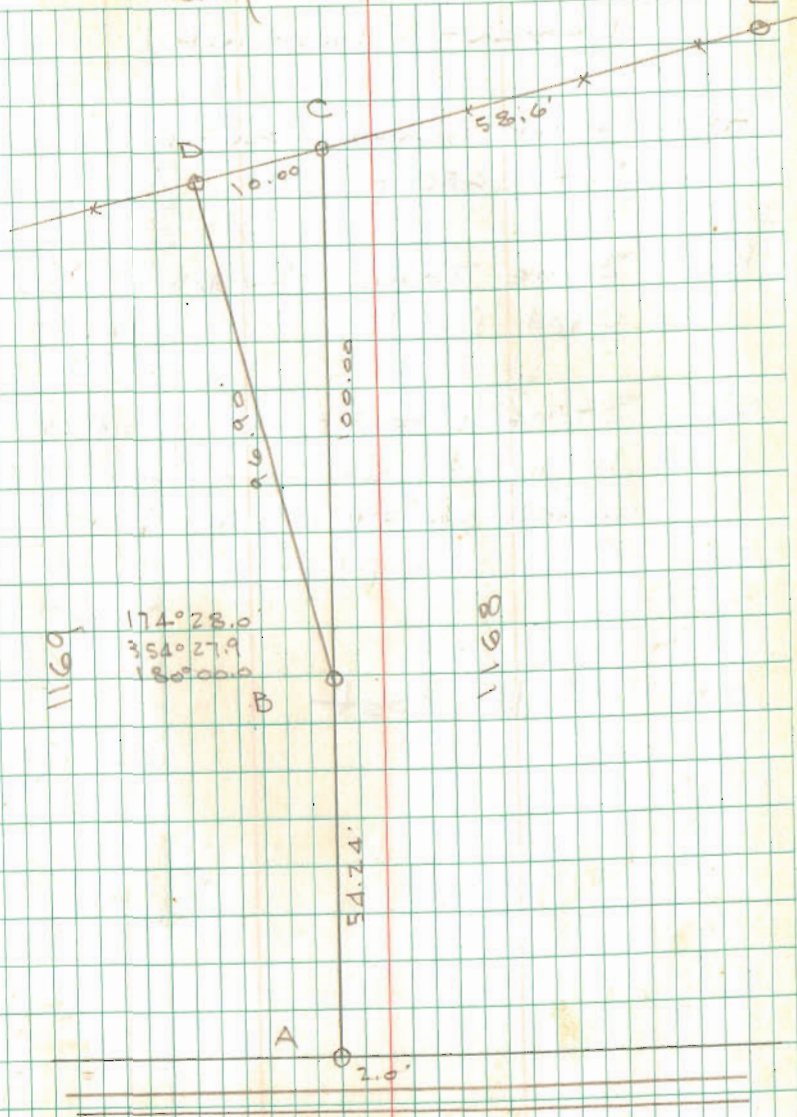

STEINKE SURVEY
 Sec. 3 T-1 R-8
 PLEASANT TWP.

A = 1" Pipe Found $\frac{1}{4}$ Sec Cor
 Sta 71+38 F.B. 559 pg 69

B = Stone Found Sec. Cor.
 Sta. 44+78 F.B. 559 pg 67



C = R.R. Spk Set

D = " " "

E = $\frac{5}{8}$ " ϕ Bal Set

F = " " "

Meas A-B = $2658.42 \div 4 = 664.60$


Meas 664.60 from A & set "C" = N.W. Cor
 of E. $\frac{1}{2}$ of W. $\frac{1}{2}$ of N.E. $\frac{1}{4}$

INDEXED ON MAP
 5396

Dutton
 Actis


11/17/73
 450

39

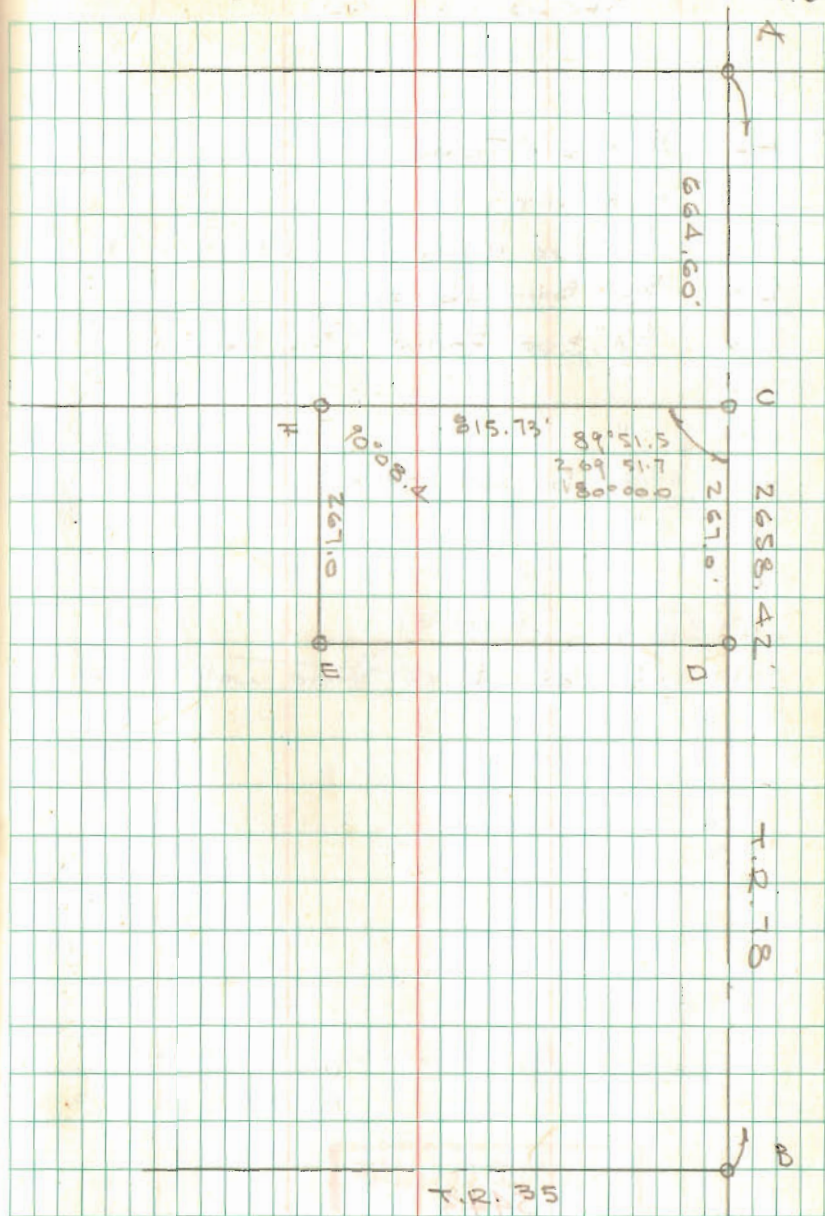

Lot 33
SHAWNEE ISL


- A = 1/2" Pipe Found
- B = Hub Set
- C = 3/4" Pipe w/cap Found 145' S. of B
- D = 5/8" Bar Found
- E = 3/4" Pipe Found 75.0' from C
- F = " " "
- G = " " "
- H = 5/8" Bar set 73.50 from B
- I = " " "
- J = " " "
- K = " " "
- L = " " "
- M = Chiseled + on stone wall

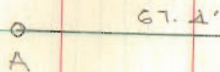

INDEXED ON MAP
5443

Dodson
Artis-McLurey

12/8/73
45° 40

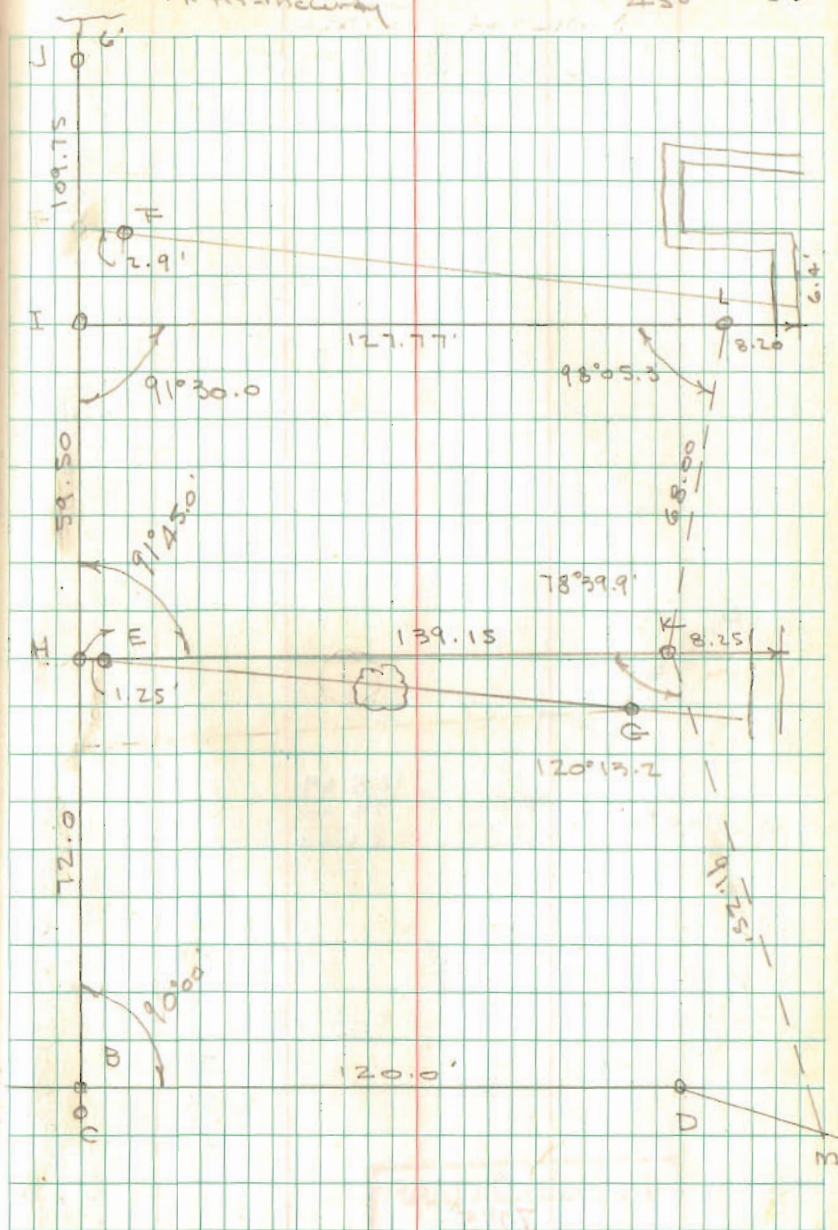

Hewey Survey

179 60
 69 09
 110 51


294.53
 214.01
 80.52

INDEXED ON MAP
 5258

Dodson
 McCurdy

2/16/70

42

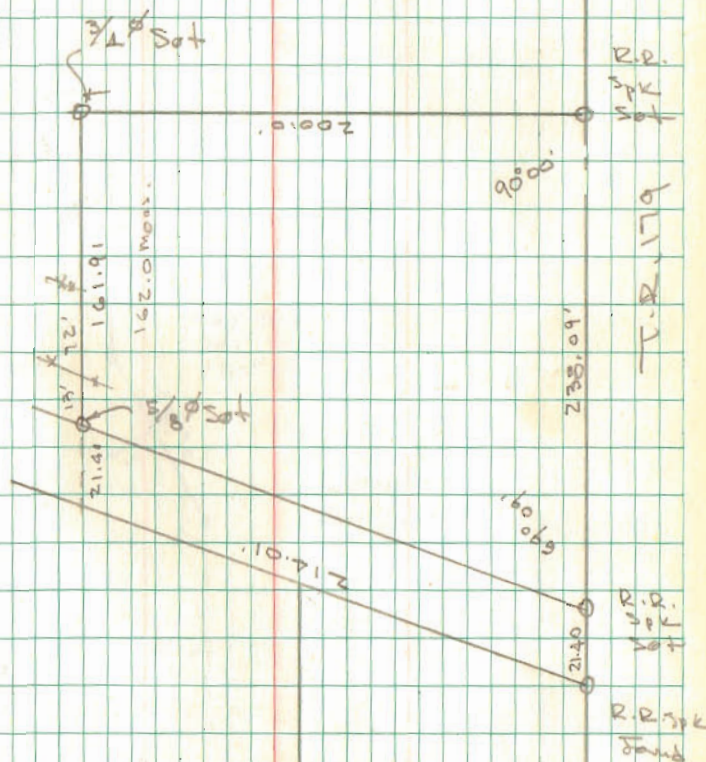


Super Foods

Dodson
Melby


2/23/74

44

INDEXED ON MAP
4951

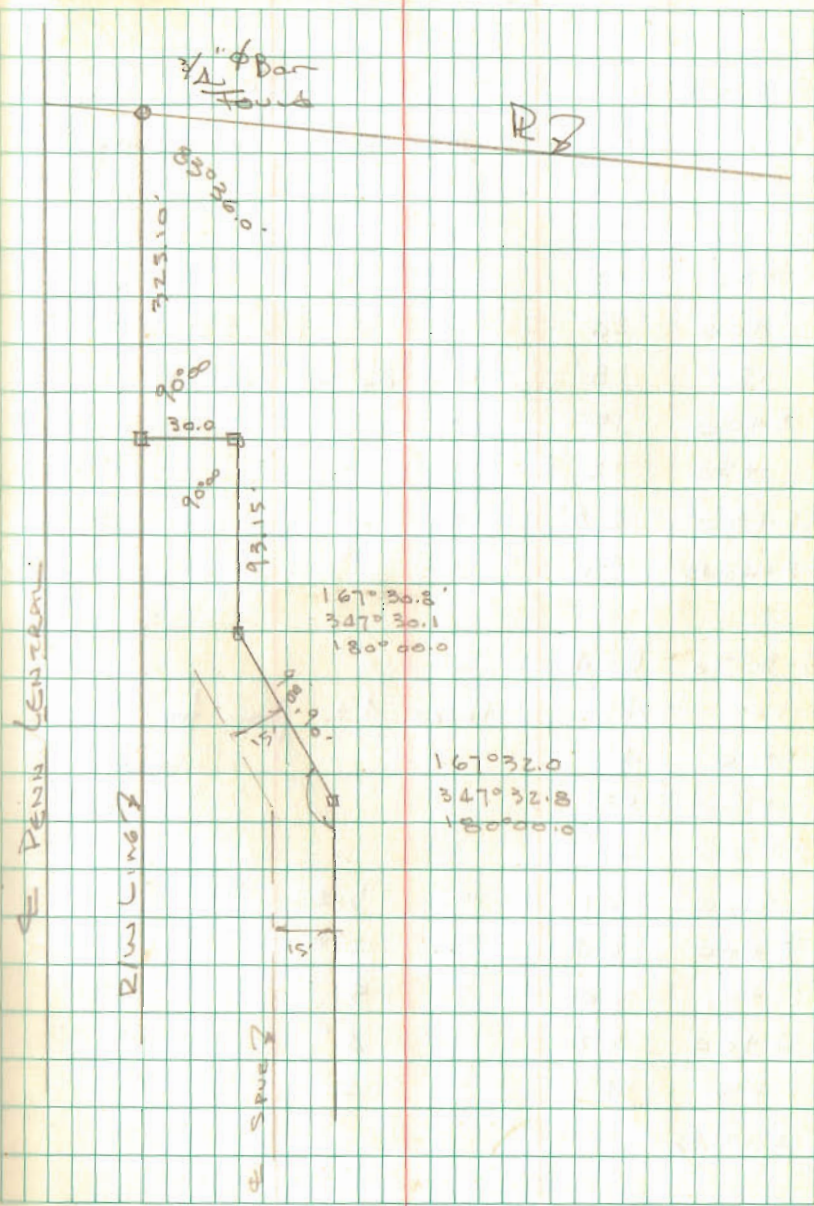


Millisoe Survey
Russells point

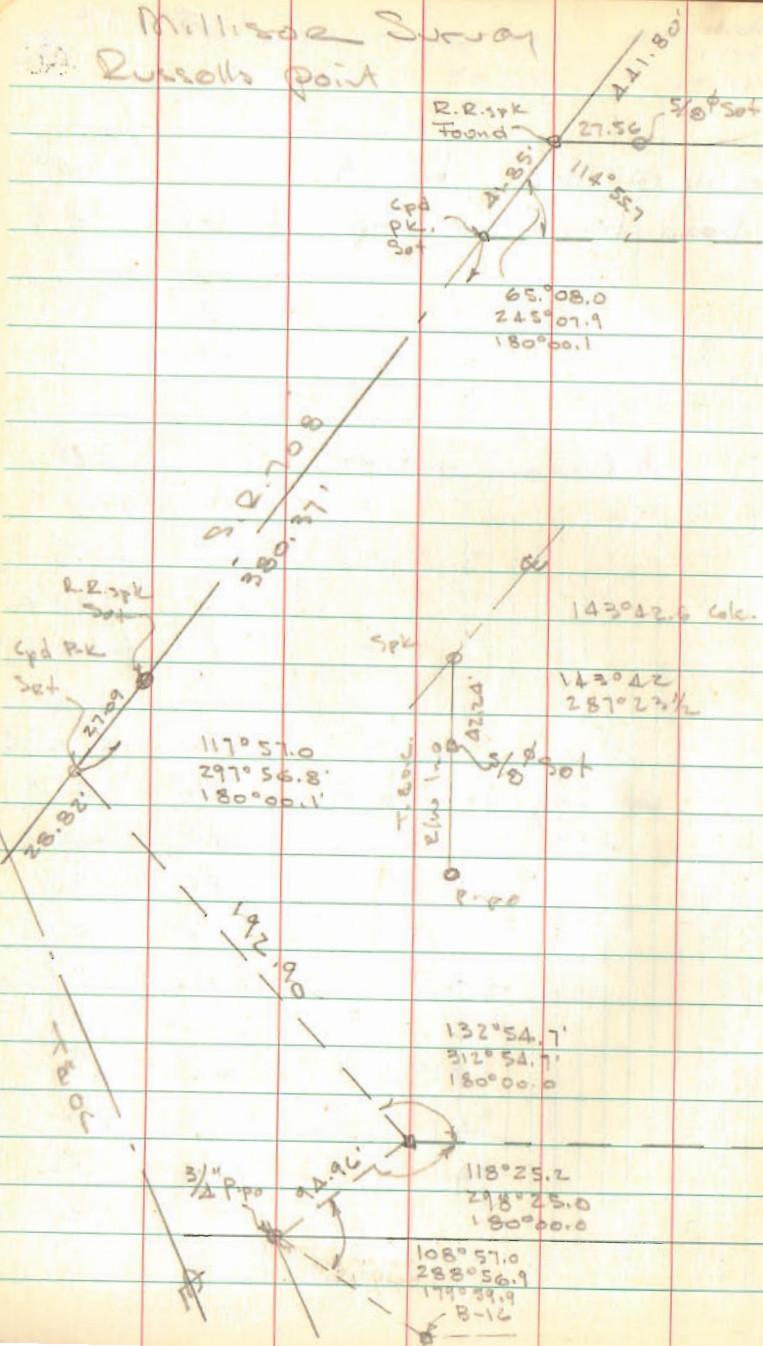

Dodson
Art's
McCurdy

3/2/74


46

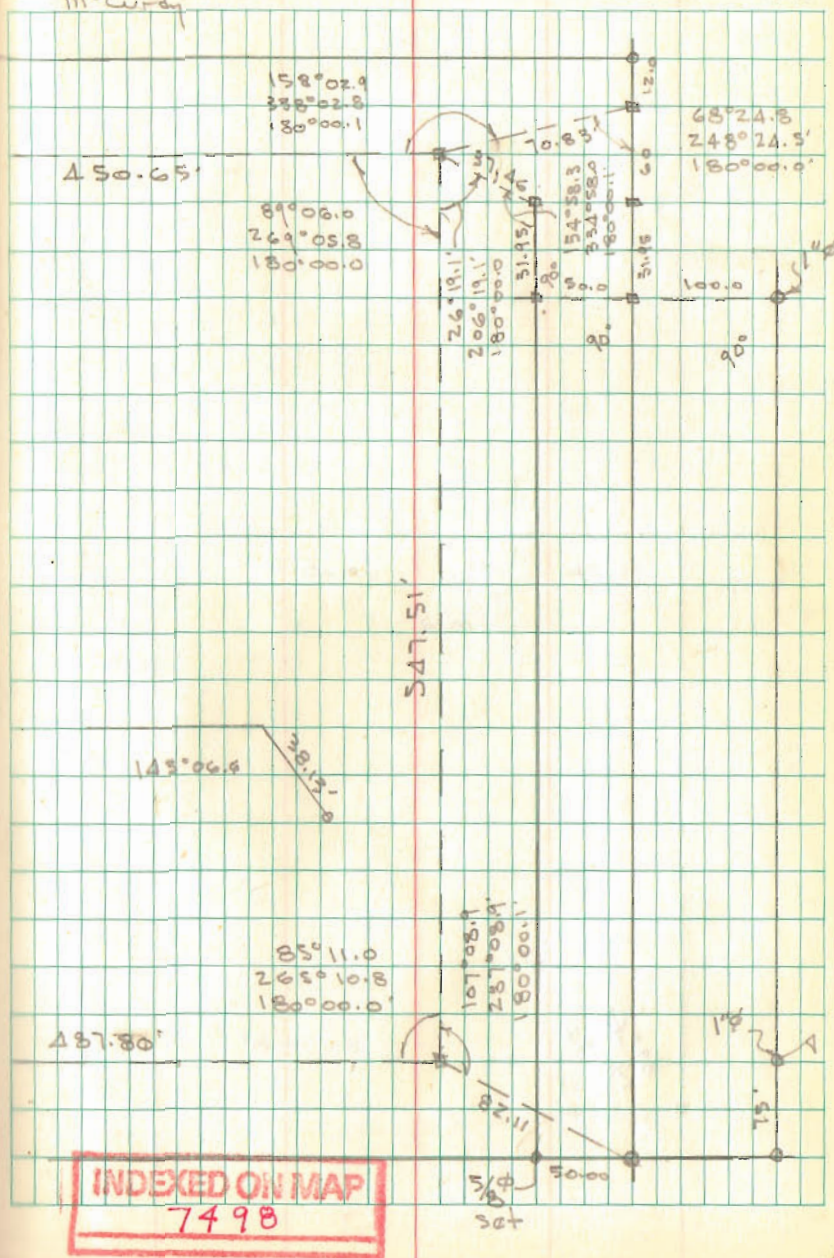

CAMPBELL SURVEY
 Bloom Fig. 0 Two



08	60
33	02.6
54	57.4

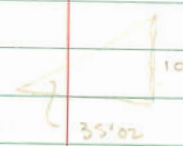


INDEXED ON MAP
 5532

Dutton
 M. Ke Bow
 Dave Campbell

4/4/74

43

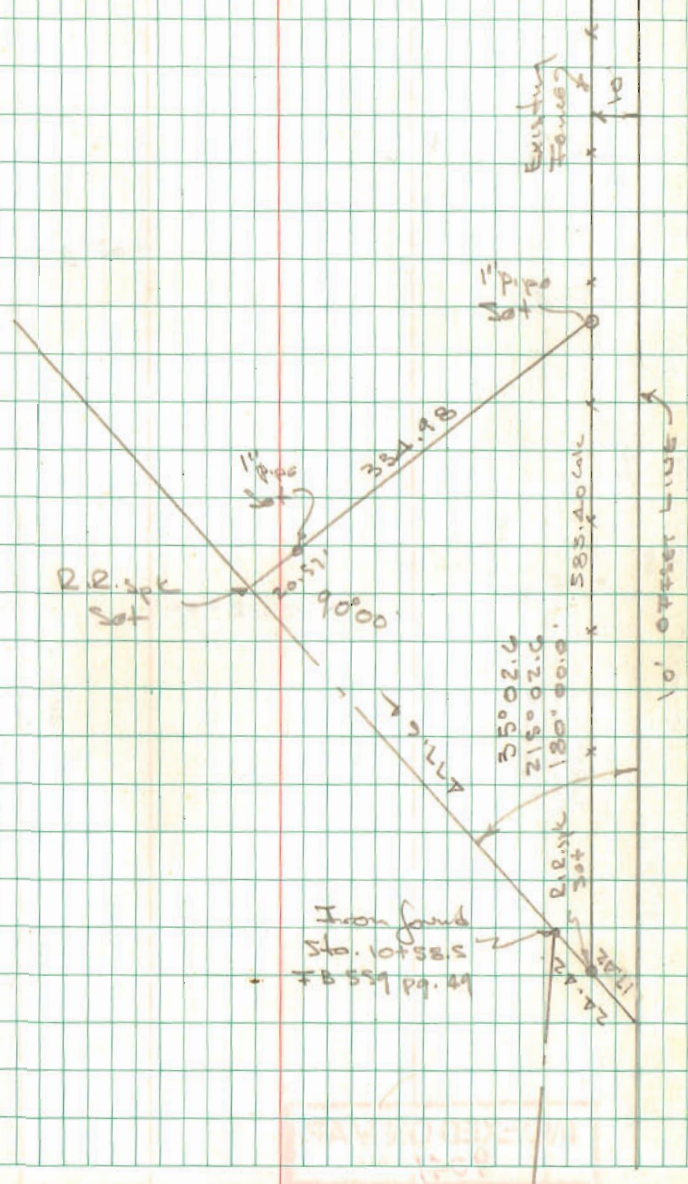

Iron found
 54. 10 + 58.5
 75 559 pg. 49

INDEXED ON MAP
 5532

PART LOT 2
SHAWNEE TR

- A = $\frac{3}{4}$ " pipe found
B = " "
C = $\frac{5}{8}$ " ϕ Bar found
D = 1" ϕ Bar found
E = $\frac{3}{4}$ " pipe found
F = Capped P-K Set in wood
retaining wall
G = $\frac{5}{8}$ " ϕ Bar found


Points A-B-C-D-E OK for line

INDEXED ON MAP
4663

Dodge
Anti
Melway

4/27/74

51

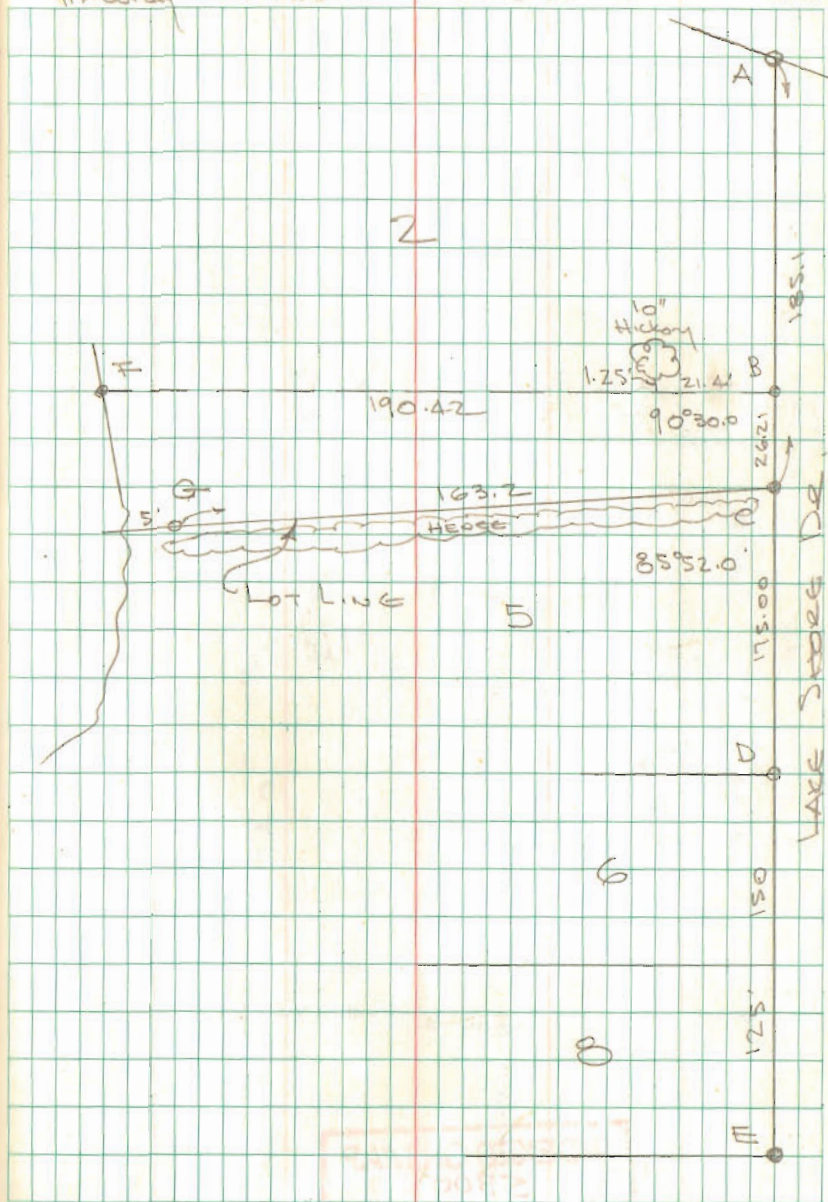

INDEXED ON MAP
4663


KRESS SURVEY
LIBERTY TOWNSHIP

Dodson
Antis
McLugby

5/1/70

52

INDEXED ON MAP
5300

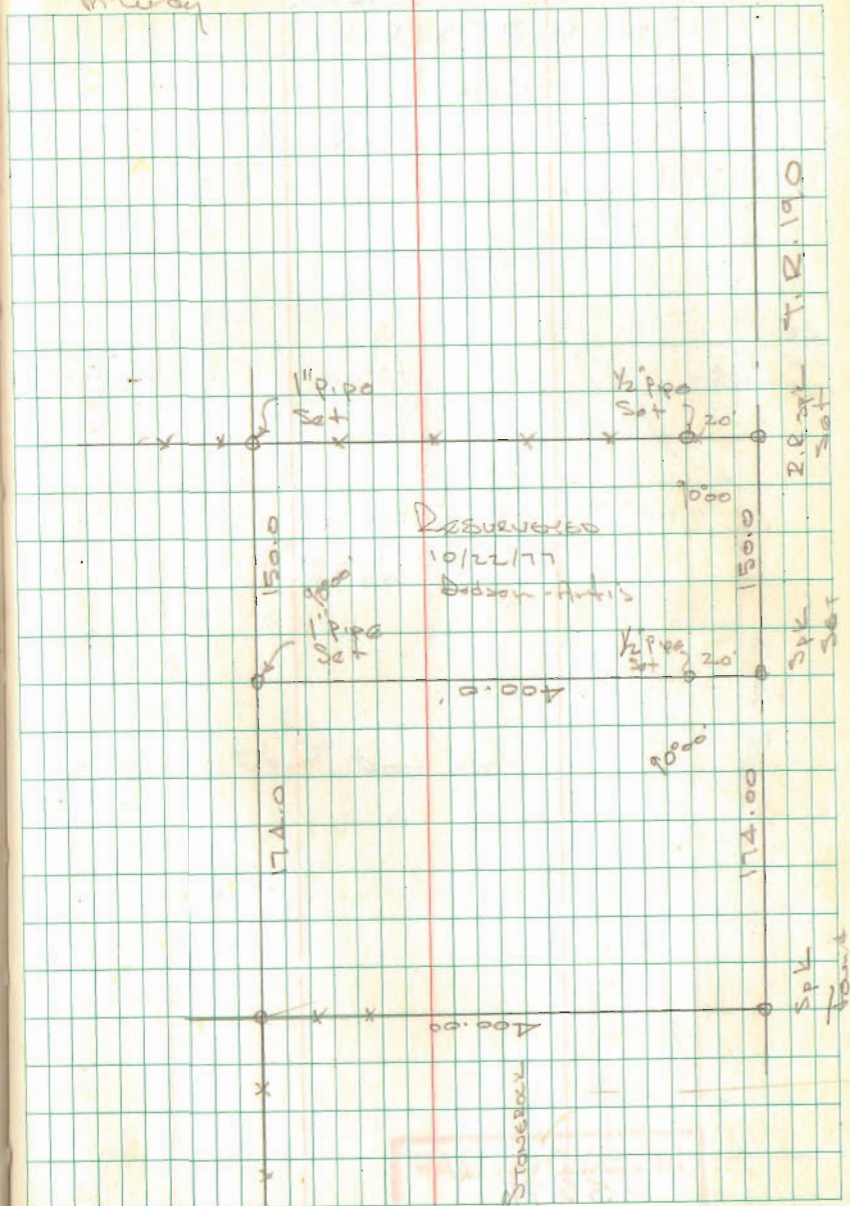

Knife Survey
 Stokes Township
 Sec. 6 T-7S R-8E

Gary Watkins
 R.R.
 Lewistown


179.60
 9.30
 88.30

INDEXED ON MAP
 5671

Dodson
 Artis

5/11/74


53

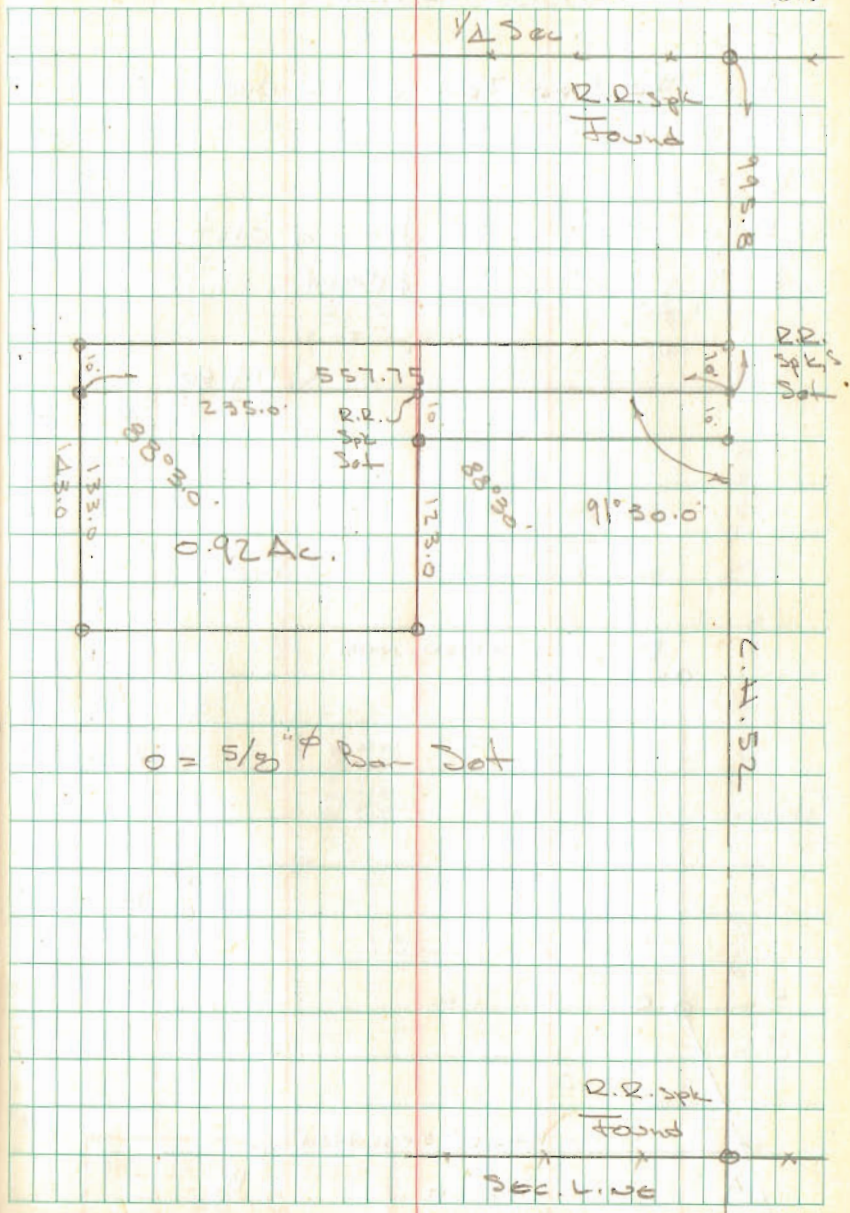

LOTS 101-102
SHAWNEE ILL

A = 3/4" Pipe Found 12' deep
 B = " " "
 C = " " "
 D = " " " Leaning east
 E " " " " Used


179 60
 87 48.8
 92 11.2

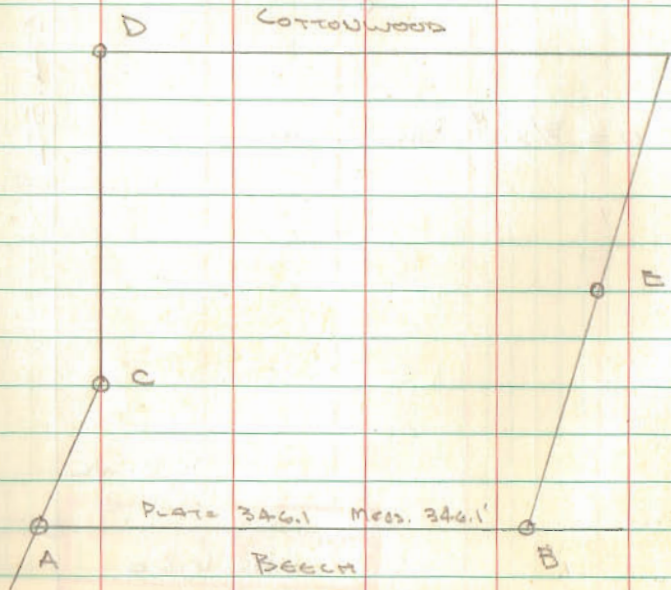

Dodson
Artus

5/11/70

54

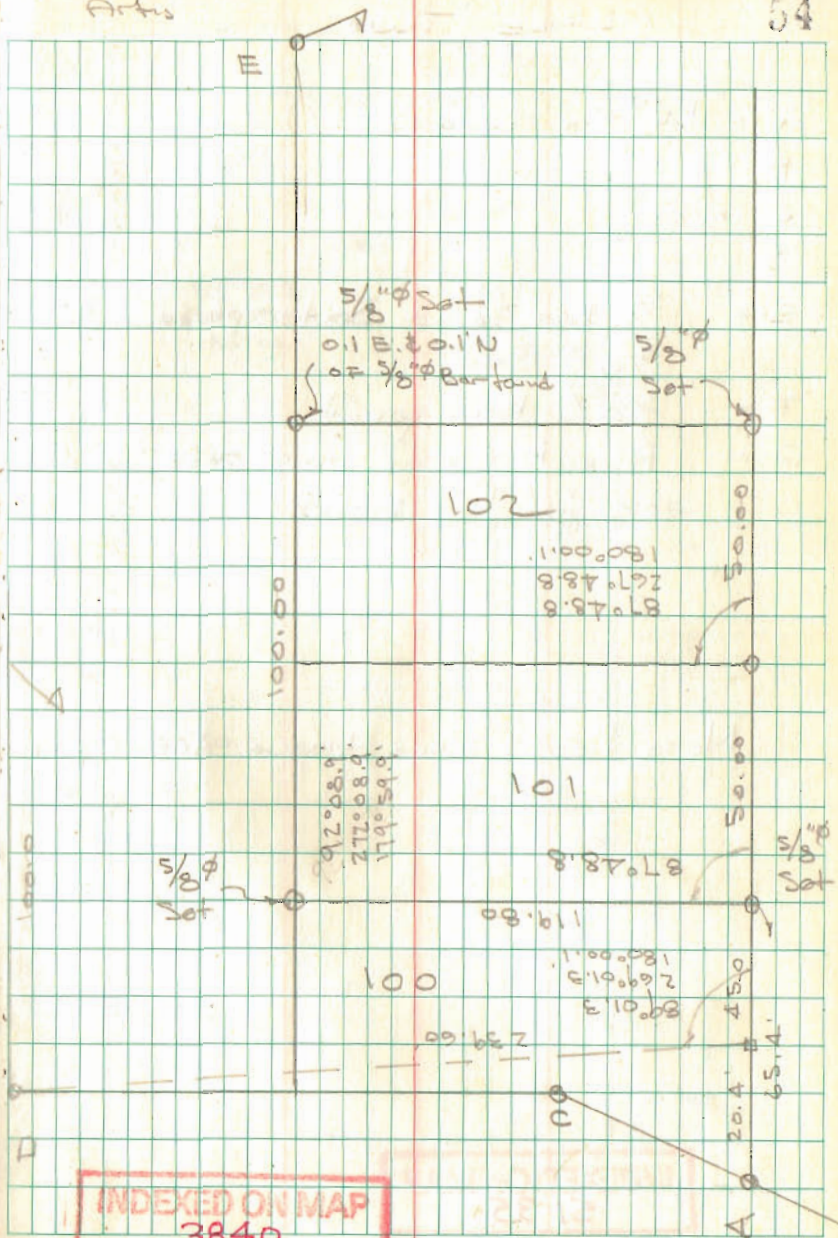

INDEXED ON MAP
3840

PALMER SURVEY
LAKE TWP

- A - 1/4" d Pin Found (Bolt?)
- B - " " "
- C - " " "
- D - " " "
- E - 3/4" pipe Found Bent-replaced with 5/8" ϕ Bar
- F - 5/8" ϕ Bar found
- G - Pipe N. side of wood post found OK for line & dist.


NOTE DEEDS MAKE ANGLE ACE = $89^{\circ}37'$

INDEXED ON MAP
5135

Dodson
Artis
McWardy

5/18/74

55

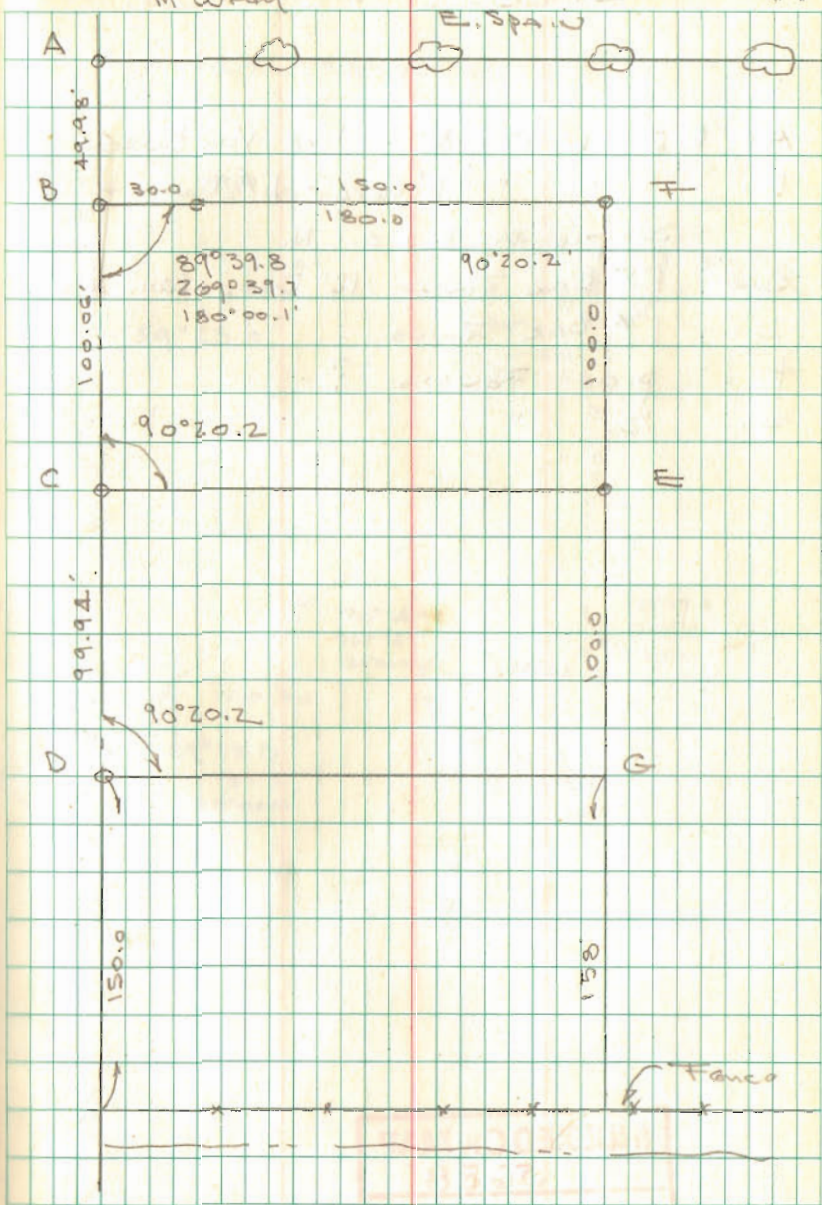

Lot 498
Russell Point

- A = R.R. Spk Found S. line Van Buren St
 B = " " " 3" deep - 1" ϕ Bar at
 Surface 0.1 E & 0.1 N.
 C = 1" ϕ Bar Found 12" Deep - Leaning South
 D = 1" ϕ Bar Found
 E = Pipe Found ?
 F = 1/2" ϕ "


INDEXED ON MAP
5688

Dodson
Antis
McWardy

5/18/74

56

o = P-2 no. 1 set on E

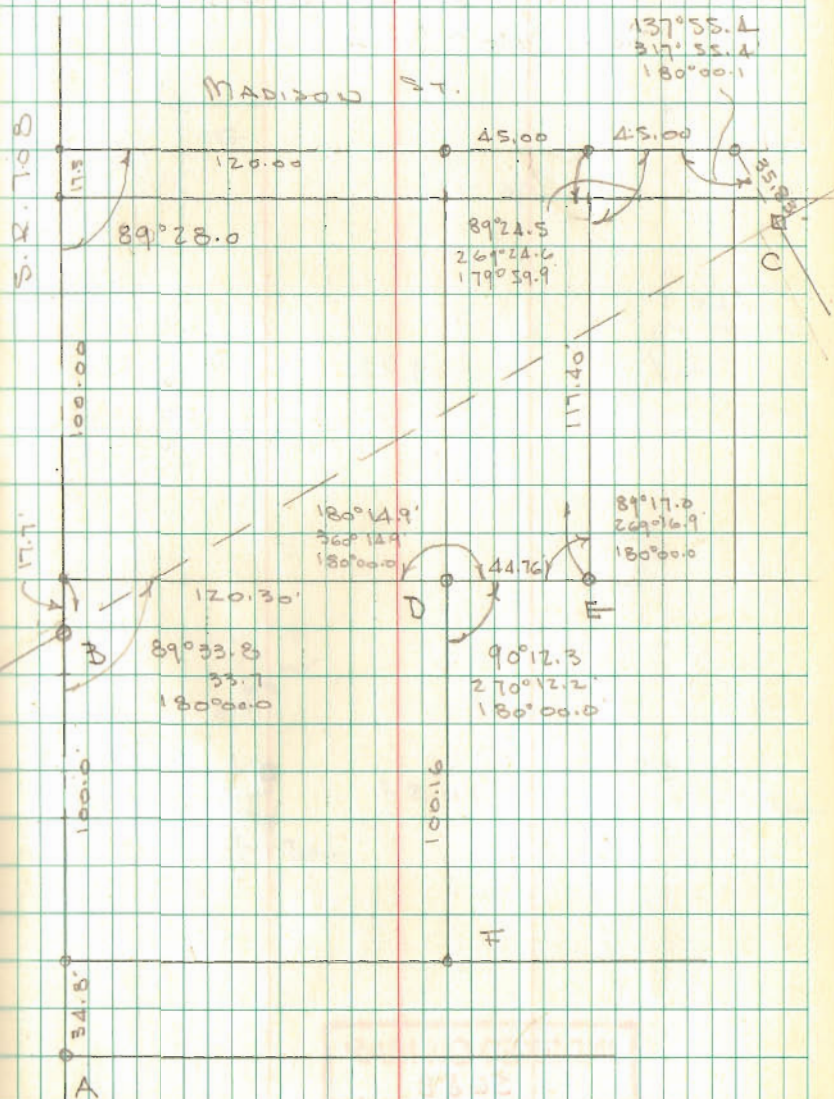

$$11 \times 35 = 385.0$$

$$\begin{array}{r} 17.5 \\ 385.0 \\ \hline 402.5 \end{array}$$

32 lots

1155.3

Blue Jacket

3/4" Pipe
Found

3/4" Pipe
Found

TECUMSEH

BIG BEND

89°53.7
269°53.7
180°00.1

89°53.1
269°53.0
180°00.1

3/4" Pipe
Found

175.30

1/2" pipe
Found 8' deep
Did not use

INDEXED ON MAP
6631


Dodson
Arts
m/wordy

6/1/74

58


682.68

682.68

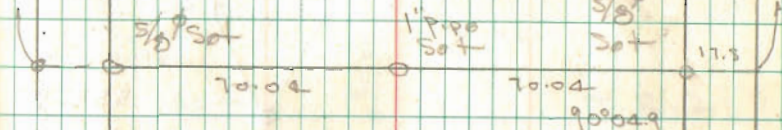

70.02

70.02

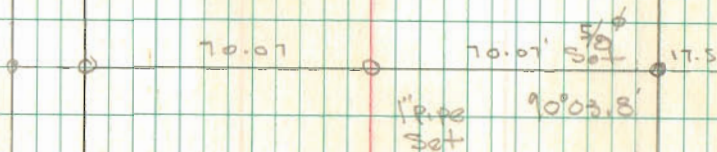

1" Pipe
Set


90°03.8

JACKSON SURVEY
 PLEASANT TWP
 Sec. 6 T-2 R-14

SEE F.B. 555 pg. 7

150.00
 35.07
 14.93

35.07
 30.06

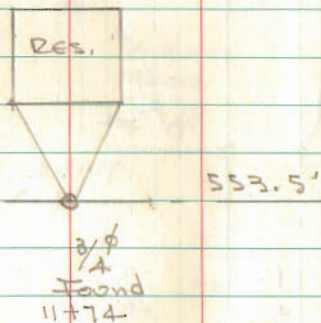


INDEXED ON MAP
 5620

Dutton - Artis
 McCurdy

June 8, 1974

59

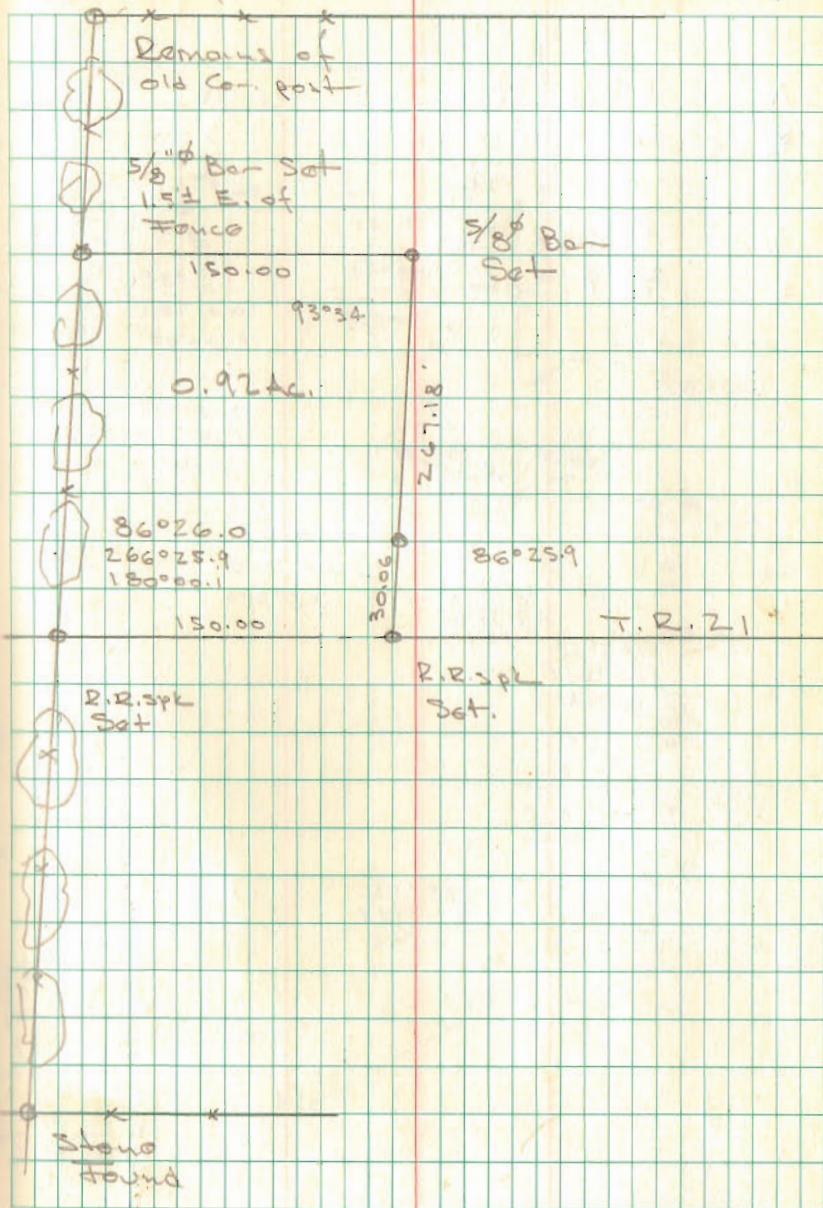


LOT 45
WEST SIDE SUBD No. 1

- A = $\frac{3}{4}$ " Pipe Found 10" deep
 B = " " " 10" deep
 C = Hub Found (old) SET $\frac{5}{8}$ " BAR
 D = " " " " "

Dodson
Artis
McLusky

7/24/74

62

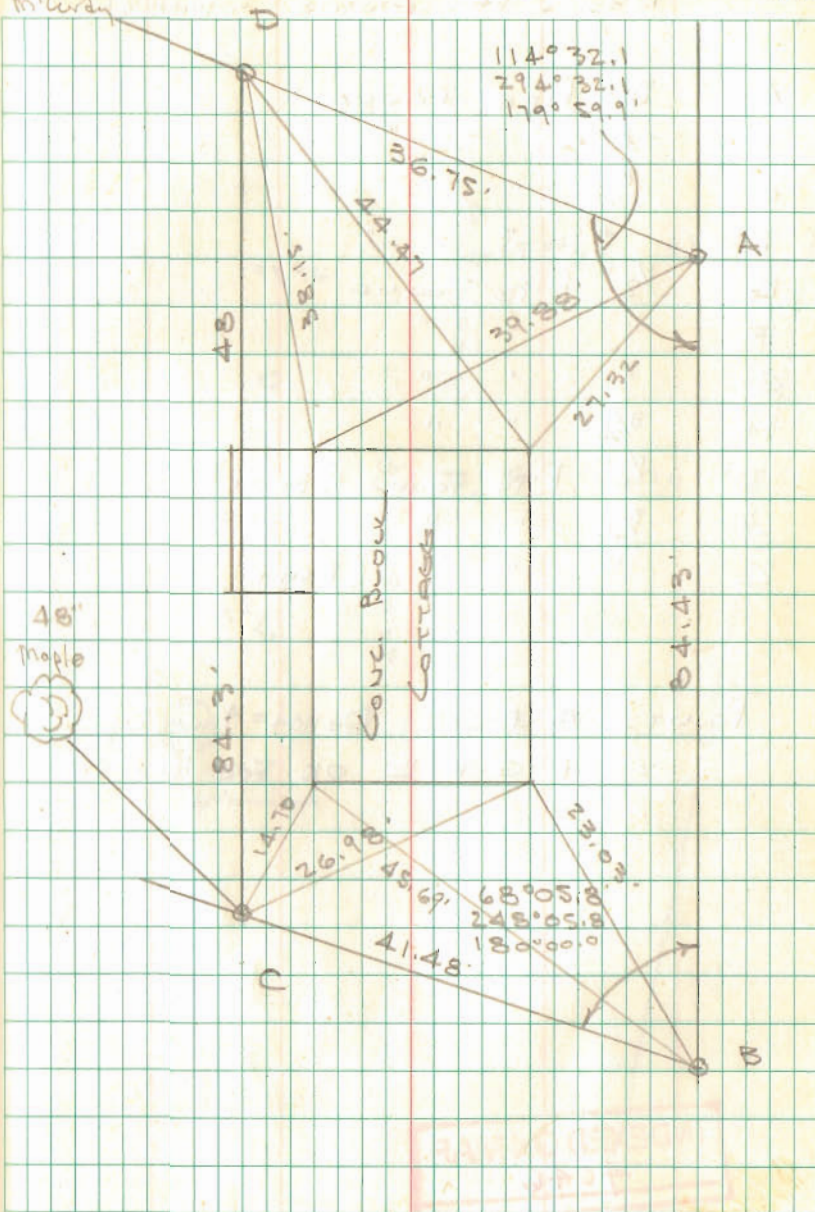

Lot 10-12
BURN HORSESHOE CHANNEL

- A = 3/4" Pipe FOUND
- B = 1/2" " "
- C = 3/4" " "
- D = " " "
- E = 1/2" PIPE FOUND
- F = " " "
- G = " " "
- H = 3/4" " "
- I = 1/2" PIPE FOUND (BENT)
- J = 3/4" " "
- K = " " " (BENT)


Points A-B-C-D Do not line up
H-G-F-E OK for line

INDEXED ON MAP
4046

Dodson
Art's
McLury


8/3/74

64

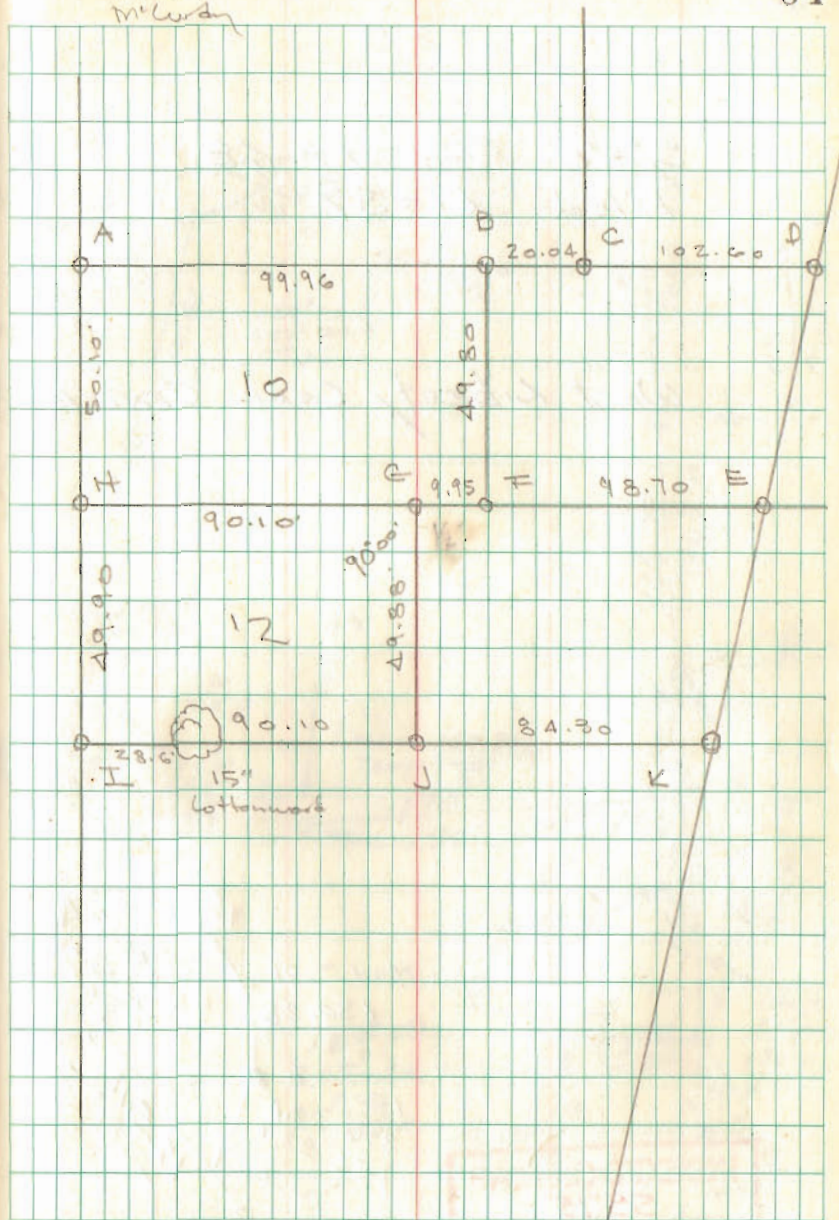

STATE PLAN RT 68
FILED L-37


WEST LIBERTY CARE CENTER

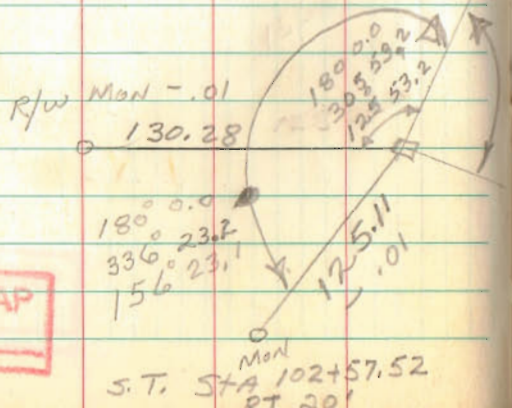

INDEXED ON MAP
5575

7.5 hrs Aug. 10, 74
3.5 hrs Aug 12

Artis McCurdy

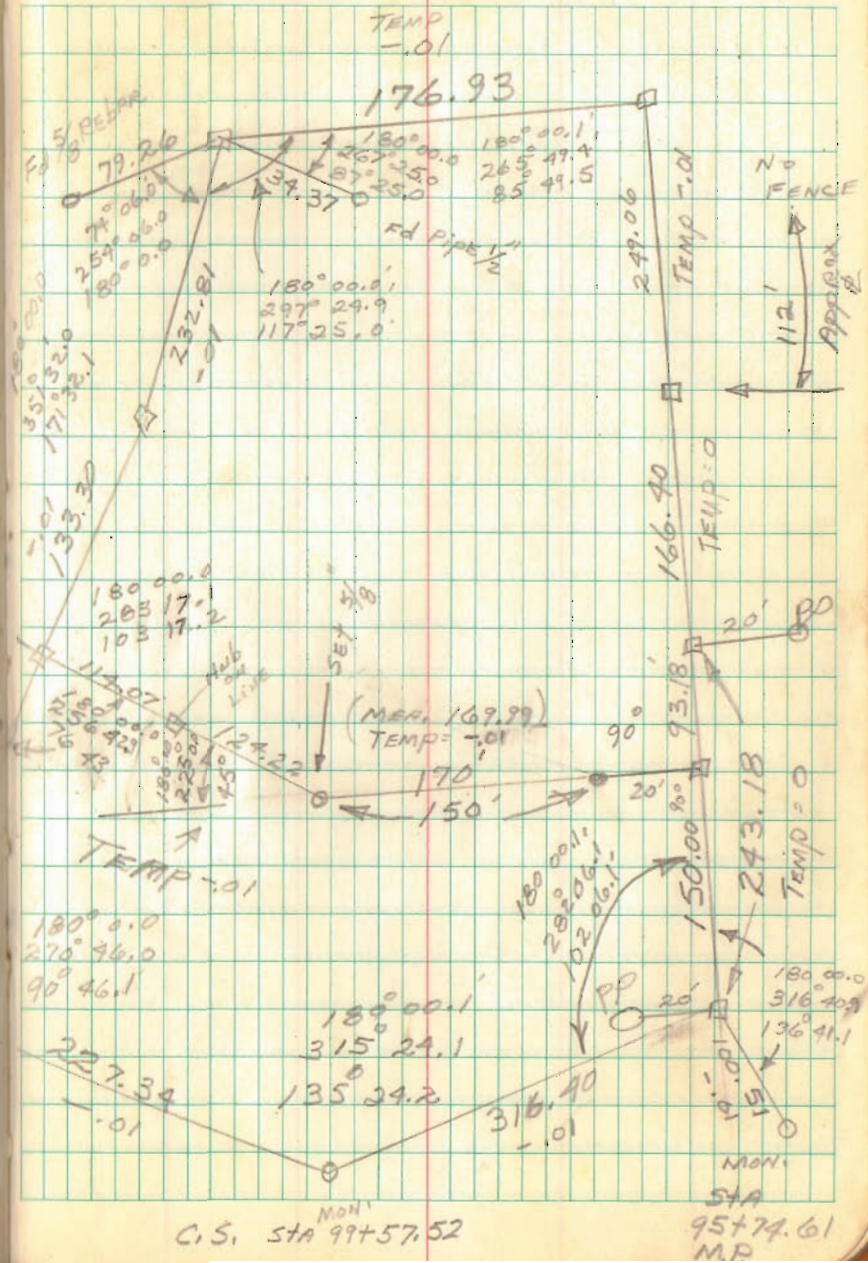

POWELL SURVEY
HYLAND PLAZA
BELL FOUNTAIN


- A = P.K. Found for J. Boyd
 B = " " " D. AIRCRAFT
 C = R.R. spike set
 D = Date Nail 28 set
 E = 5/8" Bar set
 F = R.R. spike set
 G = " " "
 H = 5/8" Bar set

	+	HT	-	Elev
F	6.02			100.00
G			6.88	
PUMT			5.07	@ 43 1/2'
H			6.37	
C			4.99	
D			4.61	
E			6.24	
PUMT			4.30	@ 44'
F			6.04	
A-B	Mean	381.83		


INDEXED ON MAP
5725

Dodson
Area
MCCORMY

8/31/74
Coal
Rms 70

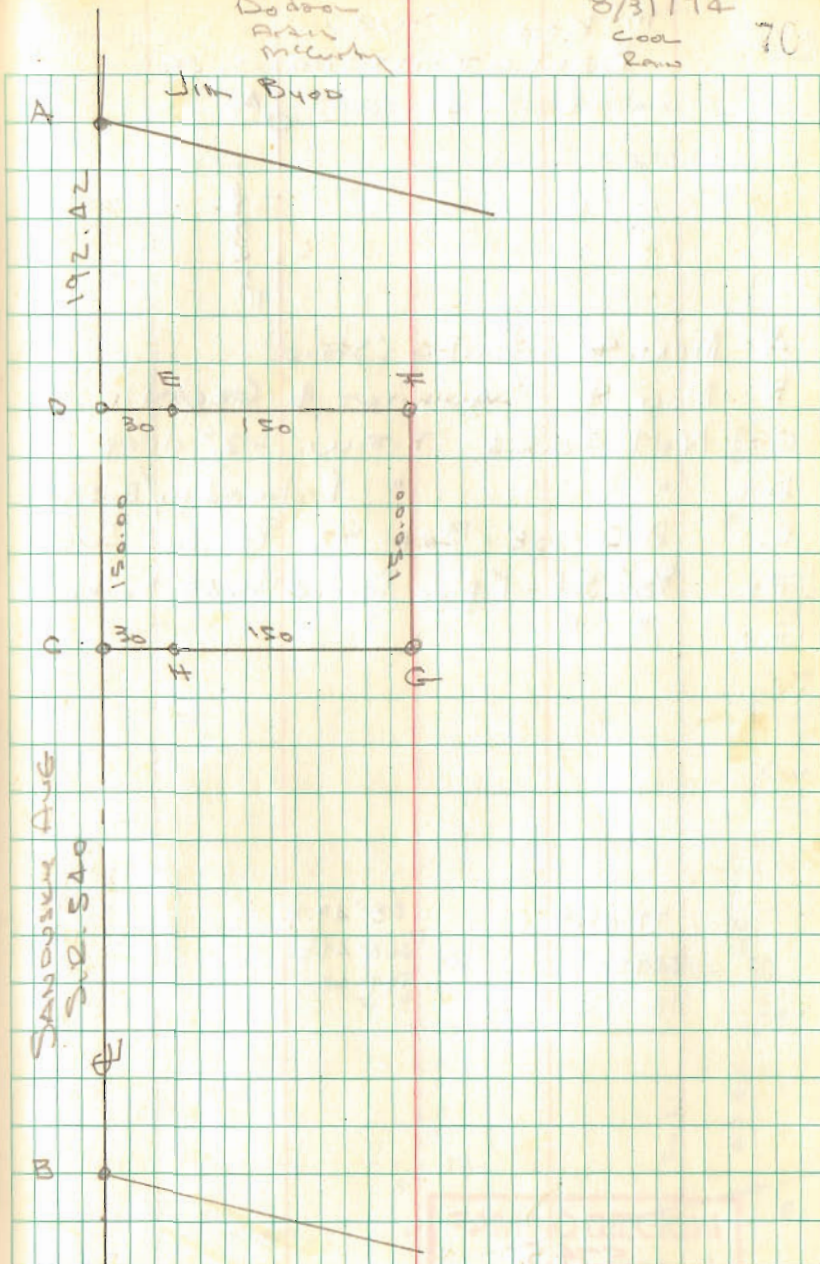

McKee Survey
Bellefontaine, O.

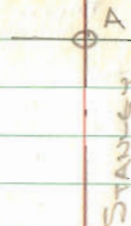

- A = Mon. & Stanley (stone)
- B = Mon & Sandusky & Green
- C = Nail Found F.F.W. - 2" deep
- D = " " " Replaced w/ R.R. spike
- E = R.R. spike Set & Possum Run
- F = 5/8" Set - 1" pipe found 0.15' South
- G = " "

77°05.3
267°05.0
180°00.0

88°49.3
268°49.0
199°59.9

179 60
88 49.1
91 10.9

INDEXED ON MAP
5745

Dodson
Art's
McCurdy

9/8/74

72

SANDUSKY AVE 60

88°49.1

