

INDEX

Index	1
"	2
Road. 186 Union Twp	3
" " " "	4
Sewers West Liberty A To B	5
" " " B To G	6
" " " B To H	7
" " " I To H	8
" " "	9
	10
	11
	12
	13
	14
	15
	16
	17
	18
	19
Road. 39 M <sup>r</sup> Arthur Twp.	20
" " " "	21
" " " "	22
" " " "	23

INDEX

Road. 39 M <sup>o</sup> Arthur Twp	24
" " " "	25
" " " "	26
	27
	28
Check levels #37	29
"	30
"	31
"	32
"	33
"	34
Check levels #37	35
	36
	37
	38
	39
	40
	41
	42
	43
	44
	45
	46

## INDEX

47

48

Road 186

Union, Twp.

Section 1 Town 3 Range 14

30' Road, Road Record

No. 1 Page 283-307-312

Stated for 40' Road.

L. Moor

x x 17.57 x

Chas H. Buller

A. Michall

90°-30'

Road 187

stone  
see Book 451  
page 59

1770


INDEXED ON MAP

Feb. 1-1937  
Cold,  
F. Wright  
G. Wilgus  
G. Pusey

Road 186

Length 2731 Feet  
 Length Miles  
 Length Miles

2-1-37

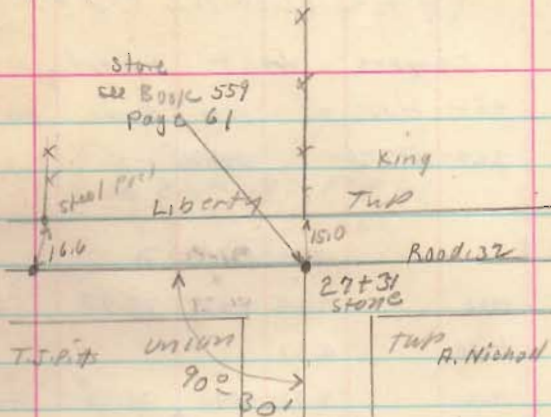

1970

INDEXED ON MAP

Road 39  
M<sup>s</sup> Arthur Twp

42' Anstine Pike - 1890

60' Commissioners Journal Vol. 5 Page 24-80  
1836

stakes placed on Tedrick and Weiser  
for fence 60'-30' from E

Hub set for monuments  
June, 1952 at 50'

2+00 RT only

1776

INDEXED ON MAP

R/W Post  
187+00  
S&P Plan  
L-27 Page 7

R/W Post  
182+00  
S&P Plan  
L-27  
Page 6

To Huntville

S. H. 130

Hubset 32

May - 4 - 1937  
Raing  
F. Wright  
G. Pusy  
G. Wilgr

Stone  
1+55  
No Angle

Road 39


653.00

252.10

24' = 03'

Survey  
Line 21

Cherokee Mans Run

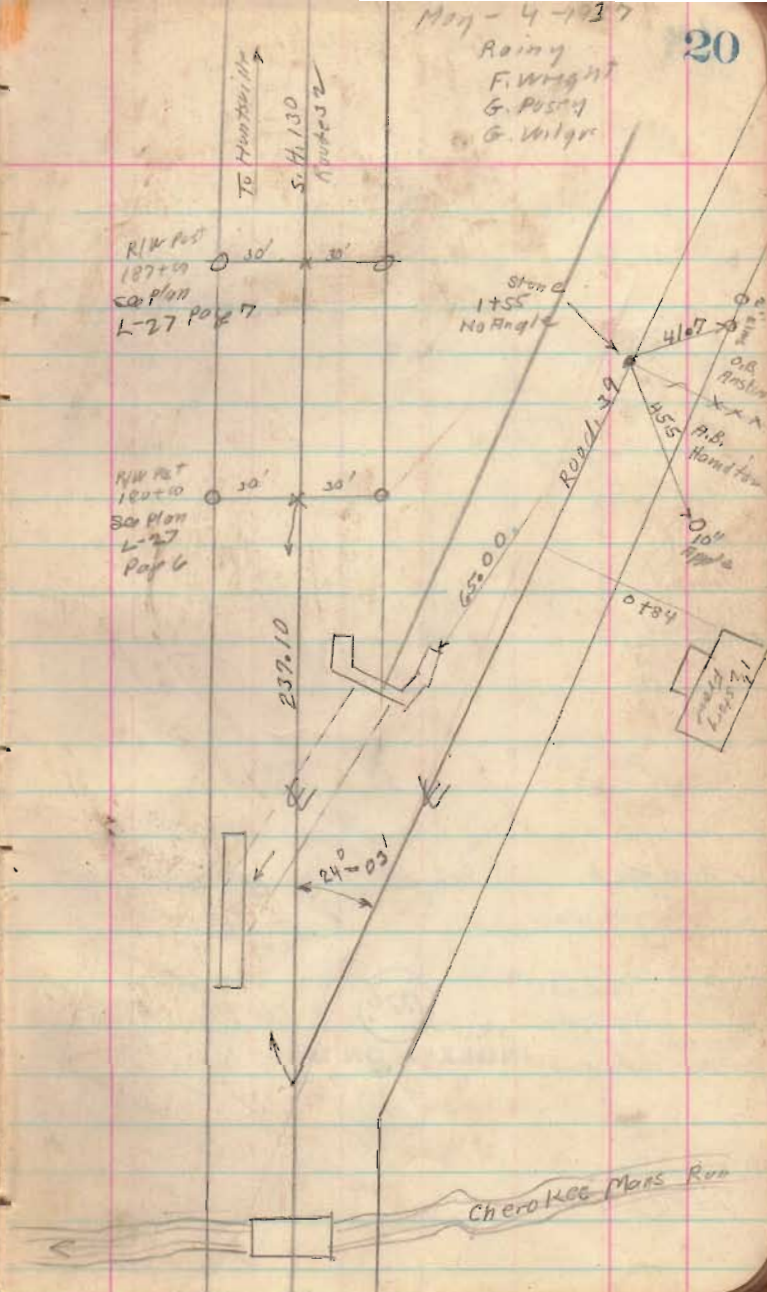

Road 39

$$\begin{array}{r} 23+23 \\ 19+12 \\ \hline 981 \end{array}$$

23+23

18+01

13+32


Set 90° from Foresight

1776

INDEXED ON MAP

7+00

5-4-37

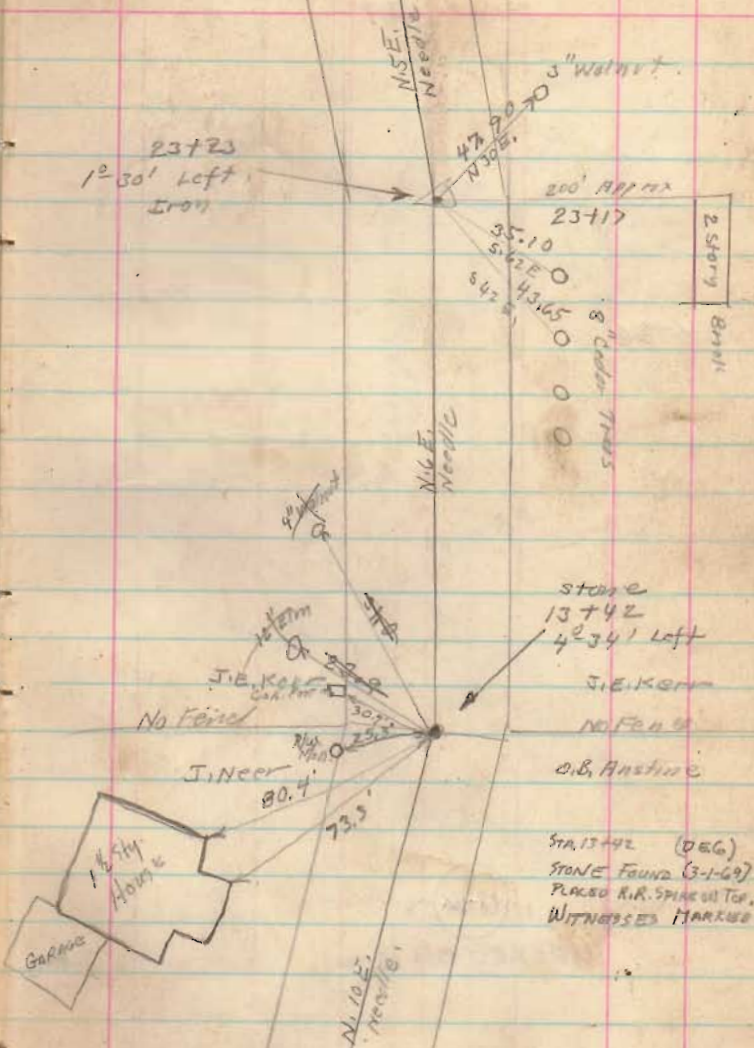

Road 39

4423

3494

929


34+06

28+06

1976

INDEXED ON MAP

May - 5-1937  
cloudy  
F. Wright  
& P. Peck  
& Wilgus

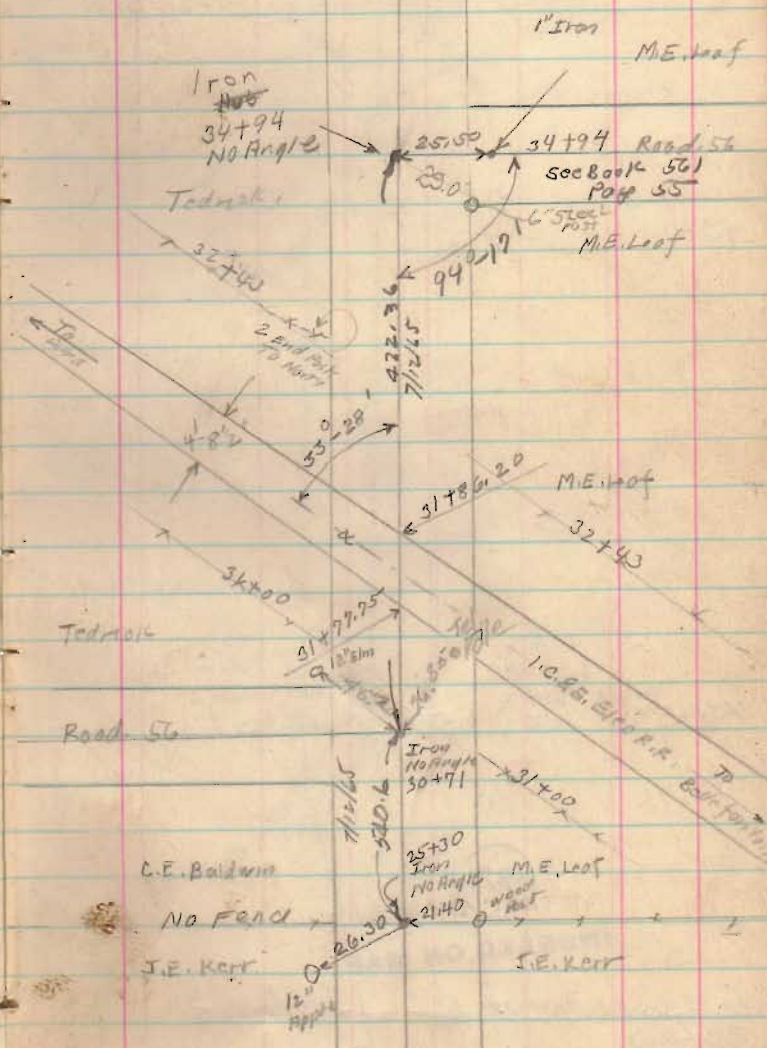



Road 39

49+00

$$\begin{array}{r} 44+23 \\ 10-12 \\ \hline 54-35 \end{array}$$

44+23


at 50.2<sup>ft</sup> Bisecting L

(1776)

INDEXED ON MAP

$$\begin{array}{r} 40+30 \\ 39+00 \end{array}$$

1" # bar set 7/12/65

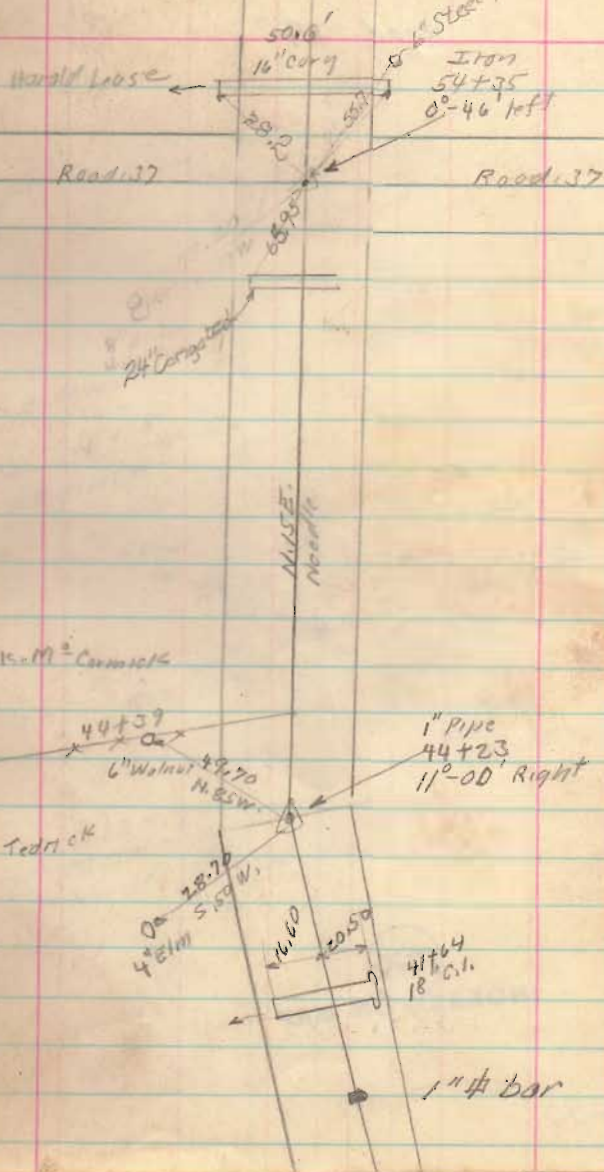

Road 39

72+00

$$\begin{array}{r} 66+48.5 \\ 9+03 \\ \hline 75+51.5 \end{array}$$

66+48.5

61+00

1774

INDEXED ON MAP

56+00

C.H. Shapp

68+48

W.H. Weis

6' ELM

54.20  
N 45 W

12' ELM 66.4

58.5 W

W.H. Weis

63+83

Harold Hase

E. Demary

66+48.5

K.B. Tedrick


66+48.5  
Iron  
NO Angle

Road. 39

77+56

1776

INDEXED ON MAP

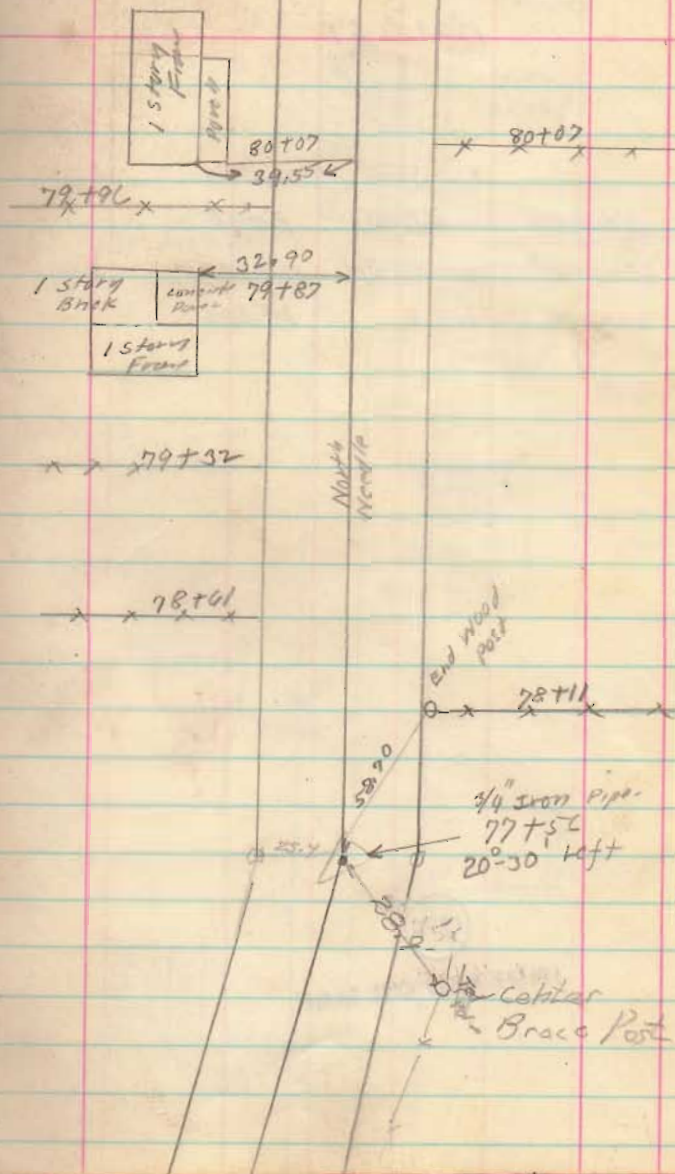

Road 39

Length 8569 Feet  
 Length 1.622916 Miles  
 Length 1.62 Miles

1776

INDEXED ON MAP

CHEROKEE

1 story  
Frame  
Porch80+63  
39+551 story  
Frame32+50  
83+66x x x x  
84+291 story  
Brick41+10  
81+45Cement  
Pillar

02+10

83+98

1 story  
Framex x x x  
83+665/8"  $\phi$  FO  
REPLACED w/ 1"  $\phi$   
8/17/72  
LHGRoad 22  
State Route 274  
(See Book 598 Page 37)Pump  
Q2100

180°

281

Road 22  
State Route 274  
(See Book 559 Page 55)Road 39  
see Book 579  
Page 10

7066.5

1107  
85+69Road 22  
See Book 579  
Page 11 and 63

stone

7045  
70901 1/2 story  
Brick

5-5-37