

INDEX

| | | |
|----------------------|-------------------|----|
| INDEX | | 1 |
| " | | 2 |
| " | | 3 |
| | | 4 |
| MAGOON SURVEY | W. PATTERSON AVE. | 5 |
| " | " " " | 6 |
| Orchard Isl. | Lot 374 to 378 | 7 |
| Mrs. Praters | Section 35 | 8 |
| | | 9 |
| Johnson Survey | Survey 4570 | 10 |
| " | " + 3828 | 11 |
| O'Connor Survey | Survey 9947 | 12 |
| Rogers Survey | " 3448 | 13 |
| Bishop Survey | " 4953 | 14 |
| The Ohio Edison Co | Sec 36 T6R8 | 15 |
| Shoats Survey | Survey 3327 | 16 |
| Wm Falk survey | Survey 3693 | 17 |
| S. S. SMUCKER SURVEY | BELLEFONTAINE | 18 |
| " " " " | " " | 19 |
| BALLINGER SURVEY | PERRY TWP. | 20 |
| PIATT SURVEY | MONROE TWP. | 21 |
| Beatley Survey | Russels Point. | 22 |
| "B." Miller Survey | Wash. Twp. | 23 |
| Park Survey | Lake Twp. | 24 |

INDEX

| | | |
|-------------------------------|-----------------------|----|
| Park Survey | Lake Twp. | 25 |
| " | " | 26 |
| " | " | 27 |
| Wynn Survey | Lot 1558 N. Main St. | 28 |
| " | " | 29 |
| | | 30 |
| BURNS SURVEY (PLEASANT TWP) | | 31 |
| " | " | 32 |
| Lakeside Allotment | | 33 |
| " | " | 34 |
| | | 35 |
| ZANESFIELD LIBRARY LOT | | 36 |
| WISH SURVEY (LAKE TWP.) | | 37 |
| POIK SURVEY | ZANESFIELD | 38 |
| " | " | 39 |
| Park Survey | Lake Twp. | 40 |
| M ^{rs} Kenzie Survey | Harrison Twp. | 41 |
| Lilly White Oil Co. | Everett St. | 42 |
| " | " | 43 |
| " | " | 44 |
| " | " | 45 |
| Lot 2376 + 2377 | | 46 |
| Lot 2376 + 2377 | W. Col. Bellefontaine | 47 |
| Lumba Lisby | W. Col. Bellefontaine | 48 |

INDEX

| | |
|---|----|
| Lilly White Oil Co. Everett St. | 49 |
| " " " " " " | 50 |
| " " " " " " | 51 |
| Cora Deer Patterson St Bellefontaine | 52 |
| Surrey State Line Sta 921+997 to Sta 960+925 | 53 |
| | 54 |
| Bishop Surrey Lot 1534 N. Detroit St. | 55 |
| " " " " " " | 56 |
| Guy Surrey Lot 2178 ³ / ₄ 2177 Spring St. | 57 |
| " " " " " " | 58 |
| Lot #4 Camp Russell | 59 |
| Snyder Surrey Patterson Ave. | 60 |

566

INDEXED ON MAP

Magoon Survey Lot # 283

W. Patterson Ave. Bellefontaine

- A = Monument with corner
- B = " " "
- C = " " "
- D = " " "
- E = " " "

AB Measured by Wright 527.3

AB Plat Book 526.5

Excess 0.8

DE Measured by Wright 526.0

DE Plat Book 526.5

Short 0.5

AD Measured by Wright 736.5

AD Plat Book 736.5

This makes the North and South measurements O.K.

The East and West measurements would be only about as short for the E of Patterson Ave. for the entire block

(see Next Page)


Date 17, 1925

cloudy

Wright

E. Smucker

5

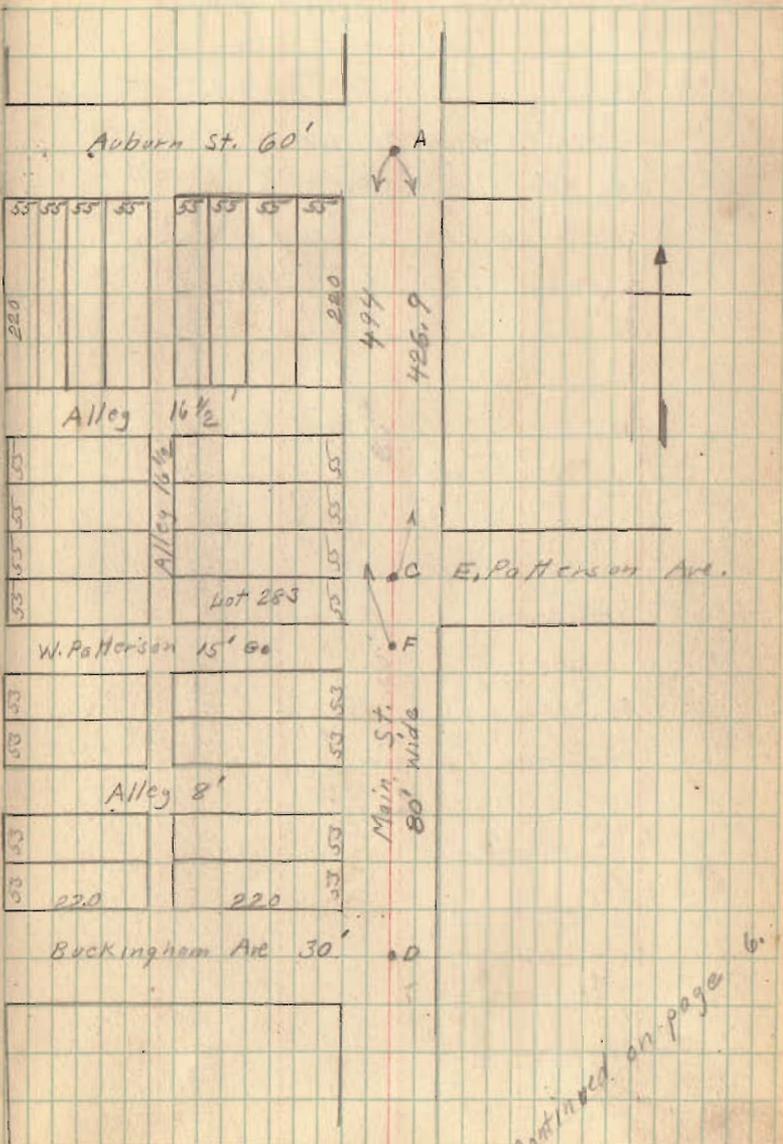

Continued on page 6.

Magoon Survey (Continued)

See Page 5 for location of lot # 283 which is shown on page 6.


Few stakes were placed as shown. Note the walk is North of lot line. Stakes were placed at edge of walk as shown.

The crease in the front edge of the front concrete porch was taken as center of house.


F. & G. were not held.
temporary points only.

10-17-25

6

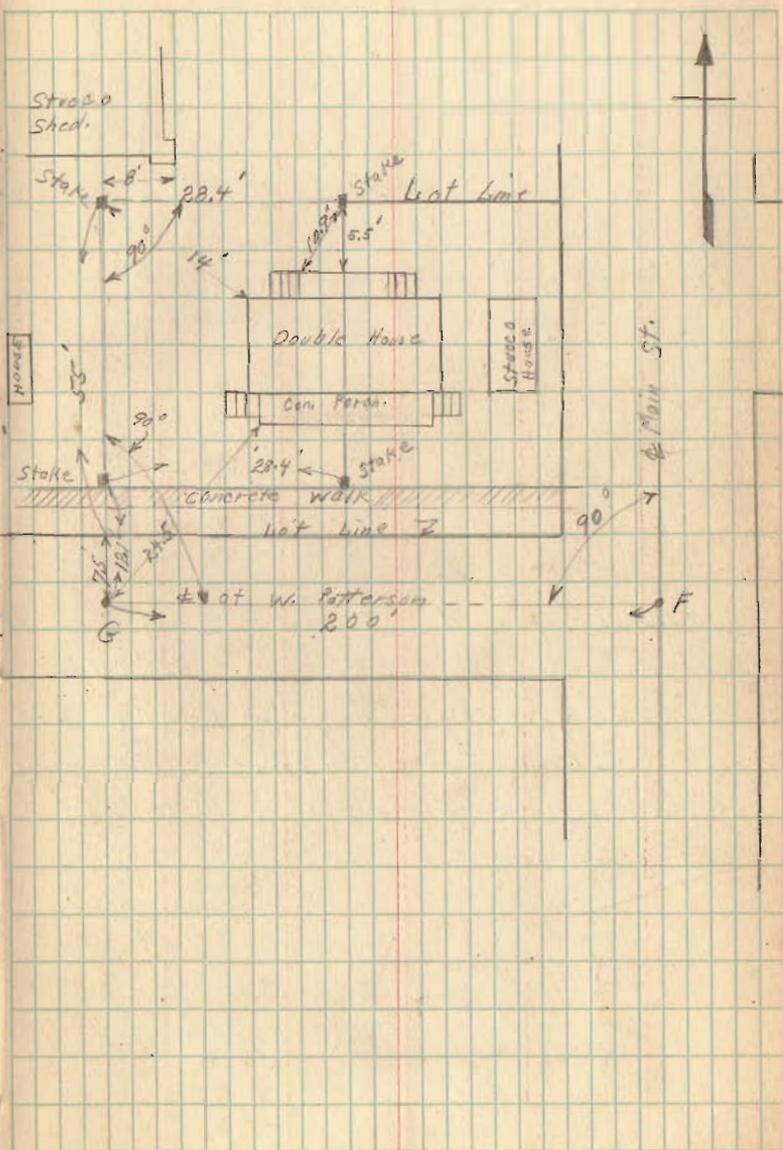

Orchard Island.

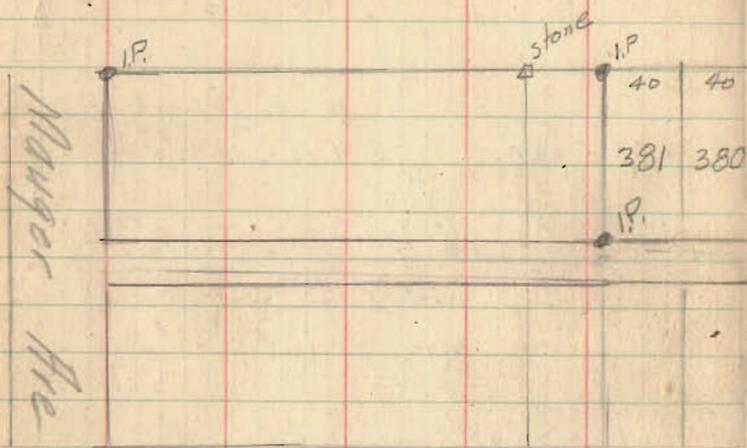

The I.P. found at Lot 379 on Auditorium was 0.5 to far south when measured from Conc marker at NE corner of 428. This marker conformed to old stks found.


1490

INDEXED ON MAP

Oct 31 1925

W H Montgomery
Harry Kilgore

Auditorium street

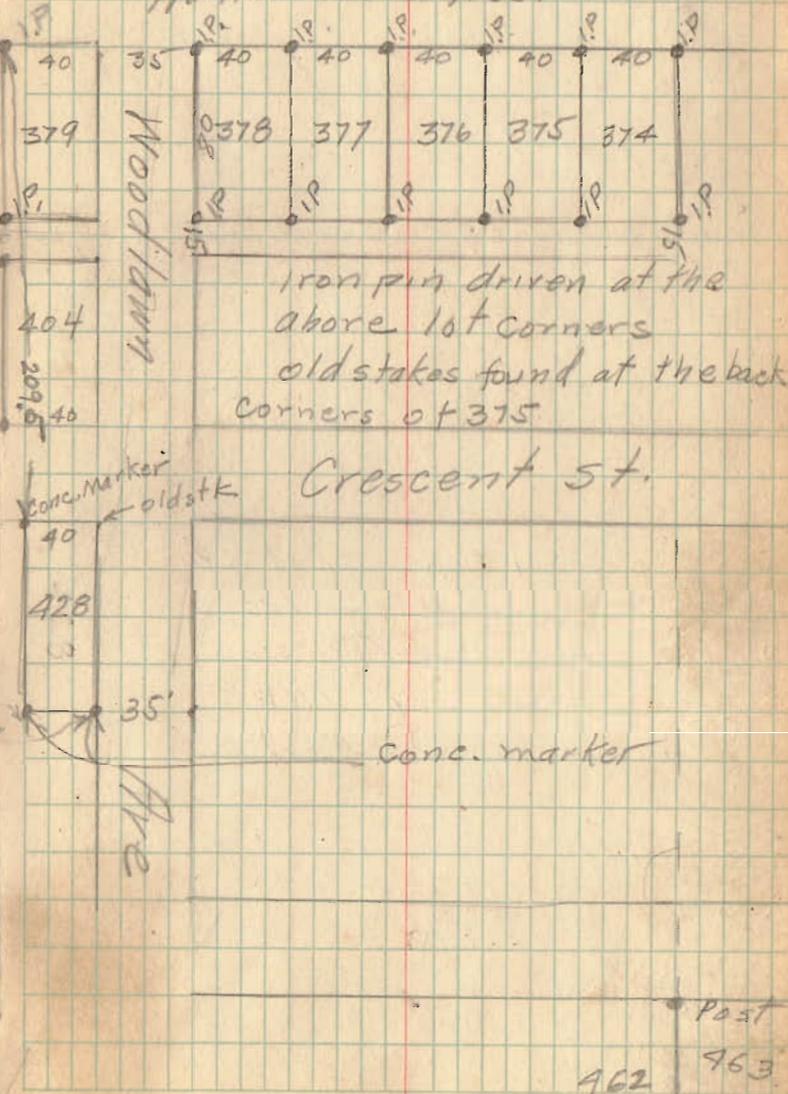

iron pin driven at the above lot corners
old stakes found at the back corners of 375

Crescent St.

462 463

5311
2602
2619
26

5333
26
27

Line ED Found stone at SW Cor Sec 35 10x30" Plat

- Wit. Wild Cherry 91' 575 W
- Cys Tole Birch 42' 575 E
- 2" Walnut 54 N 75 E

1803 Line of Center

2009 @ state Ditch

21.24 I.P. at half Sec Line

Wit. 118 to cement post south

Maple tree N E 44'

House NW Cor 11 54.3

Measured West from stone SW Cor 35

5314 ft to stone at Cor of Sec 35

4' west of fence North

Wit 3x14 3" ash 23.5'

fence North 22'

fence south 20'

LINCEA Measured East from SW Cor 35

1324 stone

2662 @ slough Ditch

5311 1/2 SE Cor of SW

sta 42 at ditch 1/2 of Sec line and 2615 1/2

SE Cor Sec 35

Random 589 1/2 E

2602
2619

W.A. Menty 9
F.F. Wright
Washington

surveyed May 14 1936

set on line 7 South and 33' West

turned 90 missed Mon 31 1/2"

Wit to stone man 34.3 Elev 18' East

2" maple 17.5

3 maple 33.0

set 20' from Sec Cor + 20' from stone Mar

apple 89.14'

Set East 20' at Probers Line + continued

Missed pipe on N side of RR. 13' 4"

Missed stone at probe road 11' 10"

Missed I.P. at Lot 142 11' 9"

I.P. at Lot 746 11'

post at south side corner 11' 1/2"

Found old post by RR dead

40' 7" from I.P. Cor Betty's add.

11000. 535.3 to station

set at PT of curve measured

at Rt Angle 50'

measured on curve of T+OC RR 321.7

set point.

Ran in line between Sec Cor

and stone at Probers Cor on 20'

offset. Missed RR Land Cor.

19' 1 1/2"

Missed State Mon 13' 10 1/2"

O'Connor Survey Survey 9947

Nov 17, 1925

- A stone found
- B stone found
- E Auto Axle Driven
- C point in O Cement Road
- D Iron pin ^{driven} 2' East of East Edge of Pav.
- E Iron pin driven G' East of East edge pav.
- G Fence Post & stone found.
- H 1 1/2" Pipe found on line with A & G

(570)

INDEXED ON MAP

See Drawing R

Survey (988)


4344

182 20

W.H. Montgomery
John Herring
Spangler

12

ch. carriers
ch carries

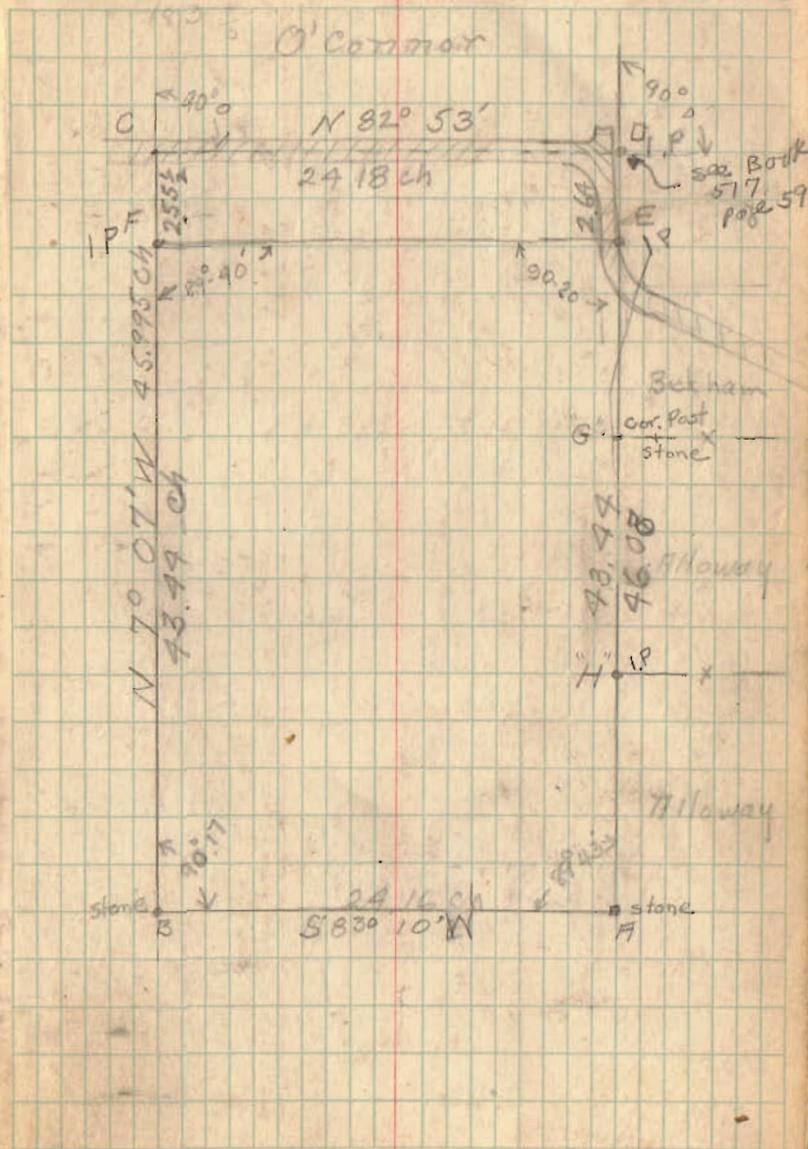

Surveyed for JT Rodgers


Survey 3438 Jefferson Tp Nov 18th 1915

(57)

W F Montgomery

JT Rodgers.

INDEXED ON MAP

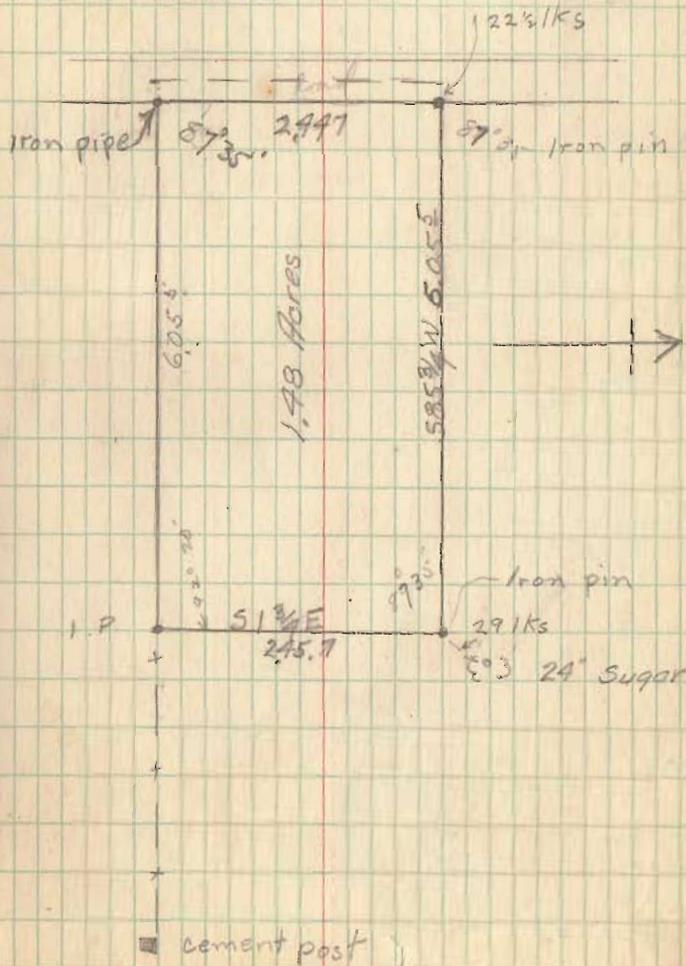

Survey for Bishop
Survey 4953


W.A. Montgomery
Wm Smucker

572

INDEXED ON MAP

Bishop Survey

14

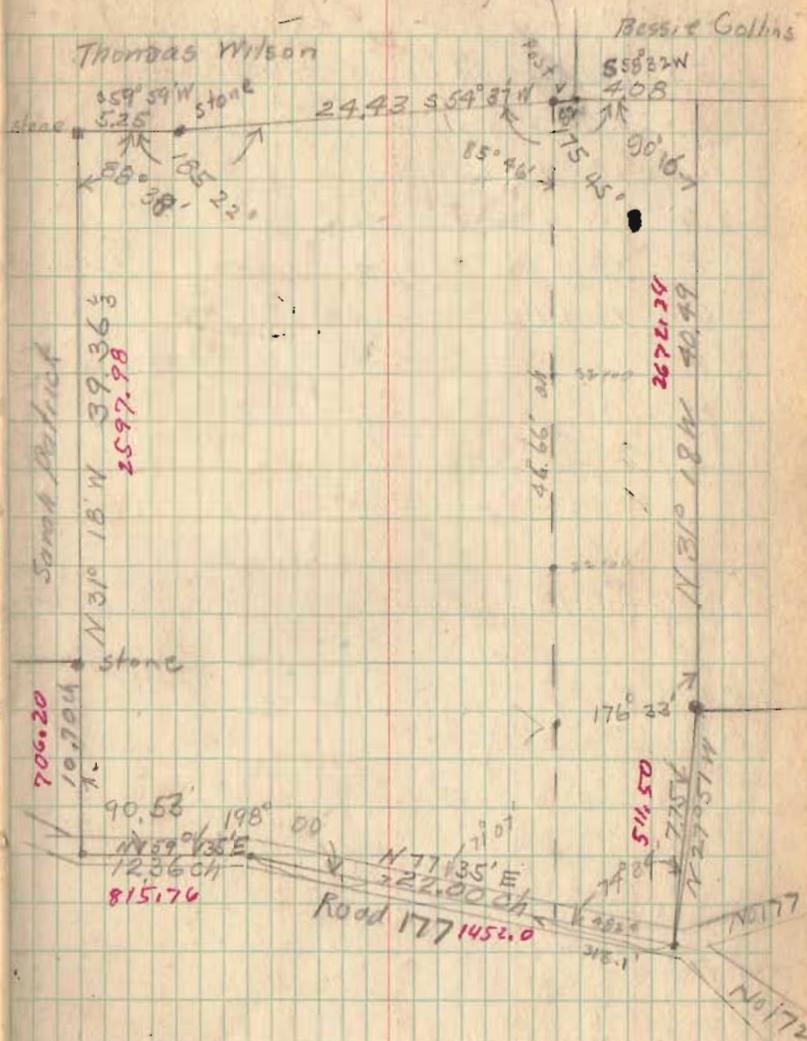


The Ohio Edison Co

- A I.P. found.
- B I.P. 2" gas pipe found
- C I.P. 1 1/2 " " "
- D I.P. 1 1/4 " " "
- E I.Pipe 3/8" gas pipe driven
- G Ford Axle driven
- F " " driven
- H I.P. found.

(573)

INDEXED ON MAP

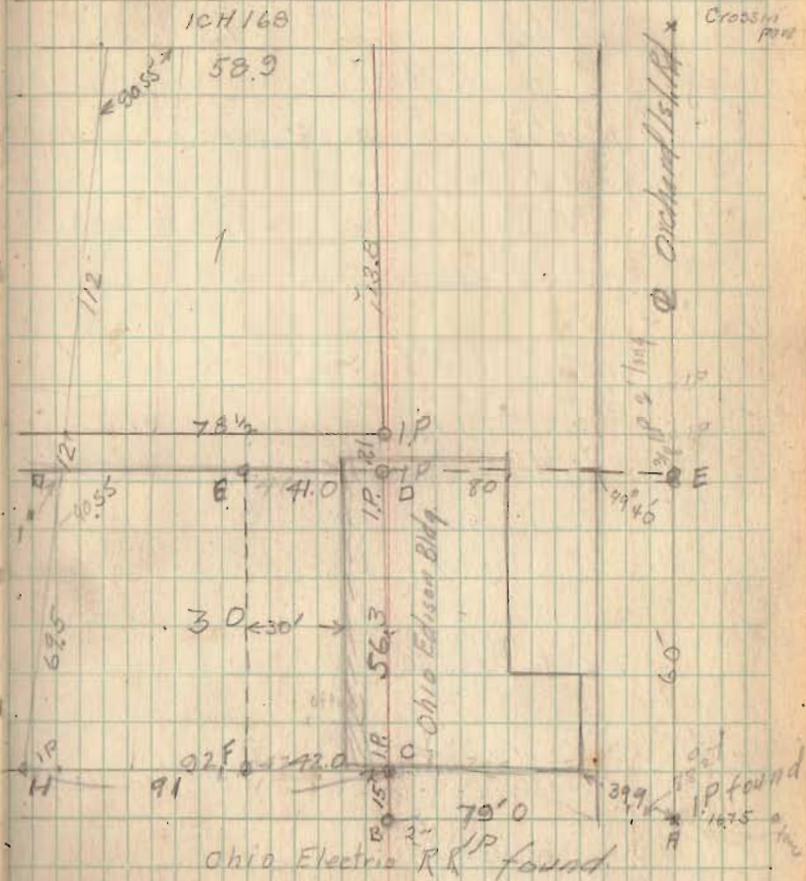

Jefferson Twp. Survey 3683

Survey for Wm Falk

~~85~~

measured 9 ch on East side

set 4' offset

(575)

at South end turned $87^{\circ}16'$ obtuse

2.80 ch

turned 90.44 to cement Rd 686

turned 127.04 3.50

turned $52^{\circ}54'$

set south end 41.7 ch to West

and North end 51.4 to make 2.5 Acres

all measurements in chains



$$\begin{array}{r} 1253 \\ 41 \\ \hline 1253 \\ 5012 \\ \hline 51373 \end{array}$$

(see Road survey Book 555 Page 26)

Wm Montgomery
Wm Smucker
Cold & windy.

Jan 29 1926

Weather

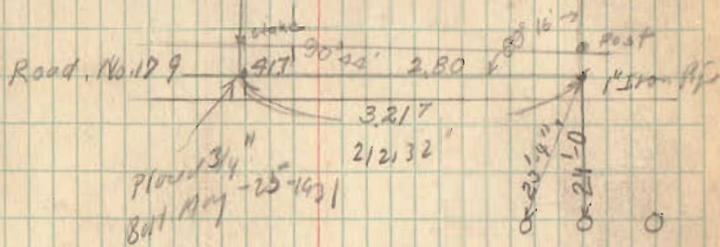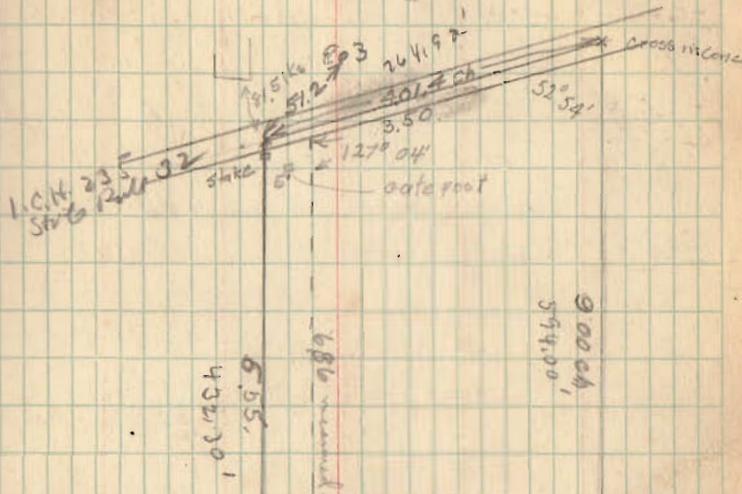

15" soyars
Witnessed
May - 25 - 1931

S.S. Smucker Survey (Continued)


Note survey was staked as shown
by letters. (See Page 18)

Cemetery St. is a 40' St
being 25' on west side and
15' on East side of $\frac{1}{2}$ as shown.

The 10' strip shown in red on
West side of Cemetery Ave. can
be used by Abutting Property
as per resolution # 456 Passed
by Bellefontaine City Council
July 27, 1920

Note:-

See Page 18 for Points as shown.

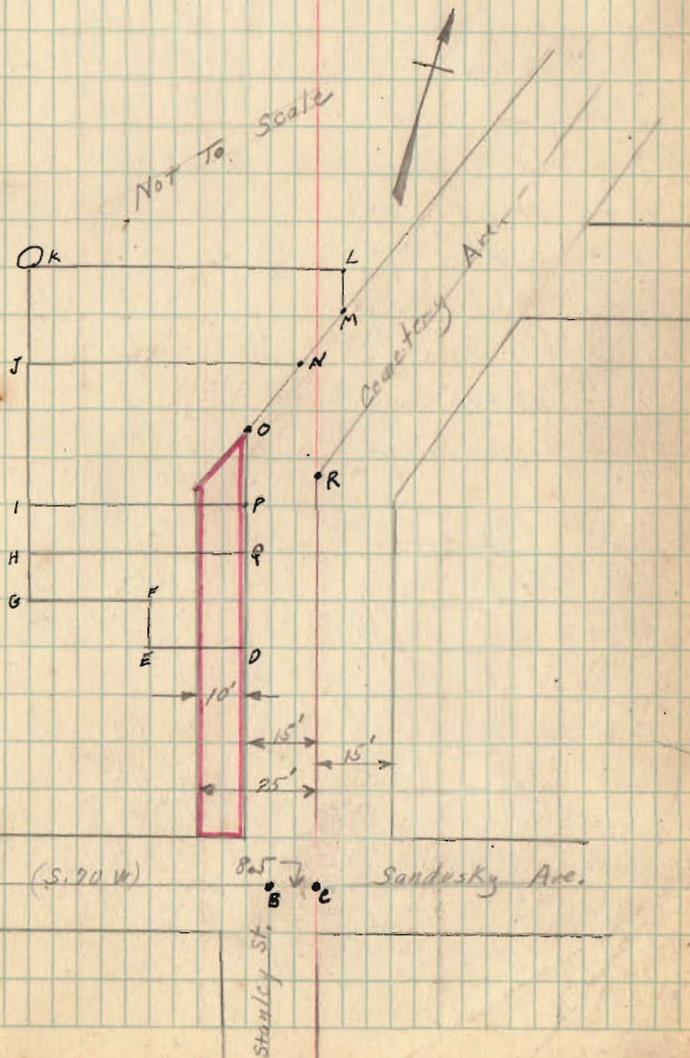

577

INDEXED ON MAP

Ballinger Survey

Perry Twp.

- A - Stone found
 B - Oak Stake placed by Wright
 C - Stone found
 D - Oak Stake placed by Wright
 E - " " " " "
 F - Post
 G - Stone found
 H - Post
 I - Post
 J - Stake placed by Wright.

ABCJ is in Survey $\begin{cases} 12103 \\ 13528 \\ 13557 \\ 13558 \end{cases} = 13.71 \checkmark$ Acres

DEFJ is in Survey 13529 = 52.10 Acres

GHIJ is in Survey 14894 = 22.17 \checkmark Acres

Total 87.98


All angles and measurements were taken
 in field as shown.

Feb. - 23 - 1926

Clear-Thawing

20

Wright
 Swickard
 Mr. Ballinger
 Mr. (?)
 Mr. (?)

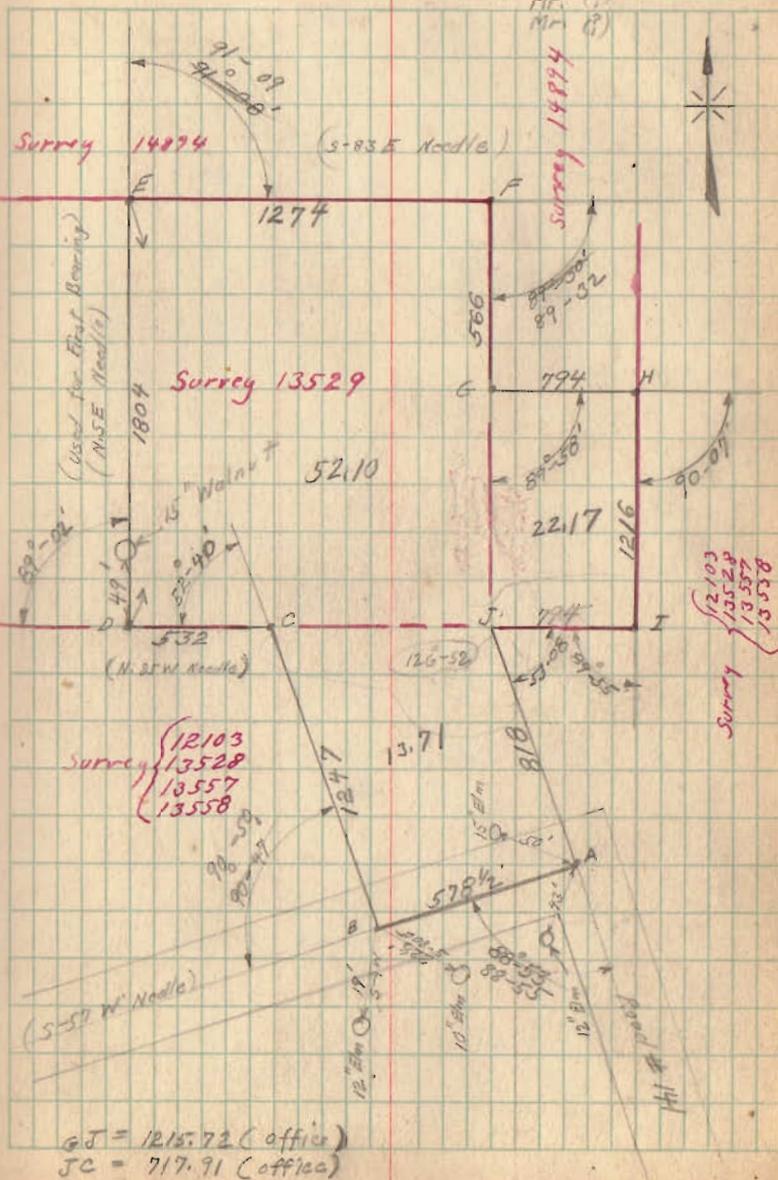


Beatley survey Russel Point

- A Reinf bar see bk 390 pp 47
- B. hub with tack.
- D. hub with tack.
- C. point 5' from I.P.
- E. hub found placed 1. Pipe inside & set up at "E" 100' from D and H sighted on "C" produced to M & N measured 450' from A turned 90° found "E" which this line missed 2" set up on this line and 12.5 ft East of E turned 90° missed Wrights Hub. 19"

(See Note Book 385 Page 46)

579


INDEXED ON MAP

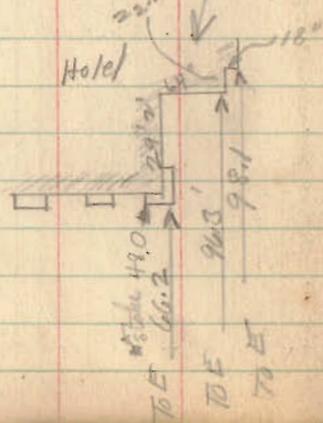

Burkhart Add

3/9/26

W A Montgomery
Wm Salvocker

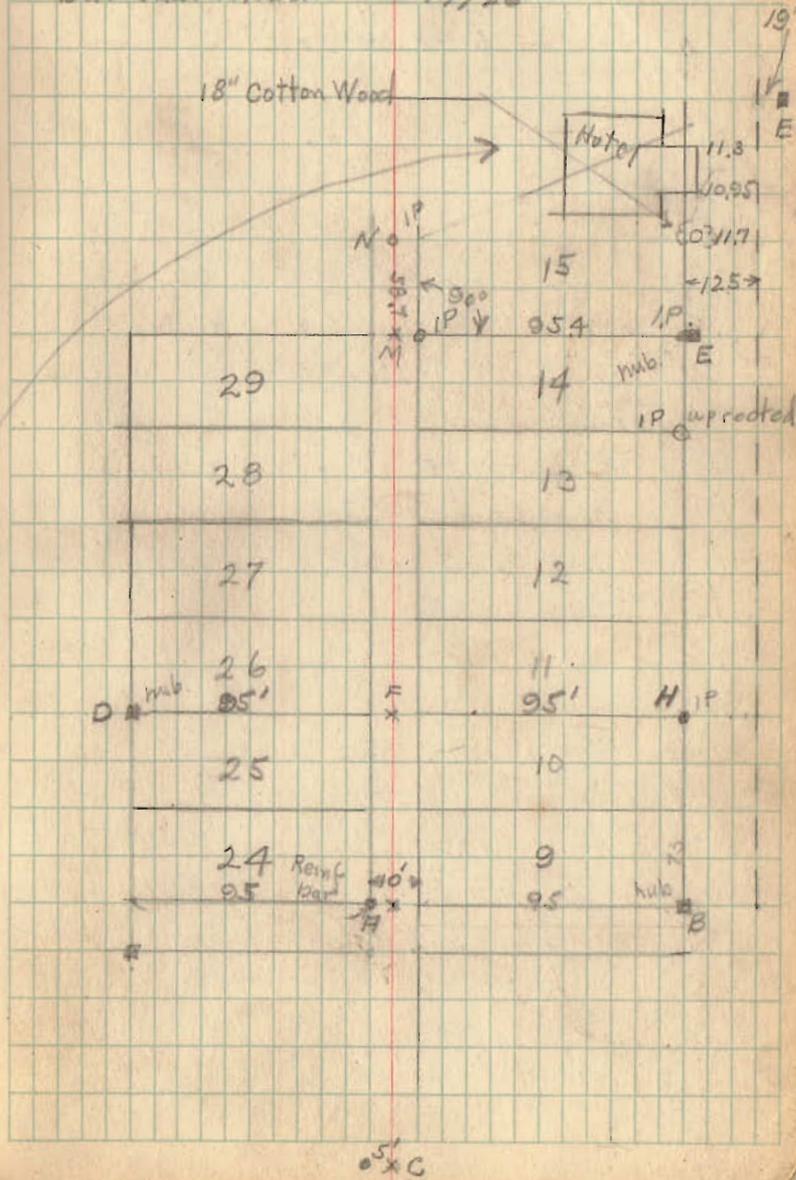

58

INDEXED ON MAP

"B. Miller Survey Washington Twp.
Sec-13-T.7-R.8

- A - Spike placed $\frac{1}{4}$ of Road.
- B " " " " "
- C " " " " "
- D " " " " " (Temporary Point)
- E IRON (Ford Axle) Placed $\frac{1}{4}$ of Road
- F " (" ") Placed
- G Stake placed (Temporary Point)
- H. Fence Post S.E. Cor. of N.W. Quarter Sec.
- I Fence Post
- J 12" Tree South edge of Tree O.K. for wire

Ground was frozen making it impossible to dig for irons.

See M^r Kinnon's Note Book #1

(Red Book) Page 127 for Parmer Survey.


ABCDGI = 46.58 Acres

line DG was removed 2.00 chains North to line EF To make 50.00 Acres in ABCEFI

(About 18.8 Acres in S.E. Quarter)
 (" 31.2 " " N.E. ")
 50.00 "

March - 10-1926
 Thawing
 Wright
 Smucker
 B. Miller
 Mr.

23

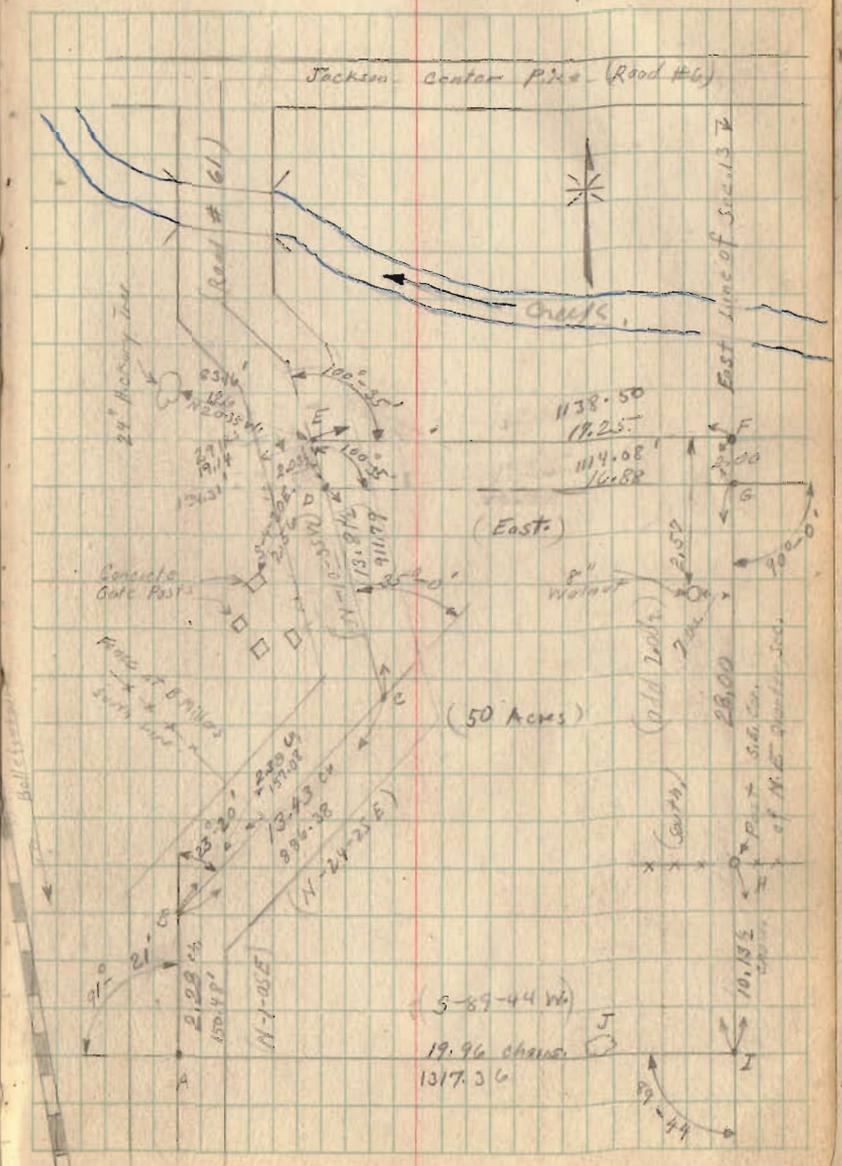


Park Survey - Lake Trp.

- A - Iron P/Ra head
- B - Fence Post
- C - 6"x3 1/2" Heavy Iron in concrete used for Post
- D - Large Oak Post
- E - Angle in R.R. Fence line.
- F - Post in Jog in fence
- G " " " " "
- H - High Stump used for Post R.R. Fence line.

Sec. 33 19.27 Acres
 Sec. 27 13.52 "
 33.27 "

March - 12 - 1926
 Cold Wind.
 Wright
 S. H. A. R. R.
 Mr. Park.
 March - 13 - 1926

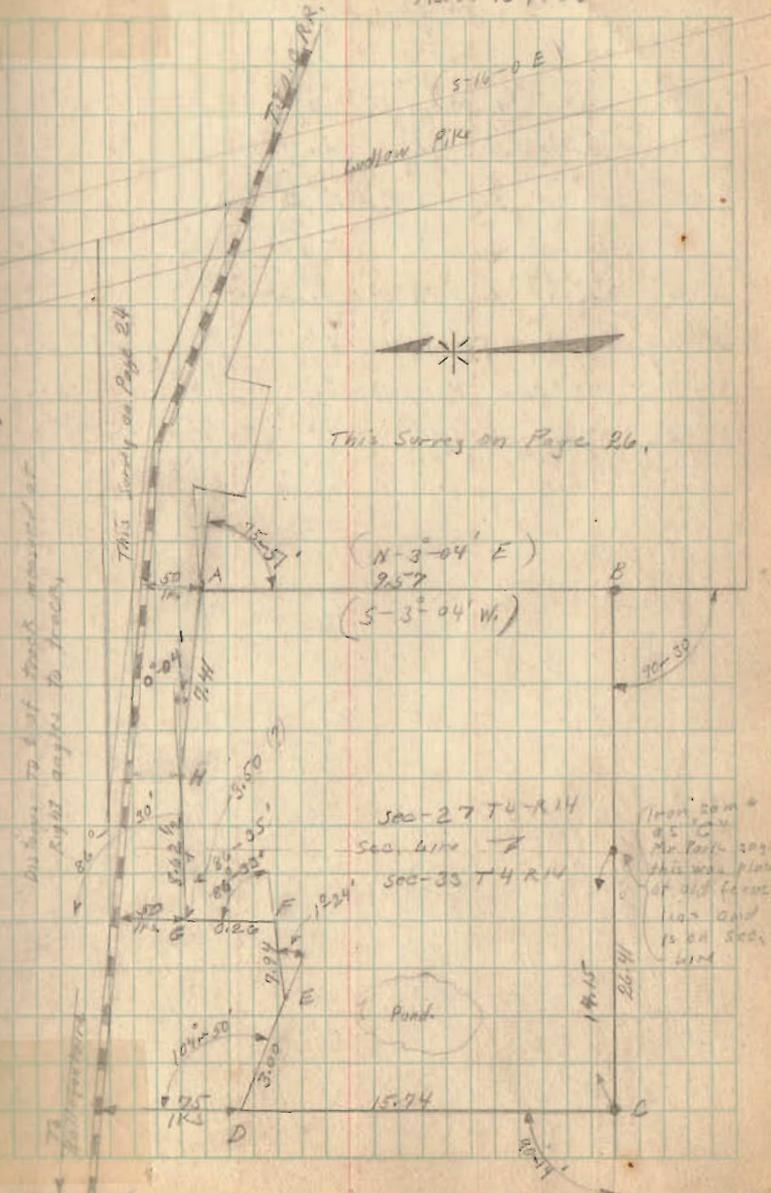


Park Survey - Lake Trip


- A - Small Iron Spike Placed $\frac{1}{2}$ of Ludlow.
8.70 Chains from A To Horse
- 22.20 " " " $\frac{1}{2}$ Creek.
- 24.58 " " " Horse
- B, Small Iron Spike Placed $\frac{1}{2}$ Ludlow.
- C, Post - Iron Placed.
- D 2" Iron Pipe placed.
- E Same as A page 25
- F Post Jay in R.R. Fence.
- G, " " " " "
- H. Angle in R.R. Fence.
- I, " " " "
- J " " " "
- K Post Jay in R.R. Fence.
- L, " " " " "
- M. Angle in R.R. Fence.
- N, " " " "
- O " " " "

March - 15 - 1926
Cold Wind
Wright
Smucker
New Park.

26

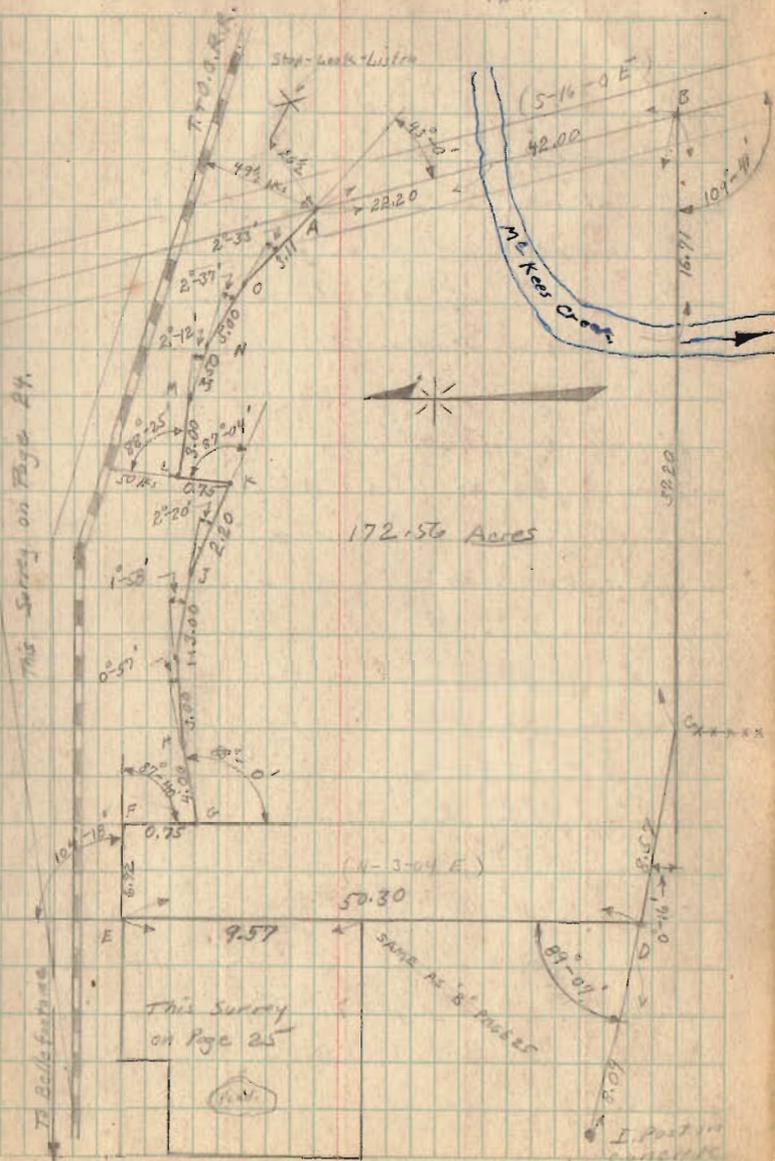

March-27-1926
Sun mch'g
Wright
Et. Con

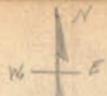

R.A. Lynn Survey N. Main St. Bellefont

lot 1558

A - Monument with corner

B - " " "

C Iron Pin. Found.

D old Hub (Not used.)

E Old Hub.

F " "

G " "

H. Iron pipe Placed by Wright

I " " " " "

J Iron " " " " (on line K.H.)

K. Iron Pipe. " " " (Replaced old Hub)

L. Old Hub found.

M. Hub placed by Wright.

N. Iron found.

O " "

P " "

Q " "

A.R. Line. 90° from AB

S & of Car. tracks (Did not dig for monument)

T Monument with corner


There is an excess of 1.5 feet between

Main & Detroit .75 was added to

lot 1558 making it 220.75

582

INDEXED ON MAP

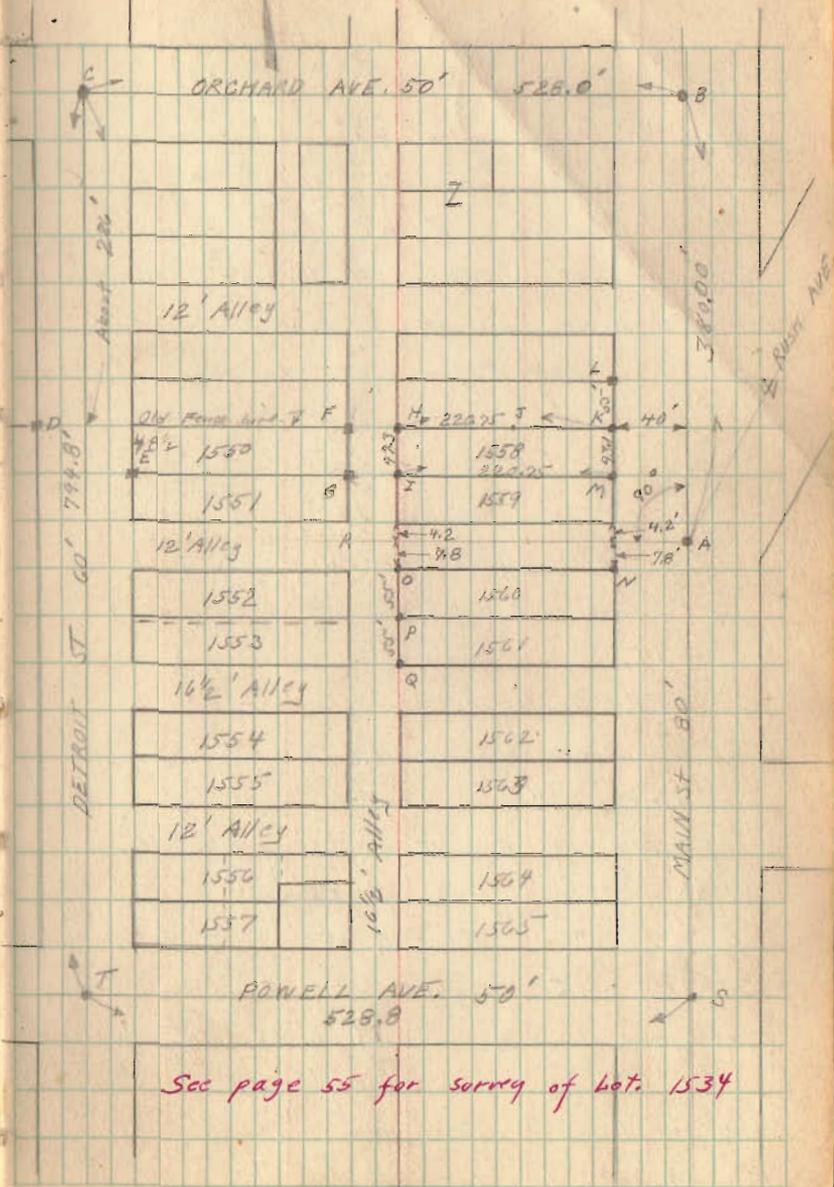

See page 55 for survey of lot 1534

(Continued on page 29)

Luna Survey (Continued)

Set on A Turned 90° from B. Measured
West 40' and South 7.8' found iron N.

(See Record at City Bldg.)

Measured North 12' for alley and then
55' for lot 1559 set Hub at M.

Found old Hub at K. Replaced with iron.

Set on K. used F for line set iron at H.

Measured. West (along A.R.) 40' from

A and then 220.75' From this
point. Then south 7.8' found iron O.

Measured N. 12' for Alley and then
55' for lot 1559 and set iron
at I.

J.H.F.D. is on old fence row.

M.S. measured 43.1'

1H " 47.3'

Found old Hub at L 55' from K.


" Iron at P 55' " O

" " " Q 55' " P.

Set on I sighted to E. Hub G

was about $\frac{1}{2}$ " North of line. I.E. produced
to M checked very good.

All distances shown were measured
by Wright in the field.

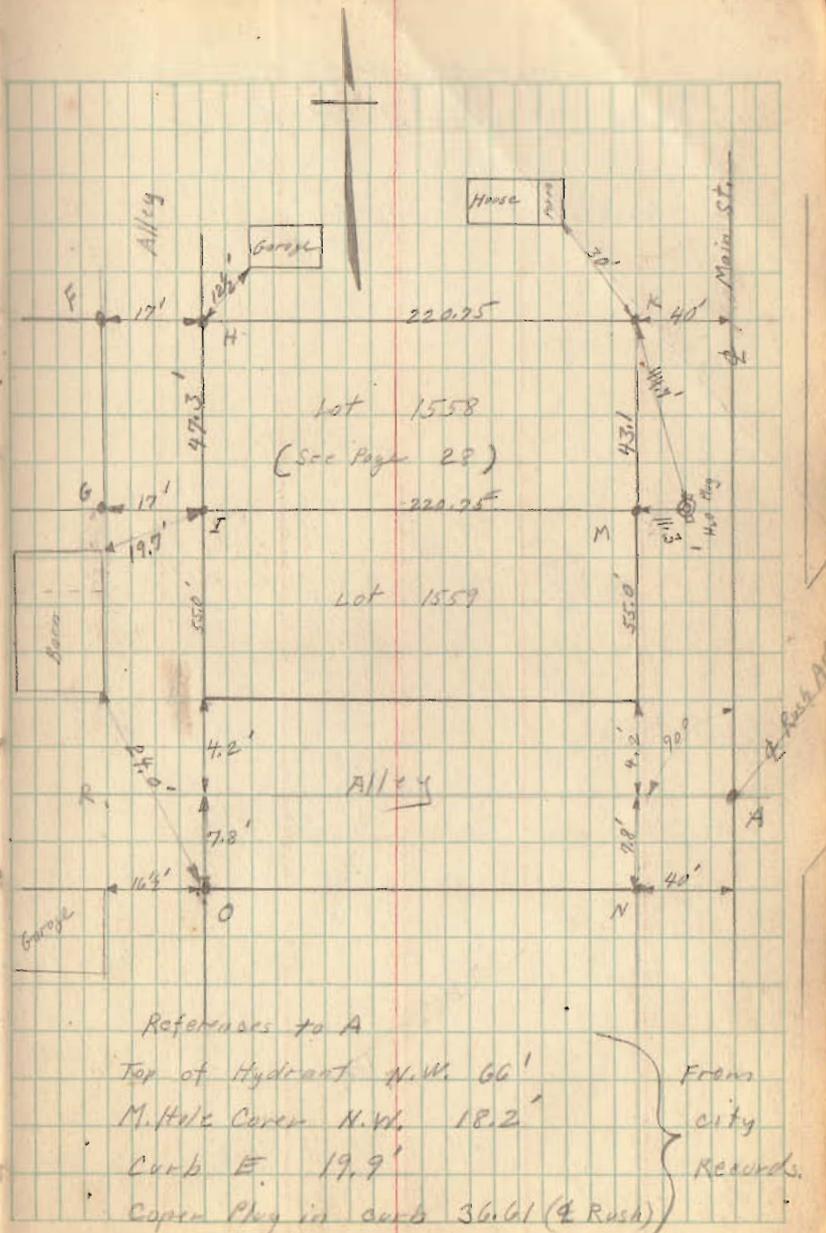

Survey for Robt Moore
Sec 31 T-2-R-14
15


Washington Township.

583
INDEXED ON MAP




March 18 1926.
Spring day

W A Montgomery 30
W M Smucker

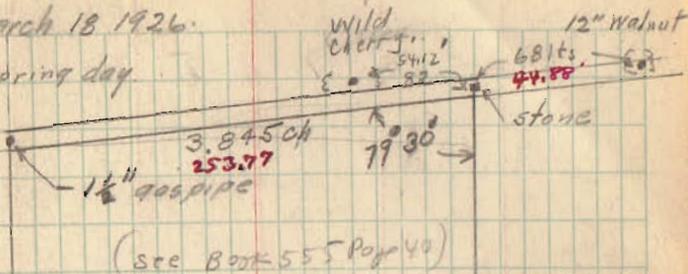

12 Acres

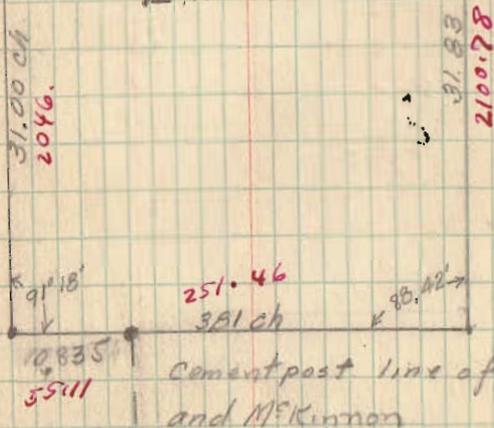

Burns Surrey Present Truss


Sec. 3 T.1 R.B EMM

See Book "C" Page 203

- A. Stone found
- B. Point in Road on fence line
- C. Oak stake placed by Wright
- D. " " " " " " " "
- E. " " " " " " " "
- F. Large Concrete End Post
- G. Stake placed by Wright
- H. Stake placed by Wright
- I. Stone found
- J. 2" Iron Pipe 5' Long placed by Wright
- K. Stake placed by Wright
- L. " " " " " "
- M. " " " " " "

Point B placed on fence line. Measured West 20.13 $\frac{1}{2}$ found stone A. ok. same dist as former survey. Measured East from B 20.14 dog for stone. Placed Stake E, ok for fence line and ok with previous survey. FI = 20.14 chains mark. FH $\frac{3}{4}$ and HI $\frac{1}{4}$ of total distance distance. This marks old rail fence. HI a little west

April 2-1926
cloudy Not very cold.
Wright
Mr. Shawver
Mr. Gates
Mr. (?)

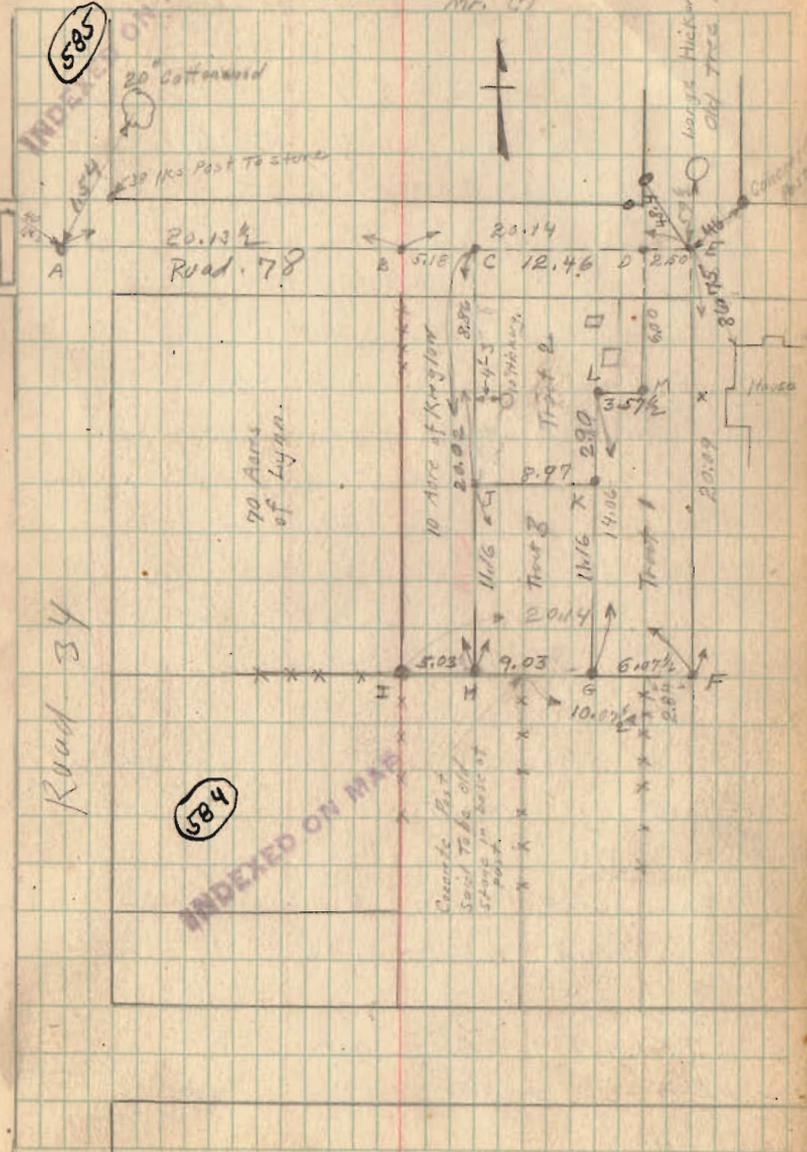

Burns Survey (Continued)

Set "Point C" about on fence line.
 Note that this gives Mr. Kreglo over
 $\frac{1}{4}$ of distance B.E. Mr. Shander said
 (Against his interest) not to go West
 farther as this would crowd over
 into Mr. Kreglo's garden.

Measured West from E 2.50 chains as
 shown. Measured from D South 600 ch.
 To M. M is 2.50 chains from X and
 X is 600 chains South of E.

Set on M. and produced XM To
 L. Made K on line with L.G.
 G and J were set as shown by
 distance.

All distances shown were measured in
 field by Wright.

| | | | | |
|-------------|----------|--------|----------|----------|
| Burns Deed | Vol. 96 | P. 148 | 30 Acres | 17th Dec |
| Kreglo Deed | Vol. 127 | P. 74 | 10 " | " " " |

| | | |
|--------|--------------|-------|
| CDMLKJ | = 10.05 | Acres |
| DEFGLM | = 10.05 | " |
| JKGH | = 10.05 | " |
| | <u>30.15</u> | |

Library Lot Zanesfield
lot #11

Used East side of East Sidewalk for
lot line. This makes Sandusky St.
60' O.K.

Measured North from the $\frac{1}{4}$ of Concrete
on Columbus St. Measured as shown to
 $\frac{1}{4}$ of Locust St. This was O.K. for
Apparent $\frac{1}{4}$ of Locust St.

Then measured again from $\frac{1}{4}$ of Columbus St.
as shown and set corners to lot #11

- A - $\frac{1}{2}$ " Iron 30" long placed by Wright
- B - $\frac{1}{2}$ " " " " " "
- C $\frac{1}{2}$ " " " " " " (Not lot C)
- D Chisel mark on edge of walk. (Lot C)
- E Temporary point on walk.
- F Hub on line AE near end of walk.

No Old monuments found

Noted that corners A & B were about
16' from Fence line on East side of
Cherry Alley.


Note that this is the same as the
original Allotment.

April - 14 - 1926

Clear
Wright
Smith & Co.
E.C. Williams & Co.

36

COUNTY ROAD #10

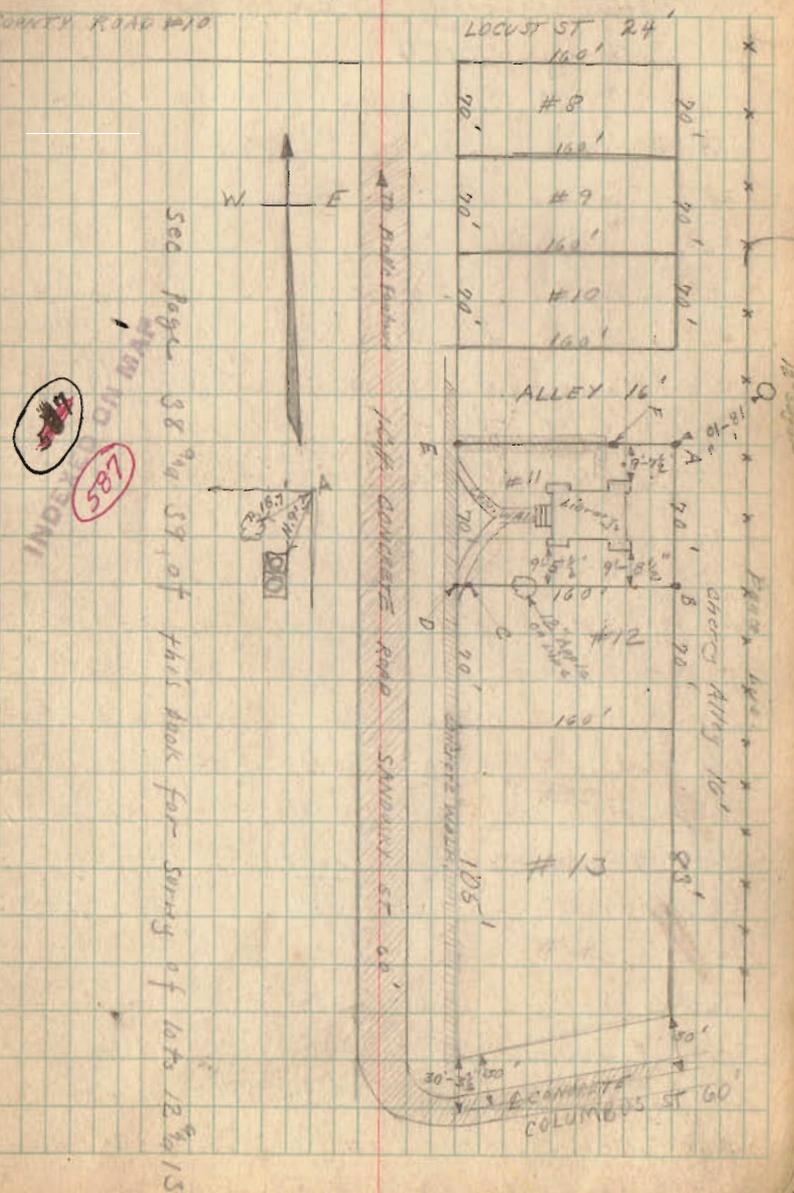

Wish Survey Lake, Twp.

Survey 3324

(See Book 512 page 29 Note Date)

- A Stone found.
- B. Stake Placed By Wright
- C. 2" I. Pipe about 36" long Placed by Wright
- D. Post
- E. Stone found.
- F. Small stake Placed by Wright
- G. " " " " "
- H. " " " " "
- I. " " " " "
- J. " " " " "
- K. 2" I. Pipe about 36" long Placed by Wright
- L. Iron Stake 1-11-32 Placed by Wright
- M. Stone and Pieces of tile Placed by Wright

Madison Kemp
90.47 Acres

J.F. Trout
100.09 Acres

J.E. Dickinson Deed Vol. 112 P. 44

Note that this deed calls for all of 100 Acres except 51 Acres off of East side.

First surveyed 50⁰⁰ Acres as shown.

Then surveyed 51⁰⁰ " " "

Note that this leaves an overrun of 2.26 Acres

The Dickinson land (To Be sold to Wish)


would then be 52.26 Acres.

588

INDEXED ON MAP

April - 13 - 1926
Clear - Fine Day
Wright
Mr. Wish.

37

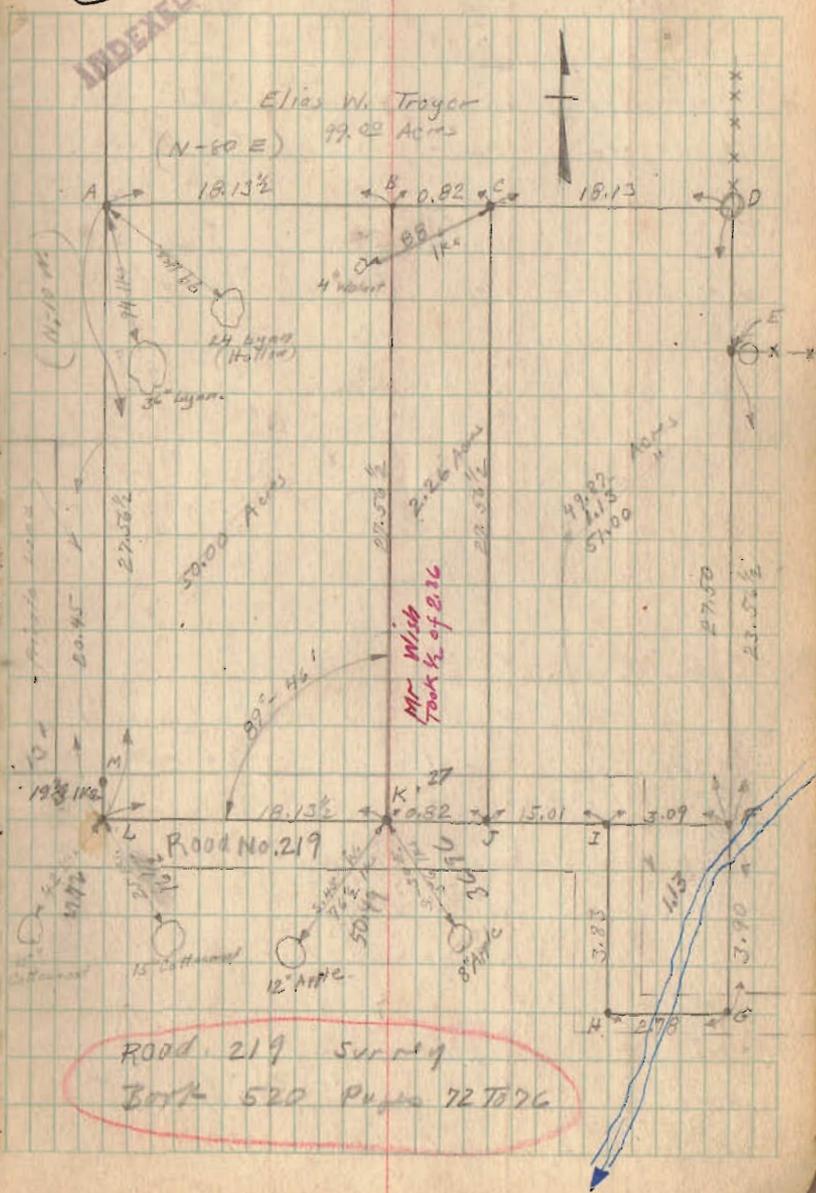

Polk Surrey Zanesfield Lots.

See Notes on Page 39 of This Book
for lots as per original Plat

Note that this survey was made to
establish lot lines as per deeds

| | |
|---|---|
| A | Same as A on Page 39 |
| B | " " B " " " |
| C | " " C " " " |
| D | " " D " " " |
| E | " " E " " " |
| F | Hub Placed by Wright also chisel mark on wall |
| G | " " " " " " " " |
| H | " " " " " " " " |
| I | Hub Placed by Wright |
| J | " " " " " " " " |
| K | " " " " " " " " |

Measured South from E⁹W.C 74'-6" and plumb F⁹W.K
 " " " F⁹W.K 55'-6" " " G⁹W.J
 " " " G 45'-0" " " H.
 " " " J 25'-0" " " I

All lots 160' Deep.

Lot line FK Apparently OK.


Lot line GJ Pased through Brick
house as shown.

(Continued on Page 39)

589

INDEXED ON MAP

April 17-1920
Cloudy - Cool
Wright
Mr. Polk
Billy Wright

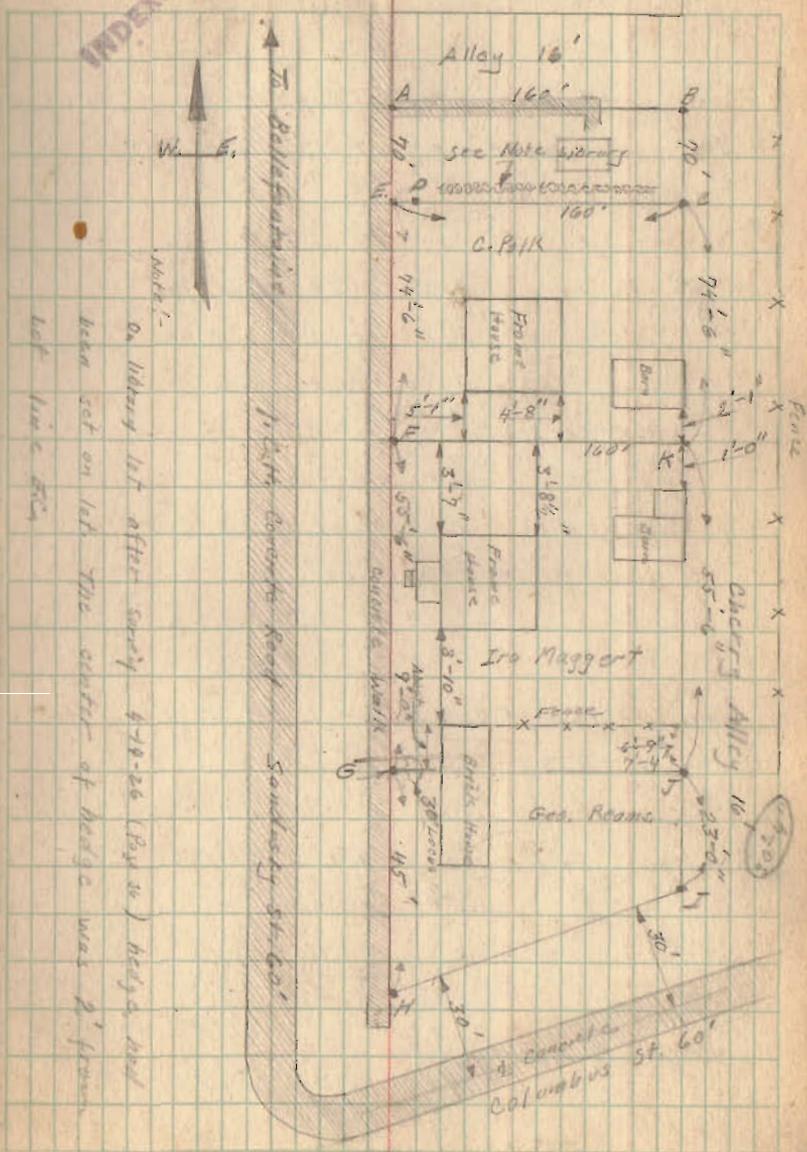

470

Polk Survey (Continued)

Geo Reams Deed Vol. 118 Page 206
South half of lot 13 (No distines
given)

Ira Maggert Vol. 128 Page 171
55 $\frac{1}{2}$ ' of N. $\frac{1}{2}$ of lot 13 being
60' off the N. Part of lot 13
except 4 $\frac{1}{2}$ ' on N. side of said lot.
(Note that this is as staked
4 $\frac{1}{2}$ ' off of #13 now being with Lot 12
60' off of the original lot
would leave 45' for Reams

Taylor To Thorton Vol. 44 Page 81
4 $\frac{1}{2}$ ' by 160'

Chas Polk Vol. 124 Page 265

Park Survey

Tract A is the same as Tract 1 on Page 27 except south line of Tract 1 was moved South 150 Feet (2.27 chains)

Tract B is the same as Tract 2 on Page 27 except North line of Tract 2 was moved south 150 feet (2.27 chains)

Tract C same as tract 3 on Page 27 No Change.

Note:-


See Page 27 for distances before South line of tract 1 was moved South 150'

See Drawer R

April -23-1924

40

Wright
Smucker

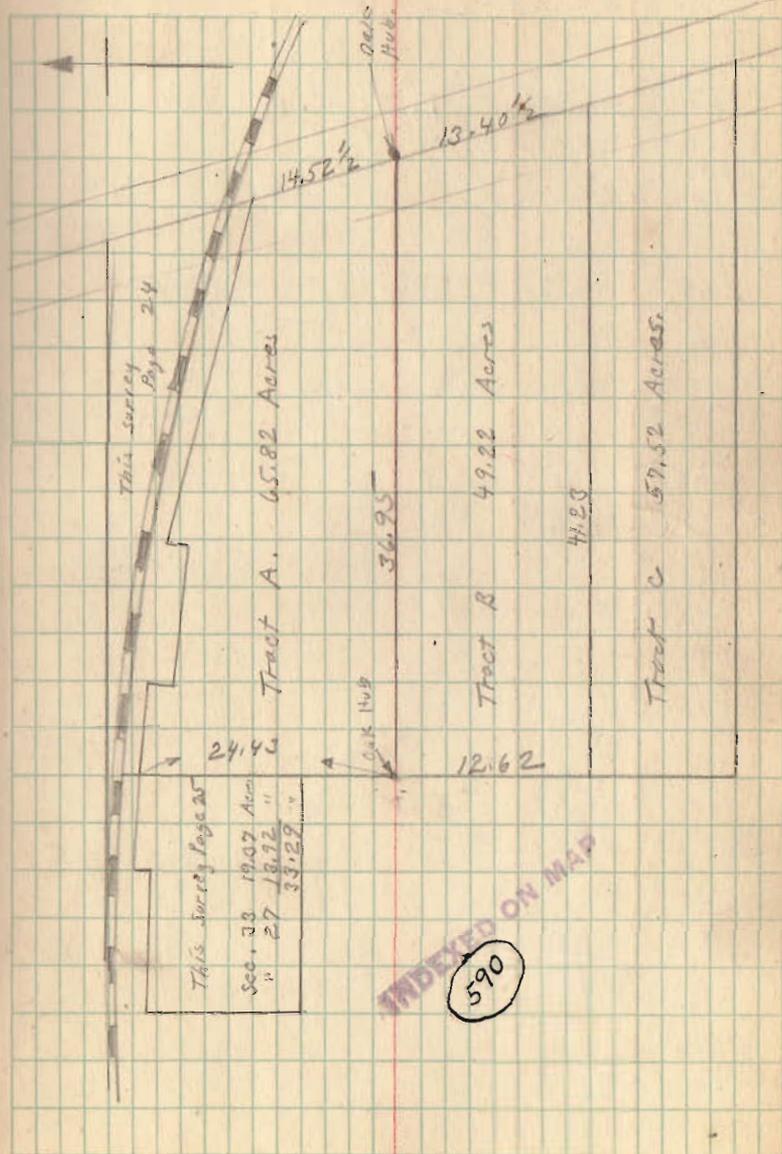


M^e Kenzie Harrison Twp.

Sec. 5 T. 3 R. 14

- A - Cross on Concrete made by Wright.
- B " " " " " "
- C Stake Placed by Wright.
- D Stake and Stone (Stake Placed by Wright)
- E Old Stone Found.

591
INDEXED ON MAP

April - 30 - 1926
Very Windy
Wright
Smucker 41

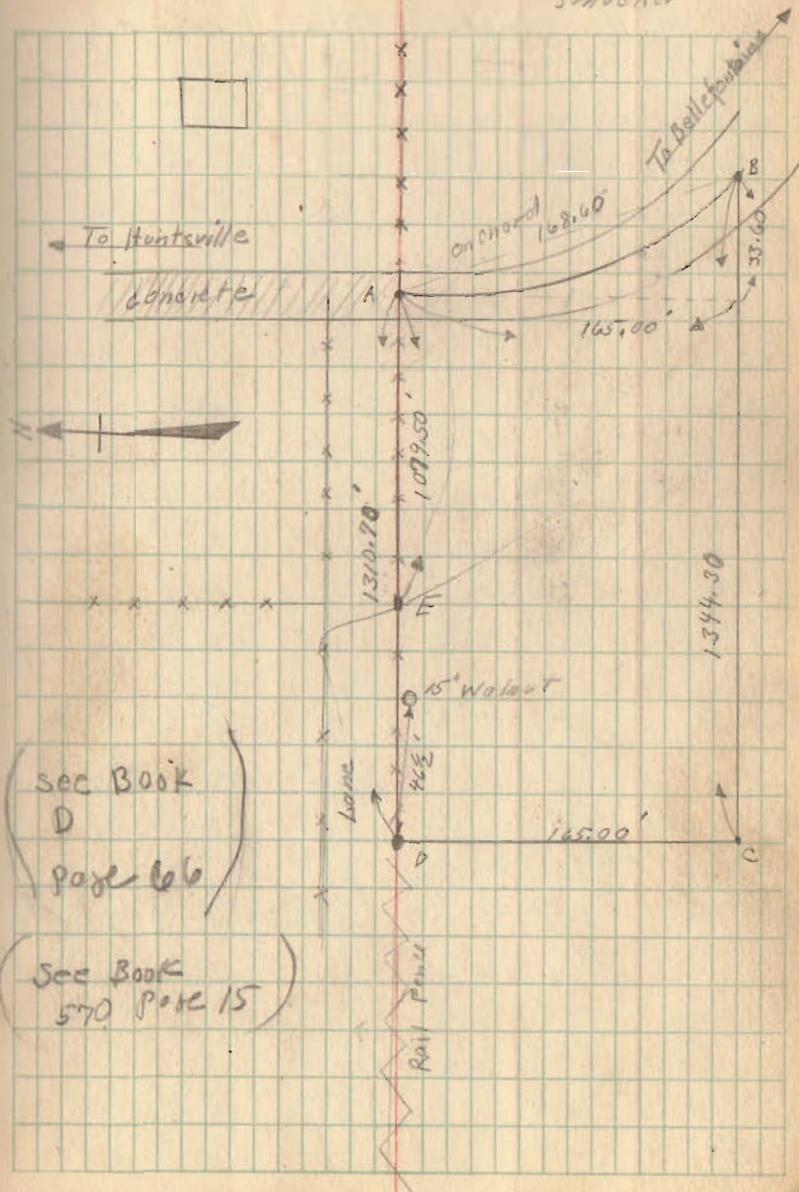

(see Book
D
page 66)

(see Book
570 page 15)

Lilly-White Oil Co. Everett St.

| | +s. | H.I. | -s. | Elev. |
|------|------|---------|--------|---------|
| B.M. | 4.25 | 1205.17 | | 1200.92 |
| T.P. | 5.56 | 1207.73 | 3.00 | 1202.17 |
| | | | 3.85 | 3.88 |
| A-1 | | | 5.08 | 2.65 |
| A-2 | | | 4.39 | 3.35 |
| A-3 | | | 3.65 | 4.08 |
| A-4 | | | 3.70 | 4.03 |
| A-5 | | | 4.12 | 3.61 |
| | | | 4.61 | 3.12 |
| B-2 | | | 3.58 | 4.15 |
| C-2 | | | 3.40 | 4.23 |
| D-2 | | | 3.64 | 4.09 |
| E-2 | | | 3.95 | 3.78 |
| | | | 3.05 | 4.68 |
| | | | 2.68 | 5.05 |
| | | | 3.10 | 4.63 |
| | | | 3.32 | 4.41 |
| | | | 3.00 | 4.73 |
| | | | 2.91 | 4.82 |
| | | | + 0.59 | 8.34 |
| | | | 0.37 | 8.10 |
| | | | 2.80 | 4.93 |
| | | | 2.43 | 5.30 |

592
INDEXED ON MAP

May-12-1926

42

Fire day
Wright
Smucker

Top of Hydrant Cor. Everett & Columbus
on Walk S.W. cor. of Property
Floor of garage S. End.

To make same as city levels
subtract 1168.28

See Page 51 for system of Coordinates.

on walk 4 line produced W.

(Levels Run March-1927 Book 418 Page 46
did not check. Add 7.88 to the levels
in this book for true levels. Those levels
O.K. except they are not true Cor. levels)

Top of Rail 2 line Pro - E

Floor Pump House

Cor. S.W. cor Pump House

Extent to 3 Tank

" " 2 "

Ground S.E. cor of Green Machine

Floor " "

Platform " "

T.R. Spur track on W. Prop. line

T.R. T.N.O.C. " " "

Lilly White Oil Co.

| TS. | H.I. | -S. | Elev. |
|-----|------|------|---------|
| | | 2.60 | 1205.13 |
| | | 2.50 | 5.23 |
| | | 4.30 | 3.73 |
| | | 4.83 | 2.90 |
| | | 5.33 | 2.40 |
| | | 3.52 | 4.21 |

| B.M. | 7.45 | 1209.62 | 1202.17 |
|------|------|---------|---------|
| | 5.05 | 4.57 | |
| | 4.55 | 5.07 | |
| | 4.95 | 4.67 | |
| | 4.41 | 5.21 | |
| | 4.73 | 4.89 | |
| | 3.45 | 6.17 | |
| | 3.10 | 6.52 | |

| B.M. | 5.09 | 1207.26 | 1202.17 |
|------|------|---------|---------|
| B-0 | 4.35 | 2.91 | |
| C-0 | 5.00 | 2.26 | |
| D-0 | 4.85 | 2.41 | |
| E-0 | 5.20 | 2.06 | |

J.R. Switzer Tract W. Prop line.
 " " Main " " " "
 E Everett 4 line. Produced
 " " 2 " "
 " " 0 " "
 Ground S.W. Cor. Green House

on walk S.W. Cor. Property
 Ground N.W. Cor. Green House
 Top Rail " " " " "
 Ground N.E. " " "
 T. Rail " " " " "
 Ground S.W. Cor. of Coal Street
 " E. Prop line by " "
 Top of Rail " " " " "

on Walk S.W. Corner of Prop

Lilly White Oil Co.

| | TS. | H. 11 | -S. | ELY |
|-----|-----|---------|------|---------|
| F-0 | | 1207.26 | 5.42 | 1201.84 |
| G-0 | | | 5.74 | 1.52 |
| H-0 | | | 5.58 | 1.68 |
| | | | 4.58 | 2.68 |
| H-1 | | | 4.05 | 3.21 |
| H-2 | | | 3.43 | 3.83 |
| H-3 | | | 2.05 | 5.21 |
| | | | 1.66 | 5.60 |
| G-1 | | | 4.01 | 3.25 |
| | | | 2.49 | 4.77 |
| G-2 | | | 3.80 | 3.46 |
| G-3 | | | 2.38 | 4.88 |
| | | | 2.22 | 5.04 |
| F-1 | | | 2.81 | 4.45 |
| F-2 | | | 4.10 | 3.16 |
| F-3 | | | 3.20 | 4.06 |
| | | | 2.45 | 4.81 |
| E-1 | | | 4.70 | 2.56 |
| E-2 | | | 3.35 | 3.91 |
| | | | 2.52 | 4.74 |
| C-1 | | | 3.88 | 3.36 |
| D-1 | | | 4.20 | 3.06 |
| D-2 | | | 3.16 | 4.10 |

5-12-26

44

S.E. Cor Prop.

E. Prop Line S. side of shed.

Highest Point Rock.

Top of Rain end of spur

F line near shed

Ti Rail near E-2

Lilly White Oil Co.

| | TS. | H.I. | -S. | ETC |
|-----|-----|---------|------|---------|
| D-3 | | 1207.26 | 3.18 | 1204.08 |
| | | | 3.00 | 4.26 |
| | | | 3.11 | 4.15 |
| | | | 2.75 | 4.51 |
| | | | 3.26 | 4.00 |
| | | | 4.00 | 3.26 |
| | | | 2.60 | 4.66 |

| | | | | |
|------|------|---------|------|---------|
| B.M. | 9.60 | 1206.80 | | 1202.17 |
| E-3 | | | 2.18 | 4.62 |
| E-4 | | | 2.11 | 4.69 |
| | | | 1.90 | 4.90 |

5-12-26

45

Ground Rock # 5 Tank

" " " 4 "

" " " 3 "

N.E. Cor Garage

S.E. " "

Top Rail 0 like Produced

On Walk S.W. Cor of Property

Ground Rock Tank # 1

(Continued on Page 49)

Caroline street 527. measured 527.6
Angle Caroline and Columbus $90^{\circ} 58'$

~~AS~~
~~AS~~
INDEXED ON MAP
593


surveyed May 17
for Margate

Bradley

Lot 2376

W. F. Montgomery

Wm. Smucker

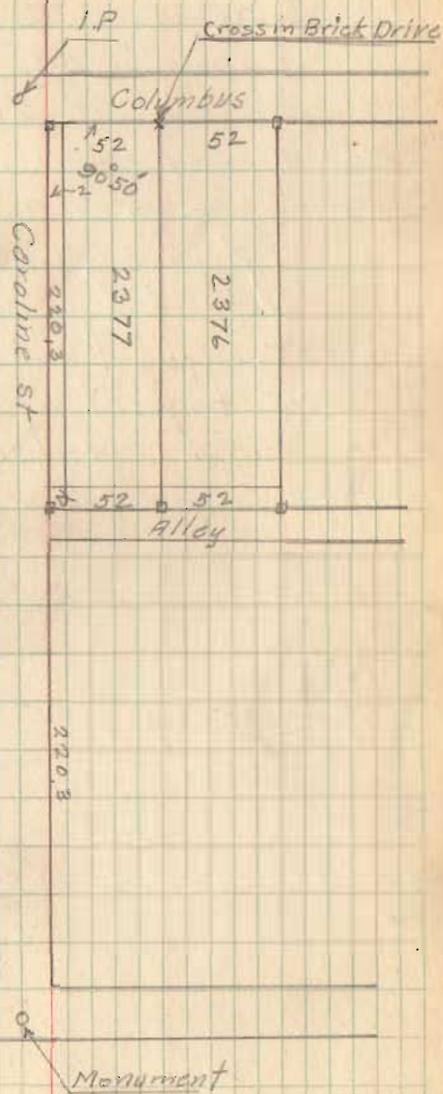

Measured on Caroline street

Excess 0.6

set nail at 261.30


Turned angle $90^{\circ}50'$ set stakes at A, B, and C.

at D found cross in Cement .15

West of my measurements

at E found hub with tack. also .15 to west of point. it should be.


Found old stake at C. O.K.

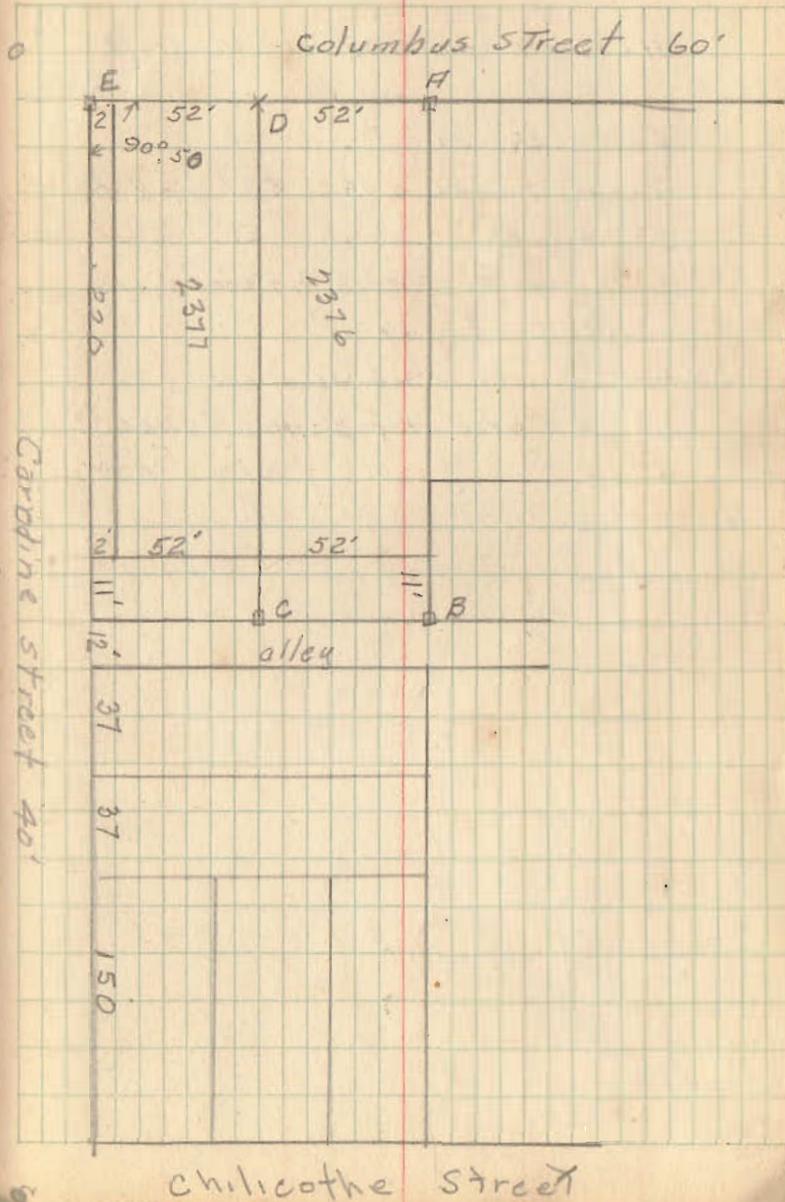

- A = Corner of what was formerly I.S. Gardner's Corner.
- B. I.P. Driven
- C. I.P. Driven 1143.6' East of Q Elems St
- D. I.P. + stk.
- E Corner to E Wood's Lot see Survey Record Vol C p 344
- F. I.P. see same as above
- G I.P. Driven 47° 44' from Q T40C Main Tr.
- H I.P. " " " " " " " " " " " "
- M. Point 21' at Rt angles from Q T40C Intersection of T40C R'taway and North line Columbus.

INDEXED ON MAP

594

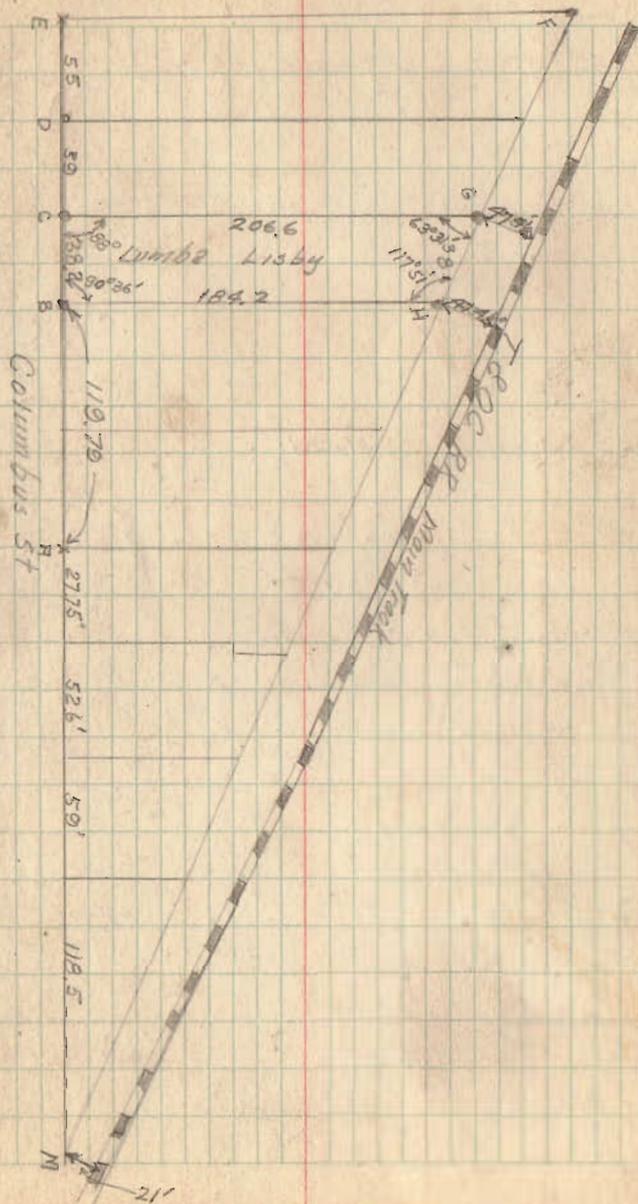

Lilly White Oil Co.

(Continued from Page 45)

- A - Small square iron placed
- B. Pipe placed.
- C " "
- D " "
- E Iron "
- F 2" Iron Pipe placed.

See John Fox Survey Book 263

See Lilly White Survey Book 385


See Wood Survey Book C Page 344

See Elizabeth West Survey Book 51

See Page 48 This Book.

See Book 480 Page 7

Iron & Garfield and
Everett - See Book
385 - Page 6 for
references.

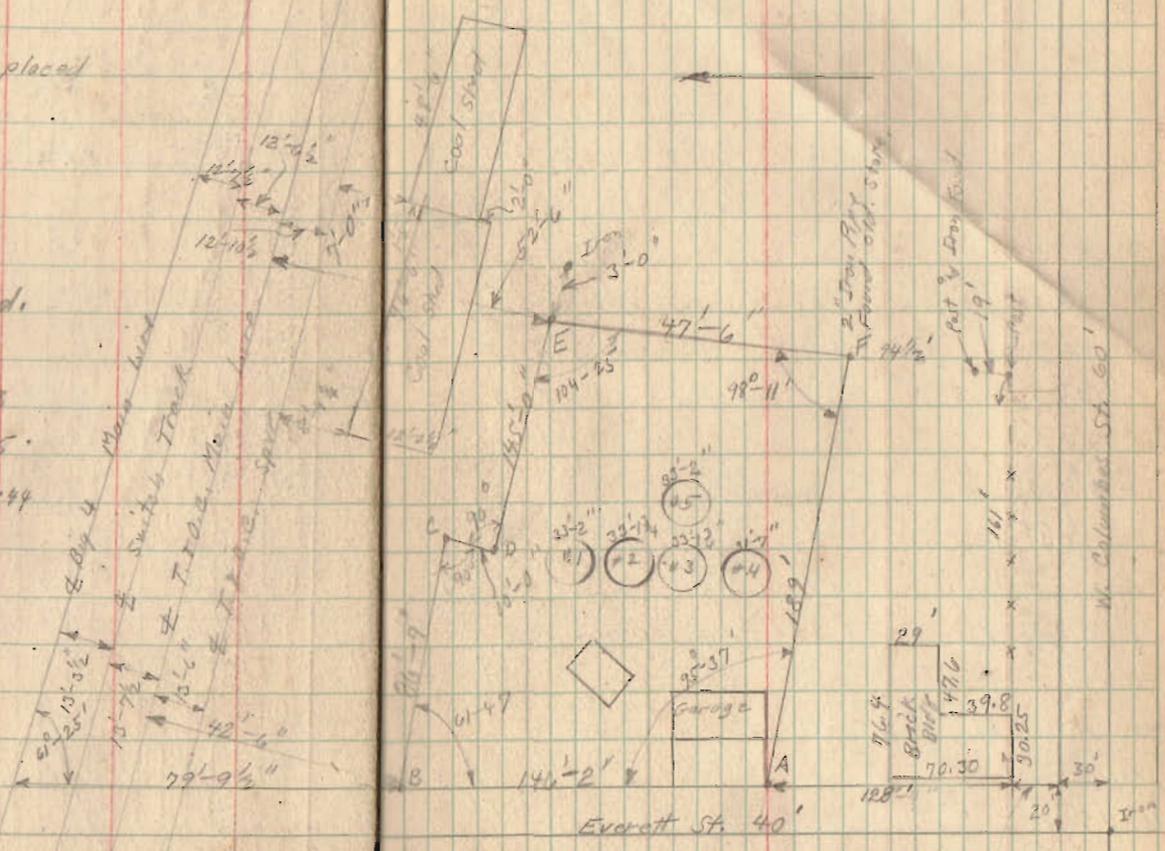

595

INDEXED ON MAP

Wright
Smucker
May - 11 - 1926

Lilly White Oil Co. (continued)

Deborah Fox To John Adams 95 - Page 411

" " " T.O.C. 101 - Page 405


Iron found near Point E. This iron was 52'-6" from $\frac{1}{2}$ of $\frac{1}{2}$ of T.O.C., in book 51 in road survey (May-1907) it states stake was found in Right of way line. I used this distance and run line EP $\frac{3}{4}$ of CB parallel with $\frac{1}{2}$ of T.O.C. Track.

Note in deed book 101 Page 405 the 60' and 50' strip are run parallel with T.O.C.R.R. This jog CD. is said to be 10' East from a point N. of N.E. Cor. of residence. Residence is now entirely gone. Mrs. Felispie (?) a colored lady, now living on the West side of Everett St. (over to next page)

Part 4 Main Road
 Subdiv
 T.O.C.
 Subdiv

May-1926

50

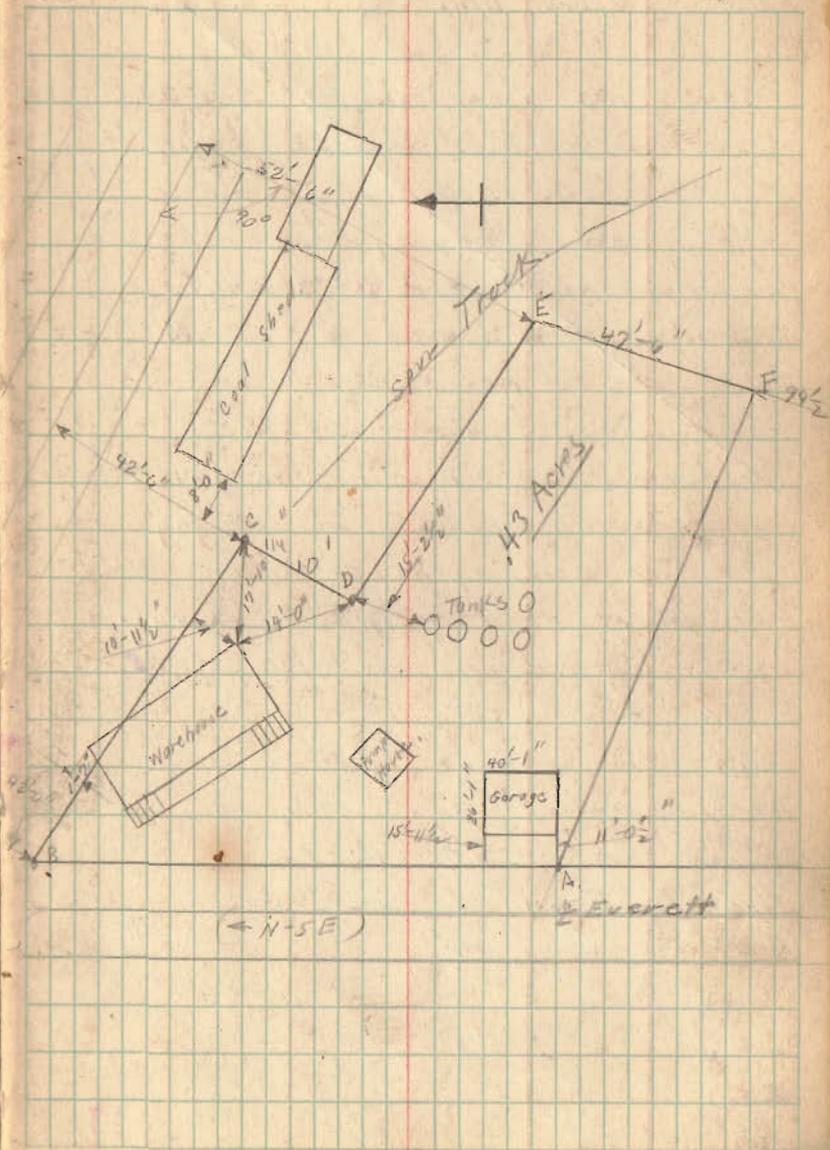

Lilly White Oil Co.


Says she lived in the old John Fouse residence for 22 years. She told me this was a large house and a large yard and she believes the corner of the old house was near where #1 Tank new stands. There are no measurements given for this jog (except from house). I made jog as shown believing it to be at or about where original jog was.

J. J. W. J. 19, C.E.



After this survey was made a track map was found showing some distances from track. See Point in Drawer F-64. No change was made in survey. J. J. W. J.

May 1926


51

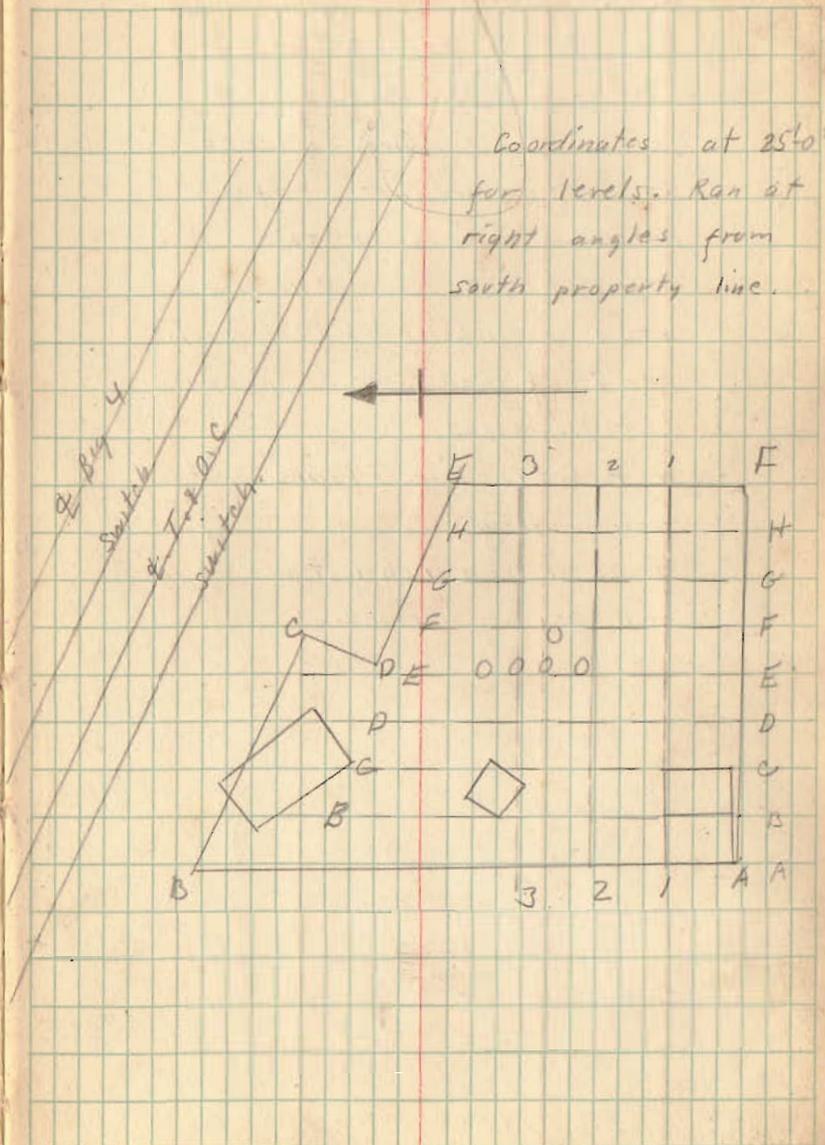

Coordinates at 25' 0" for levels. Ran at right angles from south property line.

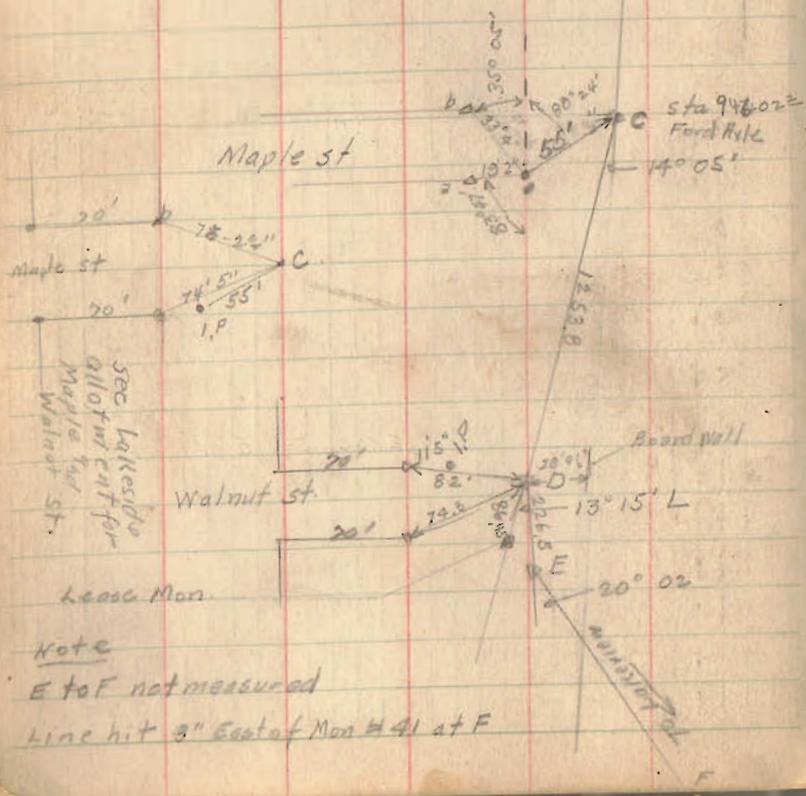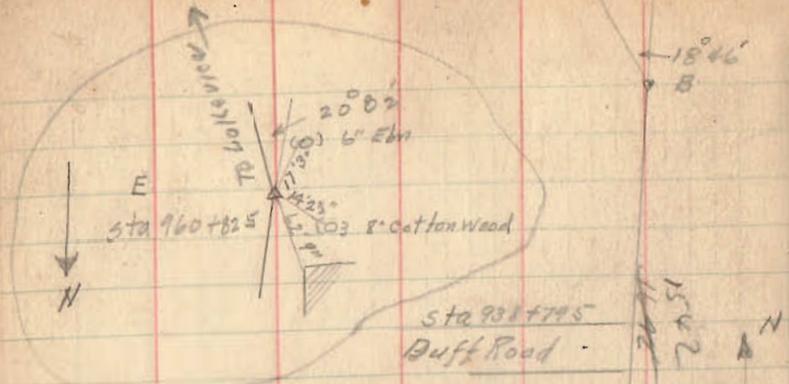

Note
 E to F not measured
 line hit 3" East of Mon H 41 at F

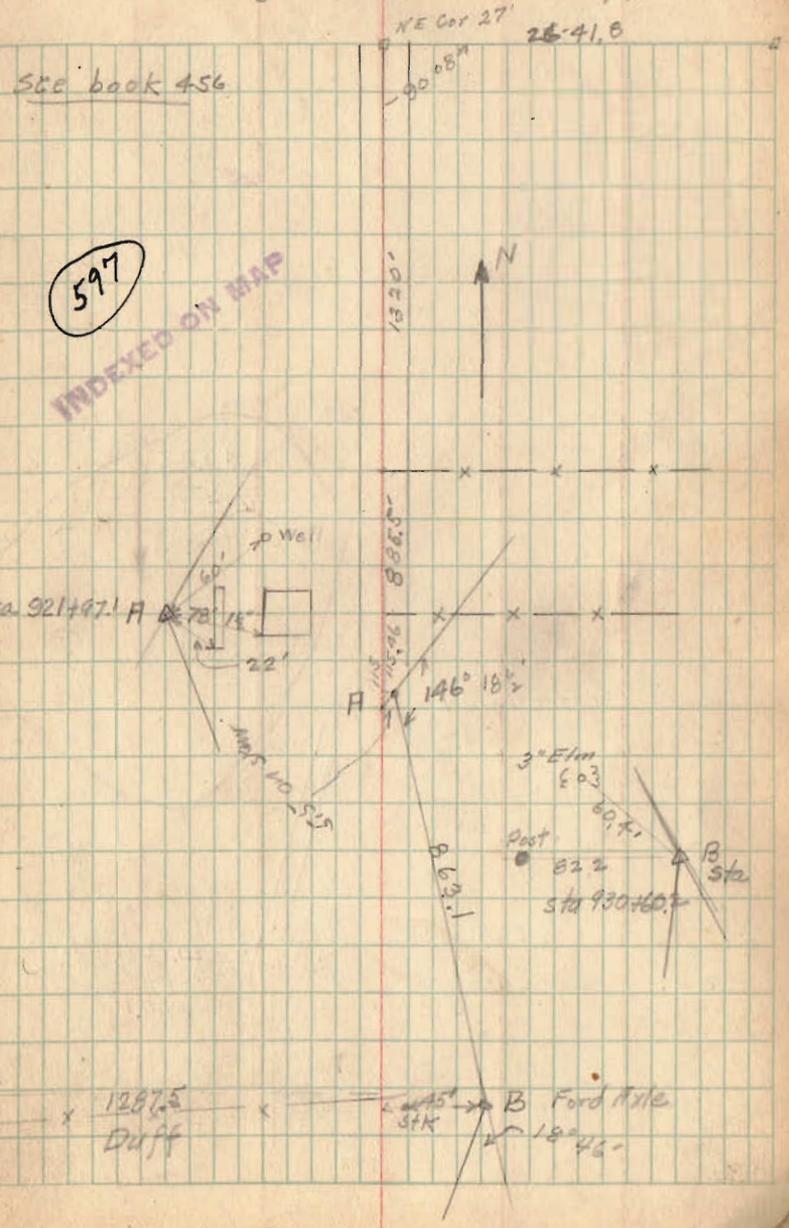

597

INDEXED ON MAP

Bishop Survey Lot 1534 N. Detroit

A. Iron & of Sts. Witnessed

Hydrant S.E. 25'-7"

Curb N.E. 22'-7½"

Brick Cor. of Park S.W. 51'-0"

Center of Men Hole N.W. 4'-4"

B. Monument with Corner

C-O-E-F-G-H - See Page 28

I-J-K-L Irons Placed By Wagon

M. Old Iron Found used for here.

N-O - Hubs Placed on here.

Set on C - Sighted To M. making C-I-O
N-M-L a straight line.

Set on H. Sited on G. and set K

There is fence on J.K. which is
O.K. for here.


IL = 142'-0" CE = 60' O.K.

JK = 142'-0" HJ = 60' O.K.

All measurements shown made in field.

See page 28 for survey of Lot 1558

June - 3 1926
2129
Wing 41
Ed. Core. 55

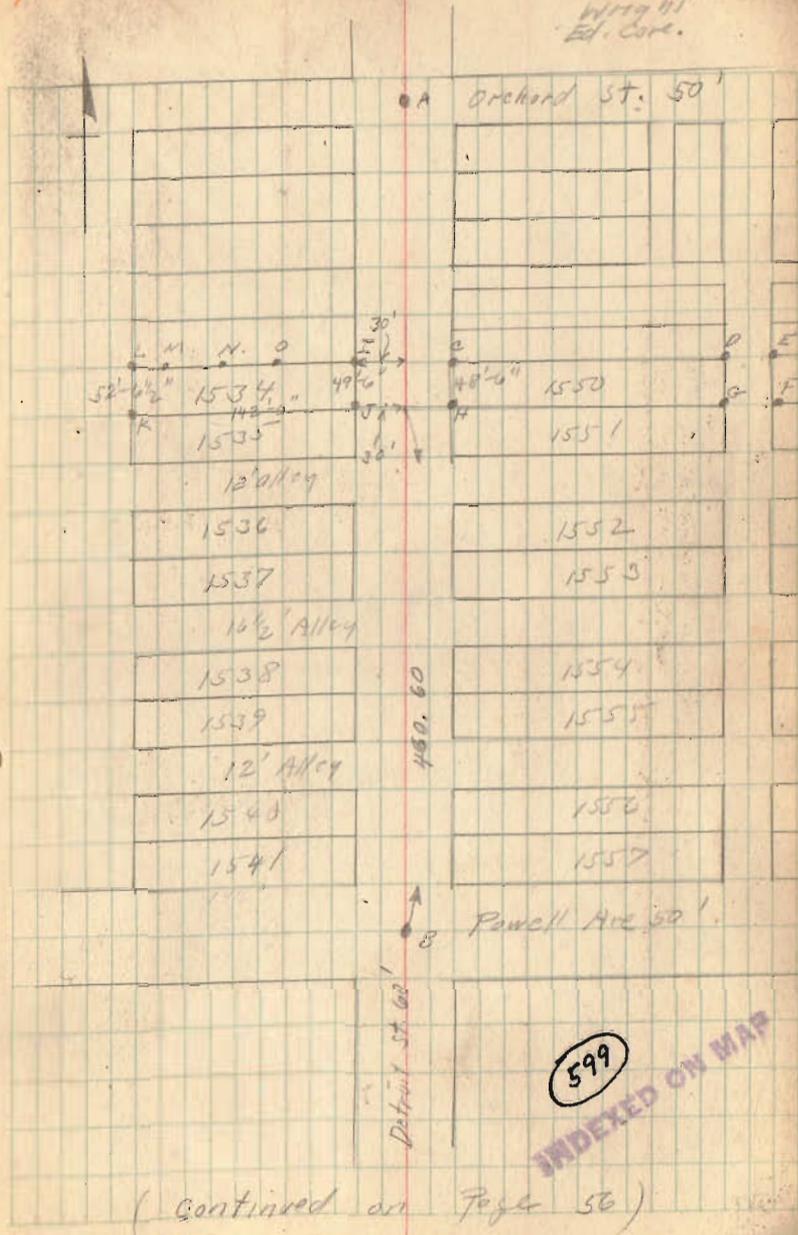


(Continued on Page 56)

Gay Survey Lot 2178 ^{and} 2177

June 3-1920
Wright
Ed. Carr, 57

- A. Iron Pin found.
- B. " " "
- C. " " " and witnessed
 To 15" Poplar N.W. 26'-4 1/2"
 To 6" Ash N.E. 25'-1 1/2"
 To 4" " N.E. 37'-3 1/2" Cantwell Ave 30'
 To E. edge of E. Walk (Produced)
 on Madison 26'-8 1/2"
 To N. edge of N. Walk (Produced) on
 Cantwell 14'-11"
- D. Iron Pin found and witnessed
 To Hydrant N.W. 40'-6"
 To 2" Maple N.E. 28'-4"
 To S.W. Corn. of Foli. N.E. 50'-6"
 E. edge of E. Walks (Produced) 23'-4"
- E. Pipe placed by Wright
- F. " " " "
- G. " " " "
- H. " " " "
- I. " " " "
- J. Ford Axel Plead "
- K. " " " "

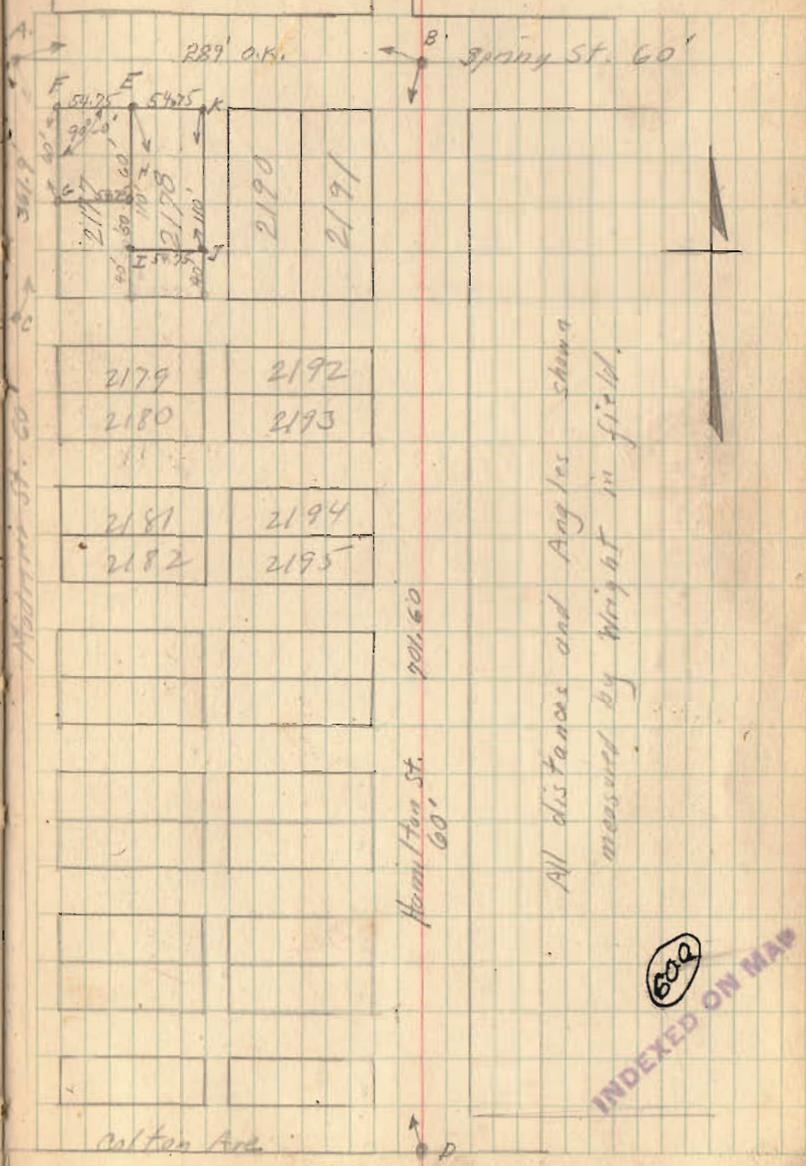

INDEXED ON MAP

(over)

Guy Survey (Continued)

see Page 57 for Location.

Sarah P. Guy Vol. 120 Page 183

All of Lot 2178 Except 40' off of South

Vol. 127 Page 60

60' off of N. End of Lot 2177

June 3-1926

58

