


Road 19 Bokes Creek Twp  
Road south of Ridgeway

Stakes placed 50 feet each  
side of E.

Stakes placed about 250 feet  
apart. no measurements made along  
road.

1303  
INDEXED ON MAP

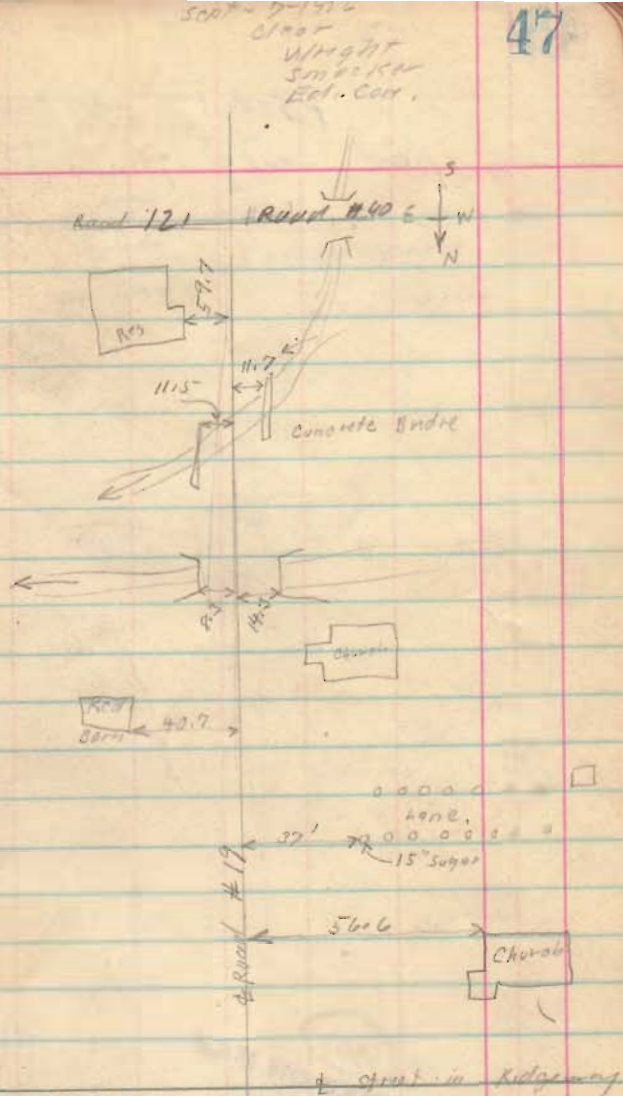

Road 19  
Road south of Ridgeway.

Parcel # 117

6" → 0' → 23.30  
From → 36.7 Tashed.

From  
McS → 45.55

34.4 to Downy Sycamore

2 Story  
From  
Concrete  
Studs  
Refrigs.

Rcs  
0.2m  
20' 0.4k  
22.7

20.38 Rcs

$\Delta = 120-15'$   
 $T = 140'$   
 $EX = 6'$

(1303)  
INDEXED ON MAP

Road # 121

Road No 40





Road # 19 Bakescreek Twp.  
Stakes at Bell farm for Fence.

Used  $\frac{1}{2}$  of gravel and set  
stakes  $22\frac{1}{2}$  North for fence.  
No monuments used.

45' Road.

Noted gravel was o.k. for line  
for perhaps  $\frac{1}{2}$  mile.

1304  
INDEXED ON MAP

June-11-1928  
First day  
Wright  
Ed. Core.

