

Road 9 (Rushsylvania Pike)

Lake - Jefferson & Rushcraft Taps.

60' Free Turnpike Record
3 Page 238 1893
Map Book H Page 56
Profile Vault.

Hand Surv
Book 493
Page 72
M.S. Adams
C.B. Rogers


1545

INDEXED ON MAP

Feb - 20 1934
cold - yes.
Cranes
and Cars
Organ
Path fields
Hunt
Running

N 33° 17' E

Monuments
placed as shown
30' from E for 60' Road

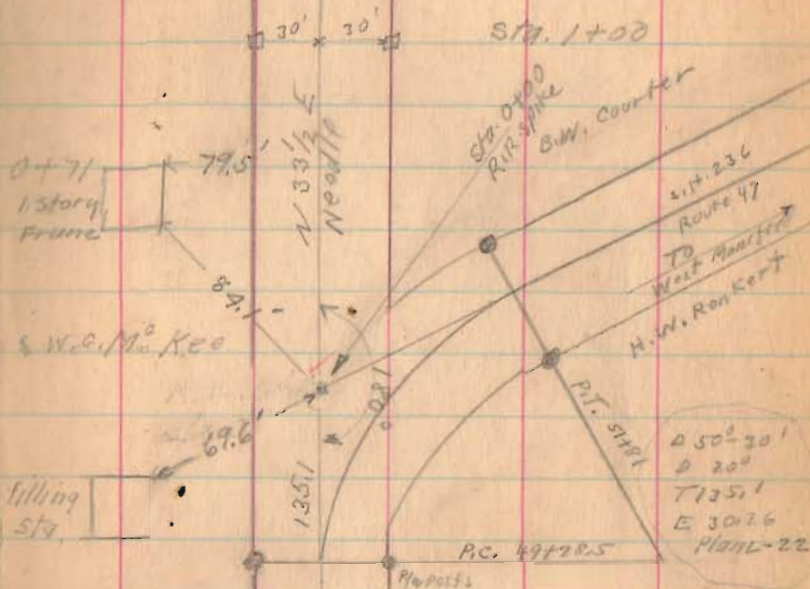

filling
Sta.

S.W.C. Ma Kee

Sta. 0+00
R.R. Spike
S.W. Counter

Sta. 236
Route 47

TO
West Mansfield


H.W. Ron Kent

P.I. Sta. 1

Δ 50° 30'
D 200'
T 135.1'
E 302.6'
H 101.22

P.C. 497.2

9/16 posts

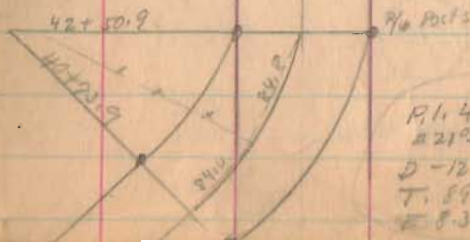

9/16 posts

R.I. 41+63.4
Δ 210° 44' - Plan
D - 120'
T - 89.64
E - 8.38
L - 22

Road 9



2-28-34

12

N 35 1/2° E
Neddie

Harrow Tooth
15+65 Angle
01° 53' R.

14+50

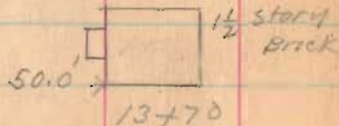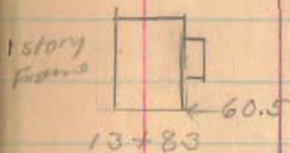

Wm Chris
13+13
x
Roy Alberts

N 33° - 17' E

10+50

6+80 Lane

Roy Alberts
x
6+75

1545

INDEXED ON MAP

Sta 5+00

Road 9

2-28-34 18

31+00

26+00

Roscoe Baldwin
Lane

25+43 Delaughder
25+45

N 35° 10' E

51.0' →  1-story
house
21+94

21+50

20+42 stone Arch

Delaughder

20+16

B.W. Courter

M.O. Entarline

19+79

Wm. Ohns

16+00

N 35 1/2° E
N 30° E

1545

INDEXED ON MAP

Road 9

2-28-37

N. 35° - 10' E

55+00

47+50

13 13

44+69 Stone Arch

43+78 E Drive

43+00

G. Hustlin
Mo. Enterline
37+58
39+59

G. Hustlin
R. Baldwin

1545

INDEXED ON MAP

37+00

Road 9

R/W Mon
Sta. 68+00

1/2" bolt
hex. nut
Set
Sta. 62+68.5

S. 68°-50' E.
340.0'

88°-00'

1/2" bolt
hex. nut
Set

S. 32°-30'

W.W. Windham
to
Don E. Edgington

2.20 Acres

2082

INDEXED ON MAP

R/W Mon
Sta. 61+00

N. 35°-10' E.
204.67'

S. 53°-40' E.

1/2" bolt
hex. nut
Set
Sta. 58+95.5

S. 88°-53' W.
472.7'

10" x 6" W
H. Side of
Fence

Surveyed for

D.E. Edgington by
D.E. Dodson
V.E. Detrick
April 4, 1932

1545

INDEXED ON MAP

N 35°-16' E

N 35°-16' E
Needle

81+00

76+16 & DRIVE

76+02

75+00

Found bent R.R.
Splice - Replaced with
1" iron pipe.
6/7/61 D.E.T.
D.H.L.

Iron
70+00 Angle
0° 06' Right

68+00


61+00

N. 35°-10' E

J.H. Elliott
G Austin
58+95

Road 19

W.W. Windham
to
Clarence Edgington

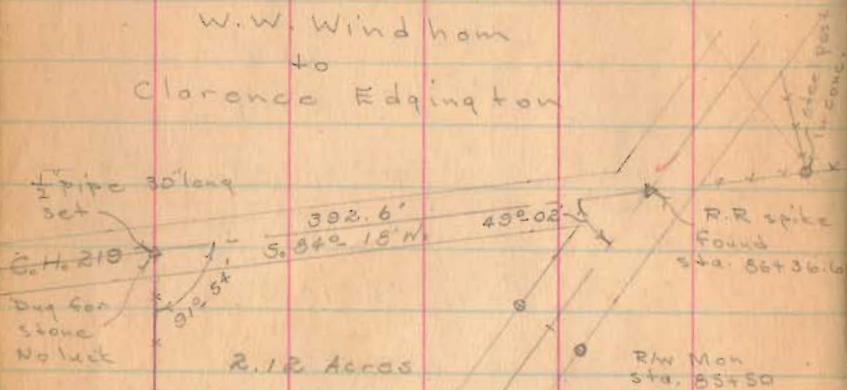

INDEXED ON MAP

2082

Surveyed for
C. Edgington by
Dan E. Dodson
Vinton E. Detrick
April 4, 1958



R.W. Mon
sta. 84+00

1/2" bold-hex. nut
1 1/4" long set
Sta. 84+3.8

1545

INDEXED ON MAP

2-28-3

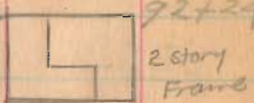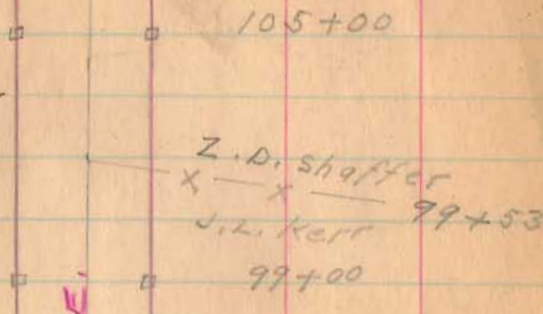

Wilson Pitts
X
G.C. Meredith
X
88+27

G.C. Meredith
Road 219 86+36.6
X
G. Austin
X
87+00
X
J.L. Kerr
X
J.M. Elliott
X
86+36.6
X
85+50

N 35°-16' E

(R.R. spike found 4-4-53 D.E.D.)

Road 9

Crane
Ed Carr
Hatch
Bugs
Hunt
Kenny

March - 1 - 1934

clear - Warner

17

Mon 121+20
Iron
1/2 story
Frame
120+23 ← 58.9 →

J. W. Lawrence
S. Cordrey
116+51

J. W. Lawrence
x — x — 121+47

E. C. Balliett

121+09 A 17/2
0° 12' Left

117+10

117+23
60

30

115+50

N. 35° 38' E.

108 →

1/2 story Frame

119+13

Sarah Cordrey

111+93 — x — x

W. Pitts

111+00

E. C. Balliett

x — x — 109+10

Z. D. Shaffer

105+64

x — x

+ lane +

105+39

1545

Road 9

42.39
32.14
1025

1545


INDEXED ON MAP

5-1-34

23

Frank Hope
142+64
J. Austin
142+39 Drive
Sarah Cordrey

Sarah Cordrey
J. W. Lawrence

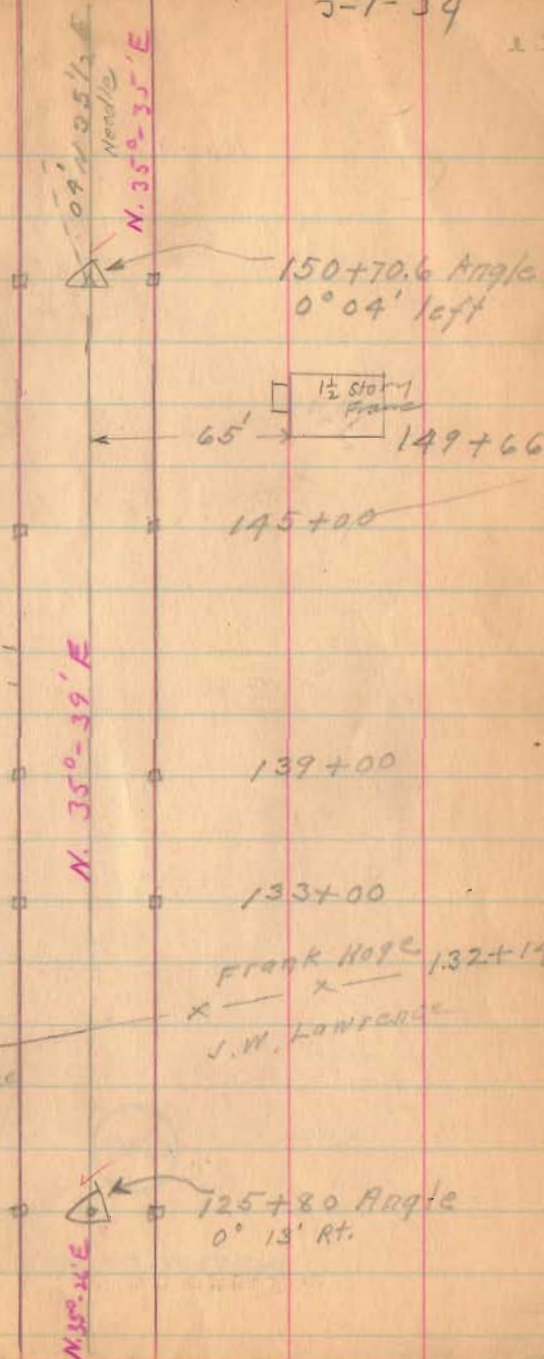


Road: -9

30.10
18.20
11.90

1545

INDEXED ON MAP

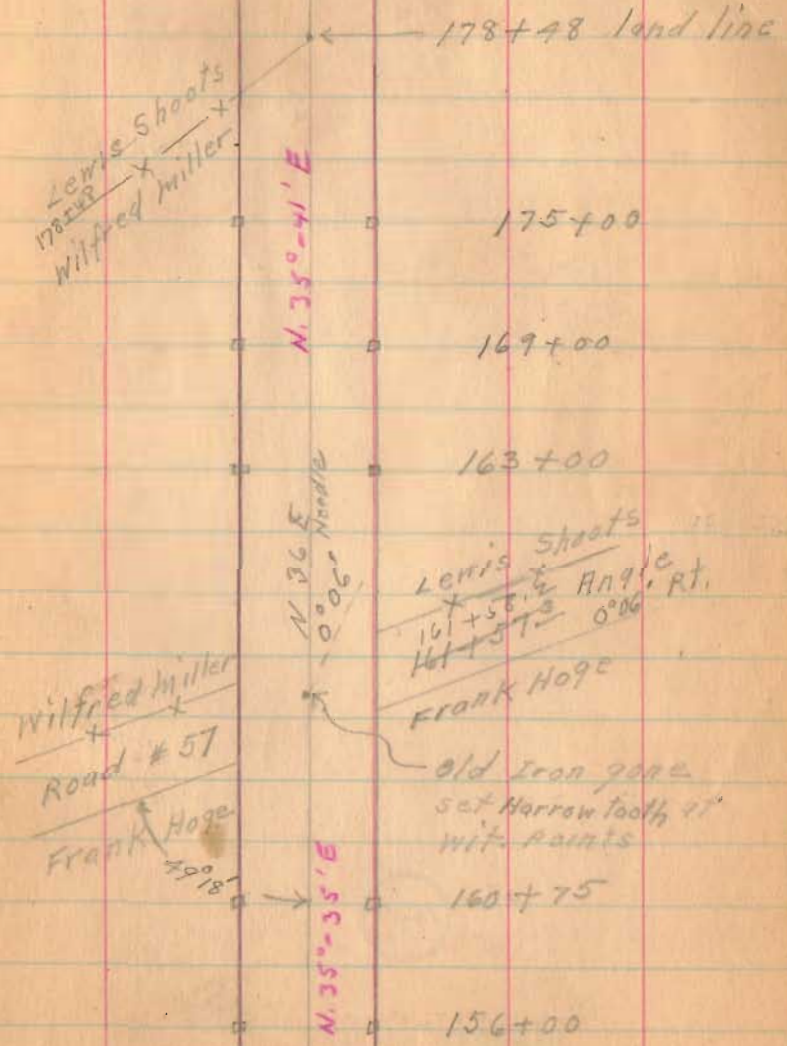

Road 9


To
Harper

1545

INDEXED ON MAP

3-1-34

21

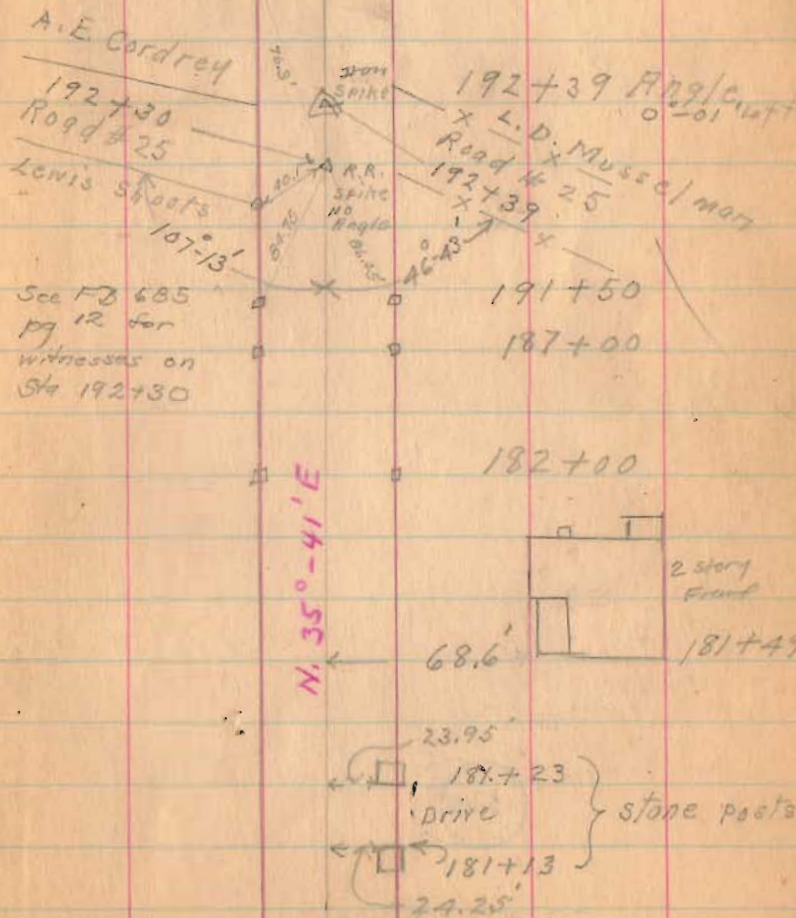

Road 9

221+00

215+00

1545

INDEXED ON MAP

3-1-34

21

Jas. Ansley
A.E. Cordray 220+08

Jas. Ansley x
218+47
Road No. 222

To Mod
city

218+04 x
Frank Hoge



See pg. 64
this book

N. 350+40' E

210+00

Frank Hoge 205+10
x +
L.D. Musselman

204+00

x + 199+66
Lone x + 199+01

198+00

N. 325'
Norda

Road 9

229+00

227+00

1545

INDEXED ON MAP

March 7-1934

cloudy - cold

Wright


Mills

Richardson

Ratfield

Henry


23

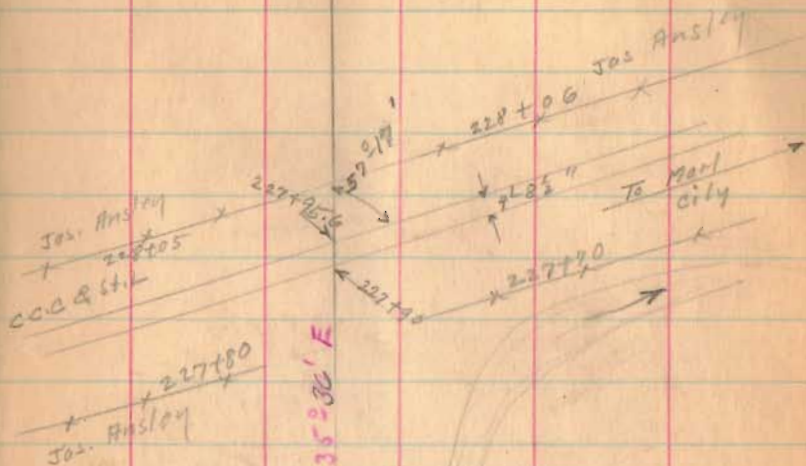

N. 35° 23' E



Iron
222+95
0.04

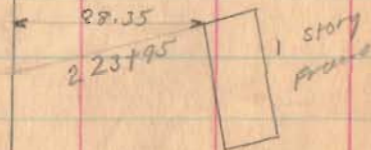

Road. 9

247+00

240+77

235+00

1545

INDEXED ON MAP


14106
14077
25

3-7-34

23

N. 33° - 36' E.

N 32 E.
Needle

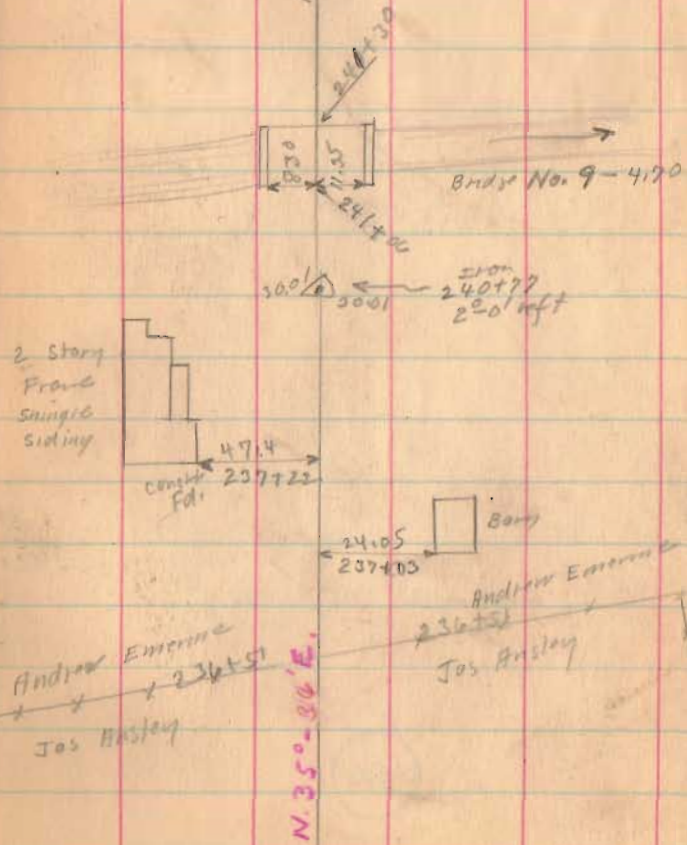

400 100 1000

Road 9

8163
6961
1202

281+63.5

90° Backsight

277+00

271+00

269+00

263+83.5

257+52

252+00

1545

INDEXED ON MAP

3-7-34

27

Large
Mound

31.9
Notch &
Spikes
2' above
ground.

R.R. Spike
269+61
No Angle

Iron
263+83.5
3° 30' Left

History
Front

N. 35°-38' E

N. 35° E

N. 35°-14' E.

N. 38°-44' E

N. 39° E

N. 33°-36' E

RR Spike
0-44' Right
281+63.5

20°-25'

100.0 Road
Puff

45.85
5.531 E

57.95
5.531 E

50.0
5.531 E

50.0
5.531 E

Frank M. Borden

Book 560
Page 57

118
Puff

118
Puff

Iron
257+52
5808' Right

72.50
251+69

Road 9

304+00

left Only

299+00



293+00

288+00

1545

INDEXED ON MAP

89-04 20

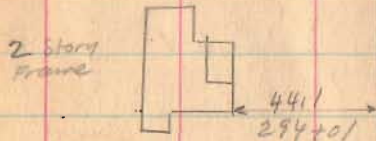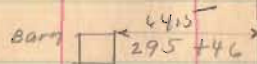


W. 35°-58'E

H. & M. Hooper
302+57
Lane
2
Frank M. Borden



Road 9

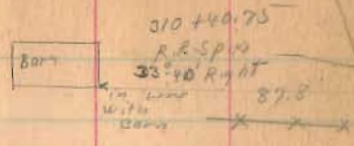


311+00 left only

309+44 90° from Booksite Right Only


306+28 Right Only

1545

INDEXED ON MAP

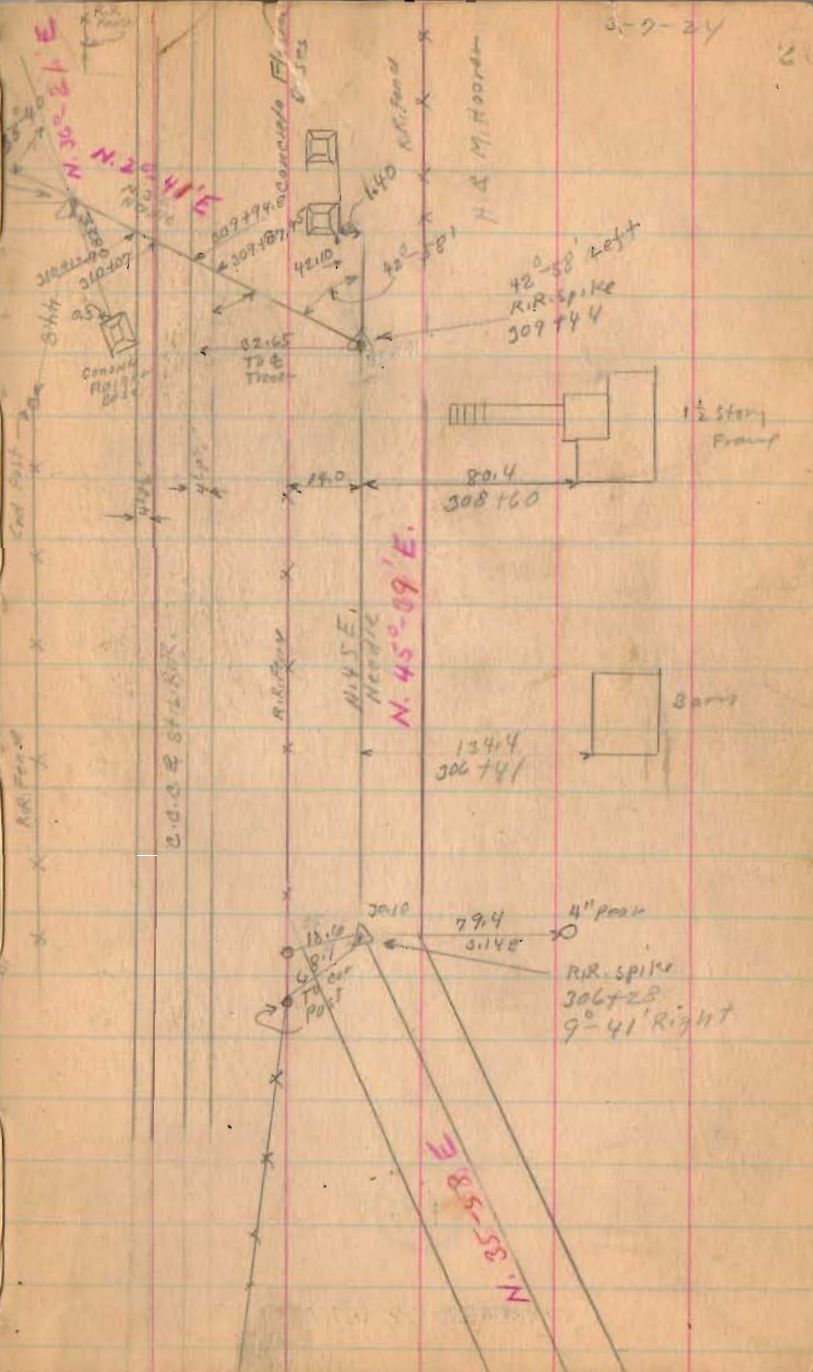

Road 9

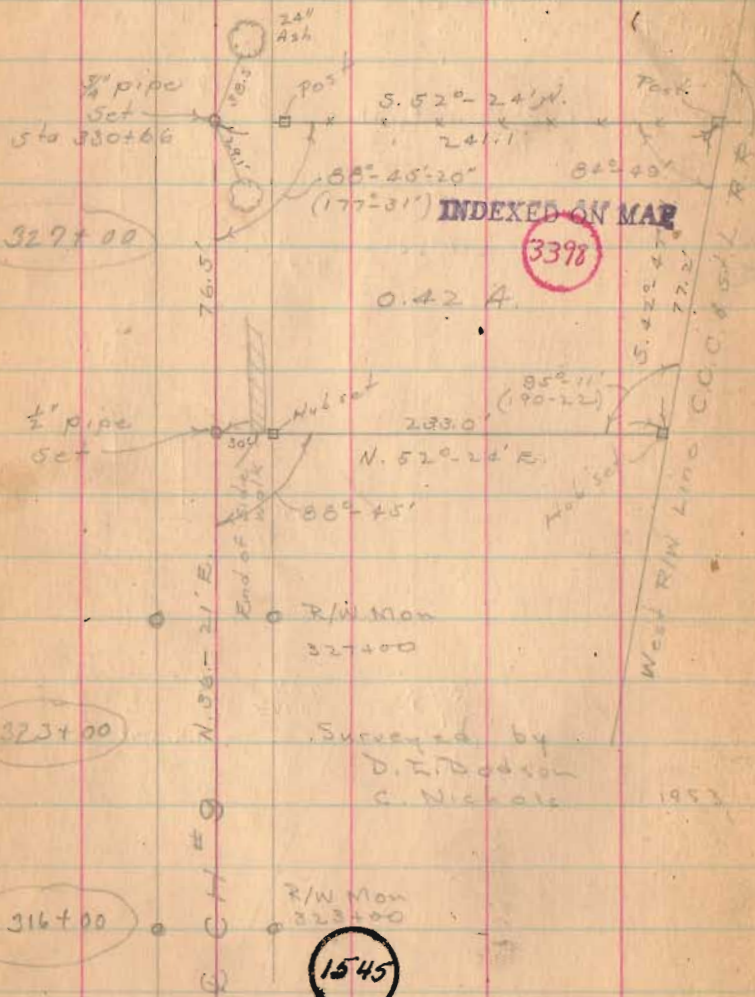

329+00

3398

0.42 A.


323+00

316+00

1545

INDEXED ON MAP

3-9-24

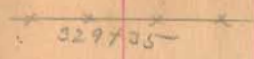

329+90
End of water



329+17

Continued on Page 49




52

Continued page 49

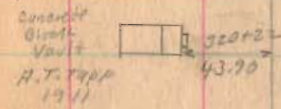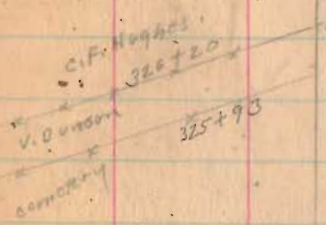

1897
R.M. Ausley
March 12
1897

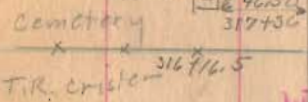

N. 36°-21' E


Road. 9



(See Book 501 for Street
 Survey Rutherford Ave)

INDEXED ON MAP

1545

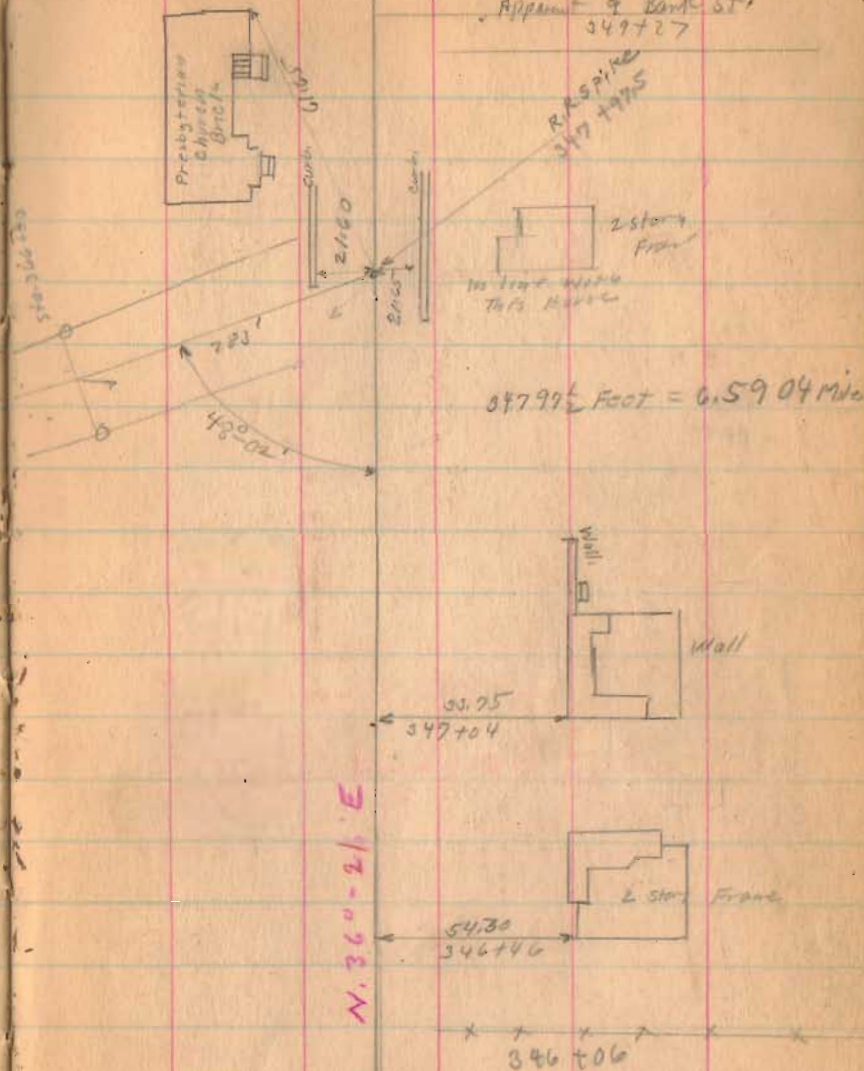

Sta. 330+00 TO 346+06
 See Pages 49 TO 52

Road 9

March 28-1934
Year - odd 29
Very Heavy frost
Winged
Mills
Rathfelder
Richardson
Henry

Apparent &
Rush St.

52+95
Apparent &
Euclid St.

N 36° - 21' E

1545

INDEXED ON MAP

Road-9

3-28-34

x 364+41 x

x 362+46
CCC 294.

N 36°-21' E

x x 364+39 x (31)

x 362+02 x

vic. Padmont.

South Track

358+35 & between
Two Main Tracks

Apparent & 357+09
Miami Road.

357+24
Apparent & Rail Road St.

N 36°-21' E

1545

INDEXED ON MAP

Road 9

371+00







Right Only

368+00
25
367+78

1545

INDEXED ON MAP

0-28-34 31

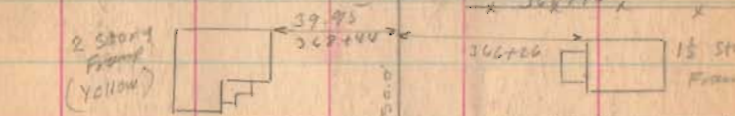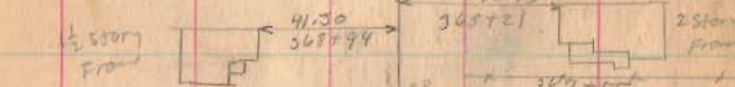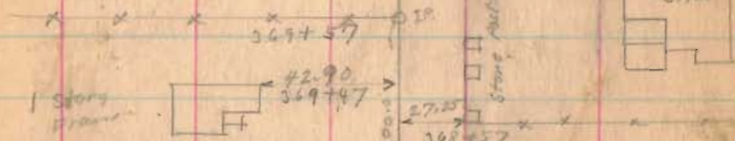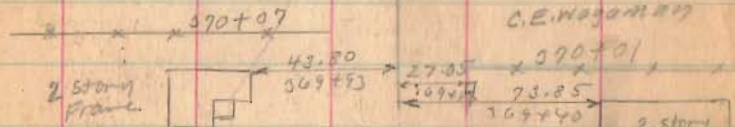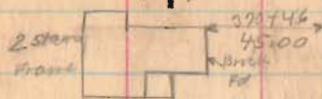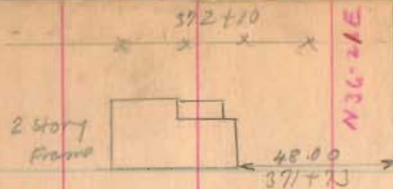

stations O.K.
foot scale

N-36-21E

Road 9

379+00

374+70

1545

INDEXED ON MAP

8-28-34

32

2 story
Frame



109.40
381+55

F. E. Padon
O. P. Snyder

F. G. Leidigh


a. w. Snyder 381+30

115.10
377+53




RESERVATION 376+11 ± WAS

L. O. W. Snyder
Wm. Rollins

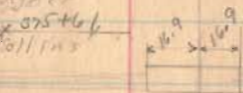

O. W. Snyder 376+00
C. E. Waples

Stone 18624
375+61

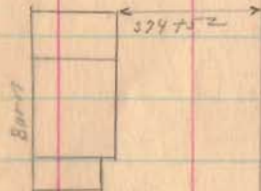

Wm. Rollins
372+70



N. 36-21 E.

BLANK MAP

Road 9

393+38

391+00

384+00

1545

INDEXED ON MAP

3-22-34

33

Iron
393+38
2nd Jct Right

N 38°-53' E

N 36°-21' E

HONZO EMBROID
394+81
Clara Musselman

30+02
35.90
393+28
Garage

53.40
392+44
1 story
Frame

Clara Musselman
388+87

FG. Leidigh

389+69
Stone Arch
389+25

HONZO EMBROID
FG. Leidigh

111.0
388+06
1 1/2 story
Frame

High Mast
384+91

386+00

FG. Leidigh
LIE. PHARMACY
382+76

3-22-34

Road 9

415+00

409+00

404+00

399+00

1545

INDEXED ON MAP

8-28-34

37

N. 39-14 E.

50.00

406+60



1 1/2 story
Frame

one
stone cap
gone



Stone Arch

Iron
40' x 75'
0° 21' Right

measured to
wall not cap.

N. 38°-53' E.

Road 9

434+50

431+00

O.C.C.R. ST. L.R.R.

426+00


1545

420+00

INDEXED ON MAP


3-28-34

35

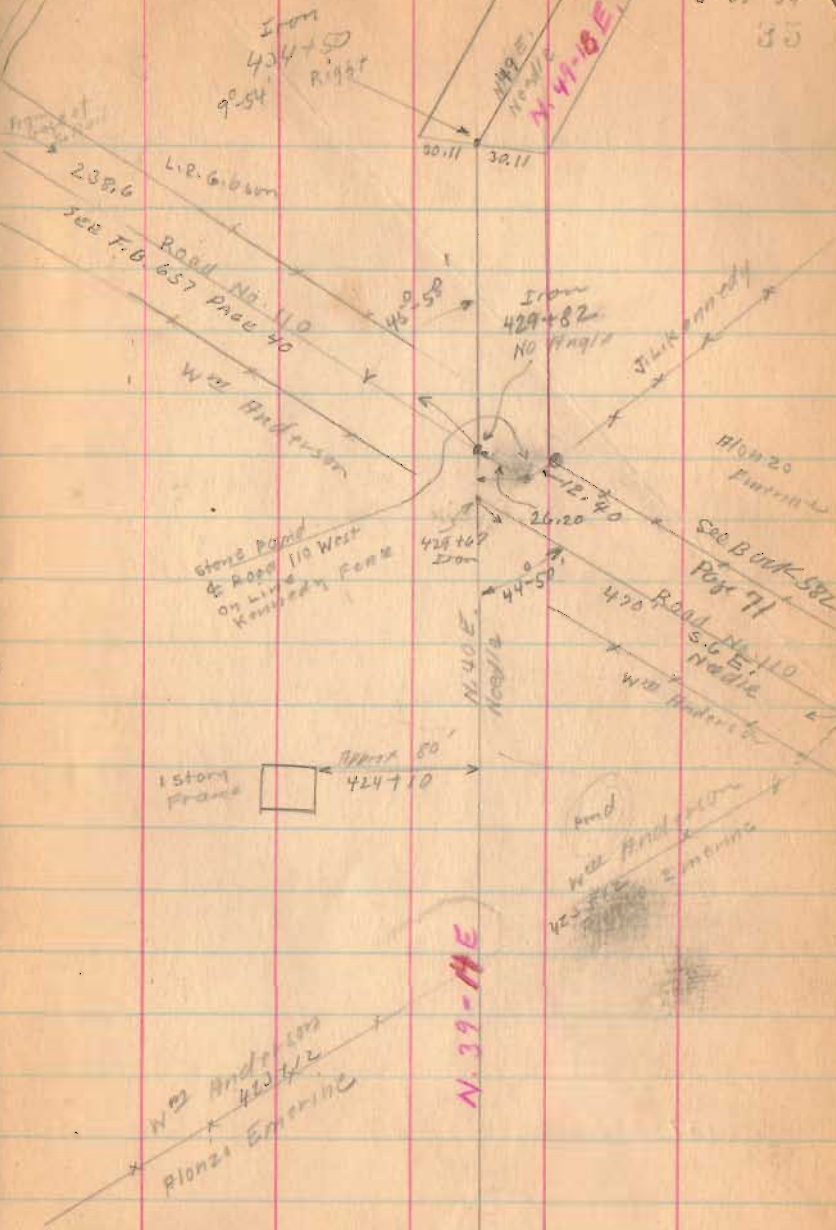

Road 9

Iron
440+52
41°35' Right

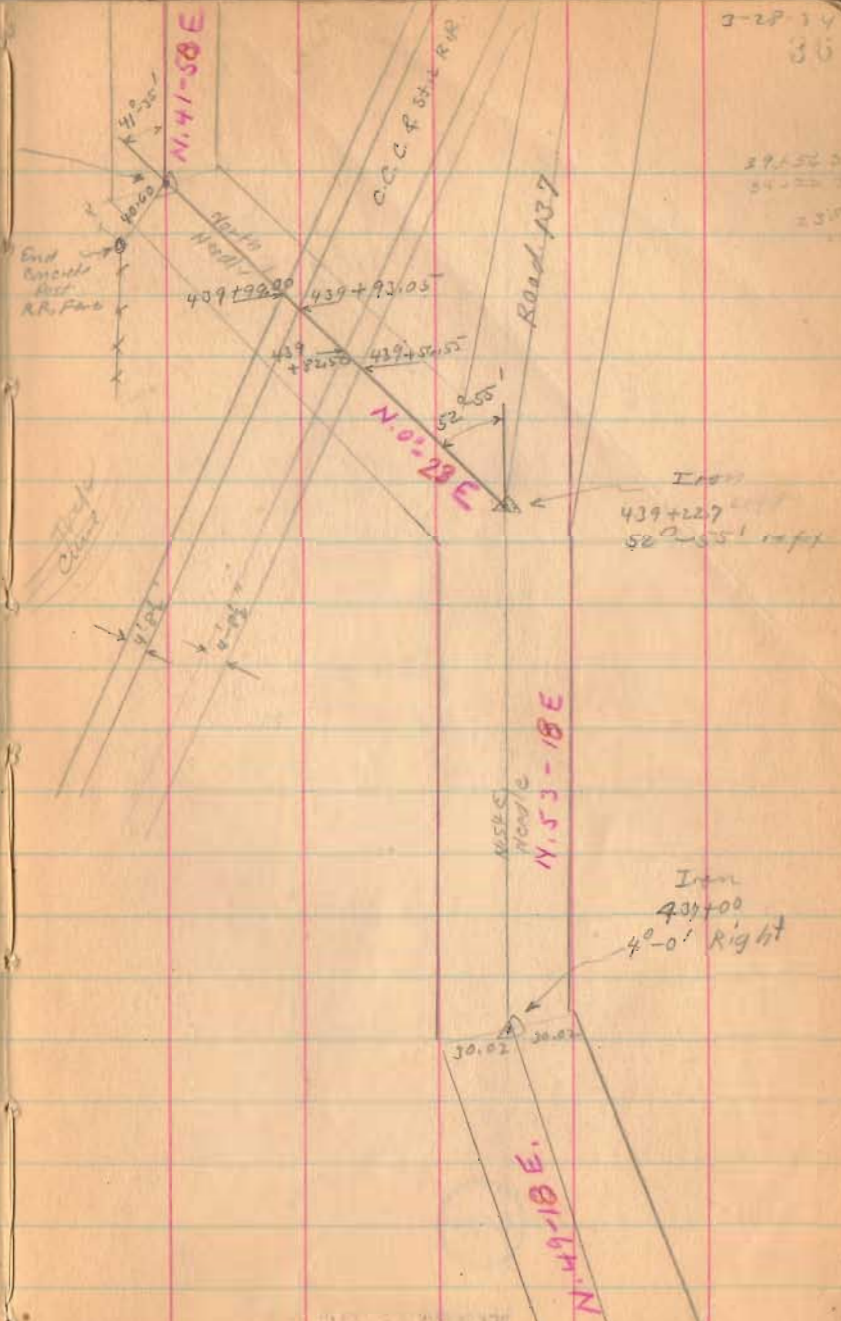

3-28-14
36
27-52-24
34-11-17
23'

440+52

Left Only 90° from fence

439+22.7

Right Only 90° from fence

437+00

Right Only

1545

INDEXED ON MAP

Iron
439+12.7
50°-55' right

Iron
437+00
4°-0' Right

30.02

Road 9

446+00

446+00

Right Only

446+02

left only 90° from Box side

449+00

Right Only

455+75

452+20

449+00

443+00

1545

INDEXED ON MAP

March 29 1934

Clear - Nice day

102 about gone

Wright

Mills

Ratcliffe

Richardson

Henry

NOTE:

Sta. 460+02 - OLD IRON BAR

FOUND BENT - REPLACED WITH

5/8" IRON BAR - APRIL 22, 1972

D.E.G.

460+02

Iron

2'-03" left

N. 40-12E

R. Gibson

57.0'

460+02

N. 42-15E

Jos Kennedy

456+06

J.J. Tropp

1 1/2 story
Frame

38.90

45+74

53.05

90° 10'

Iron Found

Iron Found

89.50

Iron Found

Iron Found

V.M.S. 9955

J.J. Tropp

442+89

W.D. Kennedy

V.M.S. 10041

N. 41-58E

Road 9

481+00

498+00

472+38

1545

INDEXED ON MAP

J.T. Titus


H.A. Robinson

480+44

480+85

lane

1 story
Frame

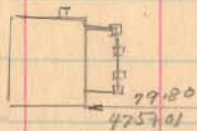

N. 36-00-E

DO
472+38
42' 4 FT

N. 36-E
N. 40-E

H. Robinson

R.R. Fegan

750
LINE

H.A. Robinson

Jos. Kennedy

30.02

30.02

N. 40-12-E

R. Gibson

road. 9

493+08.5

488+00 left only

487+72 Right Only 90° Backsite

487+00 left only

1545

INDEXED ON MAP

(Emerging Survey 9-20-05)
Book 384. Page 73

1 1/2 story
Frame

8 1/2" x 6 1/2" Clms.

54.90

493+01

30.00

30.00

N. 31-59 E

N. 35-29 E

N. 36-00 E

Large White oak

495+16

Iron Found
493+08.5
3°-30' left

Stone Found

487+72
0°-31' left.

Dalton Amrine

487+29

lane

487+58

Titus

Stone No. Angle
487+72
& lane

12" shell/bark
Hickory

30
487+90
N. 79 E P.L. Brugler

J. Runner

48.00

488+94

1 1/2 story
Frame

31.90

487+90

30

30

1 story
Frame

46.30

485+28


3-25-24

39


Road 9

1545

INDEXED ON MAP

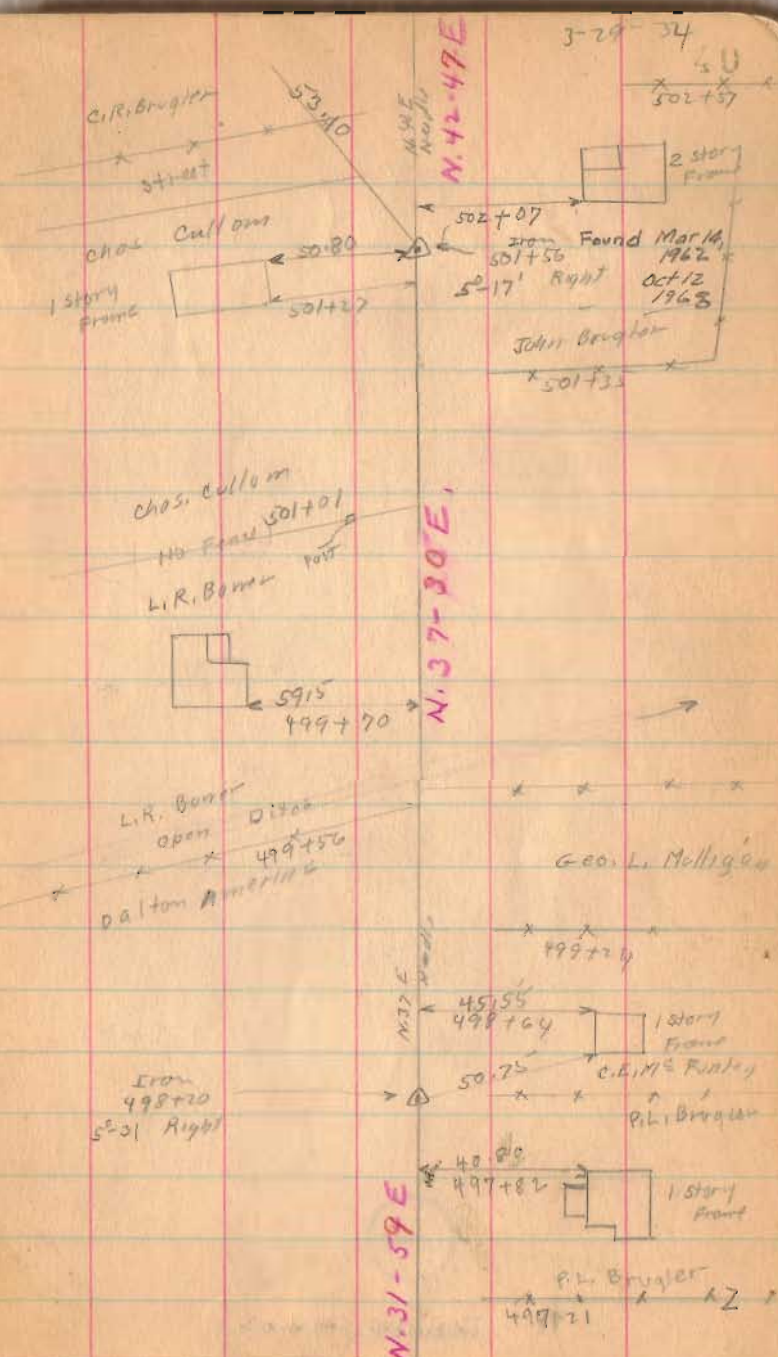

Road 9

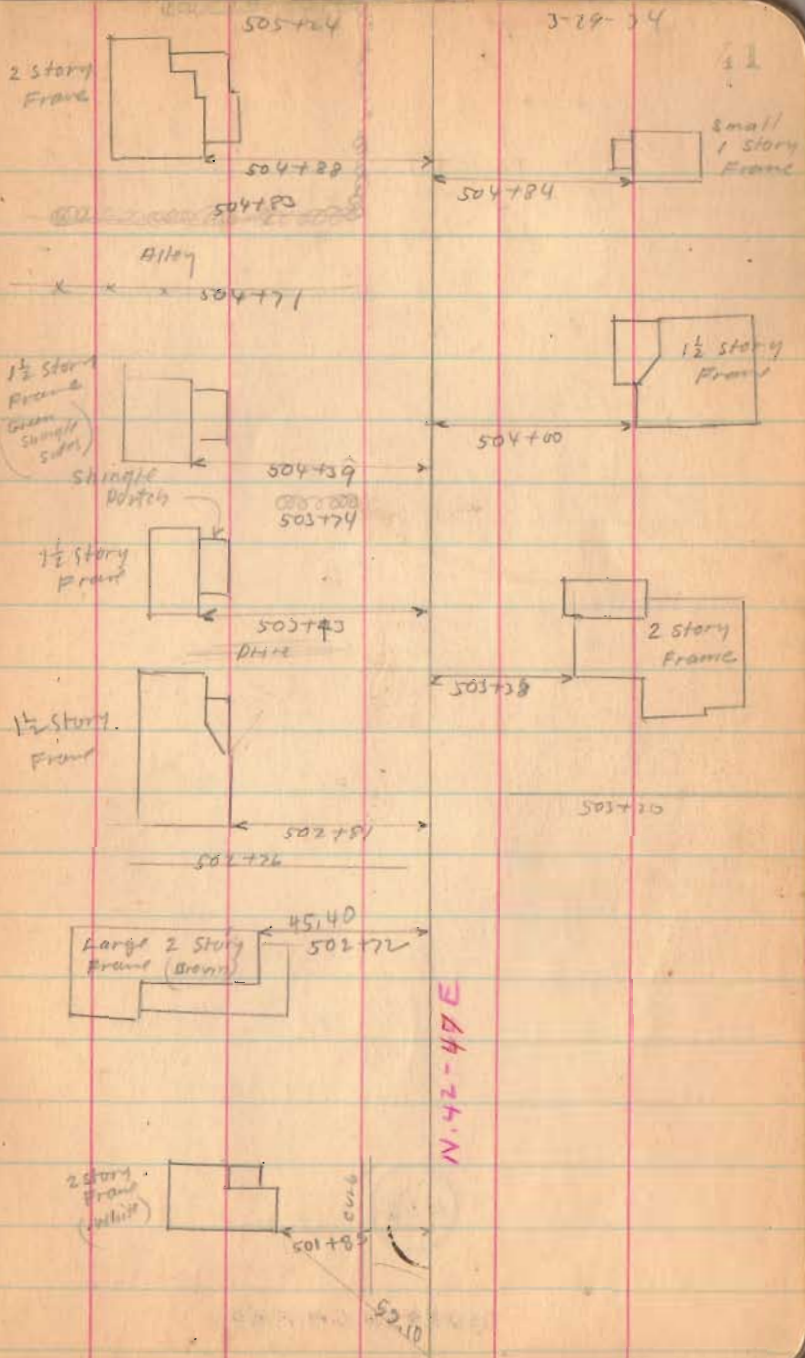

1545

INDEXED ON MAP





Road 9

1545




INDEXED ON MAP

3-29-34

23

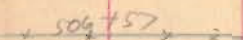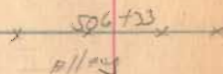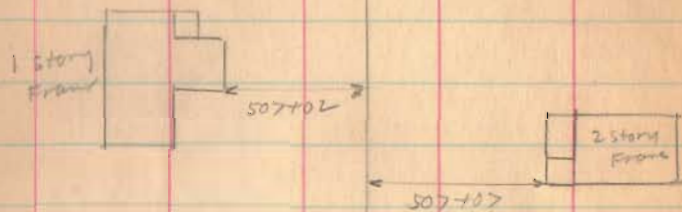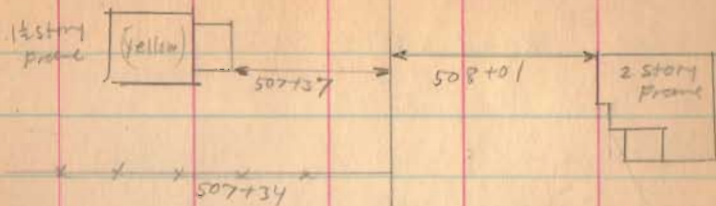

N. 42-47 E.

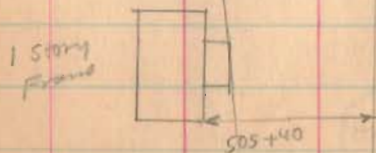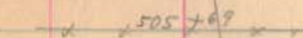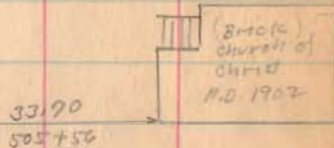


Road. 9

1545

INDEXED ON MAP

3-29-74

33

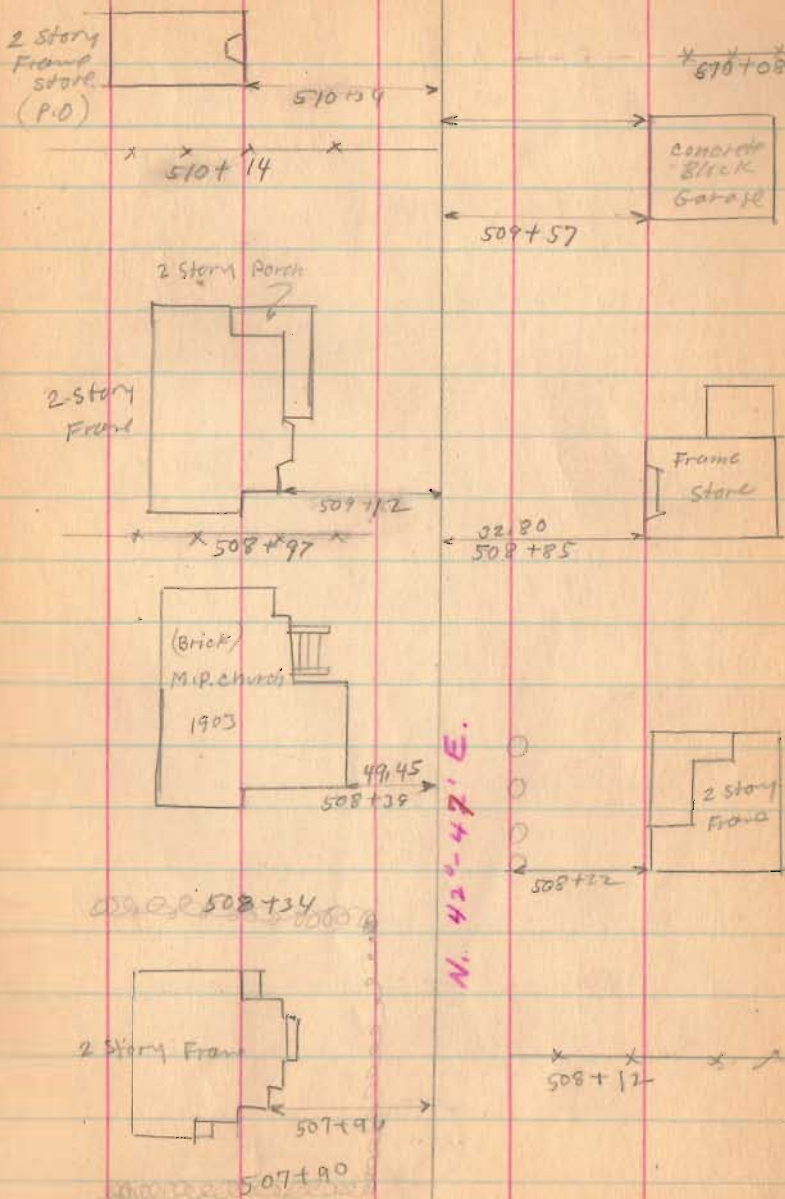


Road No. 9

512 + 78

3-29-34

32

Concrete Peds

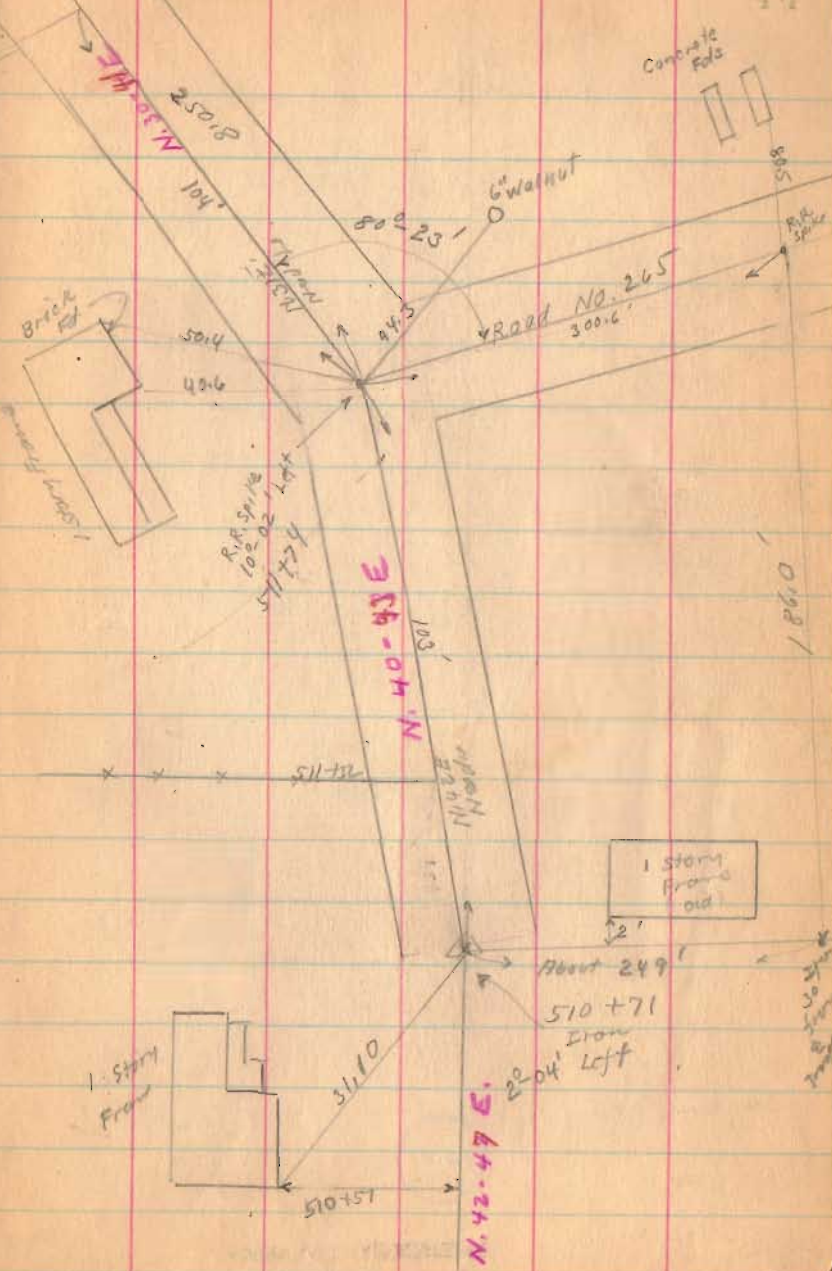


1545

INDEXED ON MAP

Road - 9

1545

INDEXED ON MAP

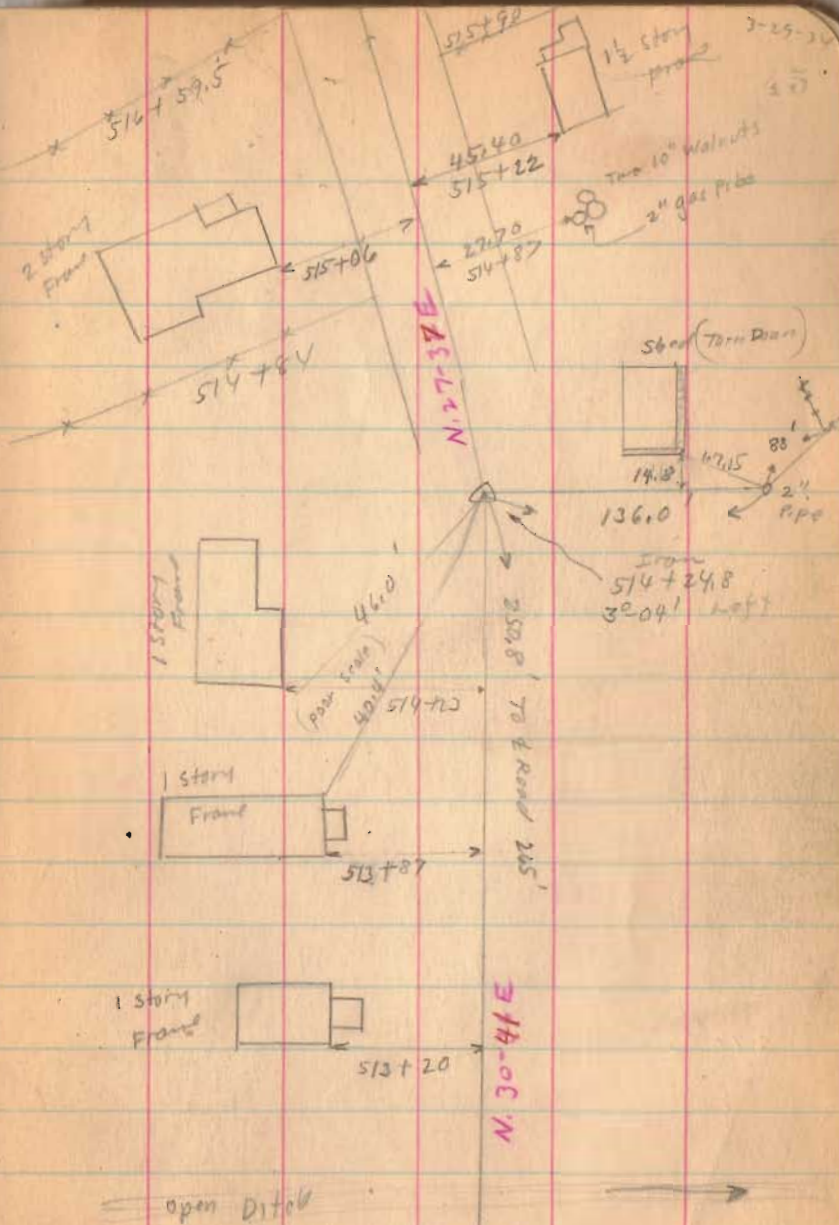

Road. 9

~~519+521.5~~

~~518+24~~

Left only

Restaked Curve

3-10-36

See Page 53

~~517+23~~


Left Only

1545

INDEXED ON MAP

3-29-34

26

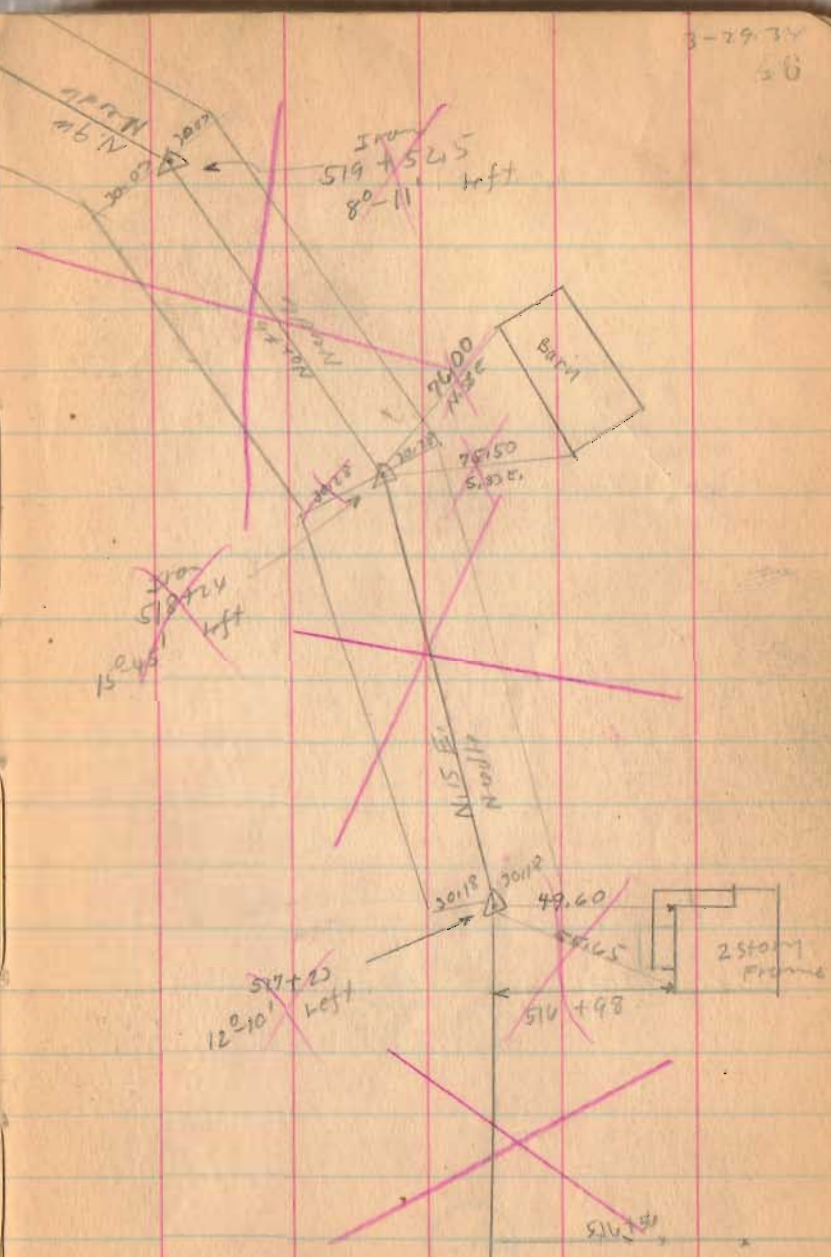

Road 9

526+24.5

526+33

522+85

522+93.5


No Manurets
No Stakes
Too Much stone

1545

INDEXED ON MAP

3-29-34

27

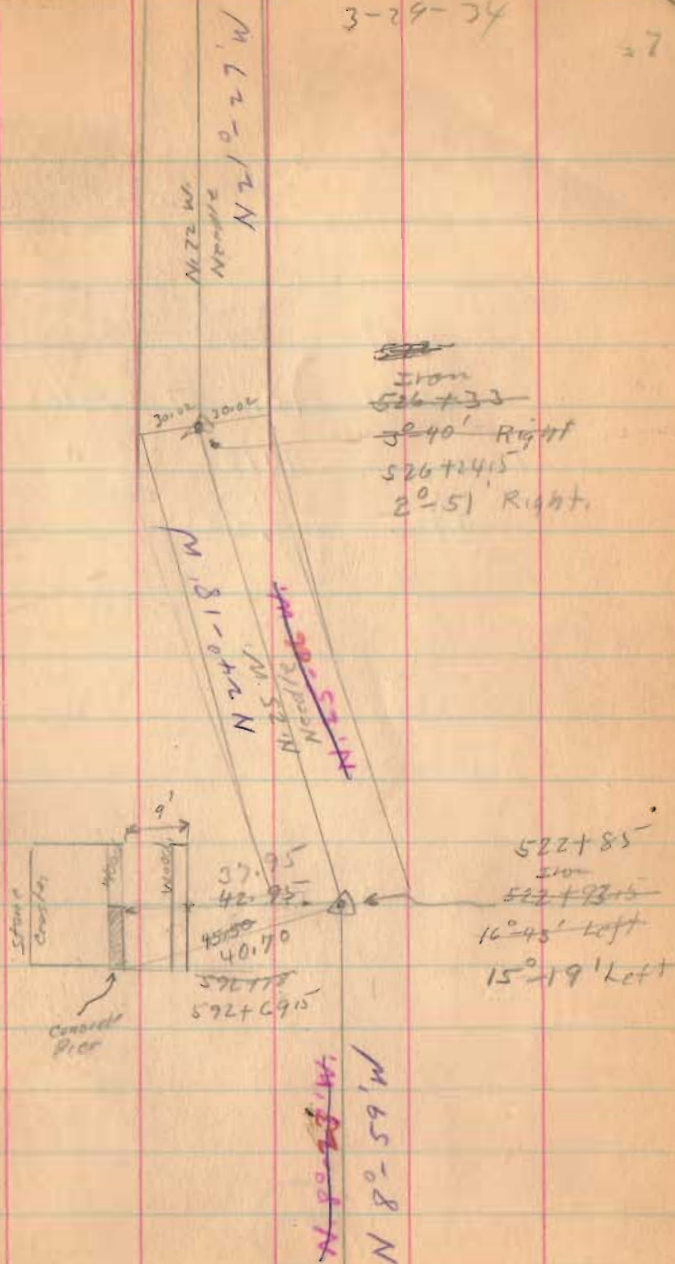

Road. 9

Length $53138\frac{1}{2}$ Feet
~~53147~~ Feet

Length 10.0657 Miles

$\frac{10.06}{85}$
9.21


$\frac{10.07}{.85}$ " Deduct for Rushsylvania
9.22

~~530750~~

530741.5

1545

INDEXED ON MAP

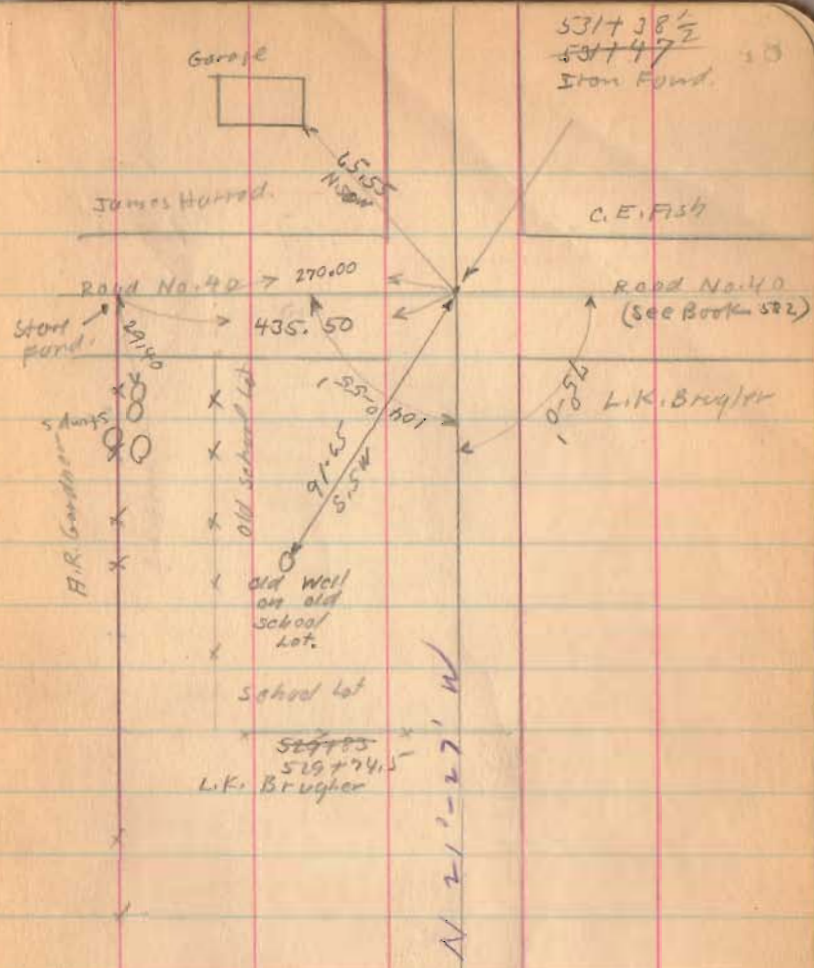

Road 9


Continued from page 27

1545

INDEXED ON MAP

3-7-34

29

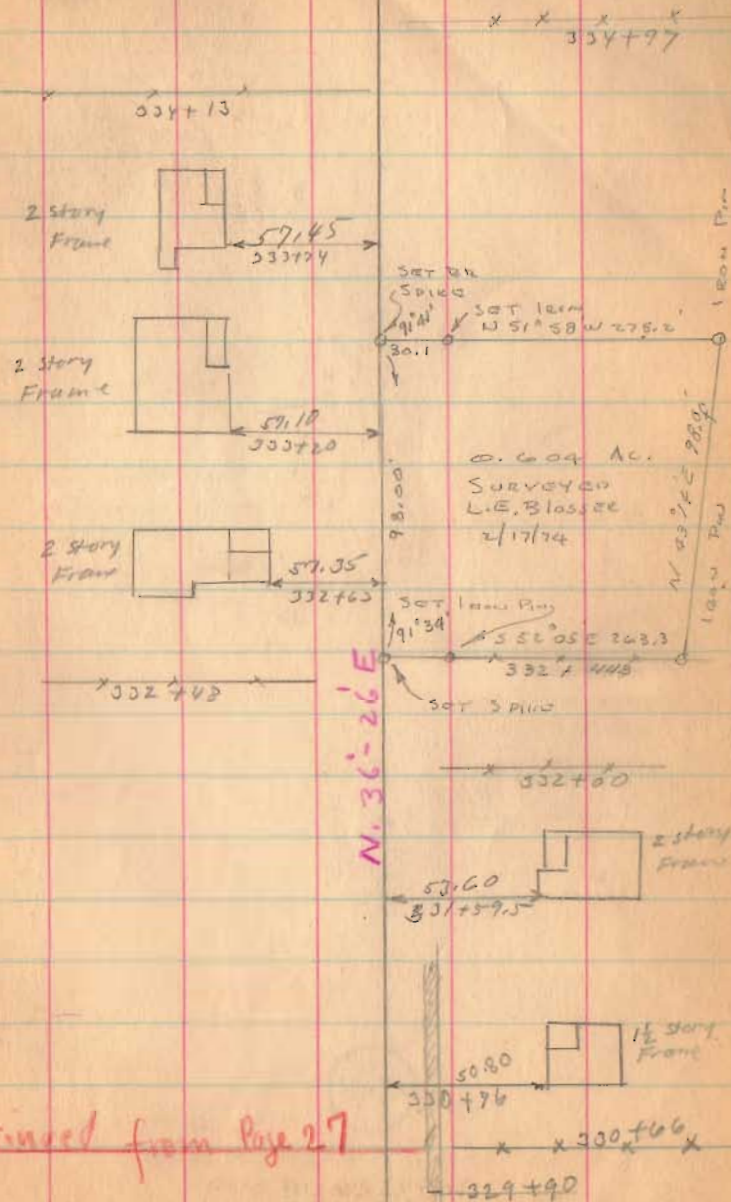

Continued from Page 27




Road 9

15-45






INDEXED ON MAP

3-7-34

50

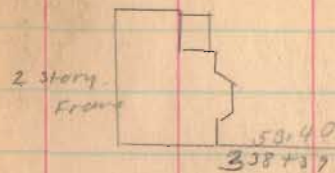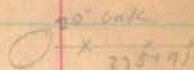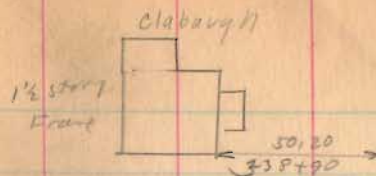

N. 36° - 26' E.

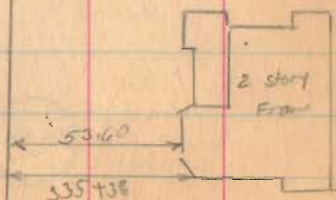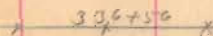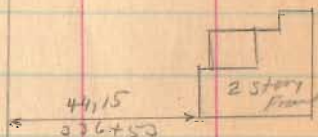
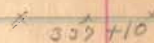
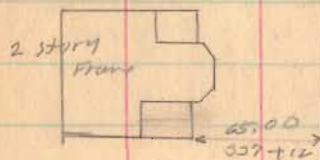


Road 9


1545

INDEXED ON MAP

51

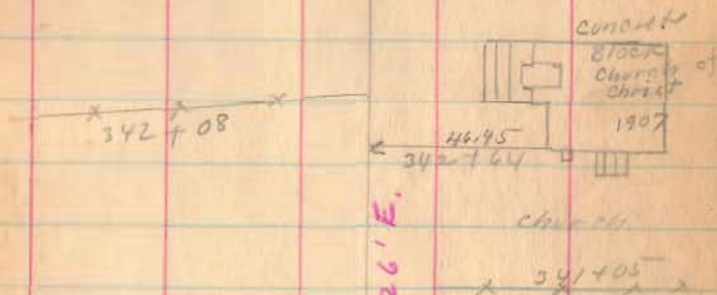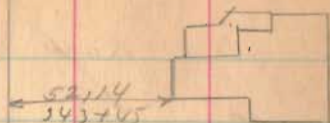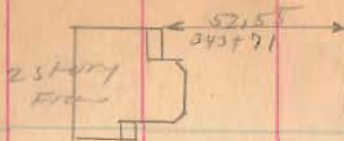


N. 36° - 26' E.

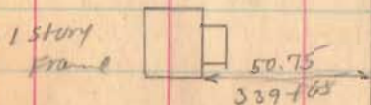

Road 9

Continued on Page 28.

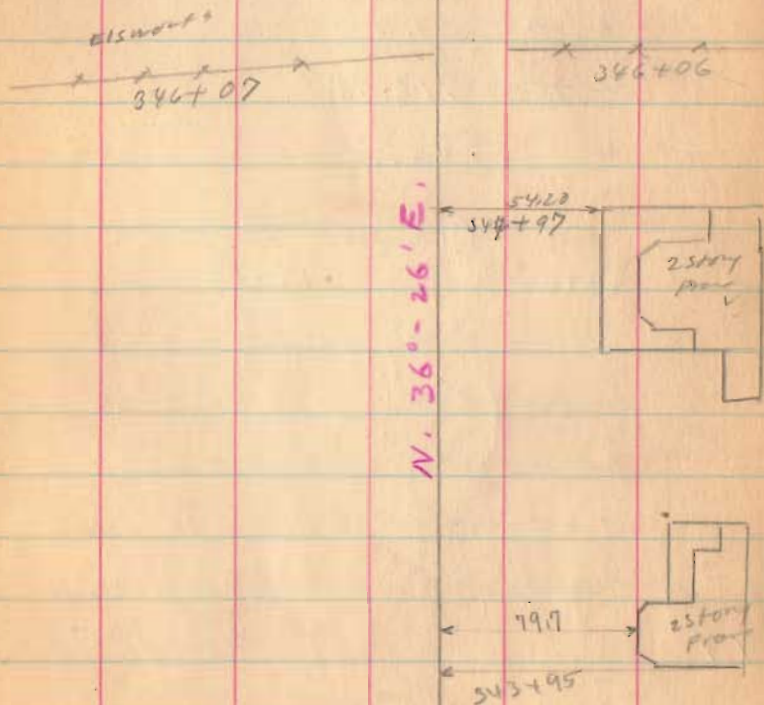

1545

INDEXED ON MAP

March, 10, 1936
 Clear - Warm
 F. Wright
 E. Cole
 G. Hilgus

53

Road 9

Curve as restaked


See Page 46 for Old Notes

$D = 9^{\circ}-0' \quad 8^{\circ}-0'$
 $\Delta = 30^{\circ}-0' \quad 36^{\circ}-36'$
 $T = 209.1 \quad 237.04'$
 $E = 82.8 \quad 38.20$
 $R = 637.3 \quad 716.78'$
 $L = 400' \quad 457.5'$

Set on	Sta.	2.7 Per foot	
P.C.	516+16.5	Def.	515+86
	17+00	$8^{\circ}-45'$	516+00 - $0^{\circ}-34'$
	18+00	$8^{\circ}-15'$	517+00 - $4^{\circ}-34'$
	19+00	$12^{\circ}-45'$	518+00 - $8^{\circ}-34'$
	20+00	$19^{\circ}-15'$	519+00 - $12^{\circ}-34'$
P.T.	520+16.5	$18^{\circ}-0'$	520+00 - $16^{\circ}-34'$
P.T.			520+44.1 - $18^{\circ}-18'$

1545

INDEXED ON MAP

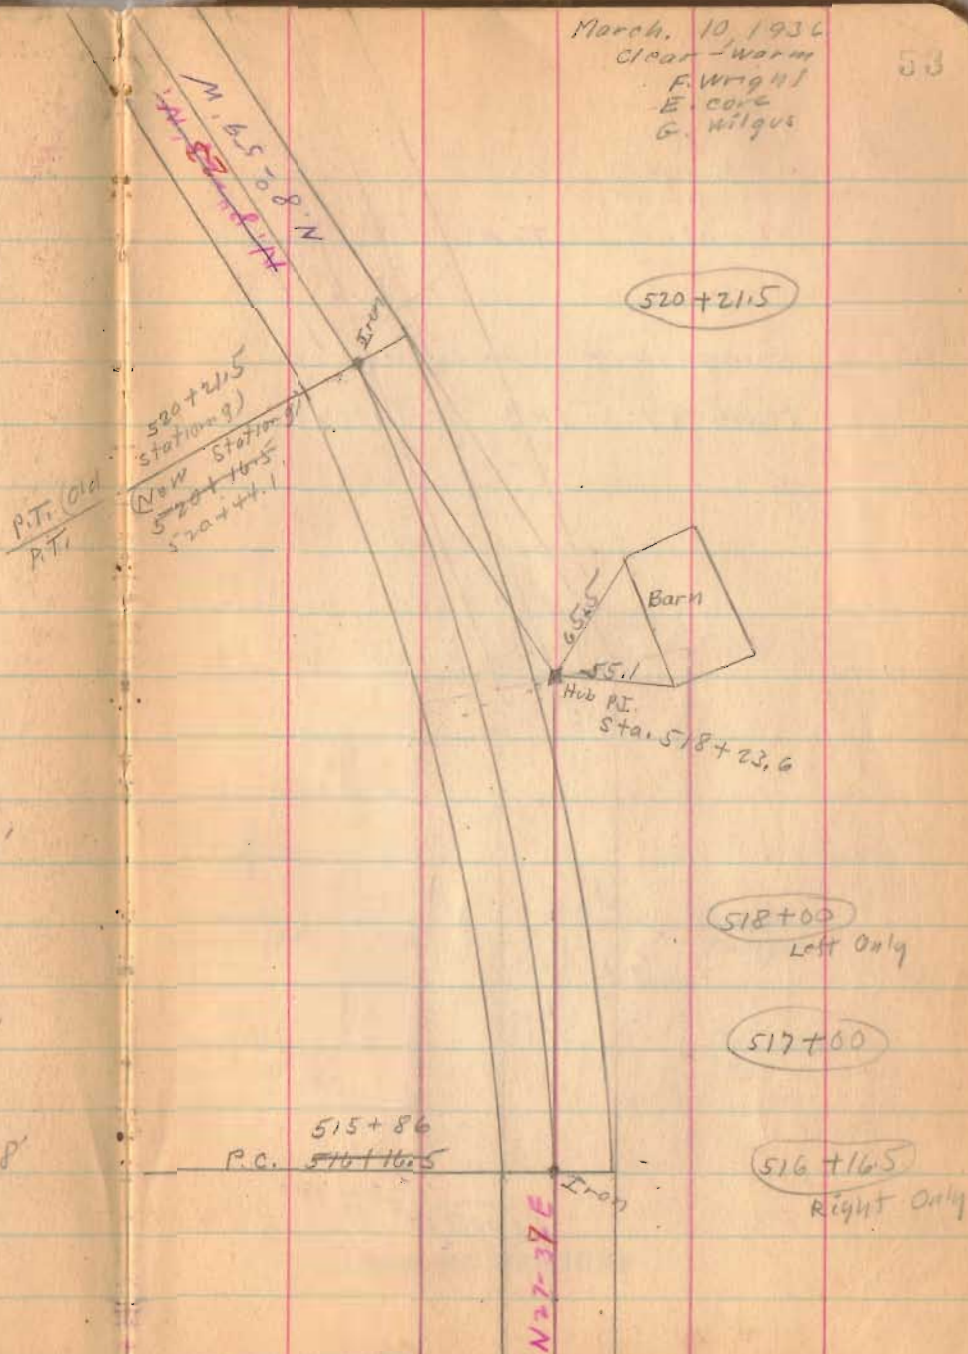

Road 60
Bloomfield Tap

60' - Commissioners Journal No. 5
Pages 97 - 183 (1837)

10+00

5+00

1+00

Minimum ends
30' from d

1728

INDEXED ON MAP

July-13-1936
Warren
F. Wright
J. Montgomery
G. Wilgus
Max James
Joe Roberts

84



concrete
box



2+25

Metz St. Ditch →



Road. 60

36+00

32+00

24+25

21+00


15+00

1728


INDEXED ON MAP

7-13-36

55

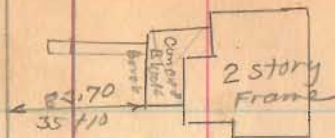

± 30" c.i.
32+41

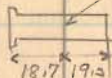

Section 19
J. E. Smith

T. 7 R. 8

Gov. BPA

Philip Metz

Road. 23

Road. 23

Hughes

Viola B. Clayton



23+72.5
stone found
0'-04" left

12" oak


Section 24

T. 7 R. 7

Road 60

J. L. West

1898
District No. 5
Brick School

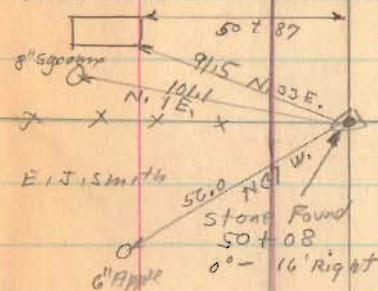

7-13-04


86

Nevin J. Smith

Road 34

See Book 396

Philip J. Metz

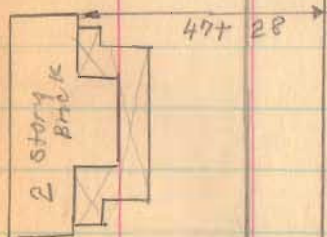

148 12.2

→ 39 ± 20 ± Stone Box

56 ± 00

51 ± 00

49 ± 00

43 ± 00

172B

INDEXED ON MAP

Road. 60

72+00

66+50

60+00

1728

INDEXED ON MAP

7-13-36


57



Emery Garling

x 60+26 x

NEWELL U. SMITH

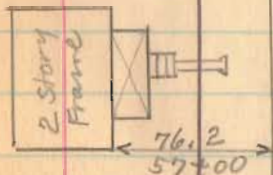

N. Hoffmann

x 56+70 x
J. L. West

Road 60

Evans Devco Co.

89+69

E.W. Garling



July -14-1936

Chas
 F. Wright
 J. Mountgomery
 G. Wilgus
 Max James
 Joe Roberts

38



section 20

T. 7 R. 8

E. W. Garling

E. Y. Garling

Concrete Post

Road 35

33.40

82.20

Stone found.

No. Angle

76+51

N. Huffman

Concrete Post

E. Y. Garling

Road 35
 see Book 601
 page 64

section 19

T. 7 R. 8

88+00

83+00

76+00

1728

INDEXED ON MAP

Road 60

115+50

110+00

104+00

101+00

94+00

INDEXED ON MAP

1728

Florence
Kemp
116+08
Evans Dev Co

Dug
NoiLock


7-14-36

John Wilder-mouth

Road 53
116+08 Appoint to

W.E. & H.B. Garling.

96.70
107+46

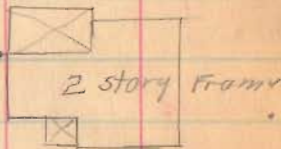

2 story Frame

EVANS Dev Co

W.E. & H.B. Garling

Road 53
see Book 60/
Page 67

EVANS Dev Co.

stone found.
102+88
0° 08' 47"



32.25

102+88

E. Knief.

80.00
S. 27 W.

10" Pipe

100+87

E. Knief.

E.Y. Garling

1 story
Frame

64.80
95+96

Road 60

125700



120765

1726

INDEXED ON MAP

7-14-34


60

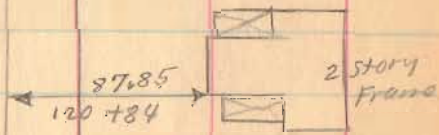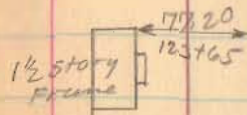

Minnie Day, mple.

x x 118.73



Florence
Konabrake

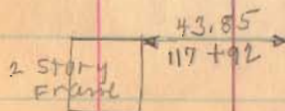

Flood Co

7-14-36

61

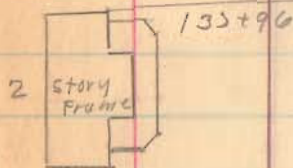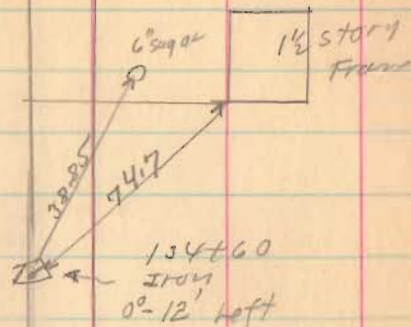


134+60

stake
129+32
0°-33' left.

section 21

T. 7 R. 8

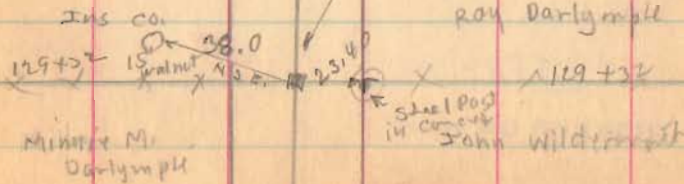

129+25

1928


INDEXED ON MAP

Section 21 T. 7 R. 8

Road. Co


7-14-36

63

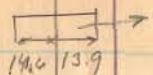

150+07 & stone Box

^ ^ ^ ^
148+55
W. F. Wahler

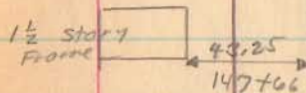

x 147+37

157+00


146+00

Geo. Metz

old Church
Lot 1

x x x x
142+61
Jus. Co.

x x
142+65
Arton Rex
John Culver

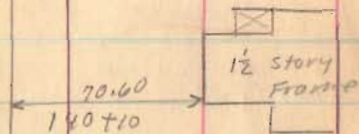

141+00

Arton Rex

x x 136+00
Ray Early

1728

INDEXED ON MAP

Road 20

155+72


154+00

1728

NEEDED ON MAP

7-14-56

63

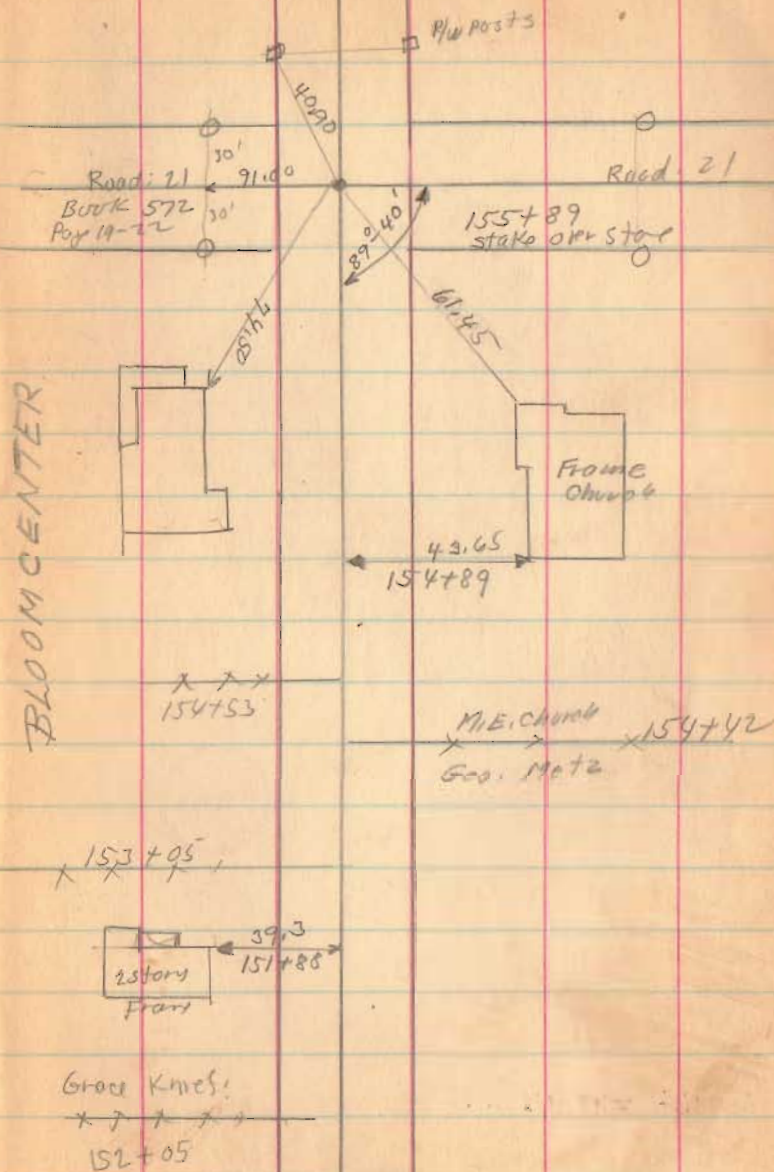

Intersection of C.H. #9 & 223
Rushcreek Twp.

Road # 223 - 33' wide

Oct 2, 1953

D. Dodson
T. Richardson

U 2




Survey of
Sandusky Street Railroad Crossing
Rushyironia

R.R. spiked set on @

5+0 0+00
0+50
0+75
1+25
2+25
2+75

Carl Meyer
A. DeWitt
O. Dodson

March 1, 1950
Coll. & N. M. S.
Snowing

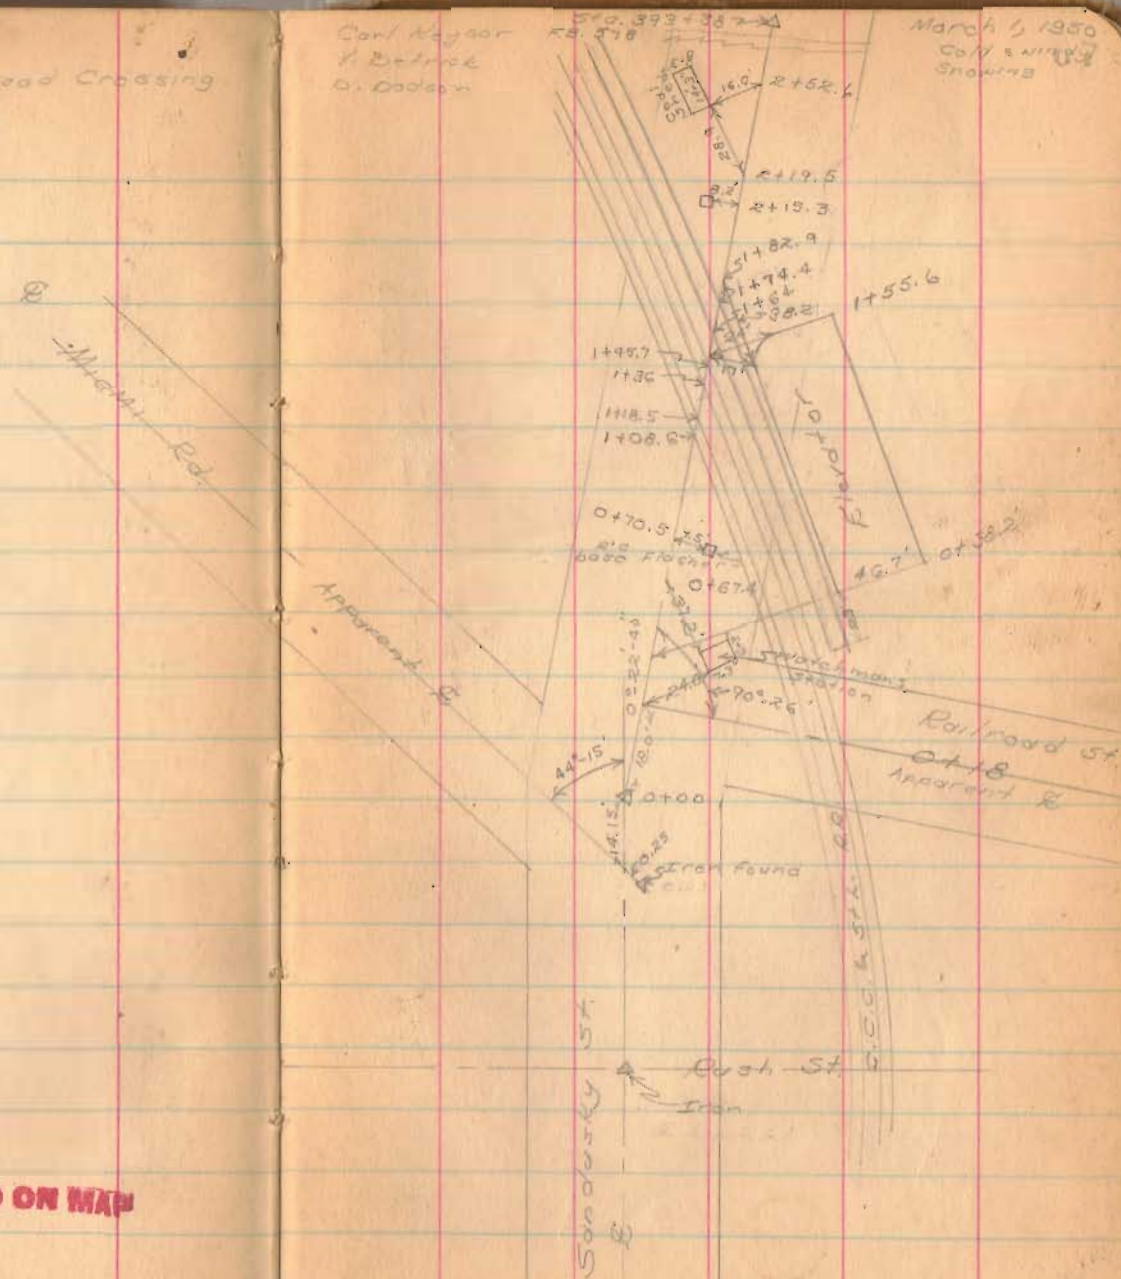

2093

INDEXED ON MAP

5+0 3/0+40.75
R.R. 578
Pg. 26