


Road No. 19  
DeGraff To West Liberty

60' Road. Commissioners Journal 3 Page 61 Aug-1832  
 " " 6 " 71-162 1837  
 " " 7 " 80-139  
 " " 8 " 131

West Liberty - Logansville Pike 1868  
 Width not given

1519  
 INDEXED ON MAP

Dec. 1-1933  
 Clear-Nite Day 10  
 F. F. Wright  
 J. S. Crane  
 A. W. Rathfelder  
 W. B. Dugan  
 O. N. Mills

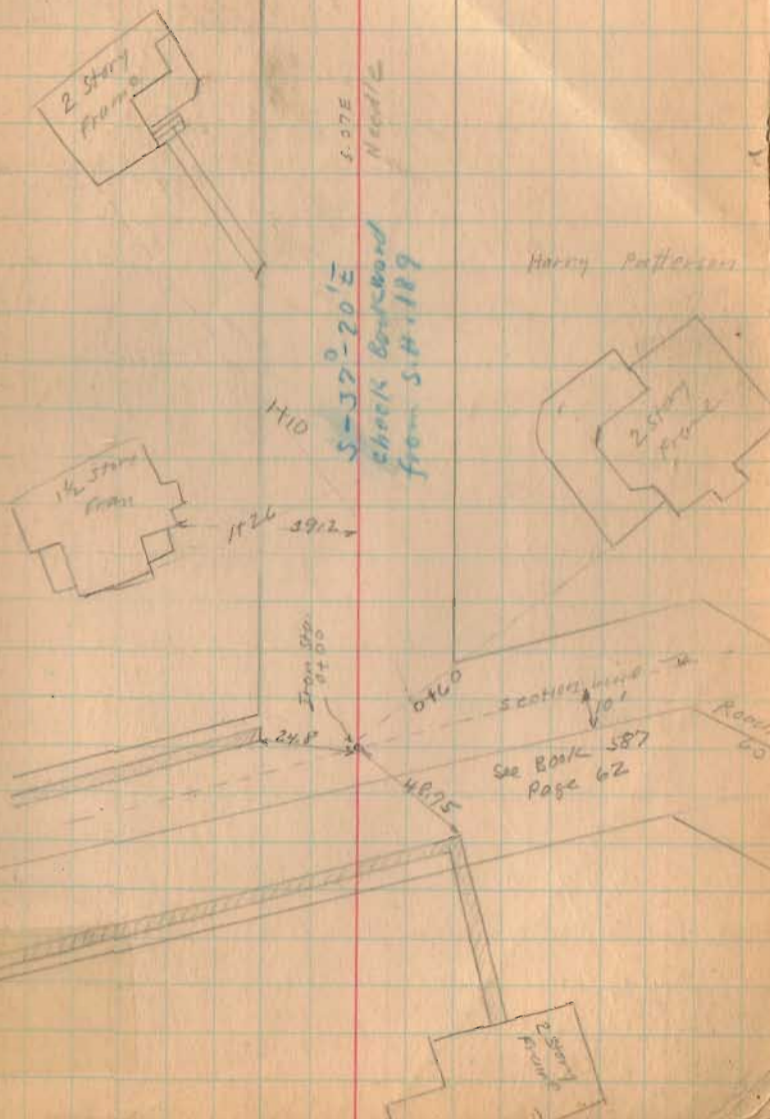

Road 19

1519  
INDEXED ON MAP

5140 Monument

Monuments 30' from E

Both sides unless otherwise noted.

12-1-30 11



5140  
Iron Found.  
No. 11/12

Frank plots

Corporation  
DC Grant  
(Recorders  
Post 92)



Road 14

23+00

15+00

13+96.2

Mon set

1519

INDEXED ON MAP

12+00



12-1-33

12

23+46  
Iron Found  
No Angle  
Sub. B. D  
P. 17

Stone & Iron  
Found

705.6

No Angle

Elizabeth Crowley

15+84.3  
018.78

Frank Platts

519-27 E

5.80 E  
Woods

Minnie D. Reapp

Road 65

SWW  
Wood by

Harry  
Patterson

Iron  
15+84.3  
No Angle

13+96.3  
Iron Placed  
17° 53' Right

30.38

20.38

Road 14

53+00

47+09

42+33.7


37+00

32+20

29+69.72

1519

INDEXED ON MAP

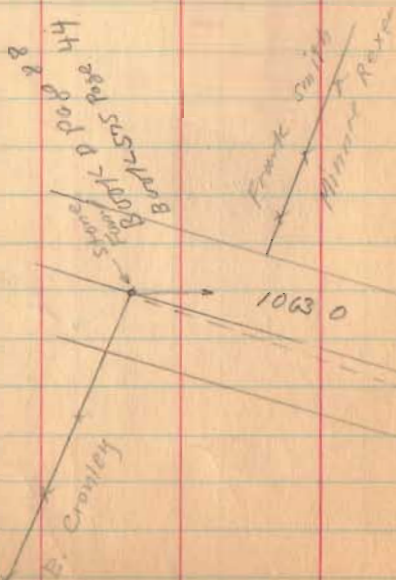

183

12-1-23  
S 25-48 E  
S 25-E  
Road 14

Iron  
47+09  
2°-30 left

Iron  
42+33.7  
22°-06 Right



Frank Smith

27+75

Minnie Rexer

S 45-24 E

S 45-E  
NO. 25

27+75

Chas. Notakine  
27+75  
Minnie Rexer

5' sugar

Iron  
32+20  
25°-51 left



S. 22 1/2 E under

of Road 2 No. 25

section

14-5

30.79

30.79

30+08  
Iron  
No. Right

29+69.72

Road 14

62+24.7

57+02

1519

INDEXED ON MAP

Li. Knick  
28+0  
Chas. Notstine

305-MS  
22-20-05

12-30

1/4

Iron  
62+24.7 left  
11-29

30.20  
47.25  
29.70

Yard Fence  
61+99



S 35-01E

50 1/2 E  
100'



Chas. Notstine  
x x x x x 58+10  
Frank Smith

Iron  
57+02  
9-13 left



Road, 14

81+70

76+00


71+00

66+00

1519  
INDEXED ON MAP

12-1-55

25

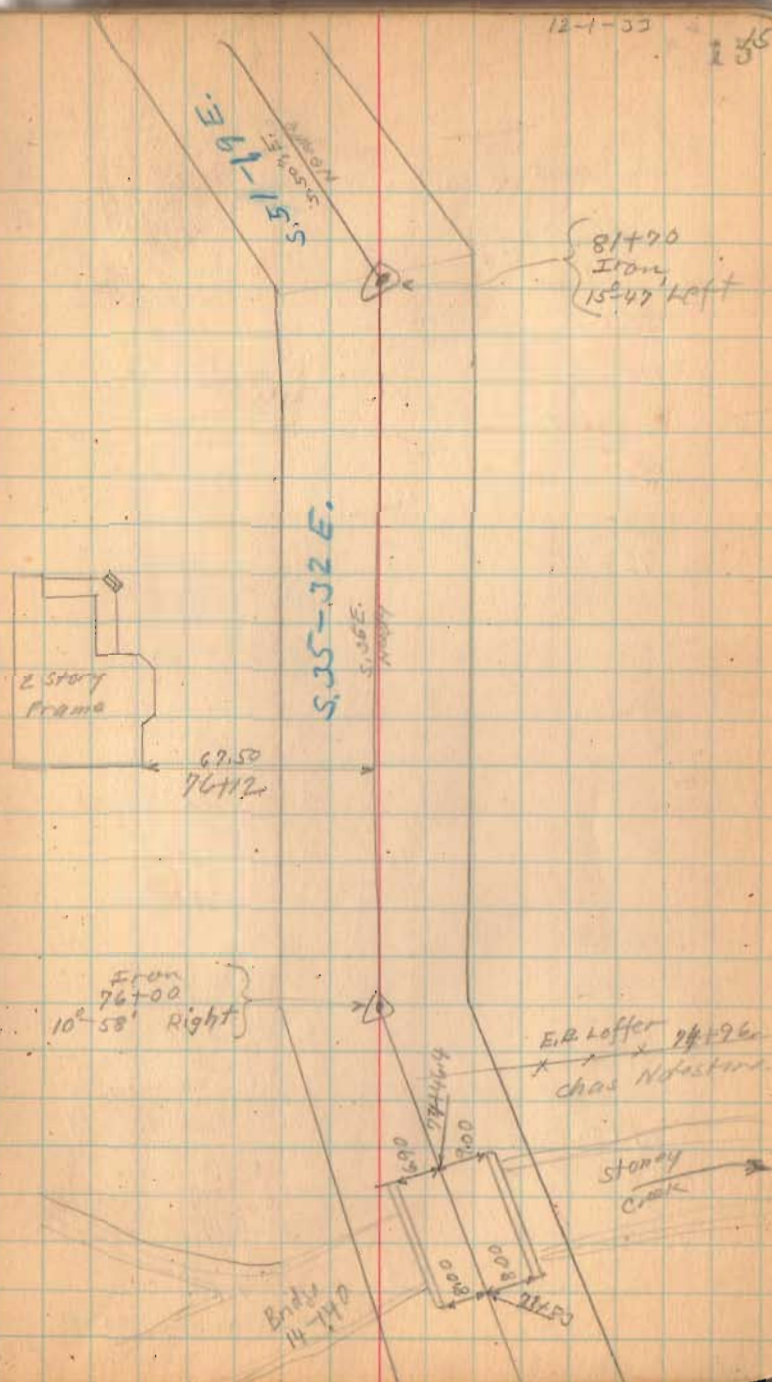

Road 14

107+00

101+35

99+50

92+00

85+50.6

1519

INDEXED ON MAP

Iron  
101+35  
5=45' Right





12-1-33

J. A. Simpson

Saml. Smith



Saml. Smith  
97+21  
Geo. Ocker

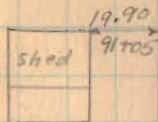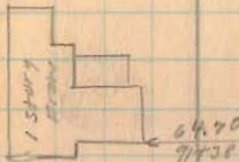

S. 52-59 E.

Sec. 35

Geo. Ocker

U. Hinkley

Sec. 5

S. D. F.  
North

T. 4 R. 12

Saml. Smith

Iron  
85+50.6

1' 40" left

E. B. Koffer

T. 3 R. 13

Road 14

128+00

124+00

118+00

116+00

112+00

110+00

INDEXED MAP

1519

12-1-33 17/1

N.W. Life Ins. Co.  
x 125+29.5 x  
H.D. Stewart

122+18  
Lot  
122+00

Bridge No.  
14-2120

Homer Walker  
& Estor

116+73

Saml. Smith

Stone found  
Plaid Brick  
on top  
116+73  
No Angle

117+20.9

116+98.7

A.D. Stewart

Road 62  
Stutz Pike

Mary M. Terrel

S 84-57E

117+20.9

111+61  
37-43 left

R/W MONUMENT  
STA. 111+61





Road, 14

178+00

172+00

167+00

161+00

155+00

FO. RIGHT ONLY

1519

INDEXED ON MAP

Ralph Atkinson

x x x 169+97

James Tamplin



169+86  
stone  
No. 111/12

Lena Harwick

stone  
road

A. & E. Holly Doss

25-30

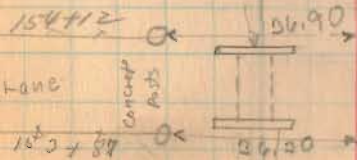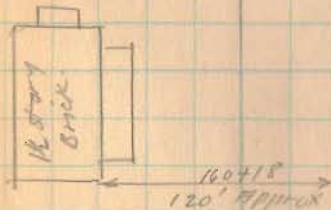

Vertical  
in concrete

Road 14

198+00

192+00

184+50

182+00

1519  
INDEXED ON MAP

22270  
21.12  
24920  
22371  
20.75

Sec 23-4-13


Z (No Fence)

Sec. 2874R13

Sec. 29-4-13

x 193+04 x  
LANE  
x 192+84 x

M. M. Huber  
x x 186+01  
H. & D. Royer

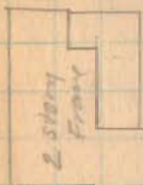

H. & D. Royer

Road 31

Ralph Atkinson

Sec. 22-4-13 20

C. & M. Mohr

196459

H. & D. Royer

Sec. 28-4-13

S. 84 7/8 N. 85-17E

From  
183+24  
6'-05" Right

H. & D. Royer

Road 31

183+24

LENA HORNER

Road 17.

224+00

222+00

216+00

211+00

209+00

204+00

1519  
INDEXED ON MAP

224+76

Lane



2 story  
Frame

150' 4"

224+75

02-09-1999  
223+08.7

585-01 E

584-52 E

58 E  
Handle

Dec. 4 1933  
Foggy  
Wright  
Crote

21  
23

Chas. Crotter

223+24

Road 202

222+85

217+22

Lane

217+04

H.D. Near

209+95

Road 202

M. & M. Huber

2020

Cor. Caprock stand  
in concrete  
for triangulation  
station  
Measure to  
center of  
square

Point Workman

C. & M. Huber


Square

209+95

02-25-1941

99.00

201+14

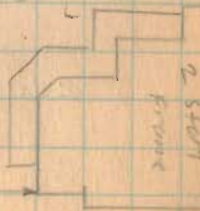

2 story  
Frame

Road 14

250+00

249+00

244+00

237+00

Right Only

236+81.4

Left Only

236+00

Right Only

230+00

INDEXED ON MAP  
1519

12-4-32 22  
22

D.S. Voder

Road No 201.  
249+70



W.L. Plank

245+26

H.R. Weer

63100

5560  
249+47

S.B. Plank

249+20

Stone found

0°-32'

Right

S. 85-06 E.  
S. 85-08 E.

110+95  
242+12




Stone found  
236+81.4  
0°-09' left

Chas. Mohandass

236+83

Chas. Mohandass

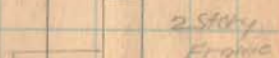

89.9  
226+13

Road 14

269+00

263+00

259+00

1519  
INDEXED ON MAP

Iron  
263+39  
0.25' Right

584-41E

20.5

To Hole

12-4-33

23

23

J.M. Hand

J.I. Vadee

2 Story  
Frame

47.30

262+02

20.45  
261+31

20.85  
260+43

258+57  
Hole

J.I. Vadee

252+41

SIB. plank

1/2 story  
Frame

61.30

251+47

Road 1A

278+00

277+00

270+00

1519  
INDEXED ON MAP

M. Holzman  
x 277+99.6 x  
Dis. Yoder

270+94  
Lane  
270+97

S 85-11 E

S. 84 1/2  
West

12-4-33

24  
2 1/2

Hugh Newell

x 277+58  
O.M. Newell

Stanford  
02-31 left  
277+39.6

162.90  
277+94

2 story  
Frame

Drill

273+26

20'

20.6

267+27

Cometery

S. 84 1/2  
West

261.0

x 269+93 x

Road 14

304+00

296+00

291+00

285+00

1519  
INDEXED ON

12-4-33

25  
25

585-42E

585 1/2 E  
North

Frank Hayes

Road 18

E. Magoon

205+36  
Stone found  
placed stone  
on top.  
0° 30' left

Mary A. Brown

Road 18

Hugh & Newell

63.35  
299+00



E. Magoon

x 296+32 1/2

M. Holyman

283+61

x lane

x 283+41



Road 14

338+00

332+00

331+00

325+00

318+00

309+00

INDEXED ON MAP  
1579

12-4-37

26  
26

Luther Horn

x x x x  
339+45  
H.J. Yoder



$$\begin{array}{r} 39+45 \\ 31+69 \\ \hline 7+76 \end{array}$$

A. J. Yoder

x x x 331+68.7  
L.M. Hayes

Iron Pipe Found  
0° 04' Right  
331+68.7



L.M. Hayes

x x x x  
Front Hayes

318+30s  
Iron Pipe Found  
No Angle

Road 14

365+00

359+00

356+00

350+00

345+00

1519  
INDEXED ON MAP

12-4-33 27  
27

S. 84-47 E.  
S. 24 1/2 E.  
N. 10 1/2 W.

0°-51' Right  
356+49.6  
Found stake  
found stone  
& brick  
with Voder

Road 187

Walter Herz

358+62 Z  
Paul D. Voder

90.75  
357+81  
Walmart  
Store  
No. 1895

184.8  
with not right  
J.H.H. Walker

356+99 Road 187  
(Girard Pike)

Mal H. Brown  
old school  
lot.

354+82 Z

28.9  
340+41



Road 14

409+00

403+00

396+00

390+00

383+16.7

Top Line -

377+00

372+00

INDEXED OF  
1519


Wid. Yoder  
Road 32  
409+00  
L.H. Yoder  
Stone Found  
403+30

409+00. 12-4-33  
Stone Found  
0-10' left  
Lee M. Yoder  
403+30  
Paul D Yoder

387+14

Lane

380+83

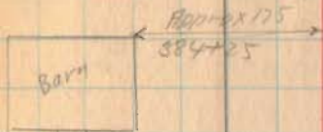

x 383+61

Lane

x 382+38

584-18E

383+16.7

Square Stone  
29 Right

LIBERTY

N. 4° 15' E. 383+16.7

ROAD

UNION

88°-50'

TOWNSHIP

TOWNSHIP



Road 14

428+00


422+00

417+00

411+00

Dec. 5, 1933  
NOT cold  
Wright  
Cran  
Dugan  
Mills  
Rathfelder

279

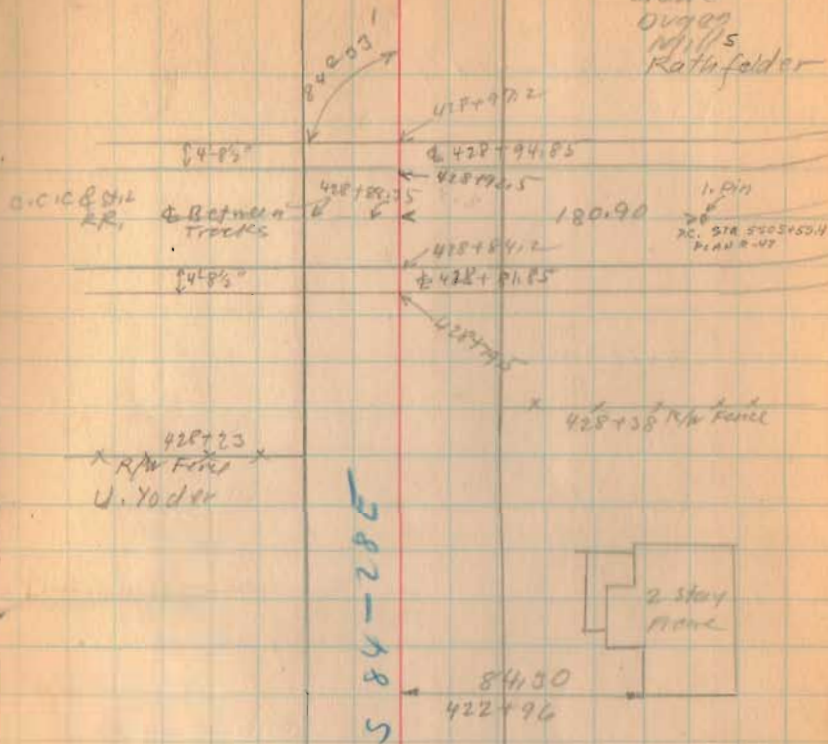







Road 19

449 + 249

449 + 94

1519  
INDEXED ON MAP

31  
31

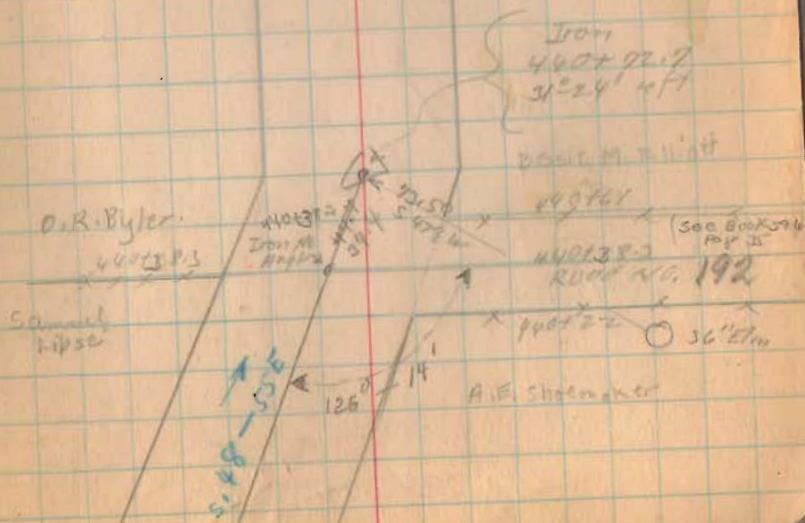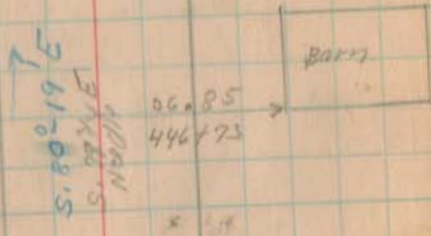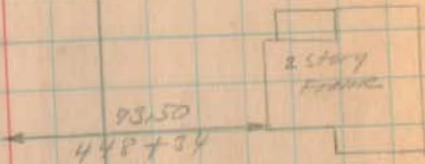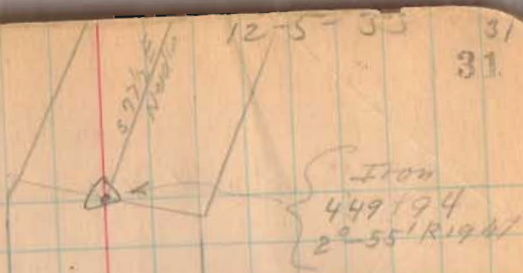




479+00


476+00

471+12.3

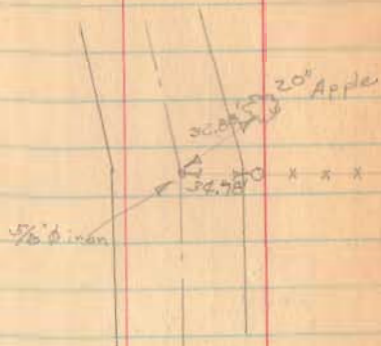

468+00

463+64.5

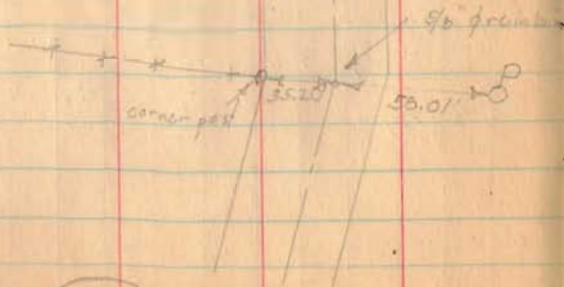

1519

INDEXED ON MAP

12-5-30 383

Ed. 5/8" p. van  
19 July 1968

Iron  
471+12.3  
5'-4 1/2" left

D.B. Vader  
11 3/4" W. Noddy  
Bessie McElliot

S. 28°-06' E  
5.27 E.  
North

A.F. Hafinzer  
Bessie McElliot  
5'-6 1/2" E

Iron  
463+64.5  
3'-4 1/2" left.

Ed. 19 July 1968  
5/8" p. van bar (top part)

S. 24°-19' E









Road No. 1


9+33.5 20' Left only

8+01.5  
4+59.3  
3+42.0

8+01.5 20' left only

4+59.5 20' Right only

INDEXED ON MAP  
0251

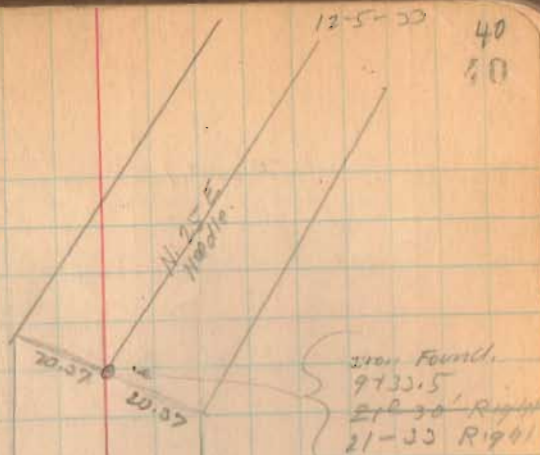

Read 1

30+00 ~~25~~ 30

26+00 X' 30

20+50  $\frac{30'}{75'}$  Right only

20+19.5 30' ~~25~~ left only 20' from Route

20+00 ~~25~~ 30' Right only

12+00 ~~25~~ 30

11+50 20'

1520

INDEXED ON MAP

000-6-1930  
Cochran 41  
Wright 41  
Curt 41

x 22+80  
Lane  
V.M.S. 6516

20+18.5  
stone found  
0'-03 Right

J.M. Hartman

24.92  
Ed. Bennett  
Shed pit  
in woods

James Cottland

B.B. Gants

V.M.S. 4479

30' 30'

15' 30'

Don found  
11+55.6  
42' left  
38'-31' left



51+33.6  
31+00  
20.6

Road 1

51+33.6 30'

49+90

30'

43+00

30'

old Hwy Post,  
on west side  
Nat Ford.  
Placed out 30'

39+00

30'

1570  
INDEXED ON MAP

Iron  
51+33.6  
18"-30" dia  
Found 7/26/72

F.N. Johnson's Elm

Road No 47  
(see Page 79)

James Outland

R.R. Spike  
Found 7/26/72  
Clopsaddle

off being  
marked  
Dec-1972

12-6-33

42  
42

stone  
51+07

Ed. Dickkopf

Road 47

(see Burd-559 Page 11)

0.4 C. Hines  
0.4 Sogor

50+61.6

76.20

0.4 Sogor

50+15

Shed

24.40

48+87

Bar

35.75

48+27.5

38+20.36

RR Spikes Set

7/26/72

Clopsaddle

36+75.36

36+75.36

stone

No Hinge

C.C. Hines

36+95.5

Marked

Road 11

64+50

30'  
25'

63+50 30'

58+55

30'

54+68.19

30'

1520  
INDEXED ON MAP

12-6-33

43  
53

74+00

64+02.6

107.38

64+02.6

58+55

5152.6

Iron  
64+07.6  
14.51' Left

Iron  
58+55  
20°-15' Right  
Found 1/14/00

Iron  
54+68.19  
10°-15' Right

30.70

30.70

11/11/11  
11/11/11



74+78.5  
68+07.2  
10+79.4

Road 1

86+00

30'  
28'

77+00

30'  
28'

70+00




30'  
28'

1520

INDEXED ON MAP

12-6-33

44  
87

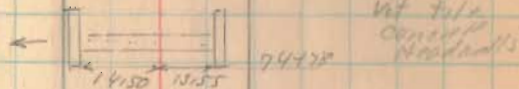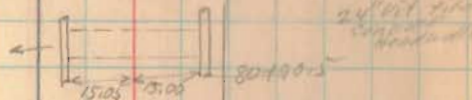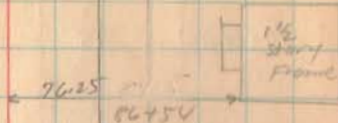



Road 1

108+00

30  
~~25~~

104+00

30  
~~25~~

100+00

30  
~~25~~

94+00

30  
~~25~~

91+00

30  
~~25~~

1520

INDEXED ON MAP

12-2-53

46

48



97+94

LANE


97+55

91+21 Stone found  
 hand stone  
 on top  
 02-08 left  
 (shown wrong  
 here, on other  
 side of bridge  
 Apr. 29, 1942 seen)

Menne S. Yoder

Bridge No 1-480

Ed. Dick North

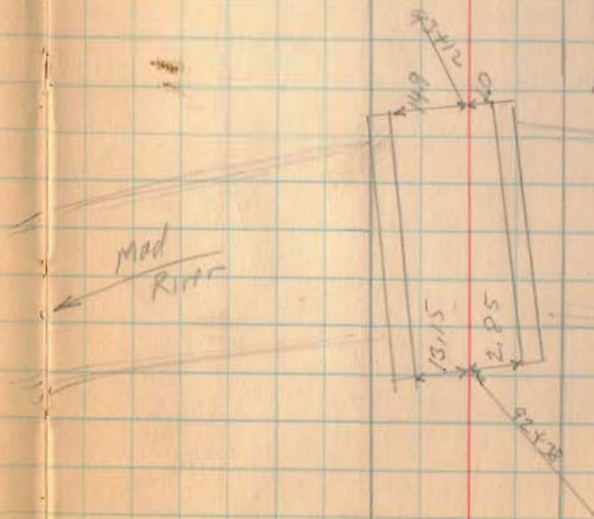

Mod  
RINT

Road 1

12-8-33

46

48

Miino S. Yoder

Length 10919 Feet  
Length 2.068 Miles

L.H. Smith

To West Liberty  
Road 5  
see Book 509  
Page 66

L.H. Smith

Sec. 23

T. 5

R. 13

To  
Bell, Johnson

Road 1

see Book 548  
Page 10

To  
Harris Hill  
Road 5

100° 10' (see Book 497  
Page 65)

109° 19'

Miino S. Yoder

V.M.S. 4493

1520

INDEXED ON MAP

# Road # 40

9-6-58  
 Wilgus  
 Cookwell  
 Phillips  
 Dobie

## Monumenting

## Next.

30' N E 30' S.


Set and checked  
 9-16-58 Wilgus

Station	Count	Direction	Status	Notes
1+00	2	Mont	OK	30' N 30' R, Sampled Phillips
6+00	1	"	"	"
11+00	1	"	"	"
12+02	2	"	"	"
19+00	1	"	"	"
26+00	2	"	"	"
29+50	1	"	"	"
38+00	2	"	"	"
39+50	2	"	"	"
41+00	2	"	"	"
48+00	2	"	"	"
49+00	2	"	"	"
56+00	2	"	"	"
62+00	2	"	"	"
68+00	2	"	"	29.89 Tila
76+00	2	"	"	OK
82+00	2	"	"	"
				09
89+00	1	"	"	07
90+00	2	"	"	OK
93+15	2	"	"	TWP Monument
97+00	2	"	"	OK .09
106+00	2	"	"	OK

Road 40  
Monumenting

9-8-88

108700	30'N	± 30S	30L	30R
109700	2	Nint.	30K	30K <sub>h</sub>
116700	2	"	"	OK
121700	2	"	"	"
122700	2	"	"	"
129700	2	"	"	"
136700	2	"	"	"
142700	2	"	"	"
148750	2	"	"	"
155700	2	"	"	"
162700	2	"	"	"
168700	2	"	"	"
174700	2	"	"	"

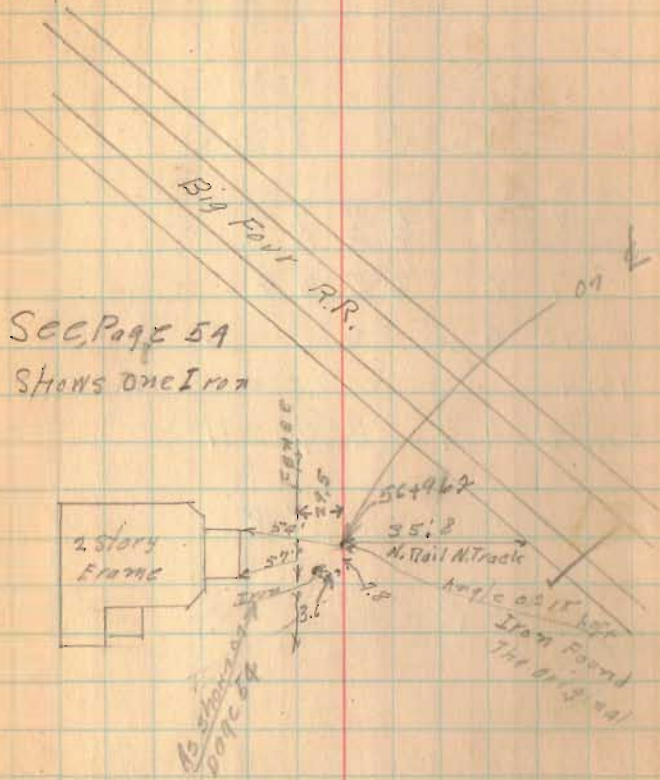

See Page 59  
Shows One Iron

H. Terrell  
stone Found. H. Terrell  
42+43  
Maud Johnson  
P. H. Bair

Road No. 40

Bokescreek Twp.

Road 9 To Ridgeway

50 Bellecenter Whitcomb Extension Pike

1887

Free Turnpike Record & Page 11

Old Pike Notes Book 319

27750

26700

19400

12702

11700

6700

1700

Monuments 25'  
from & Both sides

1524

INDEXED ON MAP

Dec. 23, 1933  
Clear Fine day 57  
W-light 15.2  
Gravel  
Dug  
Kafafilter  
Mills

C.E. Stevenson

M.F. 24

26754

Post

J.H. Brugler

J.H. Brugler

1756.2

C.E. Fish

C.E. Fish

Road 9

J.H. Brugler  
S. It

Garage

N 83° 00' E

N 83° 28' E

N 83° 14' E

43575

29400

Stamp

Dora Howard

J.H. Brugler  
S. It

Nick  
10

Iron Found  
11456.9  
2204' left  
H.L. 25' left 25 R 94'

50000  
Iron found

J.H. Brugler

Road 9 (Book 528)

Russell Hanson & Bob  
Spring's Mine

J.H. Brugler

old well on old  
school lot.

Stamp

Road 40

49+00

48+00

41+00

39+50

33+00

1524

INDEXED ON MAP

12-20-33


Maud Johnson  
W 12' Titus  
12' dim

0° N 7' E


Road No. 114

M. F. Titus  
C. E. Stevenson

N 83°-25' E


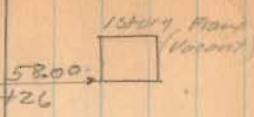


Stone Found,  
Brick on top  
2°-16' Right  
2°-17' Right  
40+10  
Hwy. 25' Right  
90° Foot cut

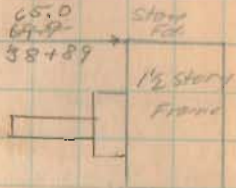

N 83°-08' E

P. A. E. Ball  
29+31  
Dora Howard

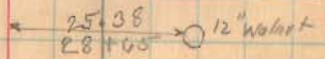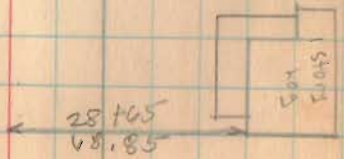

53  
33

Road 40.

see Book 516 Page 20-21  
Note Dates


See Page 48  
Shows Two Lines

Lot on E. Road.



56+100

48+43  
01.57  
518+43  
518+43  
518+43

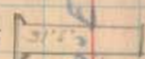

of all right  
48+43  
stone found  
brick on top  
high 25' right  
high 25' left  
and middle

H. Terrell  
Oak? 0°  
48+44  
N. Ch.  
48+44

H. Terrell  
48+43  
P. L. Bair

Maud Johnson


524

INDEXED ON MAP

N 83° 26' E

Road 40

12-23-33

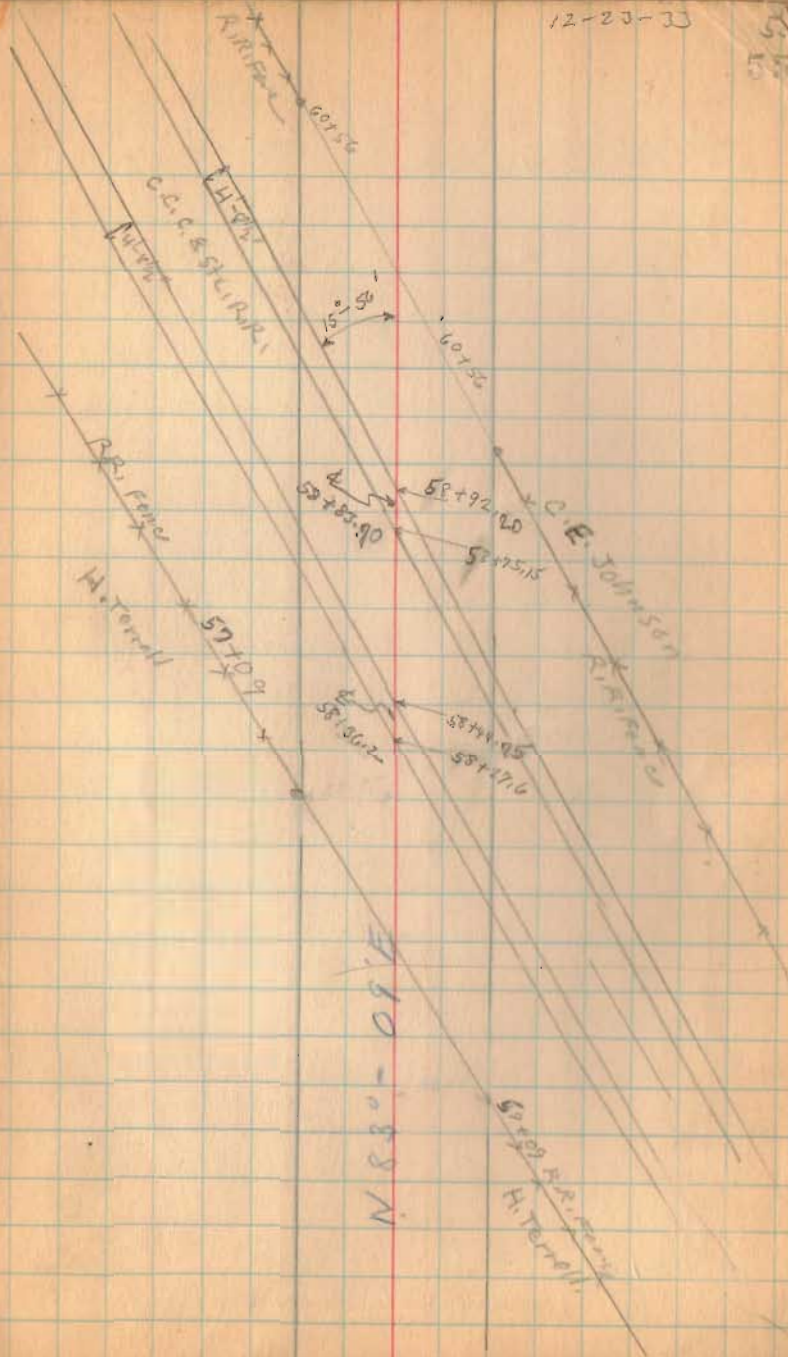

1524

INDEXED ON MAP



Road 40

84+00

82+00

76+00

68+50

62+00


1524  
INDEXED ON MAP

J.H. Cottrell  
W.F. Compton


78+25.5




N 83°-09 E

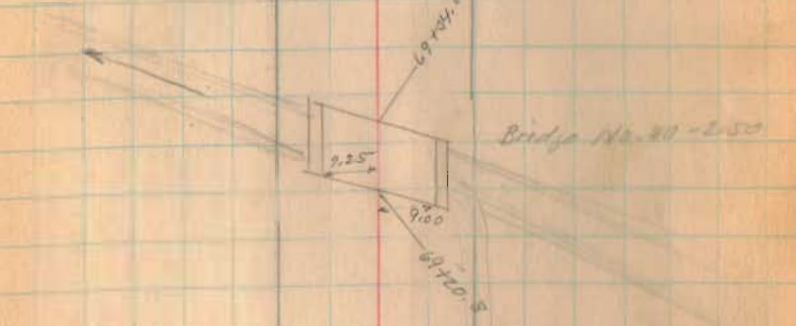

Evelene Williams  
N.H. Motor Life Ins. Co.  
66+40  
C.E. Johnson

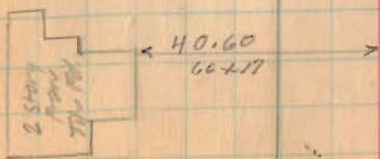

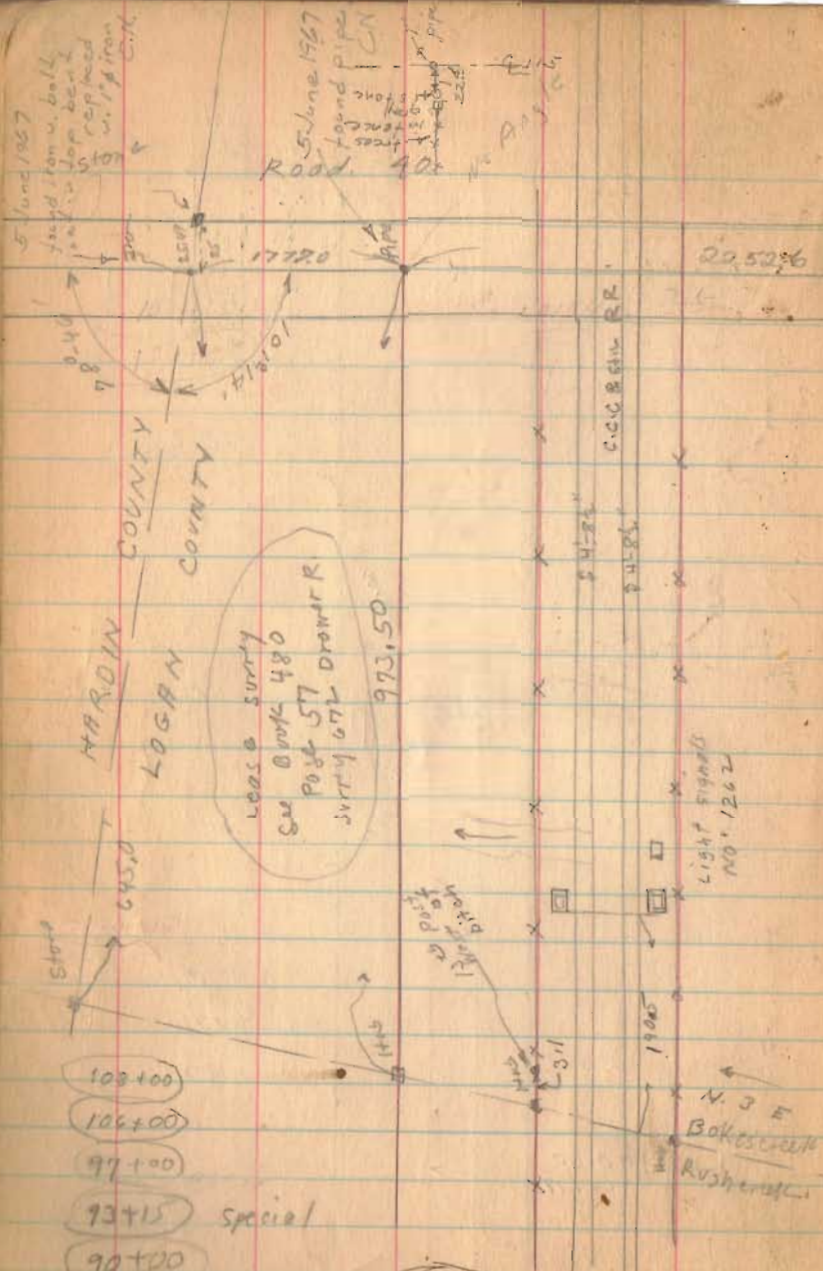


5 June 1967  
 found iron v. ball  
 for bent  
 replaced  
 with iron  
 C.M.

5 June 1967  
 found pipe  
 C.M.

- 103+100
- 106+100
- 97+100
- 93+15 Special
- 90+100

1524

INDEXED ON MAP

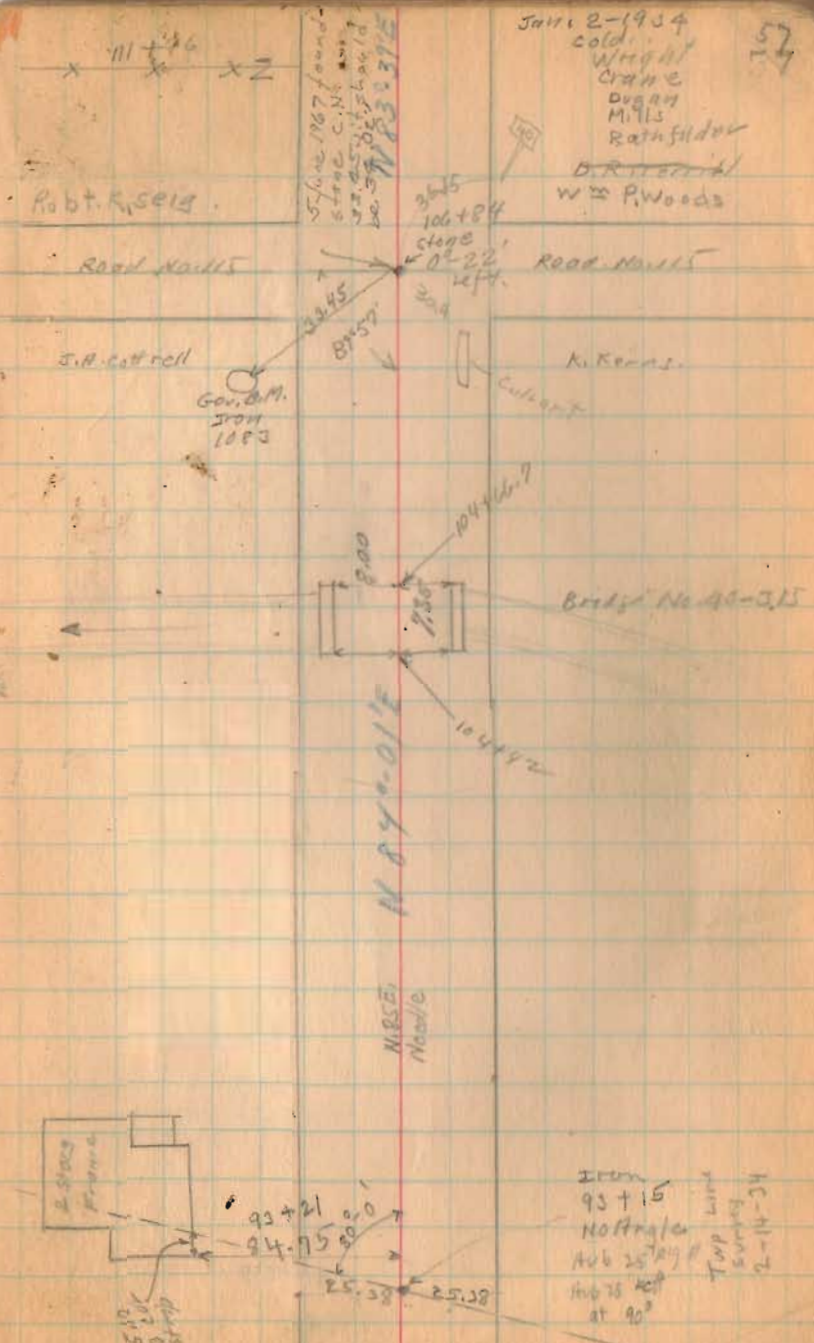

June 2-1934  
 cold  
 Wright  
 Crane  
 Dugan  
 Mills  
 Rathfelder  
 D. R. ...  
 W. P. Woods

5 June 1967 found  
 C.M.



Iron  
 93+15  
 No. 11/16  
 No. 25  
 No. 76  
 at 90°

HC-N-2-24

Road: 40

1-2-34

129+00

122+00

121+00

115+00

1524

INDEXED ON MAP

7 June 1967  
found stone  
W. brick C.N.

D. & R. Ford

Robt. seig

cor. post with capped nail

50.38

N 83°-39'E

N 83°-39'E

84.20

132.4  
126+71

D. & R. Ford

CINCINNATI POST 125+03

W. g. woods

stone found  
found brick  
at top

121+53.5  
2-05' left

DRILL

76.7

114 + 38

1/2 story  
FRONT

59.6

119+79.5

2 story  
FRONT

2 story  
FRONT



1-2-34

59

59


Road 40

5717182-

x 140753

Native Krome  
John D King

N 83°-34'E

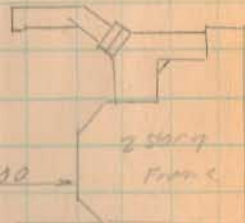

72.00

25007  
Franc

130753

John D King  
Native Krome x 136756

D. R. Ford



consolidate  
client  
BRIDGE  
43-5175

142+00

Native D King  
130760 No Found

D. R. Ford

Iron Found  
placed stone on top  
130+60  
No Angle

136+00

1524

INDEXED ON MAP

Save it  
Circuit  
Post



Road. 40

142+00

155+00

148+50

1529

INDEXED ON MAP

10147

John M Scalloch

(No. 1000) ?

Blair M ~~Scott~~

M<sup>c</sup>Ginnis

M<sup>c</sup>Ginnis  
Blair McNeill

x Large 14024  
13416

M. Stevenson  
Byron G. Catwell

Byron G. Catwell  
M. Stevenson

x x x x  
B. G. Fisher

1-2-34

60

60

N 83° - 39 E

N 83° - 34 E

Clara J. Lantz  
x 150+31

Nellie K. Lantz  
John D. King

Iron  
148+03.5  
02 05' Right


Road 40

174 + 00

168 + 00

1524

INDEXED ON MAP

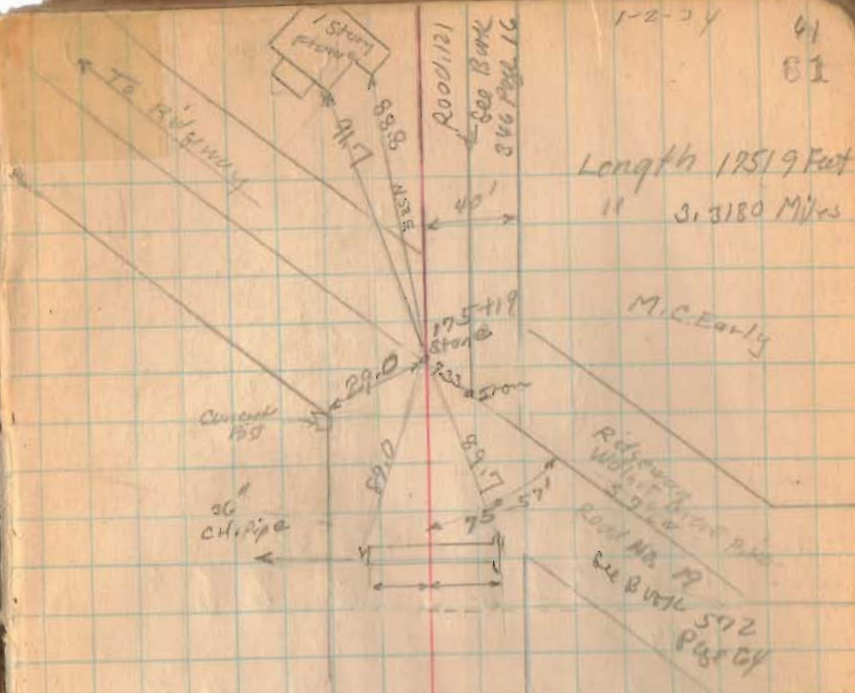

Dennis Ford

164 + 125

John M. C. M. M.

N 83° - 39 E



Road. 103

1-2-34

64  
83

36+89 x Z x



39+00

33+00

31+50

22+00

22+00

J. R. Hunter

32+09.5

J. L. Mangham

J. L. Mangham

W. E. Langhorne

Iron  
32+07.5  
0' 13' 1/4" + f.  
STAT 25' 4" + f.  
STAT 25' 2" 40'

Red Slough



BRIDGE NO. 103-4.50

25+00.5

2 story  
Frame

12/120  
2/711

N. 27 E.  
N. 27 E.

1526

INDEXED ON MAP



Road 103

62+00

57+00

55+00

47+00

1526

INDEXED ON MAP

1-2-54

65

65

x 66+23

LANE

Ward Swatland

59+915

W.E. Laughlin

10502

V.M.S.

N. 95<sup>3</sup>/<sub>4</sub> E  
NE 1/4

M.H. Wilson

56+065

Iron & Stone

3'-14" left

N. 1/2 Sec 14

N. 1/2 Sec 14

(No. 100) 7

x 56+065

J.H. Hunter

W.E. Laughlin

48+12

J.L. Marshall

14032

X.M.S.

x 45+20

Concrete  
Pile

LANE

15.80  
16.10

x 45+00

Road 103

Jan. 3, 1934 66  
cloudy 88  
Wright  
Crane  
Dugan  
Mills  
Rathfelder



84+00

77+00

70+22.2

1526

INDEXED ON MAP

1200

1100

The Bridge  
103-100

80+60

80+77.9

farm

80+89

80+485

pasture pasture

80+73.4

Wood swaland

90+31.6

90+22.2

Placed Iron  
No Angle  
Hue 25' off + 4' right  
Hue 25' off + 4' right

Rushreek

N 15° E  
North

Richland

90+22.2

70° 35'

70° 35'

Town ship

Town ship

2 story  
Farm

County line  
St. No. 21.  
Book C  
Page 436

Township  
Logan

Harden Co.  
Logan co.

140' 20" Elm

140' 20" Elm

Road 103

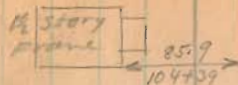

103+10  
Stone front  
NO HINGE  
STAIR 25' RIGHT  
STAIR 25' LEFT

John Stuber

103+10

Piston Pistle



Front Window

96+28.5

R.G. Waples

Iron  
96+28.5  
02.04' left  
HUB 25' RIGHT  
HUB 25' LEFT

103+00

96+00

89+00




R.G. Waples

90+00

M.H. Wilson

134.3  
86+90

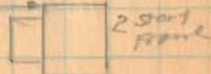

1526

Rail. 103

1-3-34

68  
20



Bridge No. 703-255

V.M.S.

9991

122+84  
Stone found  
Hgt 25' left  
Hgt 25' right  
0'-04" left

R. Crawford

x 122+84 x

x x x x

G.E. Lowery

S. Mitchell

V.M.S.

10502

119+63  
Iron Found  
No Angle  
Hgt 25' right  
Hgt 25' left


No. 119+63

J. Newlin

G.E. Lowery

x x 112+9 1/2

Frank Harwood

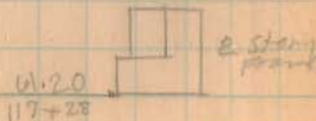

11.20  
117+28

J. Newlin

x 211+48 x

John Stuber

211+48  
Stone Found  
Hgt 25' left  
Hgt 25' right  
0'-01" Right

121+00

124+00

117+00

110+00

1526

INDEXED ON MAP

Road 103

151+00

145+00

138+00


1526

INDEXED ON MAP

1-3-24

69

69

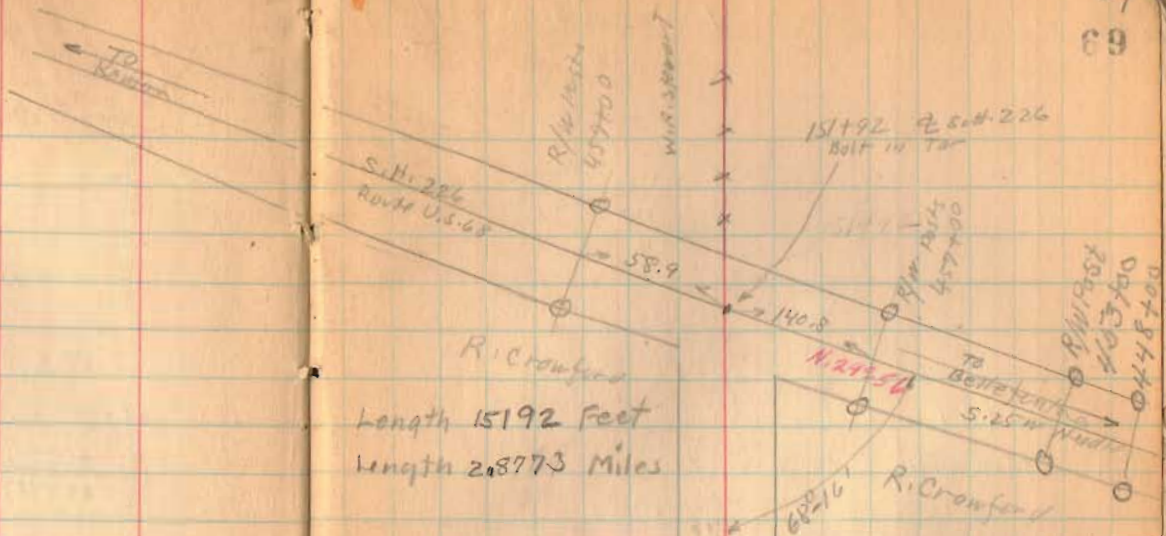

Road. 110  
Rushcreek Trp.  
V. M. S. 10041

60' Road. Comm. Journal  
No. 4 Page 82-84  
June 1834


Stakes placed for 50'

1624

INDEXED ON MAP

Dec. 9, 1934  
Cold Wind  
F. Wright  
E. C. C.


71

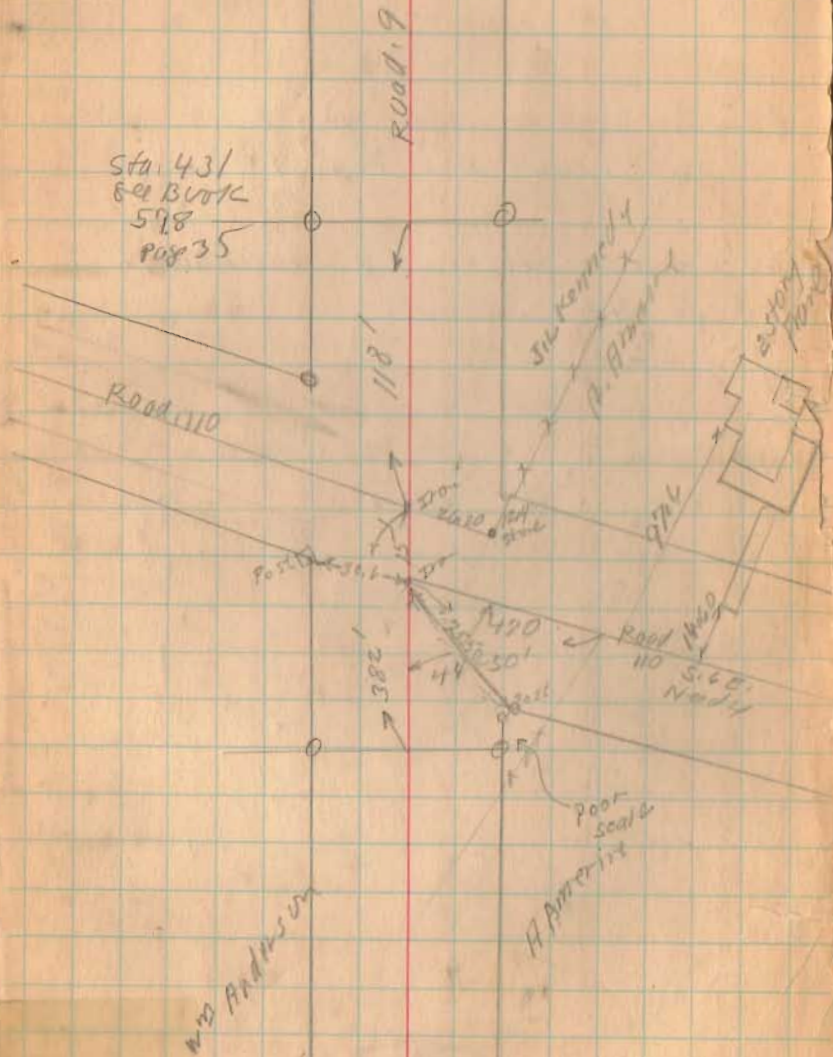

Road 47  
Monroe Twp.

Stake Placed 25' from  $\&$  at station  
as shown on pag 72

60' - Commissioners Journal No. 2  
Page 148

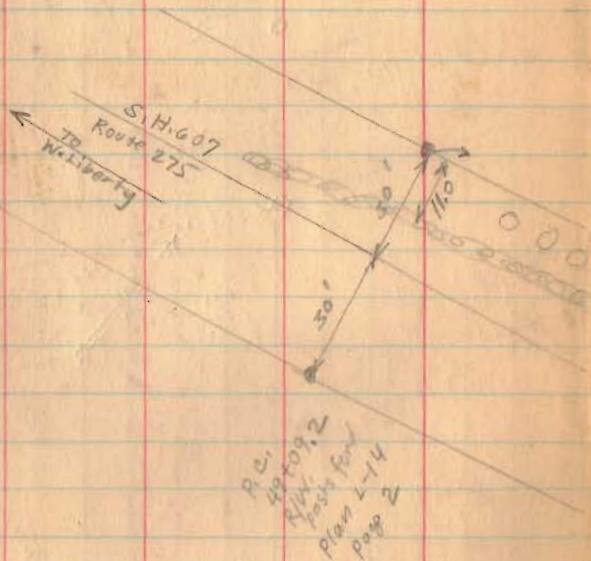

1716

INDEXED ON MAP

May - 5 - 1936

72

clear - Winton


F. H. Light

E. Corc

G. McLaughlin

Earl Coomer

78

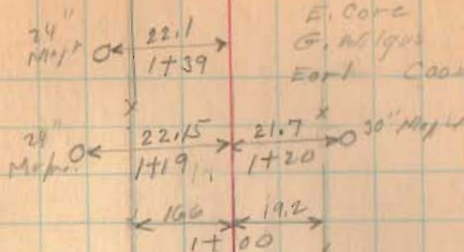

B. B. Gantz

190.45  
Neddy

190.45

190.45


190.45

190.45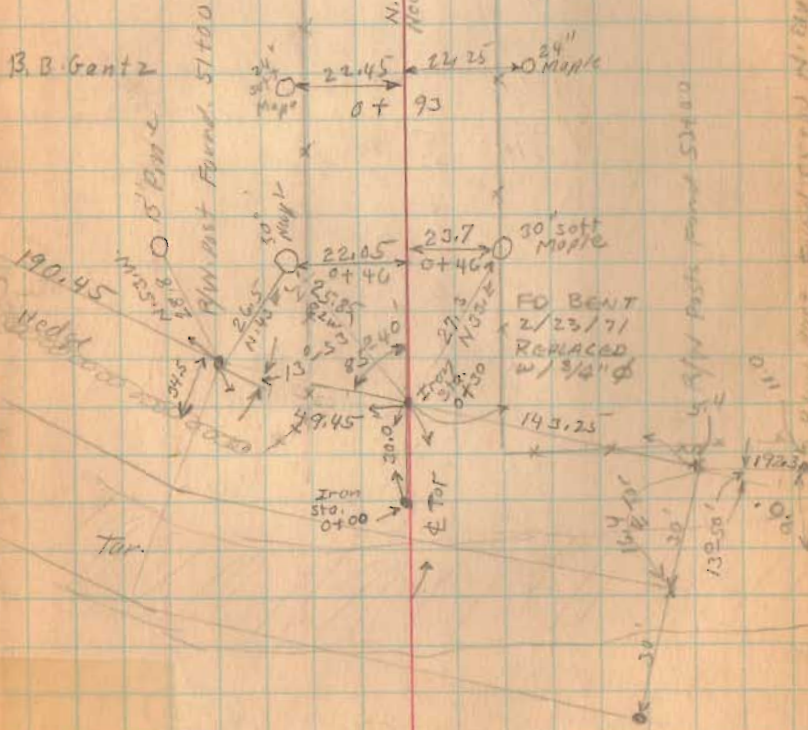

B. B. Gantz

5' 9/16\"/>

5' 9/16\"/>

11

11

(L) (R)  
Short Hds. in wheat fields

Road. 47


Stakes	1+00	L-R
	3+00	L-R
	4+84	L-R
Pl.	5+78.5	L-R
	7+13	L-R
	9+00	L-R
	21+00	L-R
	23+00	L-R
	25+00	L-R
	27+00	L-R
	29+00	L-R
	30+01	L-R
	31+00	L-R
	33+00	L-R
	35+00	L-R
	58+00	L-R
	59+09	L-R
	61+00	L-R
	63+00	L-R
	65+00	L-R
	67+00	L-R
	69+00	L-R
	71+00	L-R
	73+00	L-R
	75+00	L-R
	76+00	L-R

1716  
INDEXED ON MAP

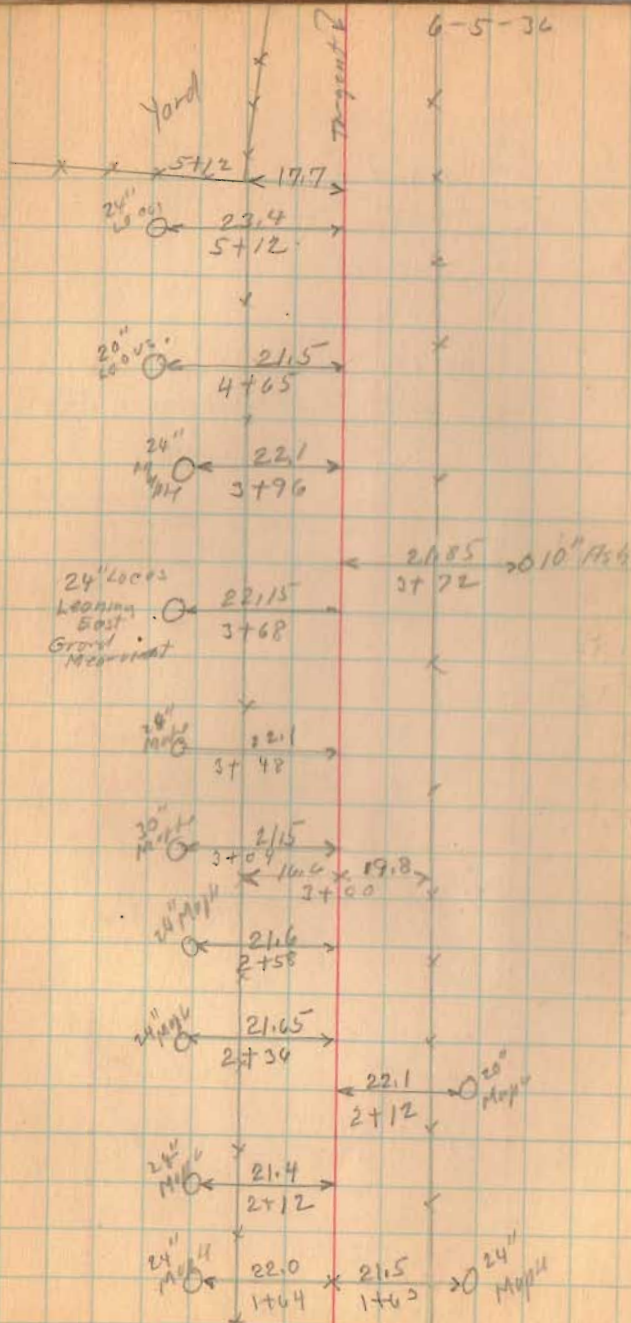



Road 47

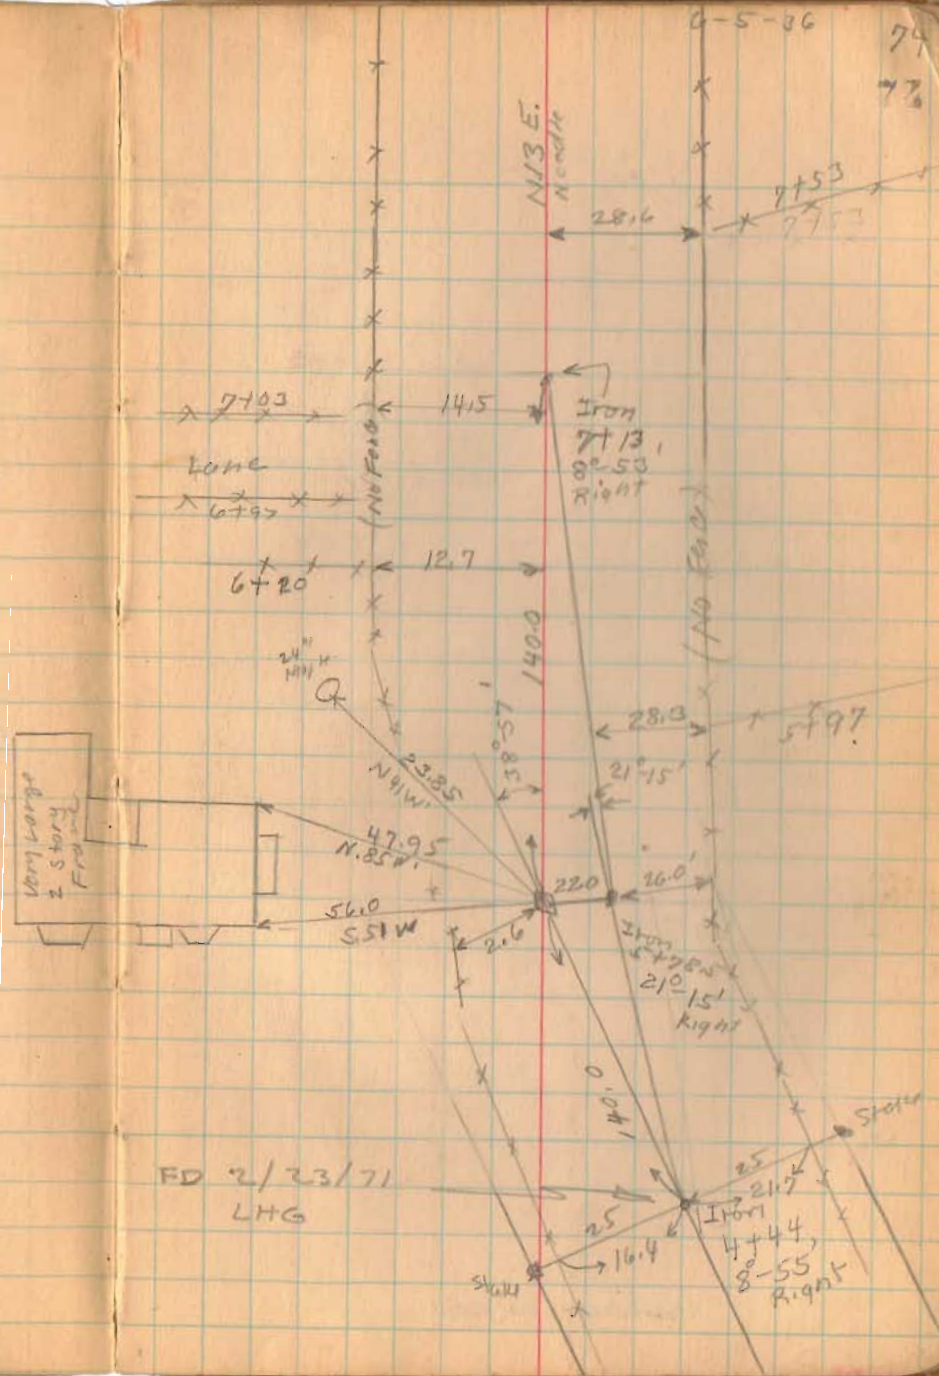

1710


INDEXED ON MAP

Road 47


May-22-1948  
Station 20+37  
Stone found.  
Placed Pipe over stoc  
Added Witnesses  
as shown in Red.  
Grover Wilgus.  
F.F. Wright

1716  
INDEXED ON MAP

SEC. 22 T.5

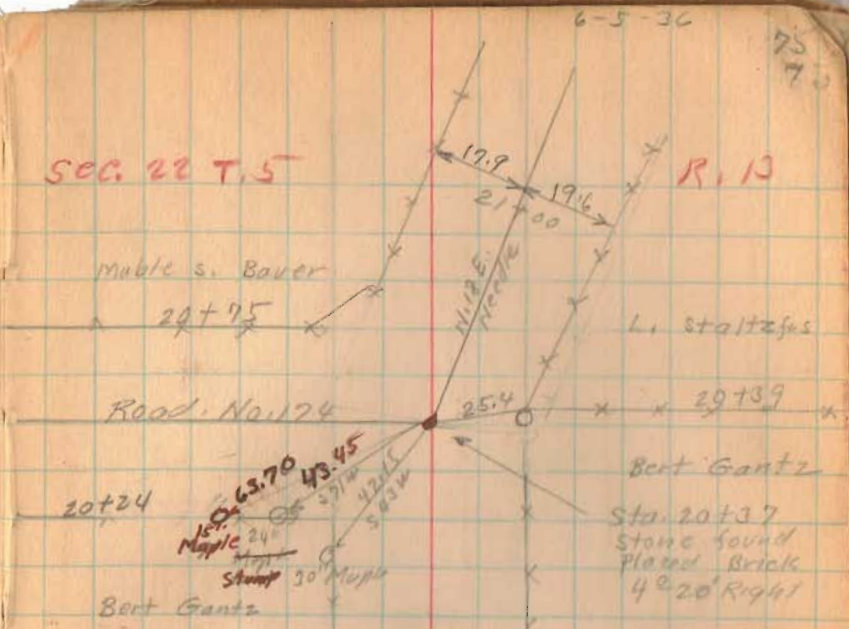

sec. 21

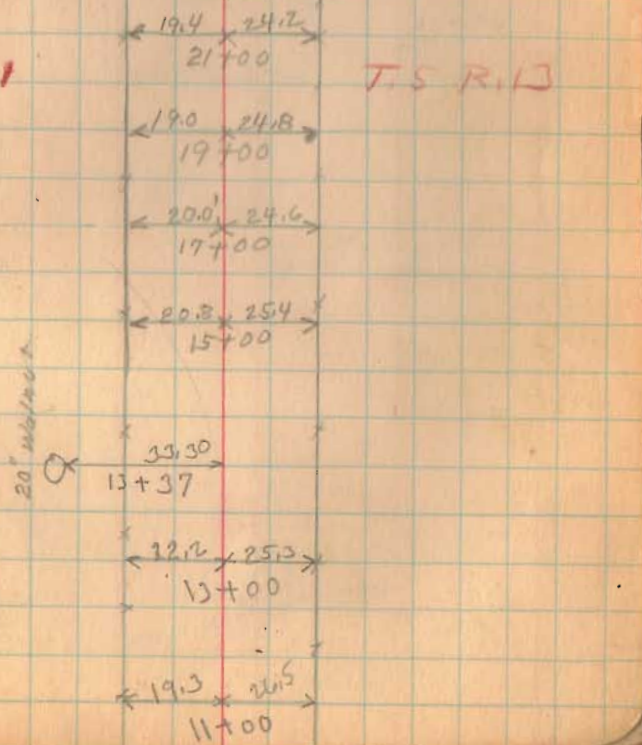

6-5-36  
75  
70

R. 13

T.5 R.13

Mable s. Bauer

29+75

L. Staltzfas

Road No. 174

Bert Gantz

20+24

63.70  
43.45  
37.10  
42.15  
50.30  
Maple stump  
30' Maple

Sta. 20+37  
Stone found  
Placed Brick  
4° 20' Right


Bert Gantz

20' marker

Road 47

6-5-36

76  
76

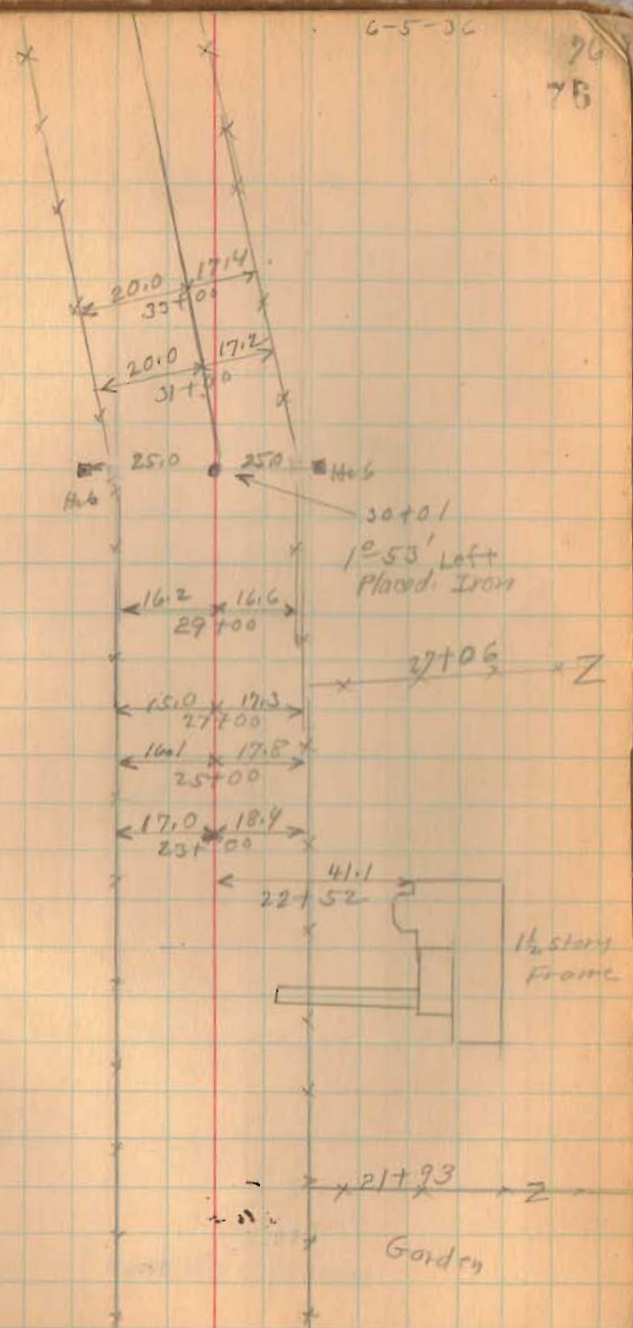




(1716)  
INDEXED ON MAP

June 6-1936





clear  
F. Wright  
E. Carr  
G. Wilgus.

77  
77


Road 47

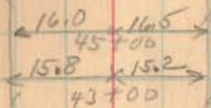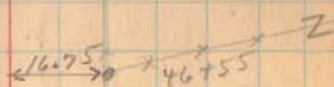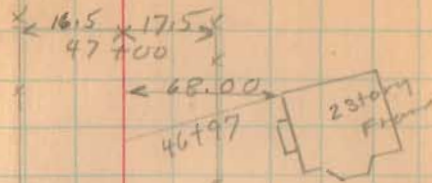

Zx 41+25  
Lane

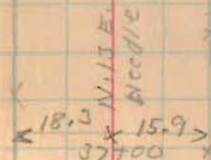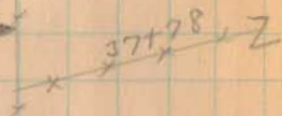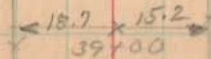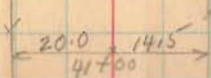

Stone found  
34+52  
2°-18'

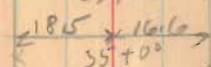

Green B. Leisure



Mable S. Bauer et al.

L. 3+91+2 fcs

1716

INDEXED ON MAP


Road 47



1766  
INDEXED ON MAP

6-6-36

59+09  
Stone found.  
17° 40' left.

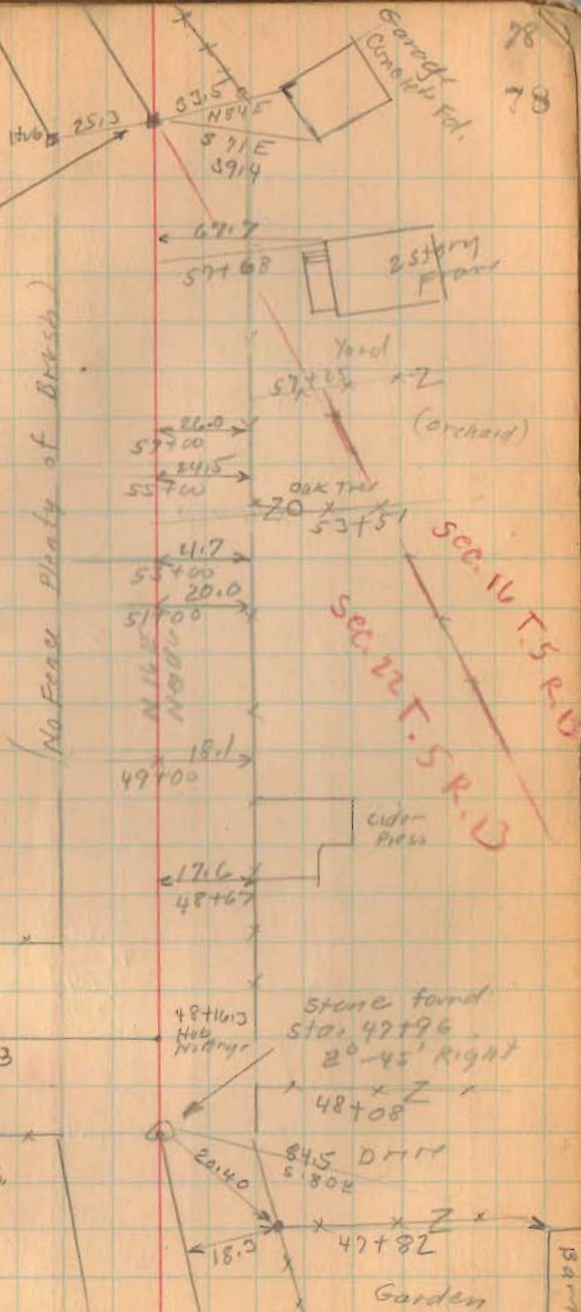

78  
78

