



Job #88

S.22 T.6 S. R. 8 E

Stokes Top Logans Co. OH

The Bellefontaine Development Co

CA Meeker  
FL Hencil  
Robt. Hynes


4-23-07

5697

57.8

4.17

88

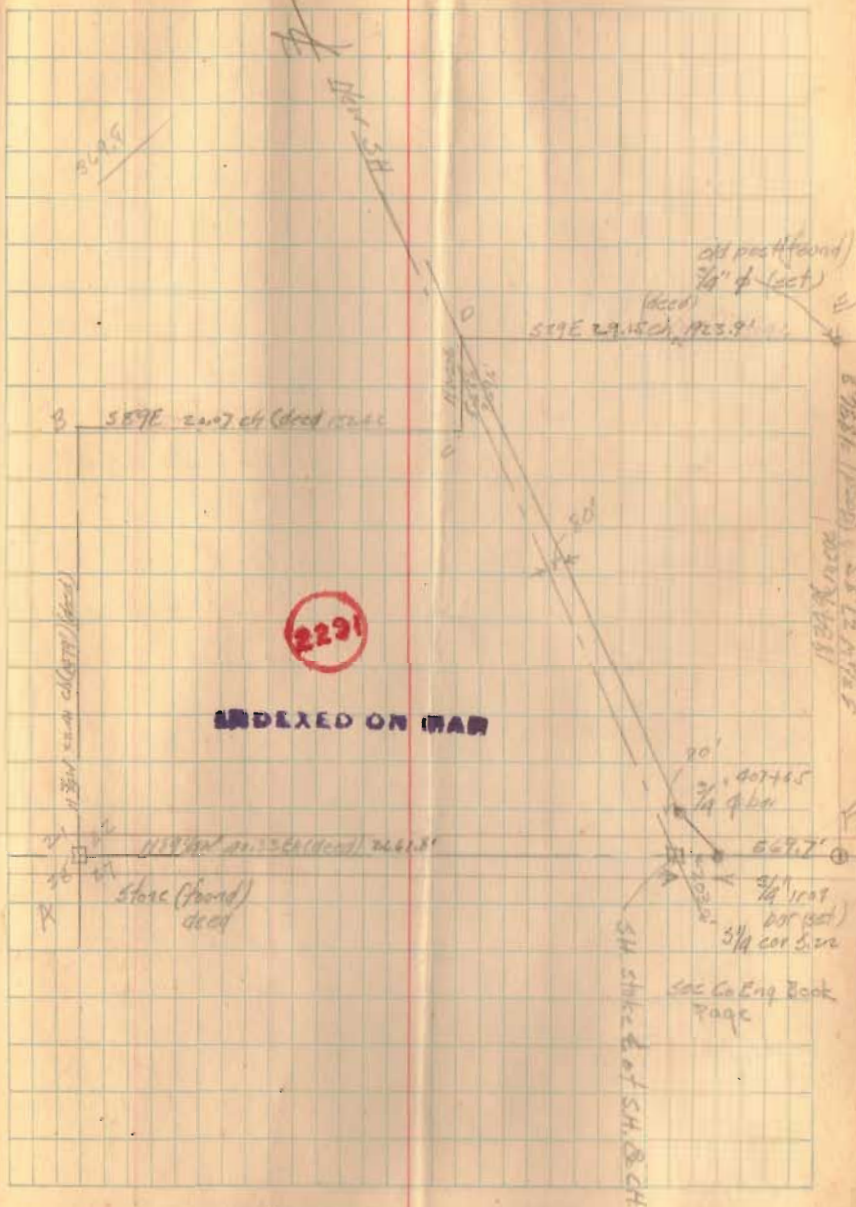





91  
309.6  
2.8  
366.8

Calykeep  
L. Howell  
Robt Hughes  
4-28-47  
4-29-47  
5-1-47

597.5  
17  
614.8

17 coc 15-29 92176  
17  
680232  
27135  
1671492  
1479 (82.56)  
1936 0-42'

78-00  
11-42-30  
89-42-30  
19-31  
70-11-30.15

Am 10-41  
9267 / 30000  
34  
146600  
9267  
1316155  
316




5965  
900  
5144.0  
9.2 cot  
89K = 8.97'

1273 / 60.00  
2672 / 20000  
115314  
2474  
69

Job #88

357 45 / 537 ( 92  
79-00  
11-42-30  
90-42-30

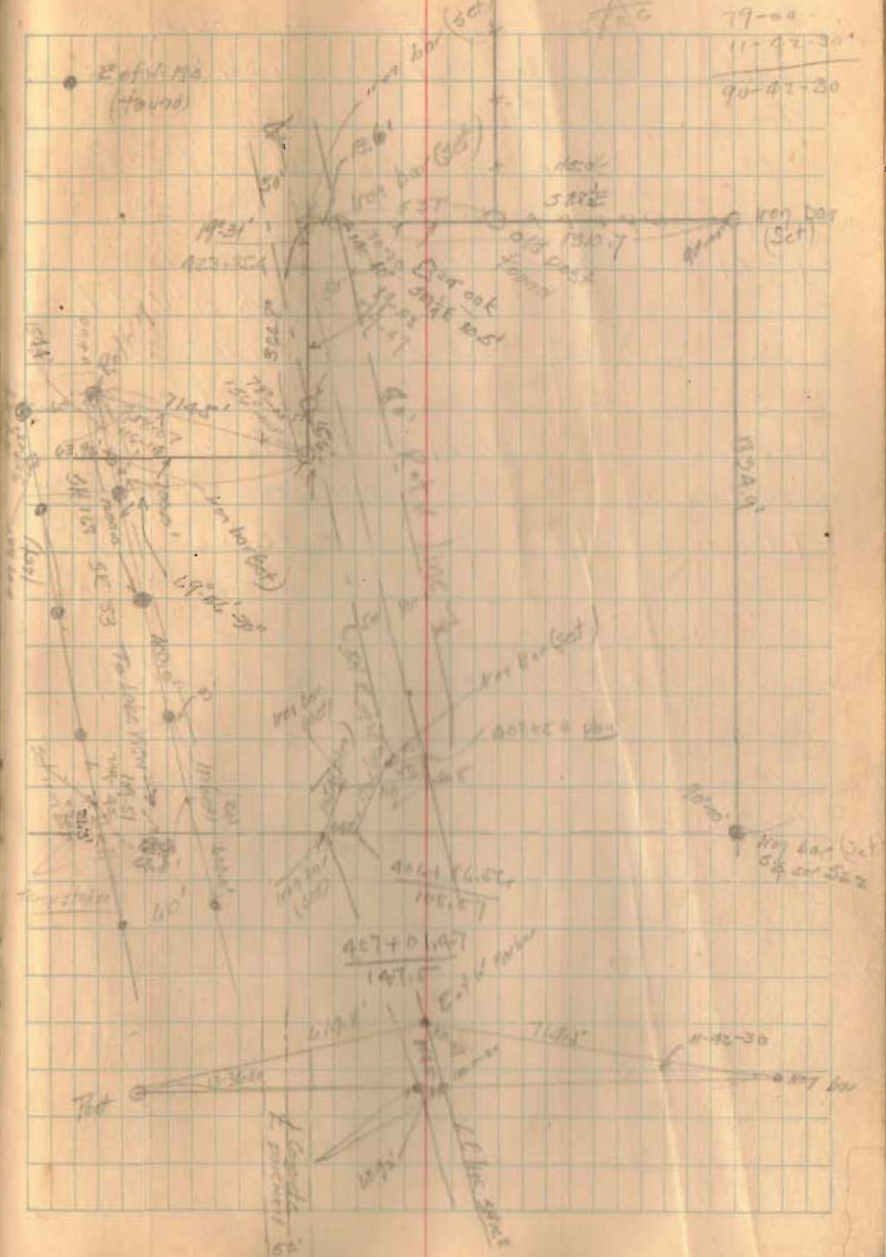



Job No. 136

Right of Way Marker  
State of Ohio

Survey for Joe Gardner

S 30 T 5 R 13

Dist. Twp Logan Co., Ohio

# Liberty


see Book 16 Page 24 12/26/07

1/2" N of M

13 feet on

C.H. Hopper  
Get Carriage  
for Harvest  
Roll

12/10/07

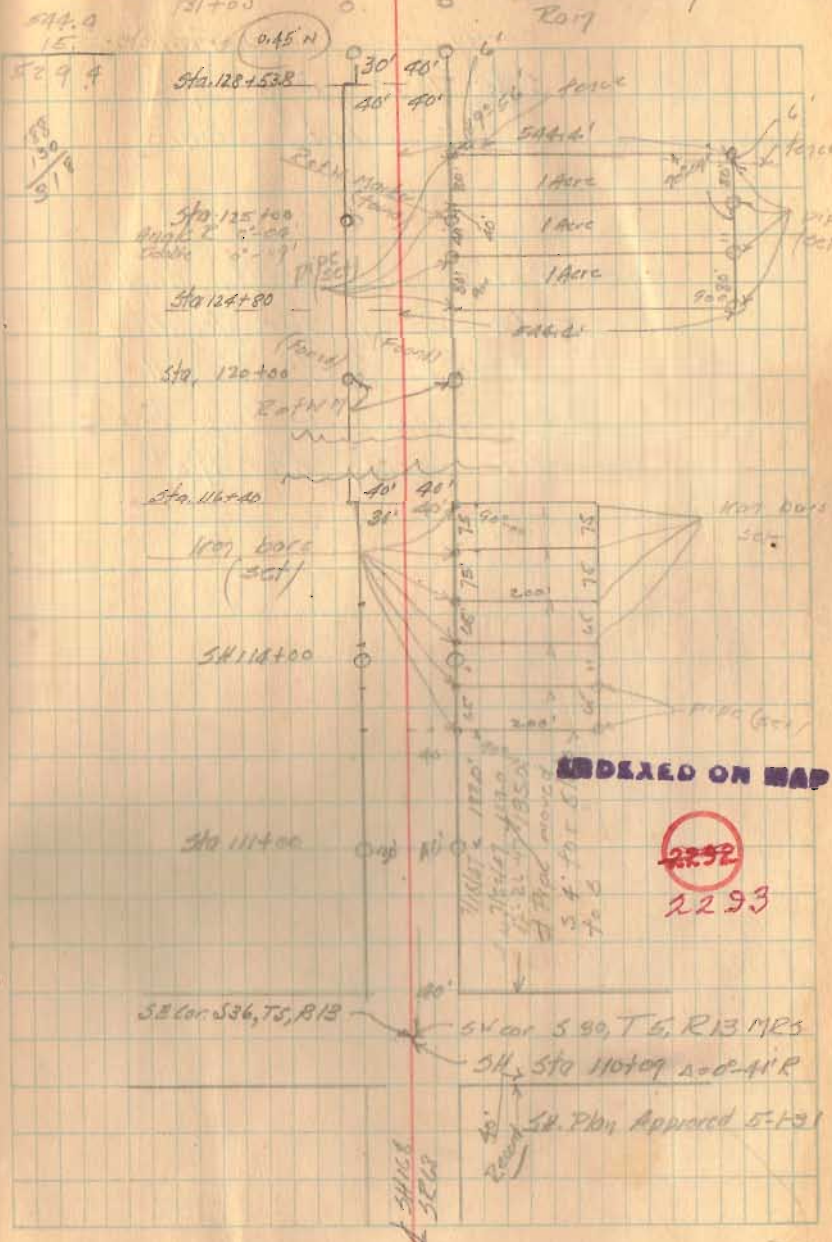

105

$$\frac{231}{8.16} = 28.18$$

$$\frac{125}{250} = \frac{276.5}{550}$$

$$\frac{175}{75} = \frac{175}{75}$$

$$\frac{30.000}{2982} = \frac{30.2}{1800}$$

$$\frac{359}{22} = 13$$

66-13'

95-56

175-09

22-46

359-59

Job No 128

GAMBECP  
old County  
Ch. Howard
 Survey for Vance Fraley  
 S25 T5 R15 MBS  
 West Liberty, Ohio

 See Rot W map County Engineer's  
 file L-31 for location  
 at Rot V of old C.H.  
 See page 110 this book  
 for survey and "M's"

76

$$\frac{1476}{310}$$

103.2


$$\frac{107.2}{22.2} = 4.83$$

10.5

707.2

106

$$\frac{797.7}{407.7}$$

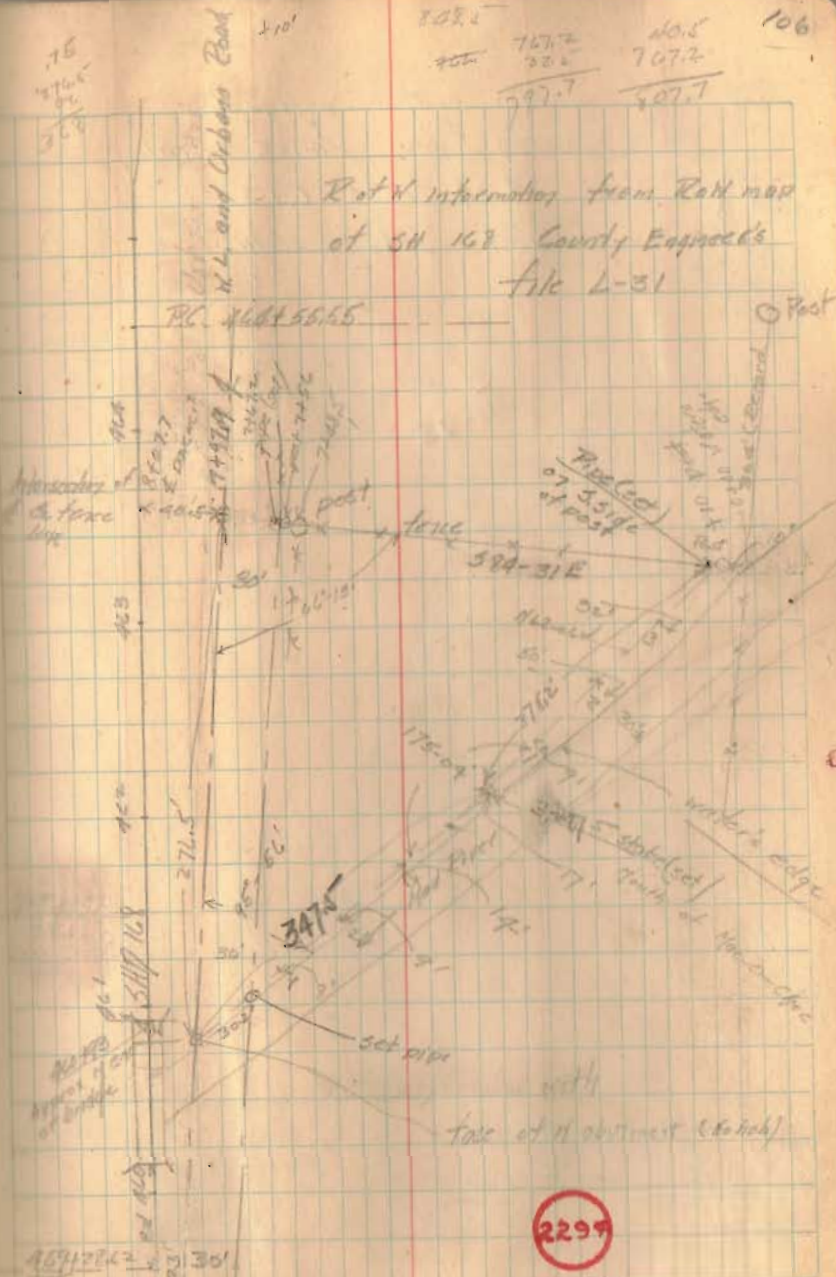 Rot W information from Rot map  
 of SH 168 County Engineer's  
 file L-31




111  
 996.51 262.7  
 220.57 180.7  
 843.4  
 82.7  
 3  
 98.  
 18.2  
 461.9  
 15.6  
 466.4

172  
 18.5  
 40.7

Survey for Sarah Errig  
 35 T 5 R 15  
 27 S 13  
 West Liberty Liberty Twp  
 Logan Co Ohio.



18.6  
 98.8  
 3.  
 119.8  
 15.5

28-37

104.  
 195-30  
 55-56 x1  
 195-31  
 98-27 x1  
 195-09  
 170-52  
 961-30  
 95-21  
 996-56  
 151-26  
 1448-22  
 111-35  
 61.06  
 259-57

✓ 107-25  
 ✓ 151-23  
 ✓ 91-26  
 ✓ 98-30  
 ✓ 196-30  
 646-16  
 ✓ 55-56  
 195-36  
 ✓ 170-53  
 1068-40

108-28 ✓  
 151-23 ✓  
 91-25 ✓  
 98-30  
 195-30  
 56-56  
 195-36  
 895-27

260  
 1048-22  
 111-35

159-25  
 151-23  
 310-31  
 901-30  
 162-21  
 95-26  
 257-41

182  
 75  
 76.2  
 3

Chinokeep  
 Off Common Appox 1/4  
 Cecil Rathen Spring Hills Road.  
 Pick

7/25/47

