





lot 1205 (Conklin survey)

- A - Iron 2nd stone
- B - Iron
- C - Iron 25' from Cemetery Hedge  
This iron is on E. edge of gravel
- D - Iron
- E - Iron
- F. Hub
- G Iron
- H. Iron
- I Iron


ABC = Straight line.

See Book 512  
Page 71-72

See Pages  
28-29 This Book

1708

INDEXED ON MAP

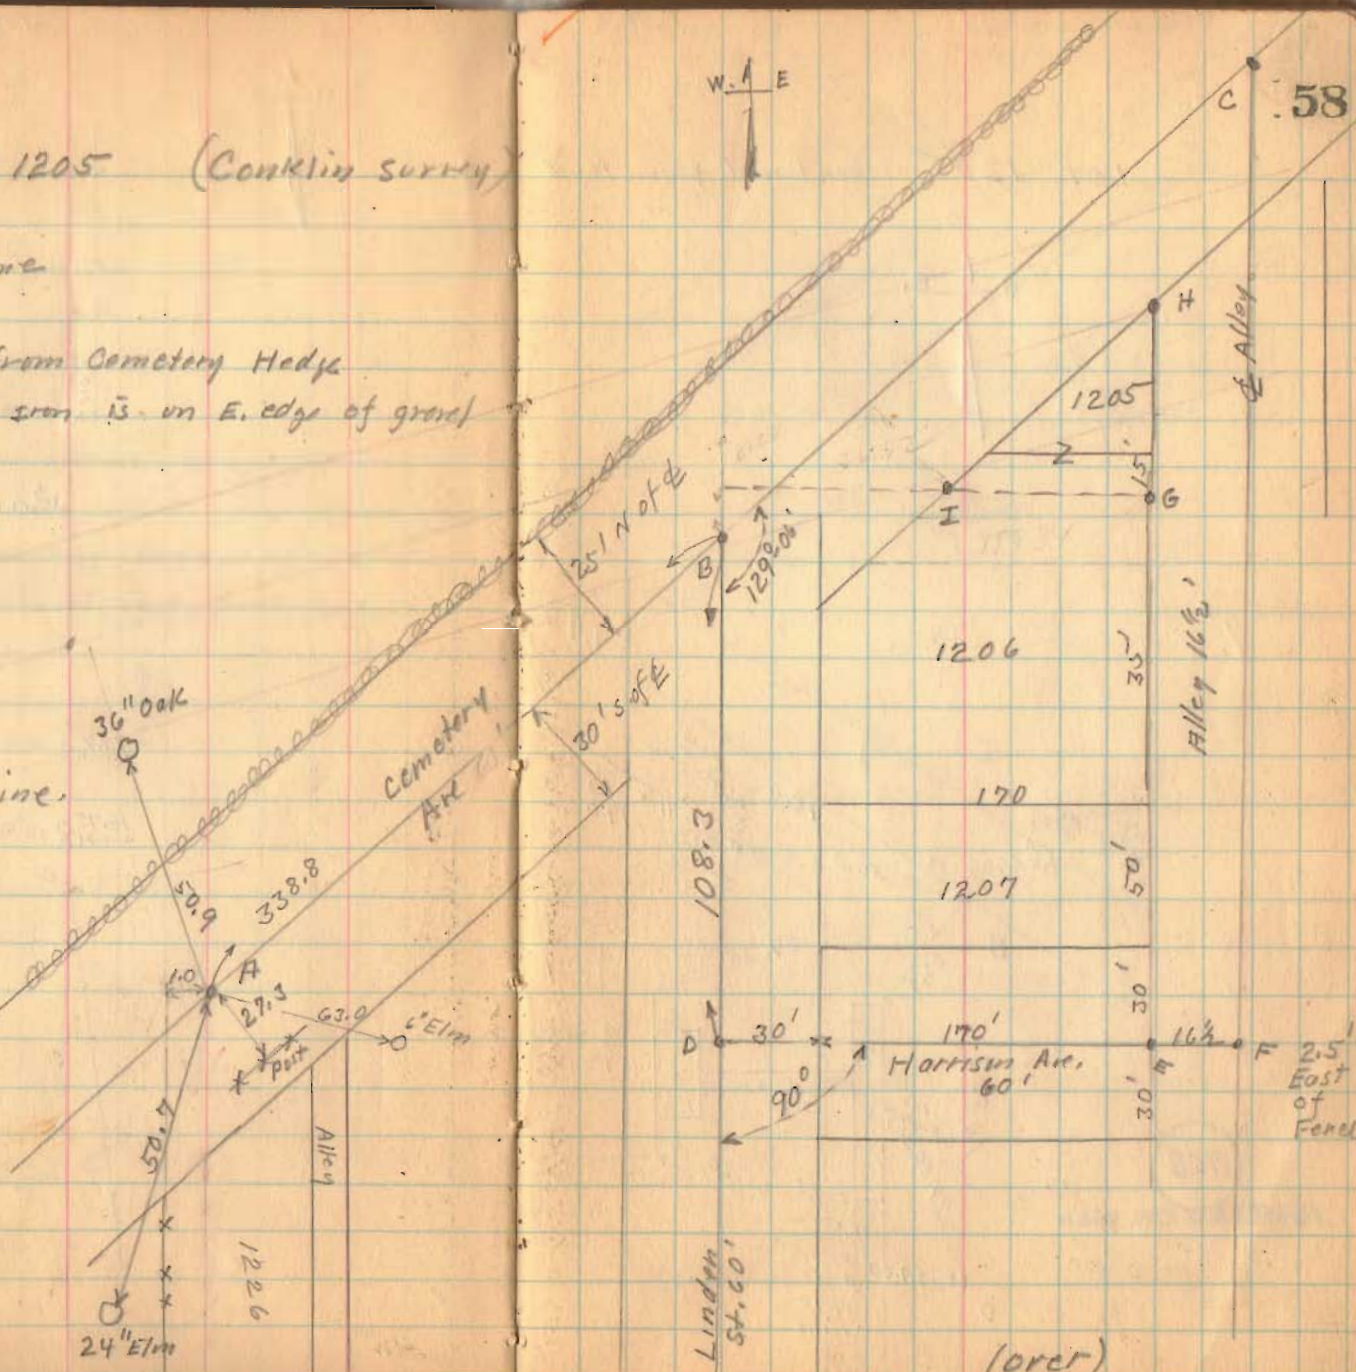

(over)



Lot 1205 (Continued from Page 8)




JUNE-26-1933  
F. Wright  
W.R. Wright

12" Catalpa  
Nail 4' up

15" Elm  
Nail 6' up

59

(Cemetery)

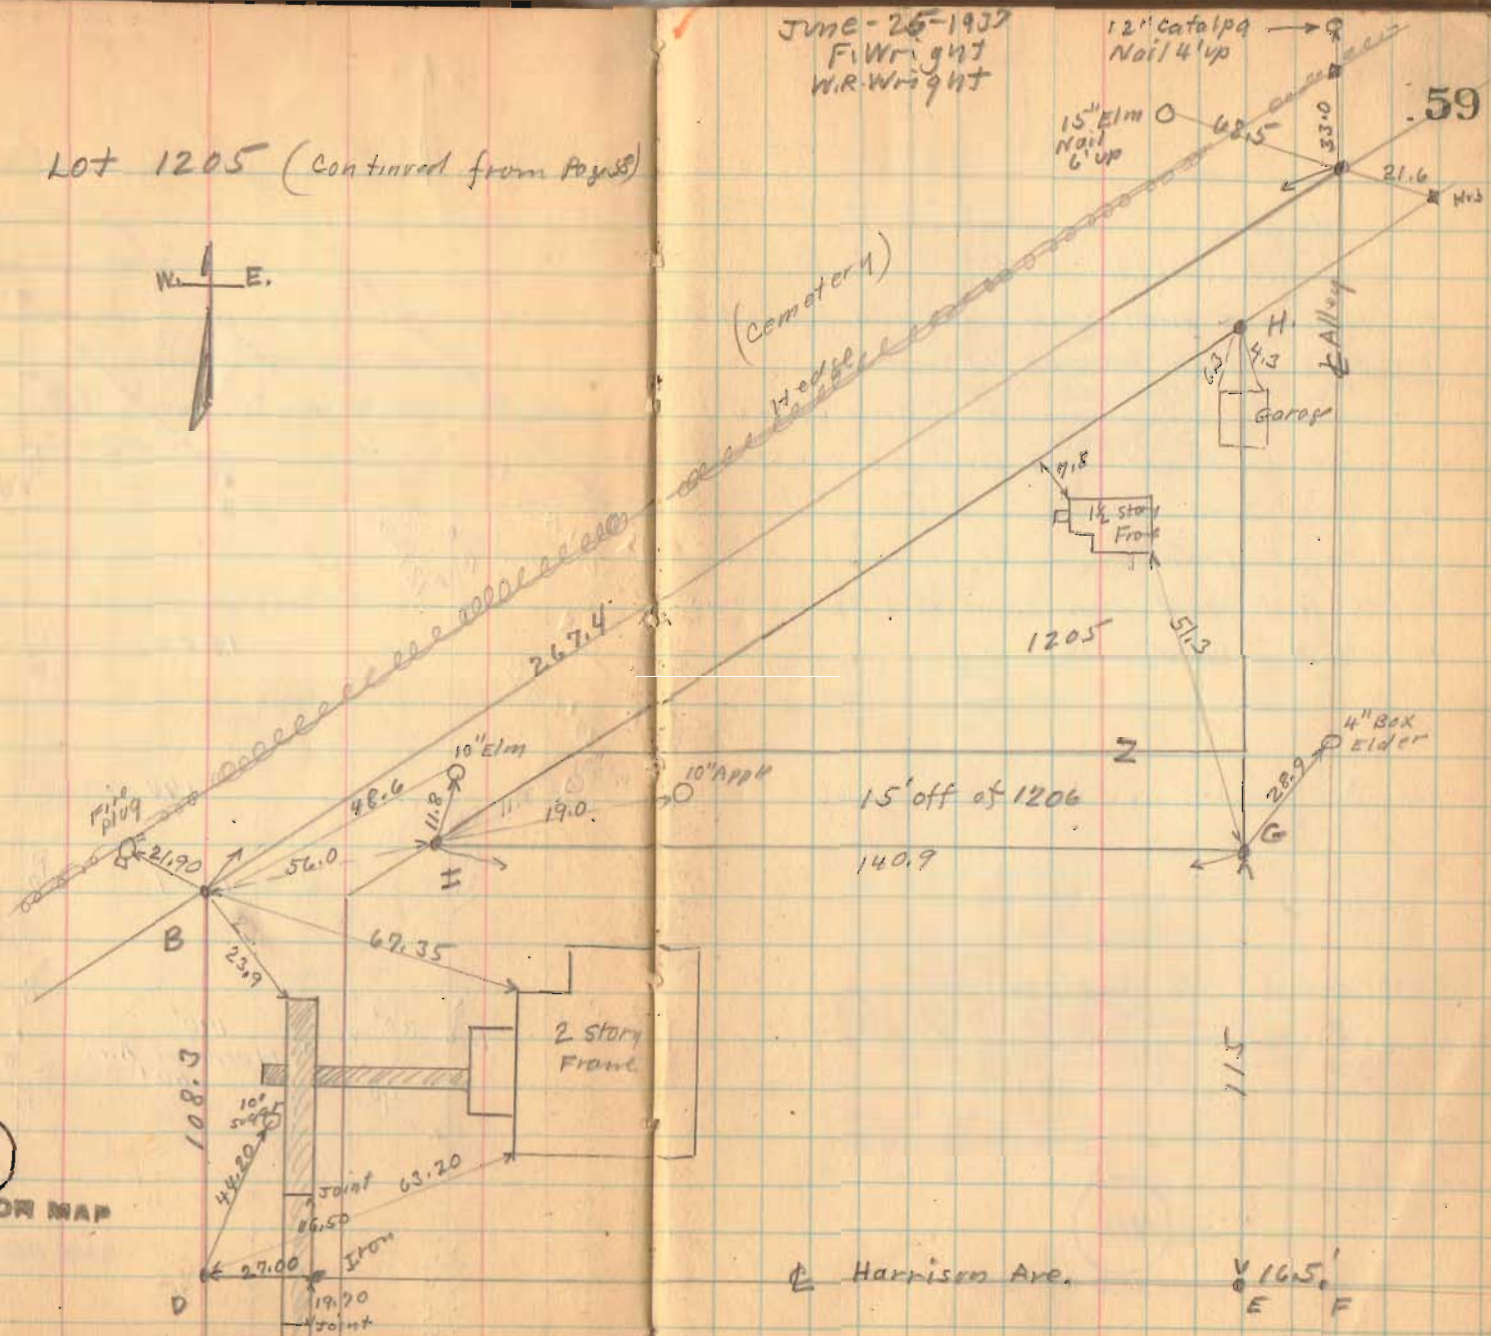

1708

INDEXED ON MAP

Harrison Ave.

16.5'  
E F