


Return to McCalum Ditch





McEldin Dun Ditch 5/21/11

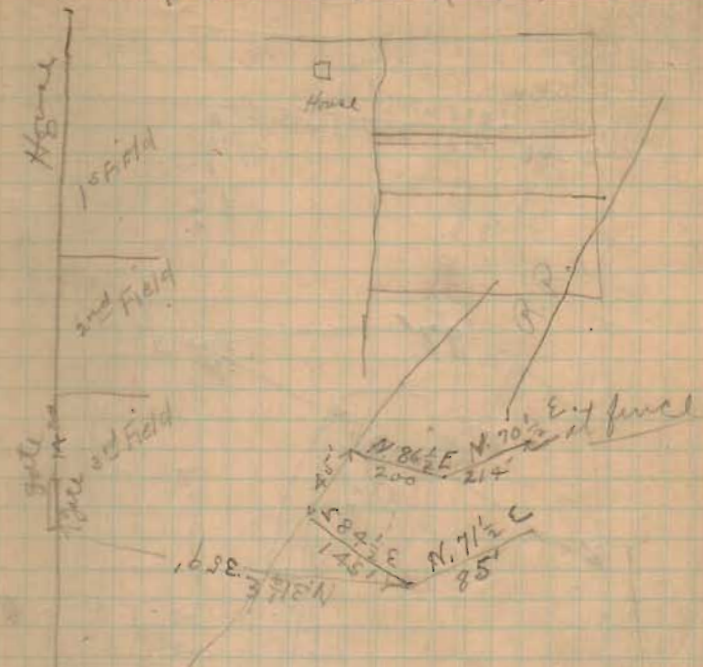

Bearings down stream  
39 ft to gate.

North



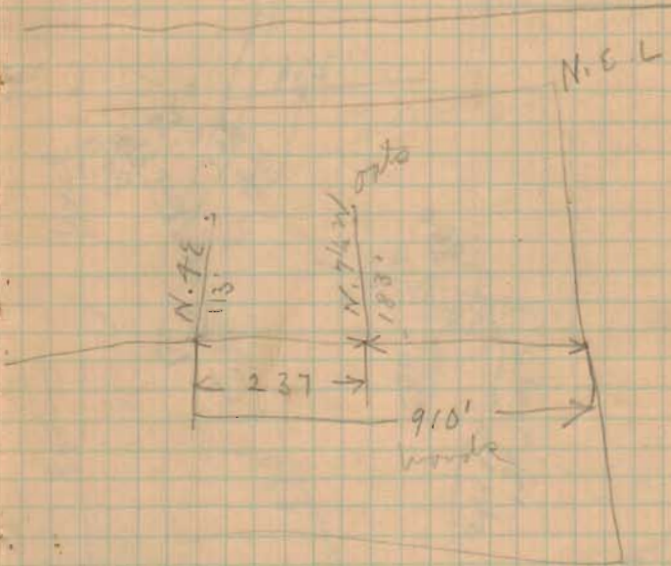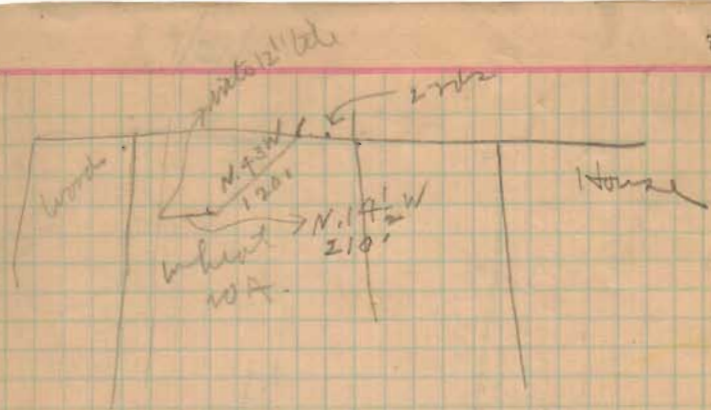

wood

