


Set on Mon # 36

Orig brg S-52 1/2 E

Correction to data (est) 1°-15'

Pres. cse (approx) S-58-15 E = 306°-45'

— 306°-45' (S-58°15' E)

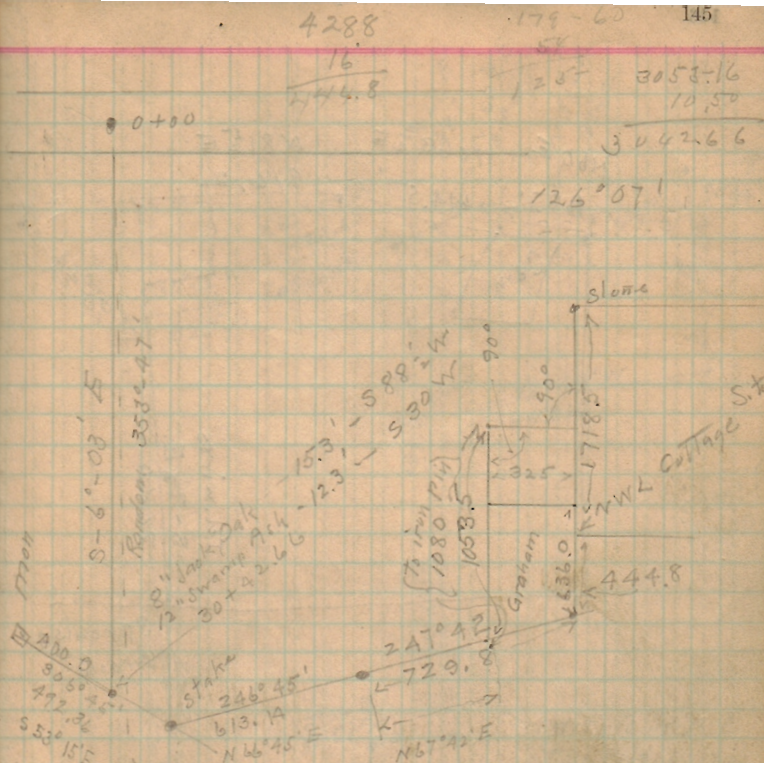

440