

SURVEYOR'S CERTIFICATE

The annexed plat correctly represents OAK ACRES, in part of Section 1, Town 7 South, Range 8 East in Washington Township, Logan County, Ohio as surveyed July 1949.
 3/4" Iron bars were placed at all points marked \bullet . Stakes were set at each lot corner.
 Distances are in feet and decimals of a foot. The area included is 17.33 acres.

Clair A. Inskeep
 Registered Surveyor No. 1843

DEDICATION

Know all men by these presents that The Bellefontaine Development Company, proprietors of the land indicated on the accompanying plat have authorized the laying out of the same as indicated in the accompanying Plat and do hereby dedicate the streets to the use of the public forever.

Phyllis Jane Tracy
 Witness
David M. Coburn
 Witness

Arthur J. McCracken
 President
James D. Askren
 Secretary

**STATE OF OHIO
 COUNTY OF LOGAN**

Be it remembered that on the 27 day of December 1949, before me the subscriber, a Notary Public in and for the said County, personally appeared Arthur J. McCracken, President and James D. Askren, Secretary of The Bellefontaine Development Company, grantors in the foregoing dedication, who acknowledged the signing thereof to be their free and voluntary act and deed, as such officers respectively, and the free and voluntary act and deed of said Corporation.
 In testimony whereof, I have hereunto subscribed my name and affixed my Notarial Seal on the day and year last aforesaid.

Julia M. Canby
 Notary Public - Logan County, Ohio

COUNTY ENGINEER'S APPROVAL

The annexed plat is hereby approved December 27 1949.

E. K. Love
 County Engineer - Logan County, Ohio.

ACCEPTANCE

The annexed plat was approved and accepted by the Board of County Commissioners at a regular meeting December 27 1949.

E. C. Webber
J. M. Hostetler
Paul J. Ostland
 County Commissioners - Logan County, Ohio.

AUDITOR'S OFFICE - LOGAN COUNTY, OHIO

The within lots transferred the 28 day of December 1949.


118078

Thomas L. Campbell
 Auditor - Logan County, Ohio.

RECORDER'S OFFICE - LOGAN COUNTY, OHIO

Received for record at 12:30 o'clock P.M. on the 29 of December 1949.
 Recorded in Plat Book , Volume , Page .

Paul O. Batch
 Recorder - Logan County, Ohio.

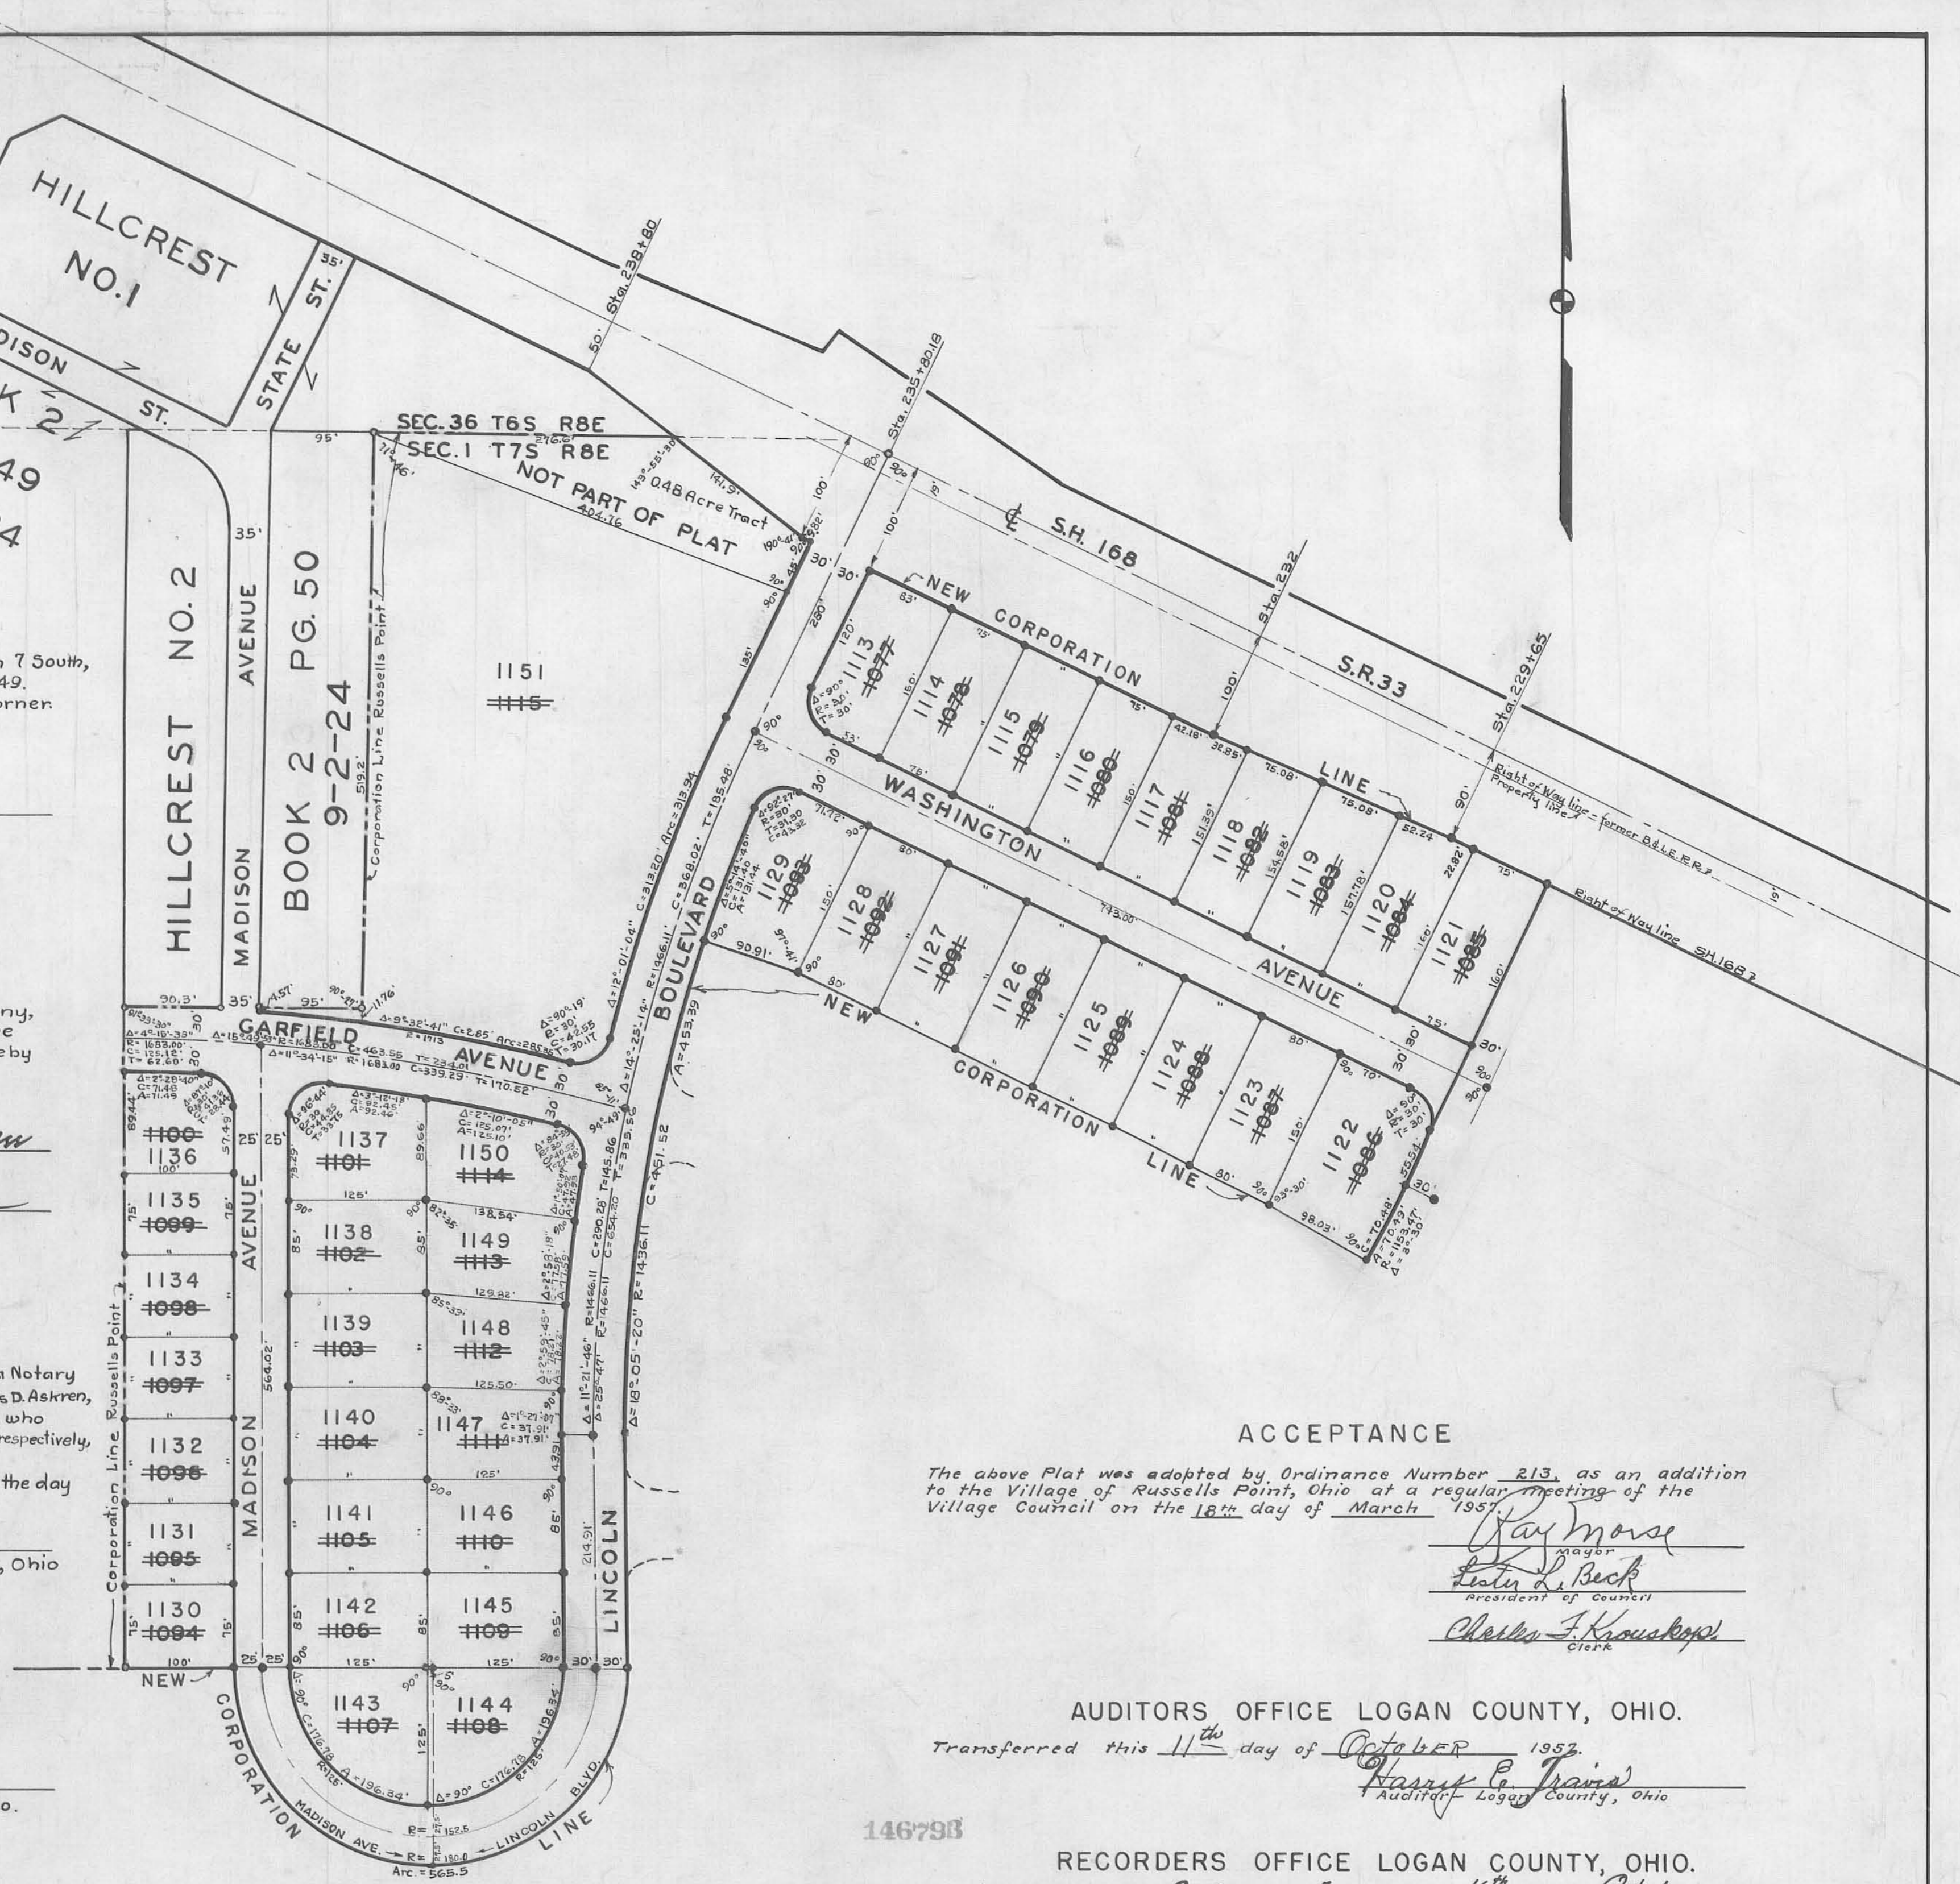

ACCEPTANCE

The above Plat was adopted by Ordinance Number 213, as an addition to the Village of Russell's Point, Ohio at a regular meeting of the Village Council on the 16th day of March 1957.

Kay Morse
 Mayor
LeRoy L. Beck
 President of Council
Charles J. Kowalski
 Clerk

AUDITORS OFFICE LOGAN COUNTY, OHIO.

Transferred this 11th day of October 1957.
Harvey E. Travis
 Auditor - Logan County, Ohio.

146798

RECORDERS OFFICE LOGAN COUNTY, OHIO.

Received for record at 2:02 o'clock A.M. on the 16th day of October 1957.
 Recorded in Plat Book 4, Volume D, Page 50.

Thomas L. Campbell
 Recorder - Logan County, Ohio.


NOTE:
 Lot Numbers show crossed are original numbers of OAK ACRES SUBDIVISION.
 Lot Numbers not crossed are Russell's Point Corporation.

OAK ACRES

A SUBDIVISION OF PART OF SECTION I, TOWN 7 SOUTH, RANGE 8 EAST, WASHINGTON TOWNSHIP, LOGAN COUNTY, OHIO.

for
**THE BELLEFONTAINE DEVELOPMENT CO.
 BELLEFONTAINE OHIO.**

SCALE 1" = 100' DECEMBER 1949

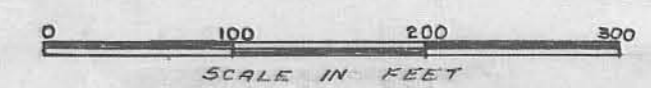

CLAIR A. INSKEEP CIVIL ENGINEER