

# ANCHOR LODGE CONDOMINIUM

PART OF LOT No. 11


SHAWNEE ISLAND

STOKES TOWNSHIP

LOGAN COUNTY, OHIO

1981


SCALE: 1" = 20'

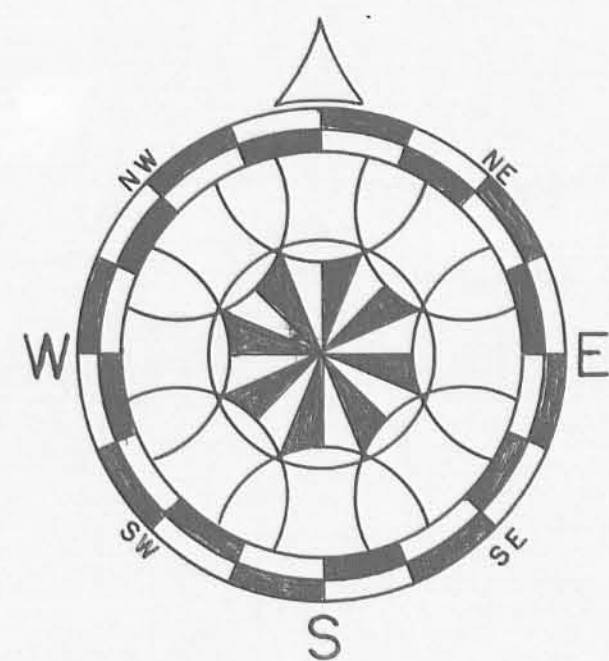

NOTE:  
AREA NOT PART OF LOT No. 11. PART OF VACATED PARK.  
NO APPARENT TITLE FOUND.



NOTE:  
ALL AREAS AND FACILITIES NOT DESIGNATED AS  
LIVING AREAS ARE DESIGNATED AS COMMON AREAS.

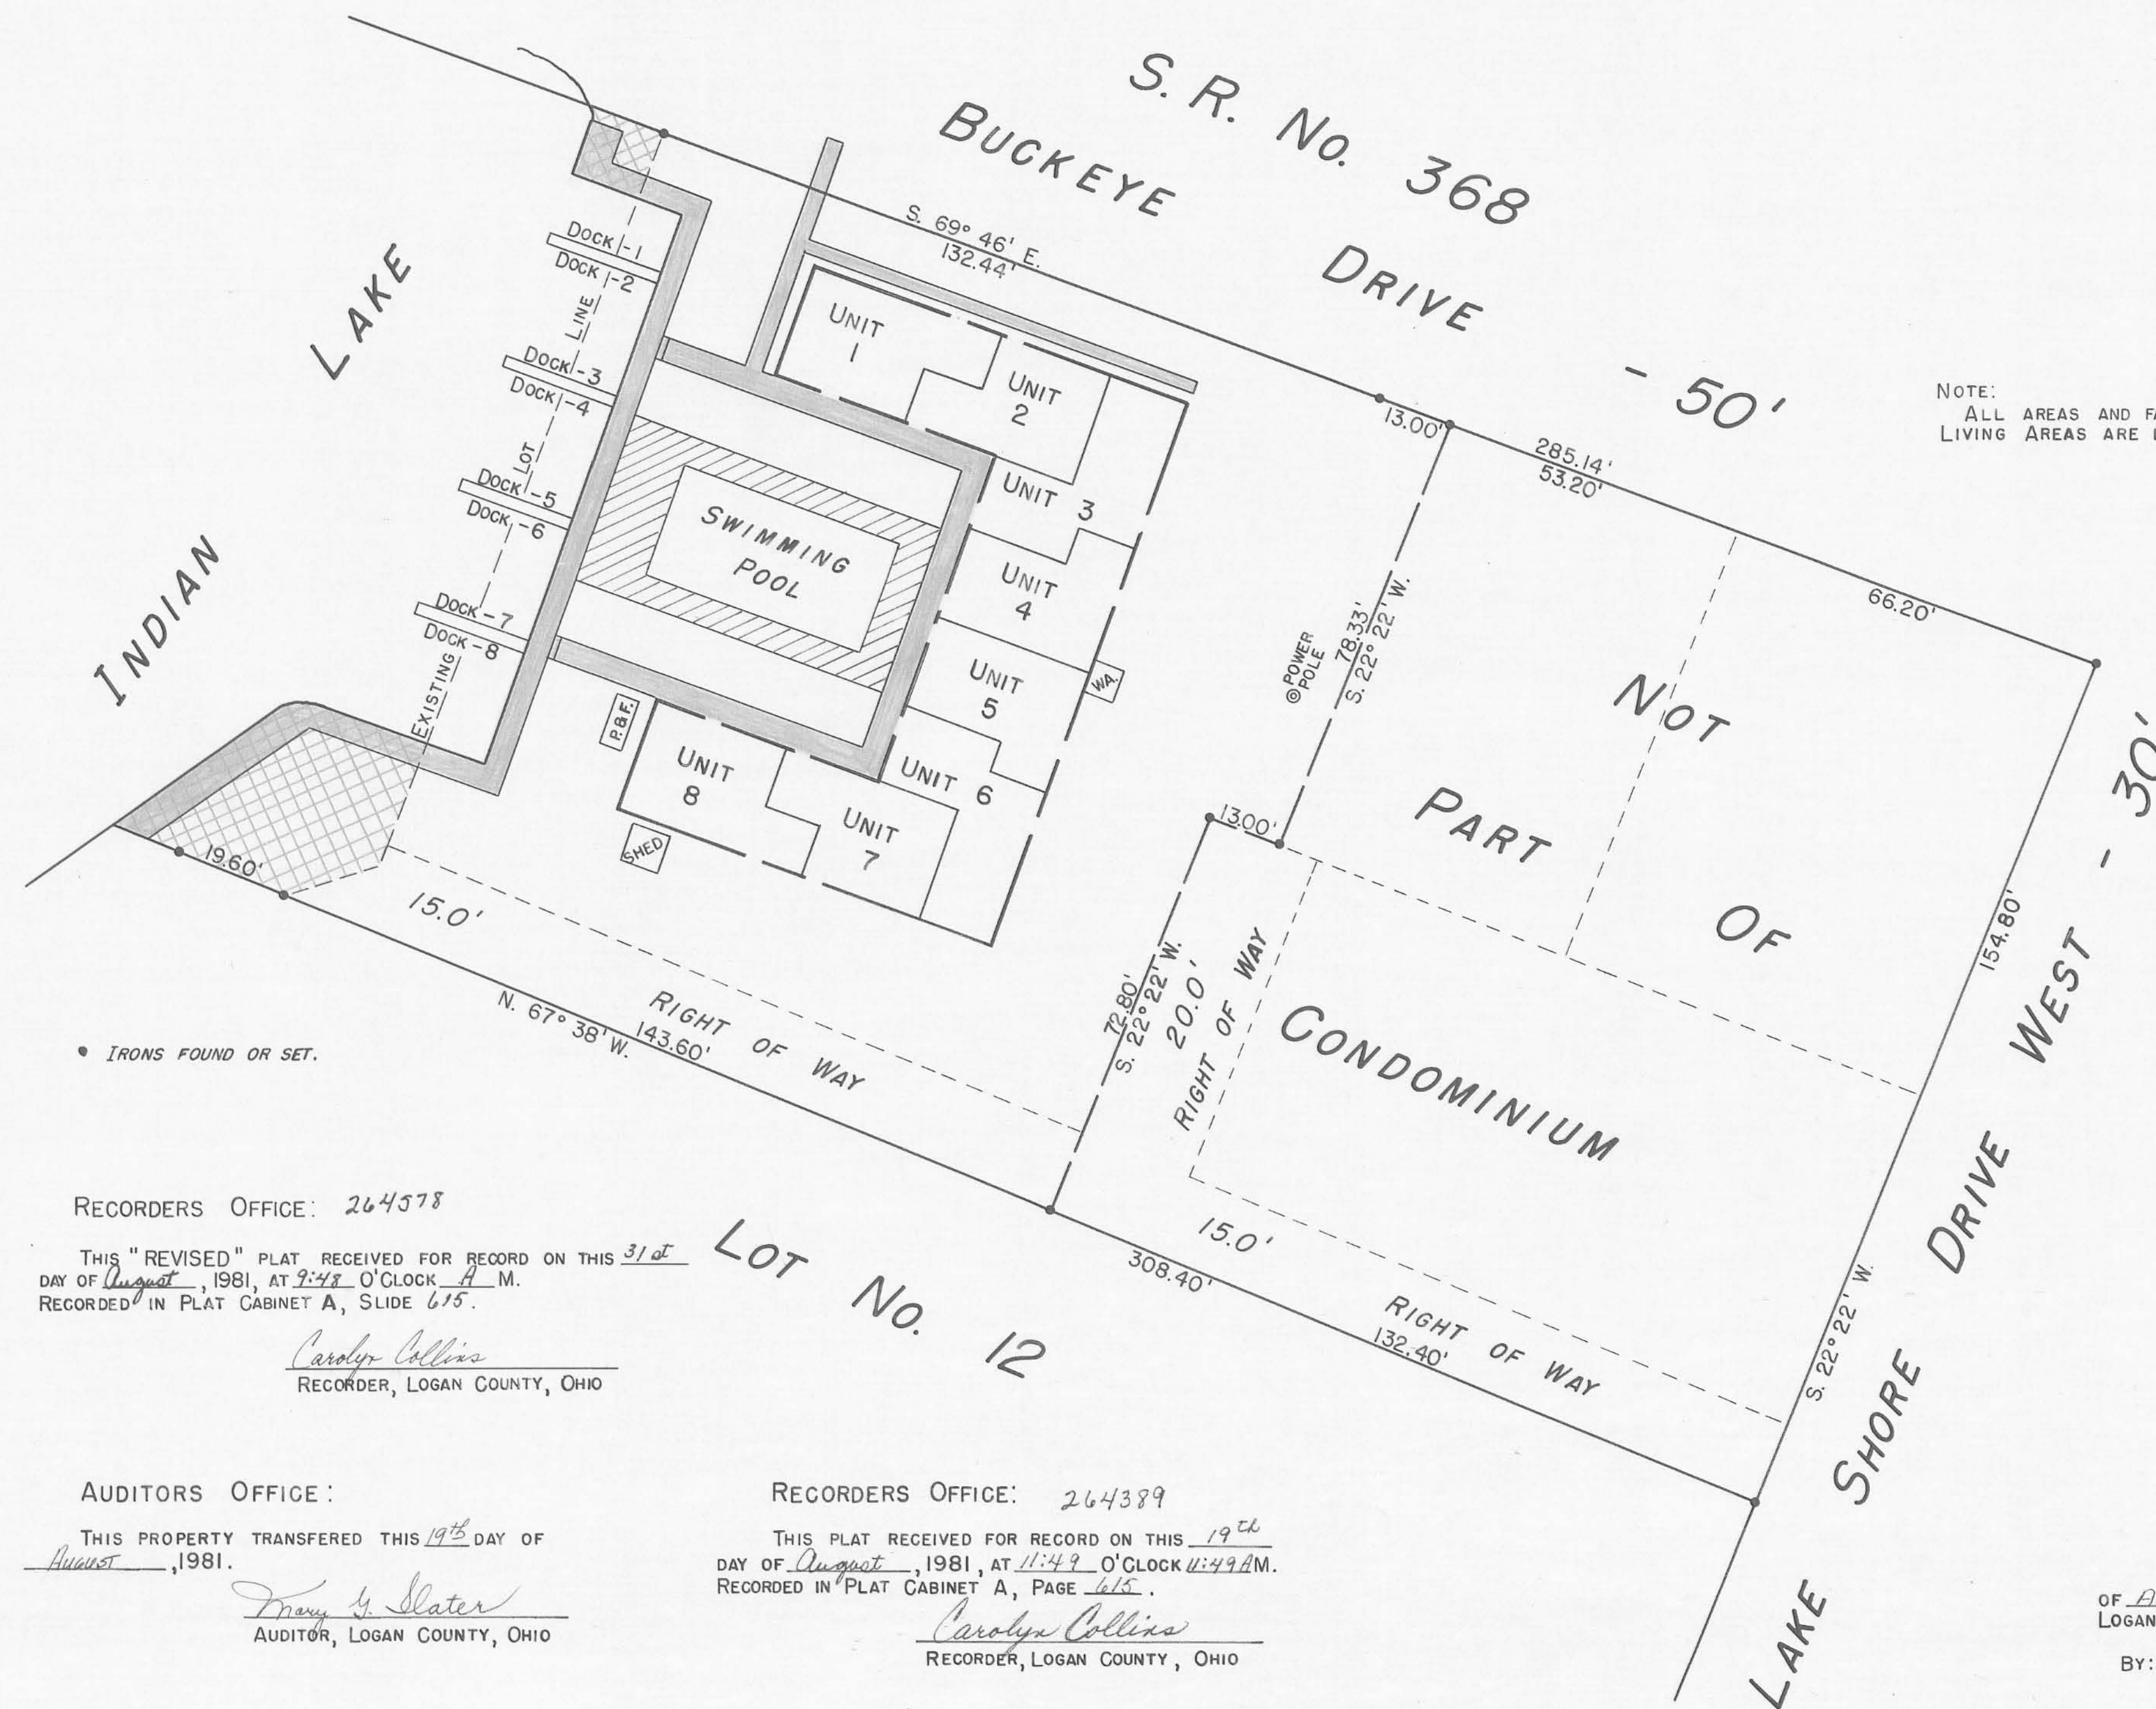

I HEREBY CERTIFY THAT THIS DRAWING WAS REVISED  
TO SHOW APPARENT VACATED PARK ON AUGUST 31, 1981.

*Daniel E. Gilbert*  
DANIEL E. GILBERT, P.S.  
REG. SUR. NO. 5402

I HEREBY CERTIFY THAT THIS DRAWING ACCURATELY  
REPRESENTS THE BUILDING AND OTHER IMPROVEMENTS  
ON WHAT IS TO BE KNOWN AS "ANCHOR LODGE"  
CONDOMINIUM.

*Daniel E. Gilbert*  
DANIEL E. GILBERT, P.S.  
REG. SUR. NO. 5402  
BELLEFONTAINE, OHIO

I HEREBY CERTIFY THAT THIS DRAWING ACCURATELY  
REPRESENTS THE BUILDING AND OTHER IMPROVEMENTS  
ON WHAT IS TO BE KNOWN AS "ANCHOR LODGE"  
CONDOMINIUM.



*Glendale H. Zell*  
GLENDALE H. ZELL  
REG. ARCH. NO. 3849  
BELLEFONTAINE, OHIO

RECORDERS OFFICE: 264578

THIS "REVISED" PLAT RECEIVED FOR RECORD ON THIS 31<sup>st</sup>  
DAY OF August, 1981, AT 9:49 O'CLOCK A.M.  
RECORDED IN PLAT CABINET A, SLIDE 675.

*Carolyn Collins*  
RECORDER, LOGAN COUNTY, OHIO

AUDITORS OFFICE:

THIS PROPERTY TRANSFERRED THIS 19<sup>th</sup> DAY OF  
August, 1981.

*Mary G. Slater*  
AUDITOR, LOGAN COUNTY, OHIO

RECORDERS OFFICE: 264389

THIS PLAT RECEIVED FOR RECORD ON THIS 19<sup>th</sup>  
DAY OF August, 1981, AT 11:49 O'CLOCK 11:49 A.M.  
RECORDED IN PLAT CABINET A, PAGE 675.

*Carolyn Collins*  
RECORDER, LOGAN COUNTY, OHIO

THIS PLAT CHECKED THIS 19<sup>th</sup> DAY  
OF August, 1981.  
LOGAN COUNTY ENGINEERS OFFICE.  
BY: *Daniel E. Gilbert, T.M.D.*