

LOCATION PLAN



STATE ROUTE 274

LOGAN COUNTY

M^cARTHUR & RUSHCREEK TWP.

FED. RD. DIVISION	STATE	PROJECT	1 1
2	OHIO	1958	


LOGAN COUNTY
LOG. 274-(14.92-16.9) Structures

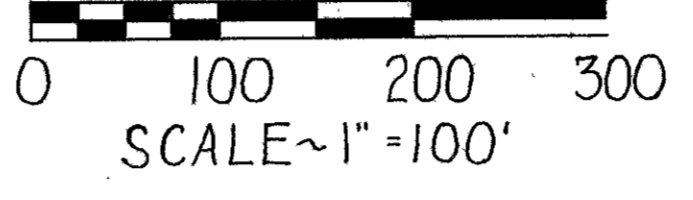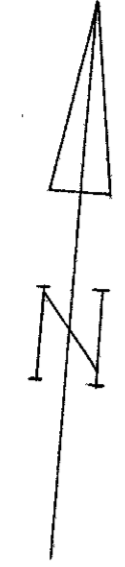

⊕ REFERENCE POINT MONUMENTS TO BE SET AFTER CONSTRUCTION

STATION	DISTANCE FROM		STATION	DISTANCE FROM	
	LT.	RT.		LT.	RT.
781+52		EXIST. MON.	863+50	30	30
785+52		"	866+00	50	50
788+80	60	55	870+15	30	30
794+06	30	30	875+00	25	25
PI. 799+00	SEE DETAIL 'B'				
PI. 803+00		"	880+60	30	30
807+51.3		EXIST. MON.	885+00	30	30
810+65	30	30	892+00	30	30
815+10	30	30	893+50	55	45
820+00	25	25	898+90	30	30
858+00	25	25			

TYPICAL DETAIL FOR SETTING & LOCATION MONUMENTS

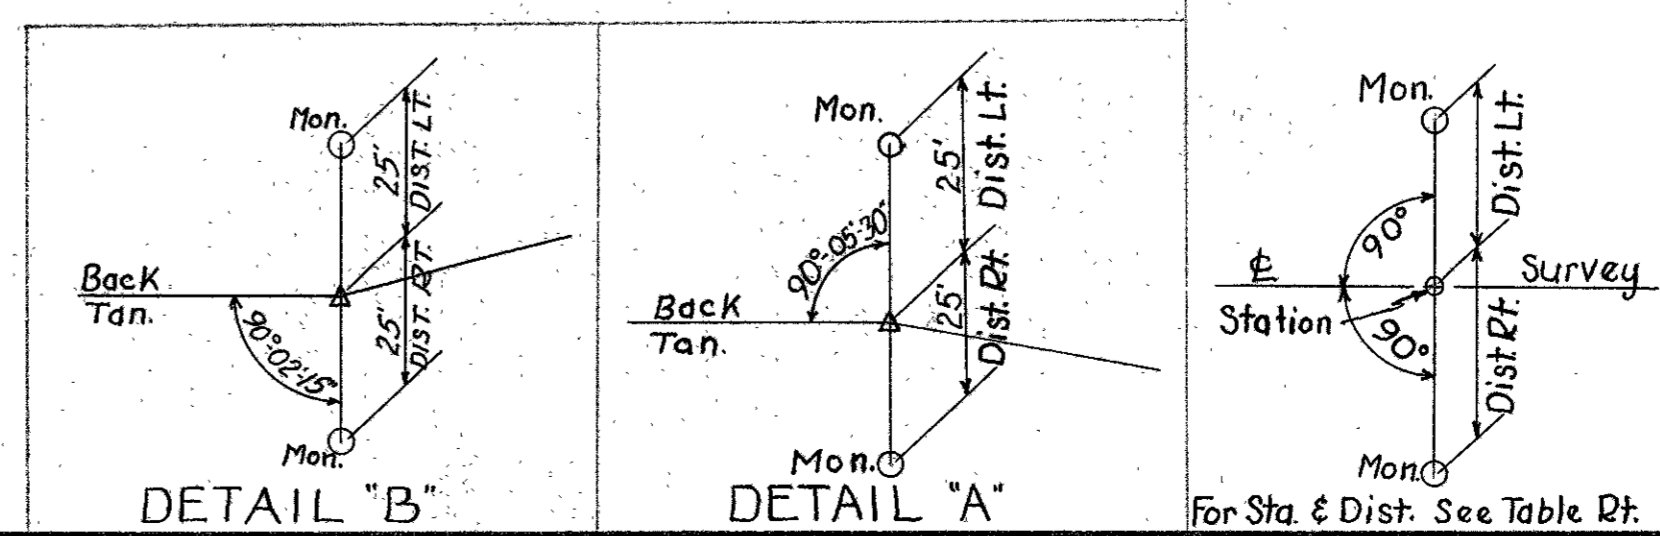

COMPLETED SETTING OF MONUMENTS BY: W. DOWNEY

RECORDED DATE: 5-6 1958
VOL. 1
PAGE 15

APPROVED: *For. M. Bowen*
DATE: 29 April 1958
RIGHT-OF-WAY ENGINEER - DIV. N^o 7
REGISTERED SURVEYOR N^o 3128

M^CARTHUR TWP.

V.M.S. 9931


FED. RD. DIVISION	STATE	PROJECT
2	OHIO	1957

51
55

J. DONOVAN CARSON &
ETHEL M. CARSON (H & W)

KLETTO M^CCORMICK

LOGAN COUNTY
LOG. 274~(14.92-16.91) Structures
R/W PLAN

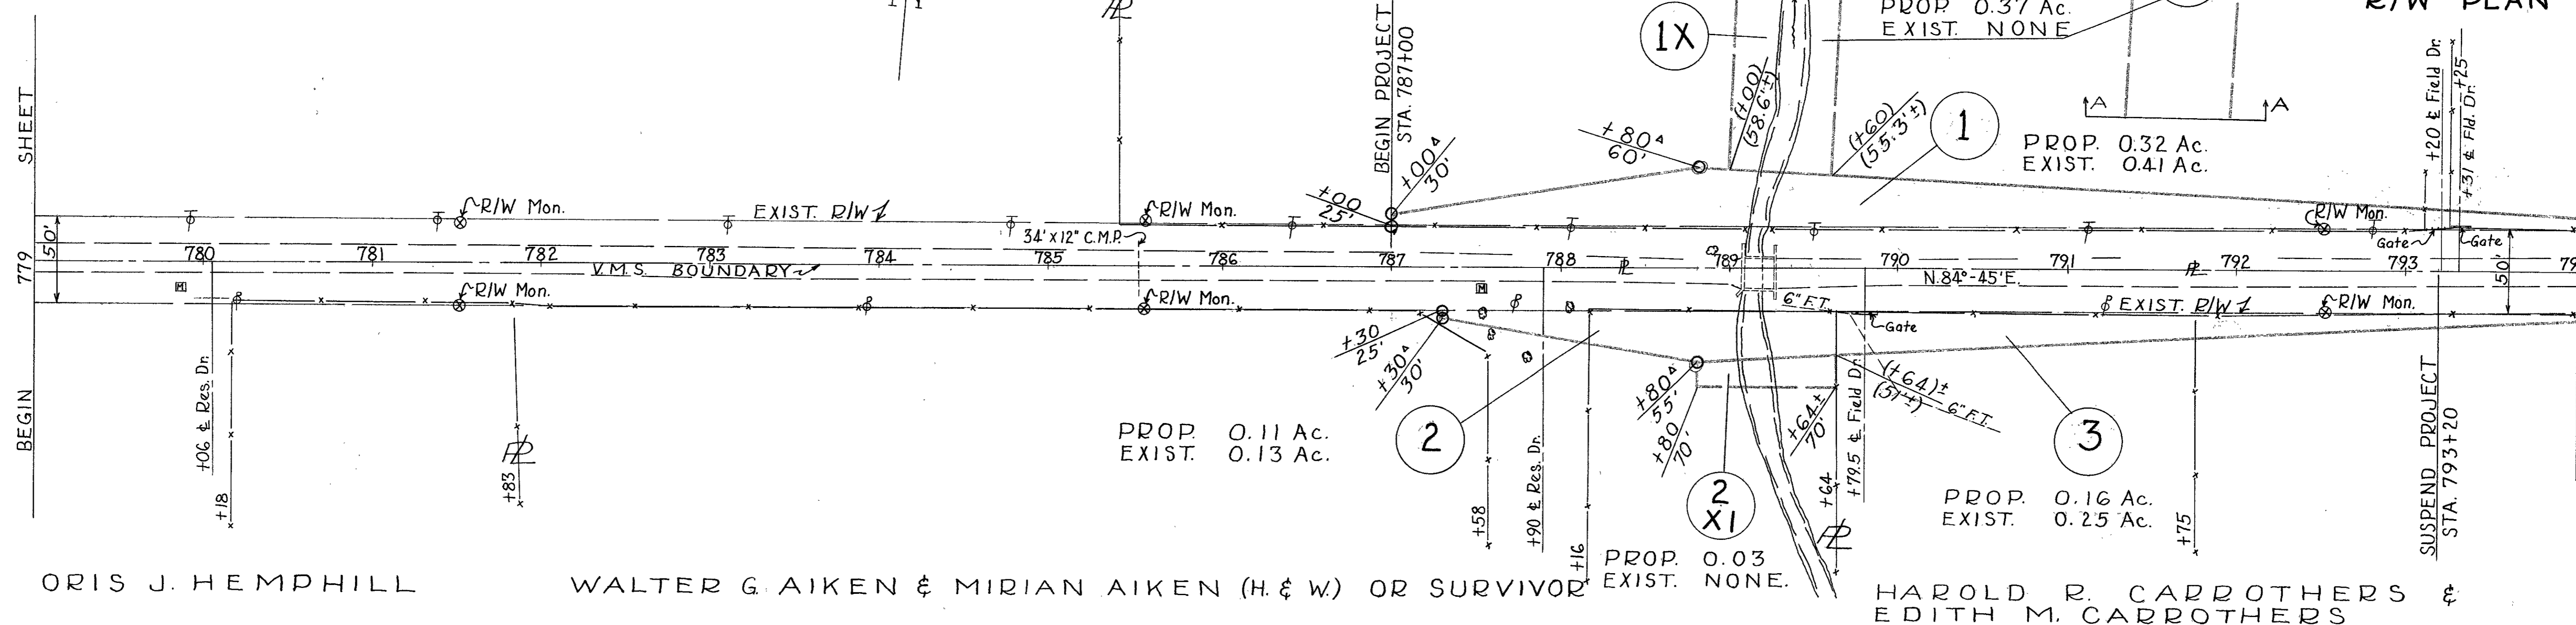

ORIS J. HEMPHILL

WALTER G. AIKEN & MIRIAN AIKEN (H. & W) OR SURVIVOR

HAROLD R. CARROTHERS &
EDITH M. CARROTHERS

○ INDICATES MONUMENTS SET 9 MAY, 1958

M^CARTHUR TWP.

V.M.S. 14033


V.M.S. 9931

M^CARTHUR TWP.

INDEX OF PARCELS 1957

NOTE: EXIST. R/W AREAS
INCLUDE ONLY THAT
PART OF THE EXIST
R/W ADJACENT TO
PERMANENT
TAKING AREAS.

KLETTO M^CCORMICK

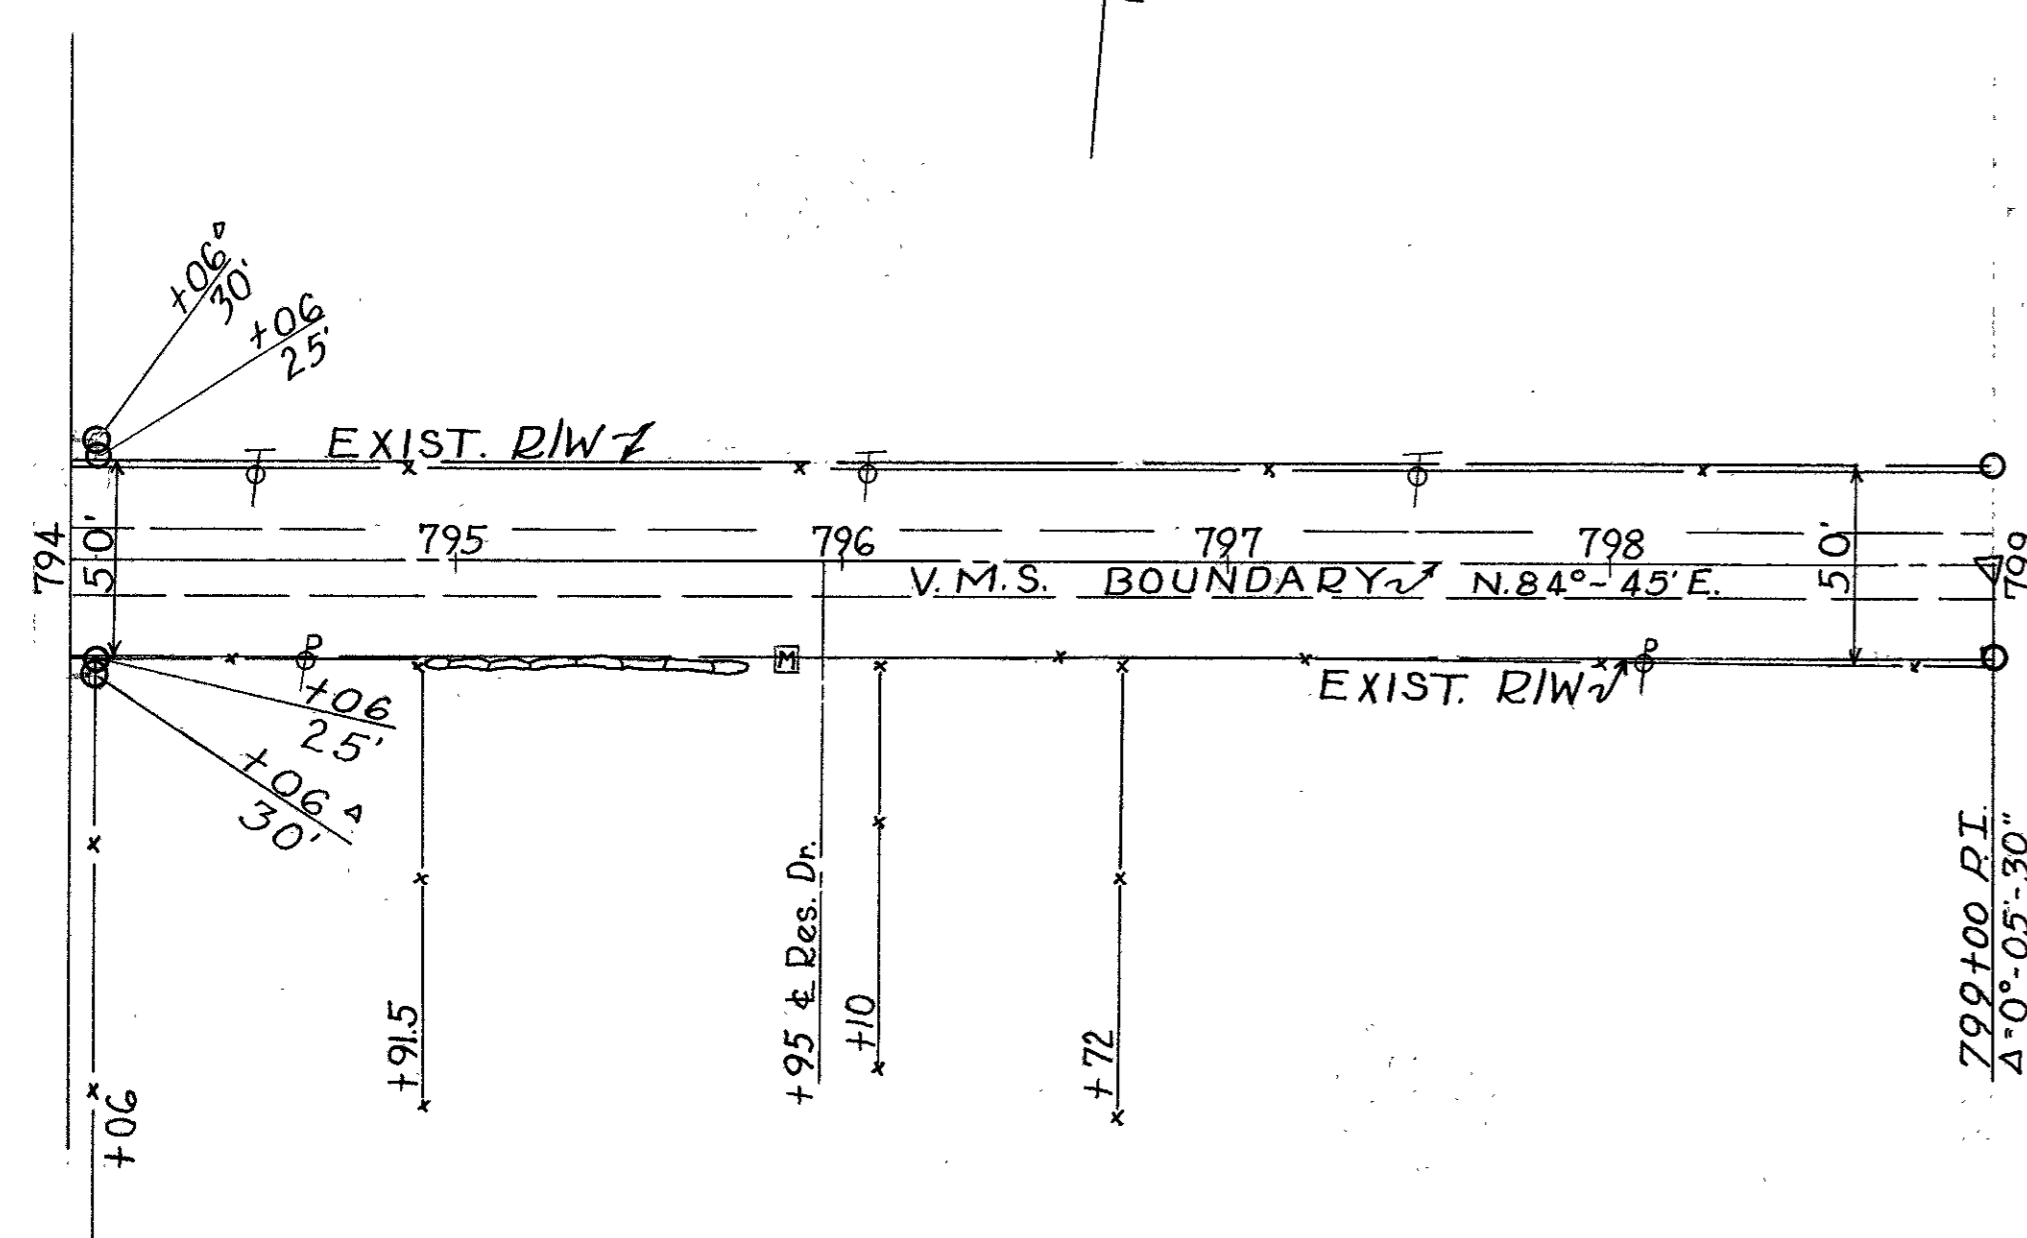

HAROLD R. CARROTHERS &
EDITH M. CARROTHERS

M^CARTHUR TWP.

V.M.S. 14033

PAR. NO	OWNER	AREA ACRES	EXISTING STRUCTURES	SHEET N ^o S	REMARKS	RECORDING DATA VOL. PG. DATE
1	KLETTO M ^C CORMICK	0.32		1		251 508-12 6-27-58
1X	"	0.37		1		
2	WALTER G. AIKEN, ET AL.	0.11		1		252 435-39 8-1-58
2A	"	0.10		2		252 440-44 8-1-58
2X1	"	0.03		1		
2X2	"	0.11		2		
3	HAROLD R. CARROTHERS, ET AL.	0.16		1		251 513-517 6-27-58
4	ROBERT W. GEORGE	0.09		2		251 518-522 6-27-58
4X	"	0.29		2		
5	PAUL A. SNYDER, ET AL.	0.18		2		251 523-527 6-27-58
5X	"	0.02		2		
6	JOHN L. KEMP, ET AL.	0.36		4		251 528-533 6-27-58
6A	"	0.10		4		
6X1	"	0.23		4		
6X2	"	0.21		4		
7	ORVILLE C. LINEBAUGH, ET AL.	0.19		4		251 534-38 6-27-58
7X	"	0.03		4		
8	SHERMAN W. LUSBY	0.10		4		251 539-544 6-27-58
8A	"	0.40		5		
8X1	"	0.03		4		
8X2	"	0.23		5		
9	PAUL W. SPONSELLER	0.08		4		251 545-550 6-27-58
9A	"	0.40		5		
9X1	"	0.06		4		
9X2	"	0.04		5		

REVISED: 3-18-58
DRAWN: 3-15-58
SCALE ~ 1" = 50'

M'ARTHUR TWP
V.M.S. 9931

V.M.S. 9932


KLETTO McCORMICK

ROBERT W. GEORGE.

FED. RD. DIVISION	STATE	PROJECT	52 55
2	OHIO	1957	

LOGAN COUNTY
LOG. 274 ~ (14.92-16.91) Structures
R/W PLAN

WALTER C. AIKEN & MIRIAN AIKEN

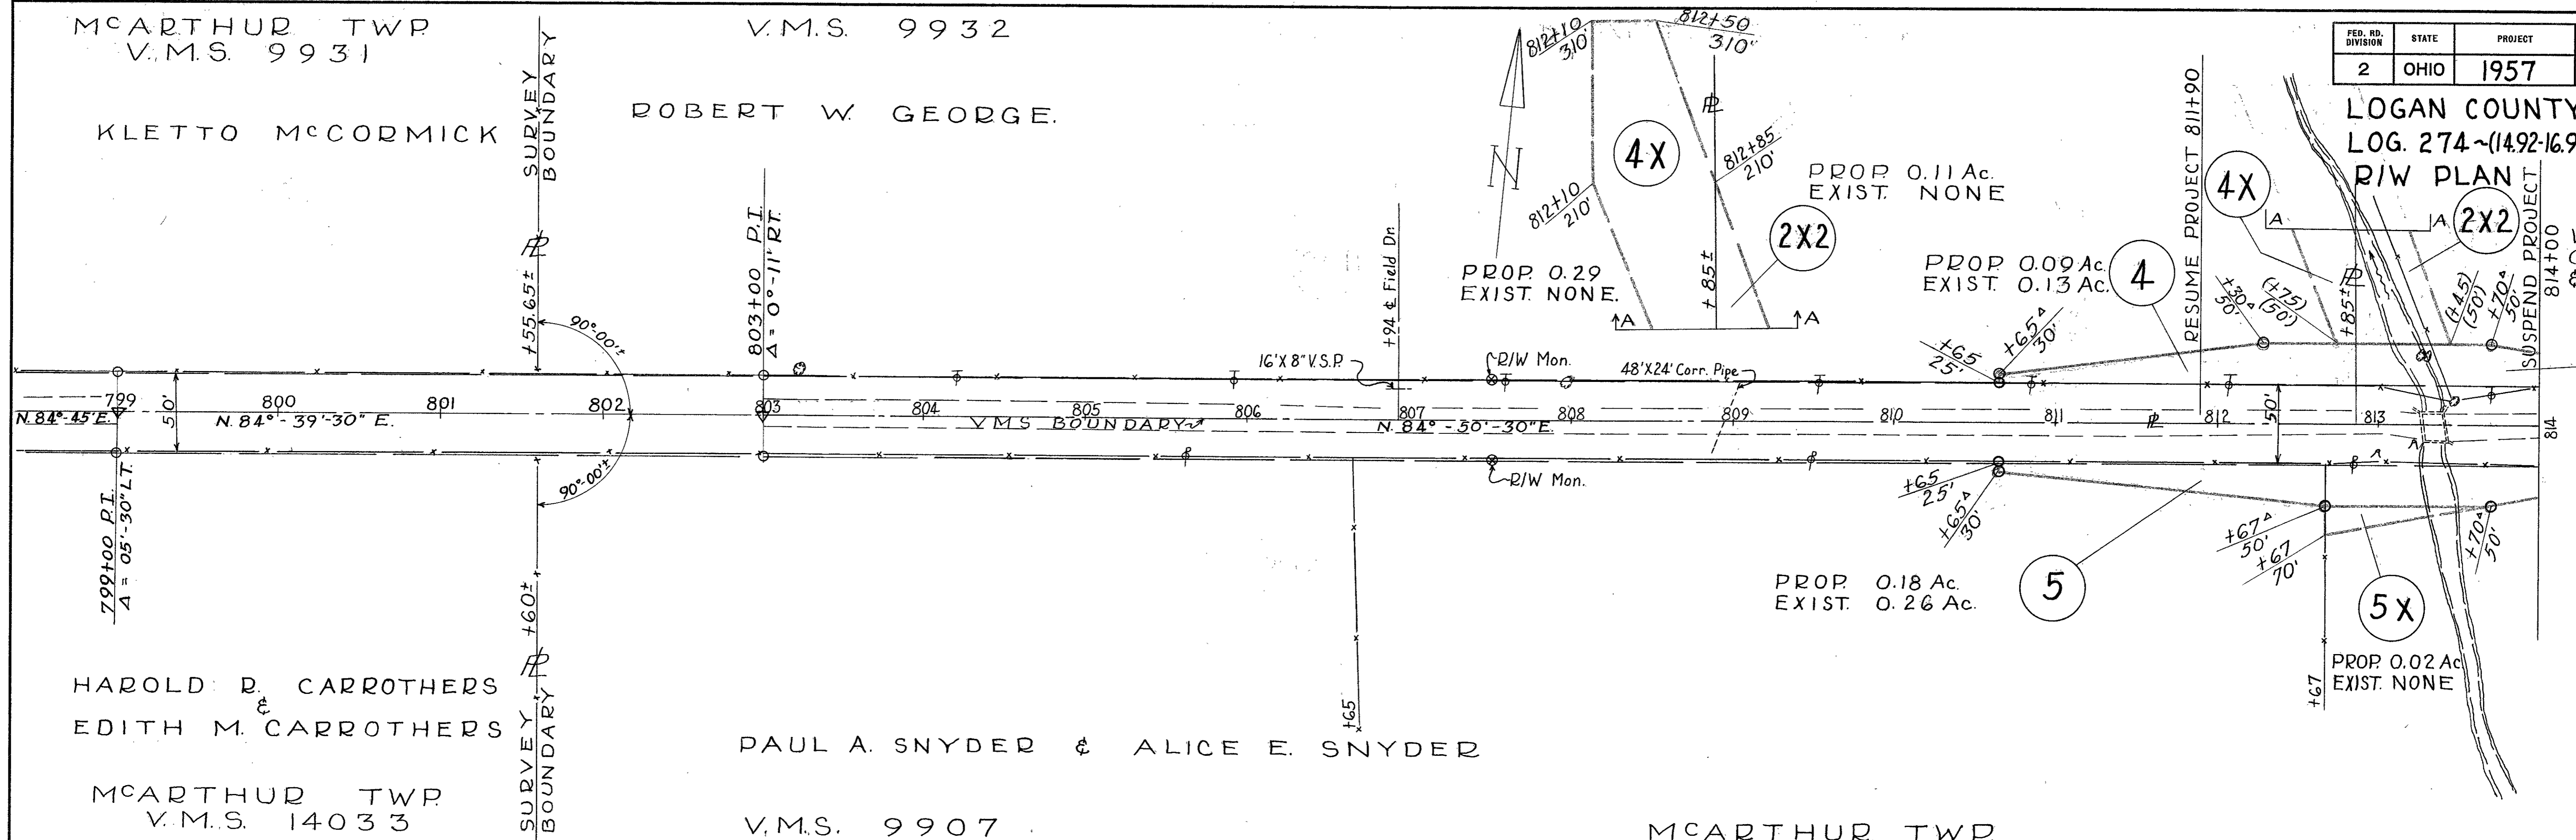

HAROLD D. CARROTHERS
&
EDITH M. CARROTHERS

PAUL A. SNYDER & ALICE E. SNYDER

M'ARTHUR TWP
V.M.S. 14033

V.M.S. 9907


M'ARTHUR TWP

M'ARTHUR TWP

V.M.S. 9932

WALTER G. AIKEN & MIRIAN AIKEN

FOR R/W OF S.D. 638 SEE
R/W PLAN ~ LOG. 638-0.00 TO
1.61, S.H. 895 SEC. A (PT)

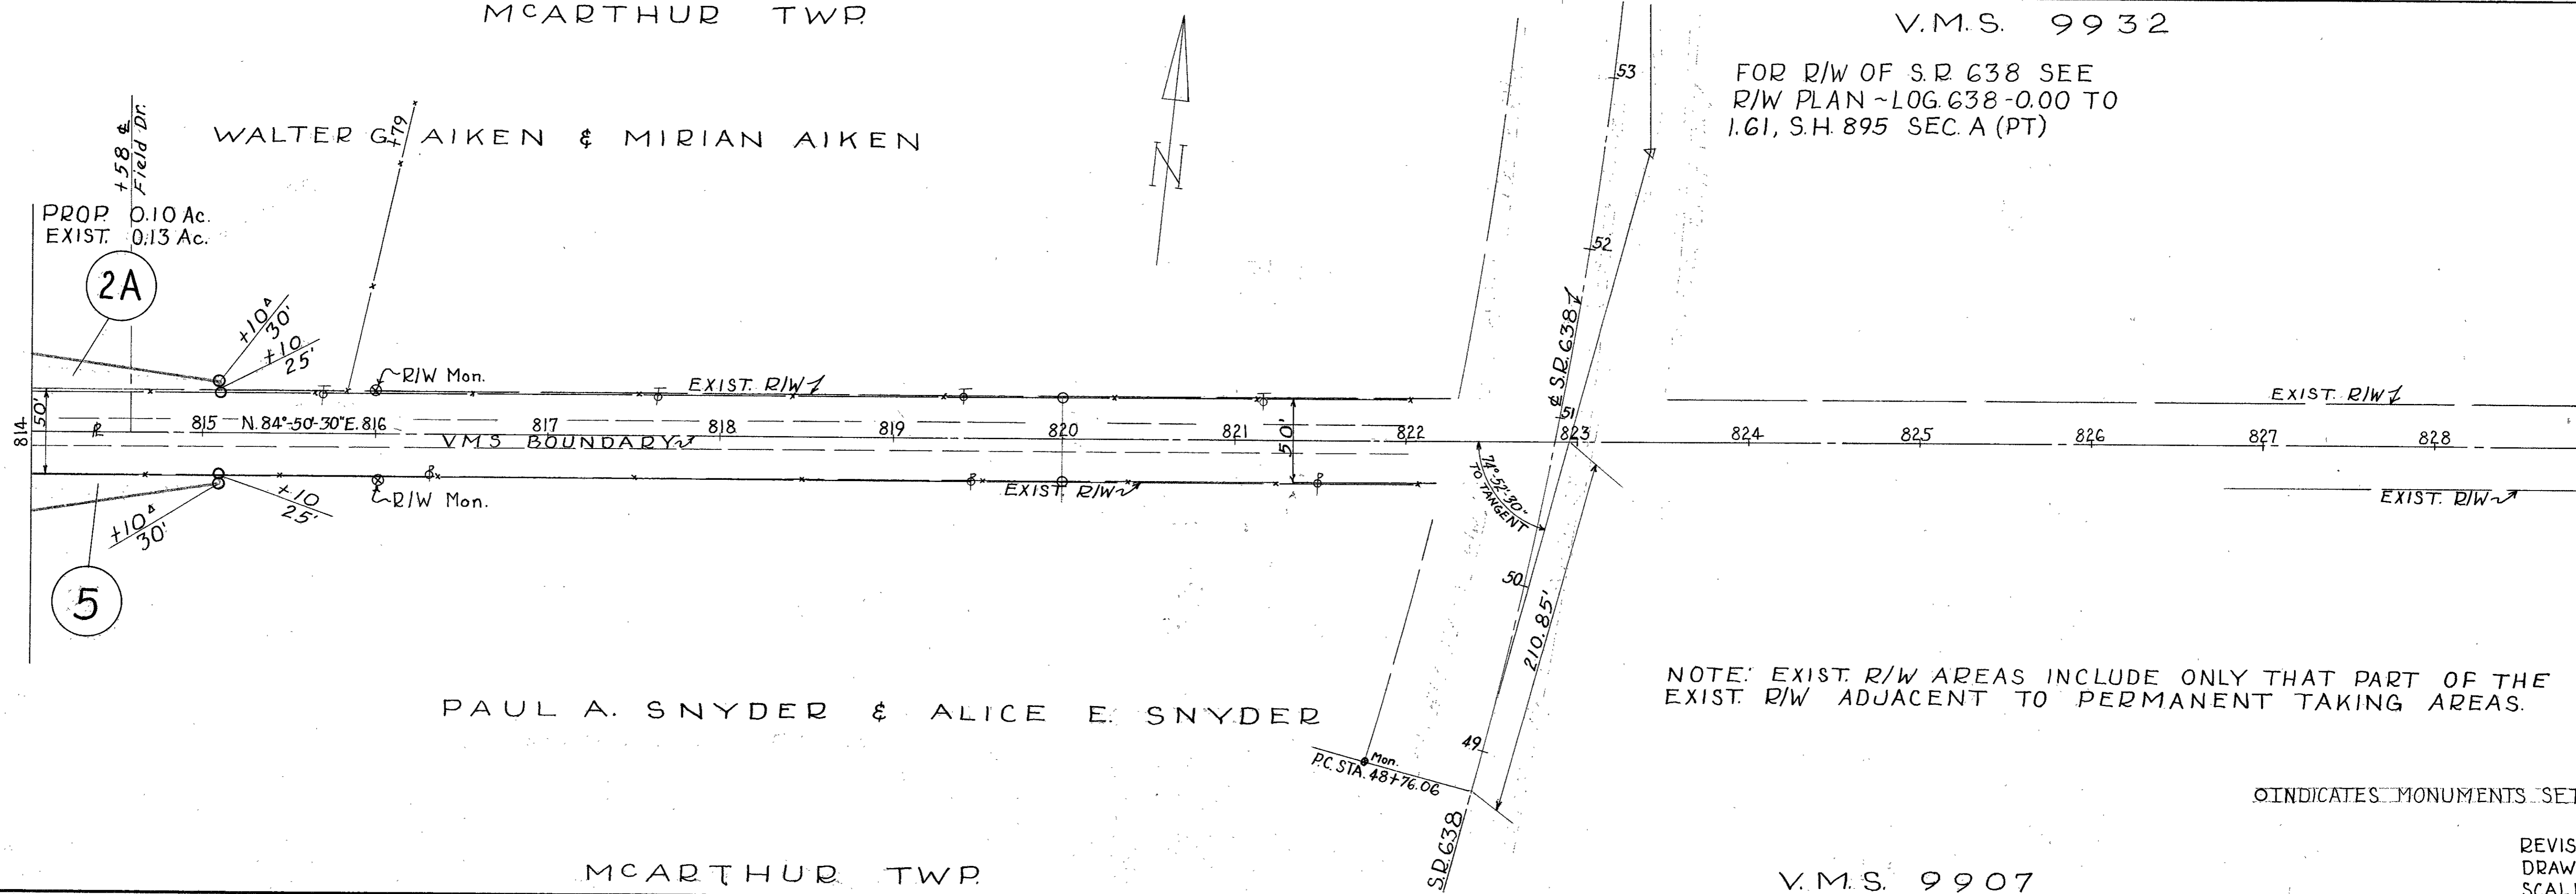

PAUL A. SNYDER & ALICE E. SNYDER

NOTE: EXIST. R/W AREAS INCLUDE ONLY THAT PART OF THE
EXIST. R/W ADJACENT TO PERMANENT TAKING AREAS.

O INDICATES MONUMENTS SET 9 MAY, 1958

M'ARTHUR TWP

V.M.S. 9907

REVISED: 4-23-58
DRAWN: 3-15-58
SCALE ~ 1" = 50'

V.M.S. 9932

MCARTHUR TWP

RUSHCREEK TWP
V.M.S. 9932

FED. RD. DIVISION	STATE	PROJECT	53 55
2	OHIO	1957	

LOGAN COUNTY
LOG. 274 ~ (14.92-16.9) Structures
R/W PLAN

SHEET

829

BEGIN

50'

830

831

50'

844

EXIST. R/W ↙

EXIST. R/W ↗

APPROX. & U.S.P. 68 ↙

APPROX. TWP LINE ↗

V.M.S. 9907

MCARTHUR TWP

RUSHCREEK TWP

V.M.S. 9907

RUSHCREEK TWP

V.M.S. 9932

JOHN L. KEMP & MABEL J. KEMP

844

APPROX. &
CO. RD. 25

845

846

50'

847

EXIST. R/W ↙

848

849

850

851

852

853

854

APPROX. R-1 ↗

855

856

50'

SHEET

857

END

EXIST. R/W ↗

RUSHCREEK TWP

V.M.S. 9907

REVISED
DRAWN: 3-15-58
SCALE ~ 1" = 50'

RUSHCREEK TWP.

V.M.S. 9932

V.M.S. 9933
RUSHCREEK TWP.

FED. RD. DIVISION	STATE	PROJECT
2	OHIO	1957

54
55

LOGAN COUNTY
LOG. 274 ~ (14.92-16.91) Structures
R/W PLAN

JOHN L. KEMP & MABEL J. KEMP

PROP. 0.23 Ac.
EXIST. NONE

+05 SUSPEND
PROJECT

PROP. 0.36 Ac.
EXIST. 0.41 Ac.

6

6X1

6

BEGIN SHEET

EXIST. R/W

V.M.S. BOUNDARY

80'x12" V.S.P.

WILLIAM L.
LINEBAUGH
& MARY F.
LINEBAUGH

PROP. 0.19 Ac.
EXIST. 0.25 Ac.

7

7X

PROP. 0.03
EXIST. NONE

6

JOHN L. KEMP & MABEL J. KEMP

RUSHCREEK TWP.

V.M.S. 9907

V.M.S. 9908 RUSHCREEK TWP.

RUSHCREEK TWP.

JOHN L. KEMP & MABEL J. KEMP

PROP. 0.21 Ac.
EXIST. NONE

V.M.S. 9933

PAUL W. SPONSELLER & ERMA SPONSELLER

PROP. 0.06
EXIST. NONE

PROP. 0.10 Ac.
EXIST. 0.17 Ac.

6A

6X2

9

PROP. 0.08 Ac.
EXIST. 0.14 Ac.

9

+00 SUSPEND
PROJECT

872

EXIST. R/W

V.M.S. BOUNDARY



+23 ± Fld. Dr.

20'x12" C.M.P.

R/W Mon.

+60 ±
25' ±
+50 ±
30'

6A

8X1

PROP. 0.03 Ac.
EXIST. NONE

8

PROP. 0.10 Ac.
EXIST. 0.20 Ac.

END SHEET

NOTE: EXIST. R/W AREAS INCLUDE ONLY
THAT PART OF EXIST. R/W ADJACENT TO PERMANENT R/W TAKING
SHERMAN W. LUSBY INDICATES MONUMENTS SET 9 MAY, 1958

JOHN L. KEMP & MABEL J. KEMP
RUSHCREEK TWP.

V.M.S. 9908

REVISED: 3-18-58
DRAWN: 3-15-58
SCALE ~ 1" = 50'

R/W PLAN S.P. 274 "PART 3 & 4" STA. 857+00 TO STA. 887+00

SHEET 4 OF 5

RUSHCREEK TWP

V.M.S. 9933

FED. RD. DIVISION	STATE	PROJECT	55 55
2	OHIO	1958	

LOGAN COUNTY
LOG. 274~(14921691) Structures
R/W PLAN

PAUL W. SPONSELLER & ERMA SPONSELLER


PROP. 0.40 Ac.
EXIST. 0.40 Ac.

9A

PROP. 0.04 Ac.
EXIST. NONE

9
X2

WILLARD D. ROBY &
MARY C. ROBY

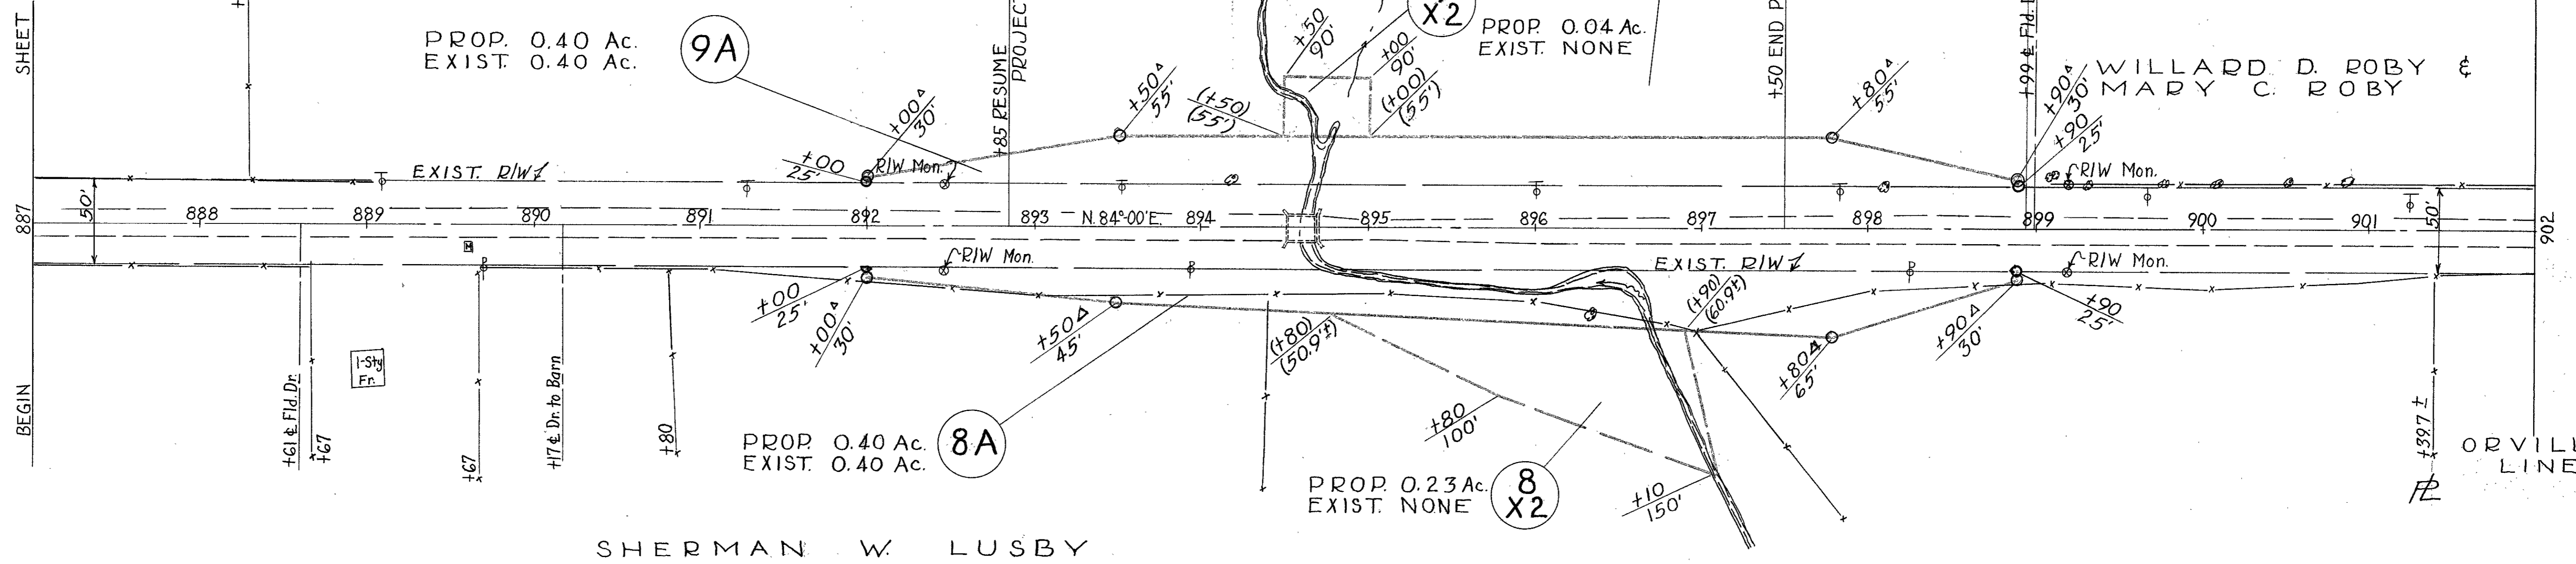

PROP. 0.40 Ac.
EXIST. 0.40 Ac.

8A

PROP. 0.23 Ac.
EXIST. NONE

8
X2

ORVILLE C.
LINEBAUGH

SHERMAN W. LUSBY

INDICATES MONUMENTS SET 9 MAY, 1958

RUSHCREEK TWP

V.M.S. 9908

REVISED
DRAWN: 3-15-58
SCALE ~ 1" = 50'