


Main st.

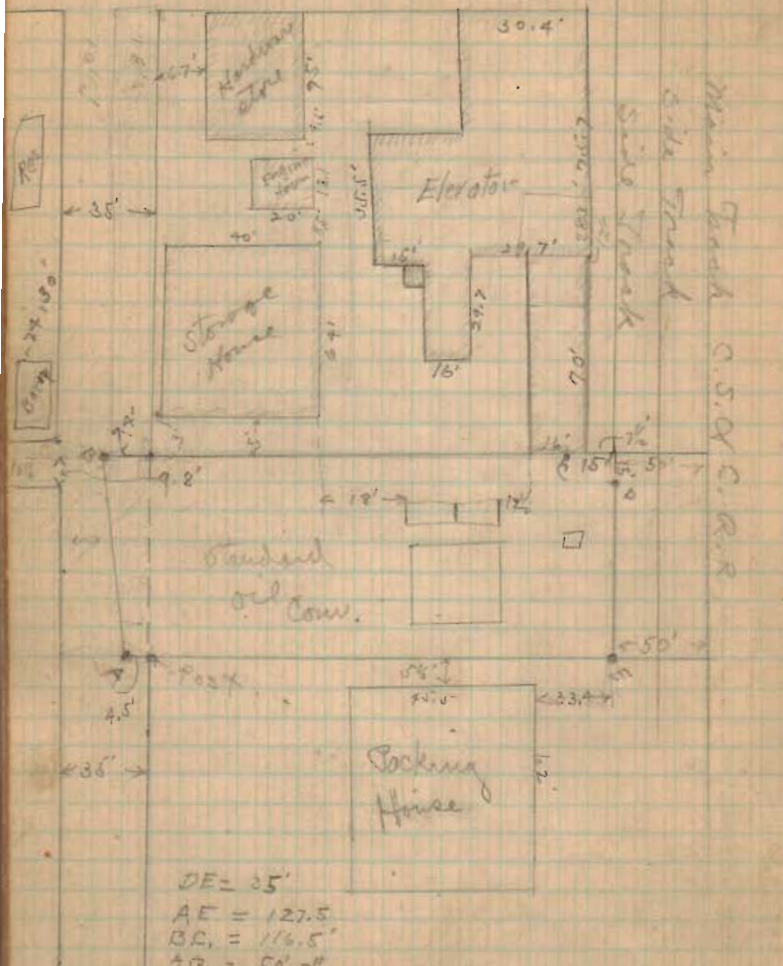

- DE = 35'
- AE = 127.5'
- BE = 116.5'
- AB = 50.2'

Gas pipes at A.D.C. A.E.

11/25/12

