


LYNN STREET 60'

MAIN STREET 70'

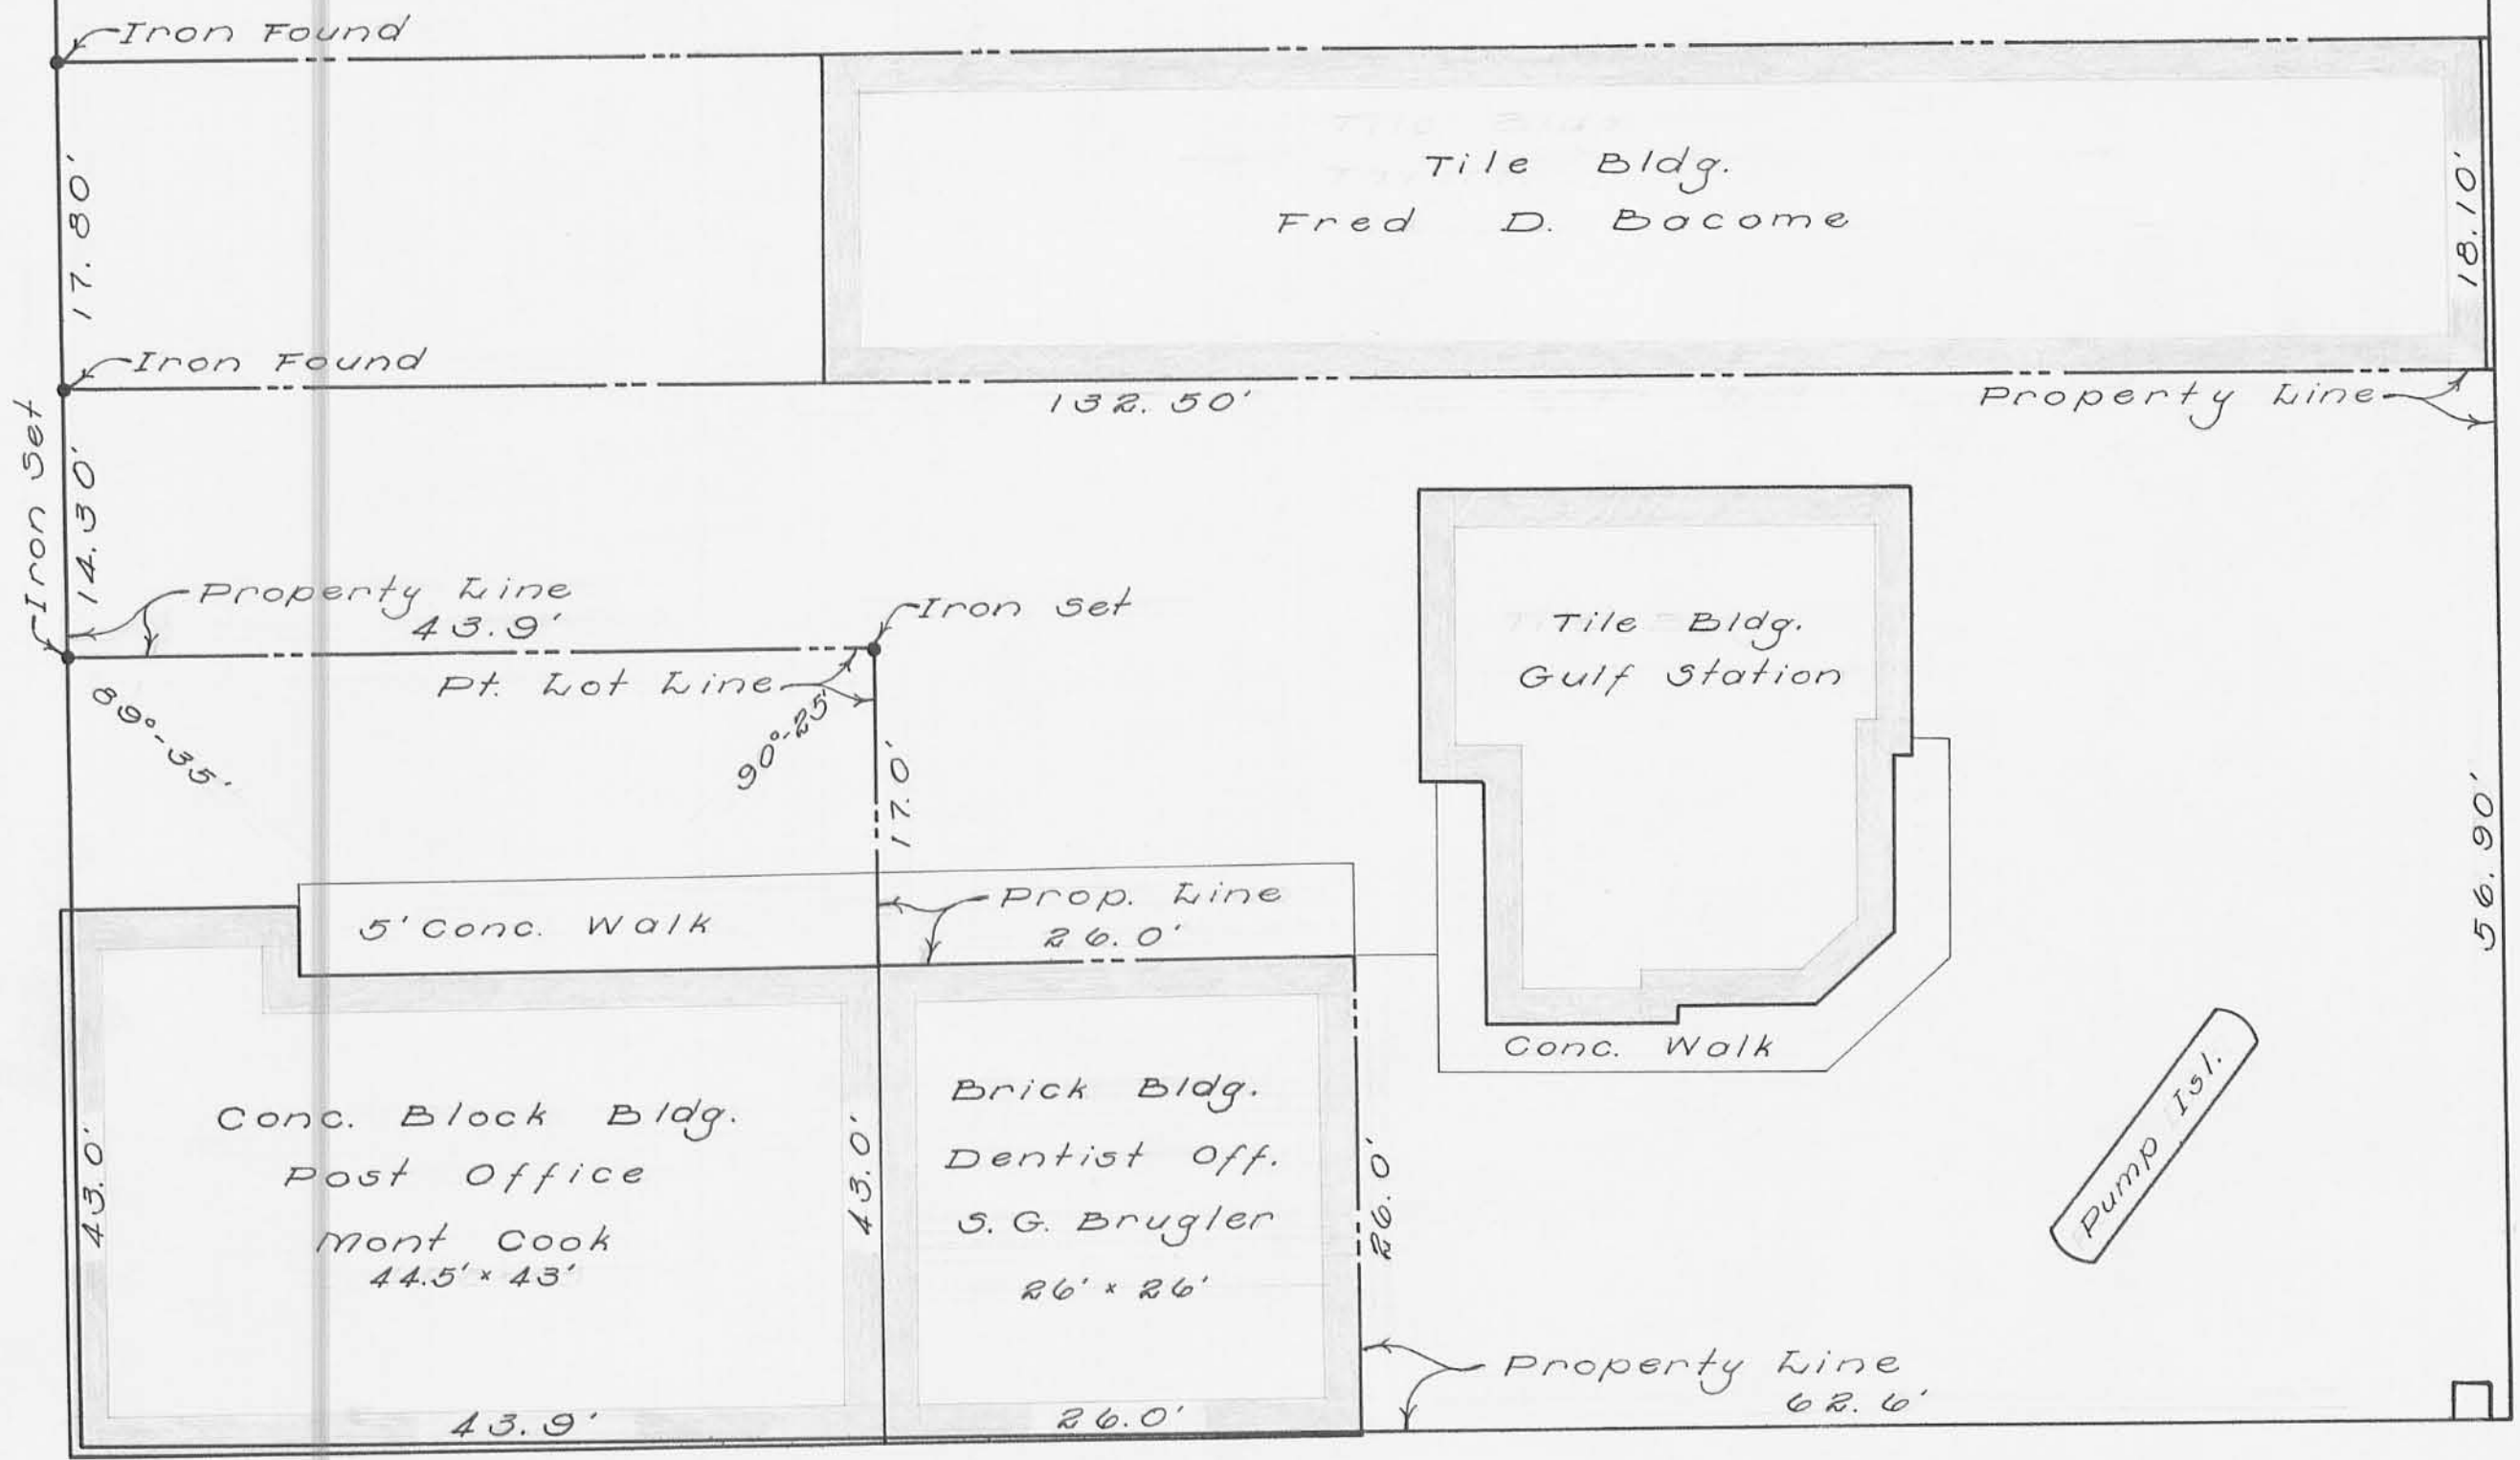

ELIZABETH

STREET 60'

SURVEY OF
 BERTHA KURT PROPERTY
 PART OF LOT No. 3
 BELLE CENTER, OHIO
 FOR
 THE VALVOLINE OIL Co.
 SCALE 1"=10'

Surveyed & Drawn by
 Dan H. Dodson
 Reg. Surveyor No. 4270
 July 25-26, 1956

