


Walnut Street
60' R/W

Asphalt

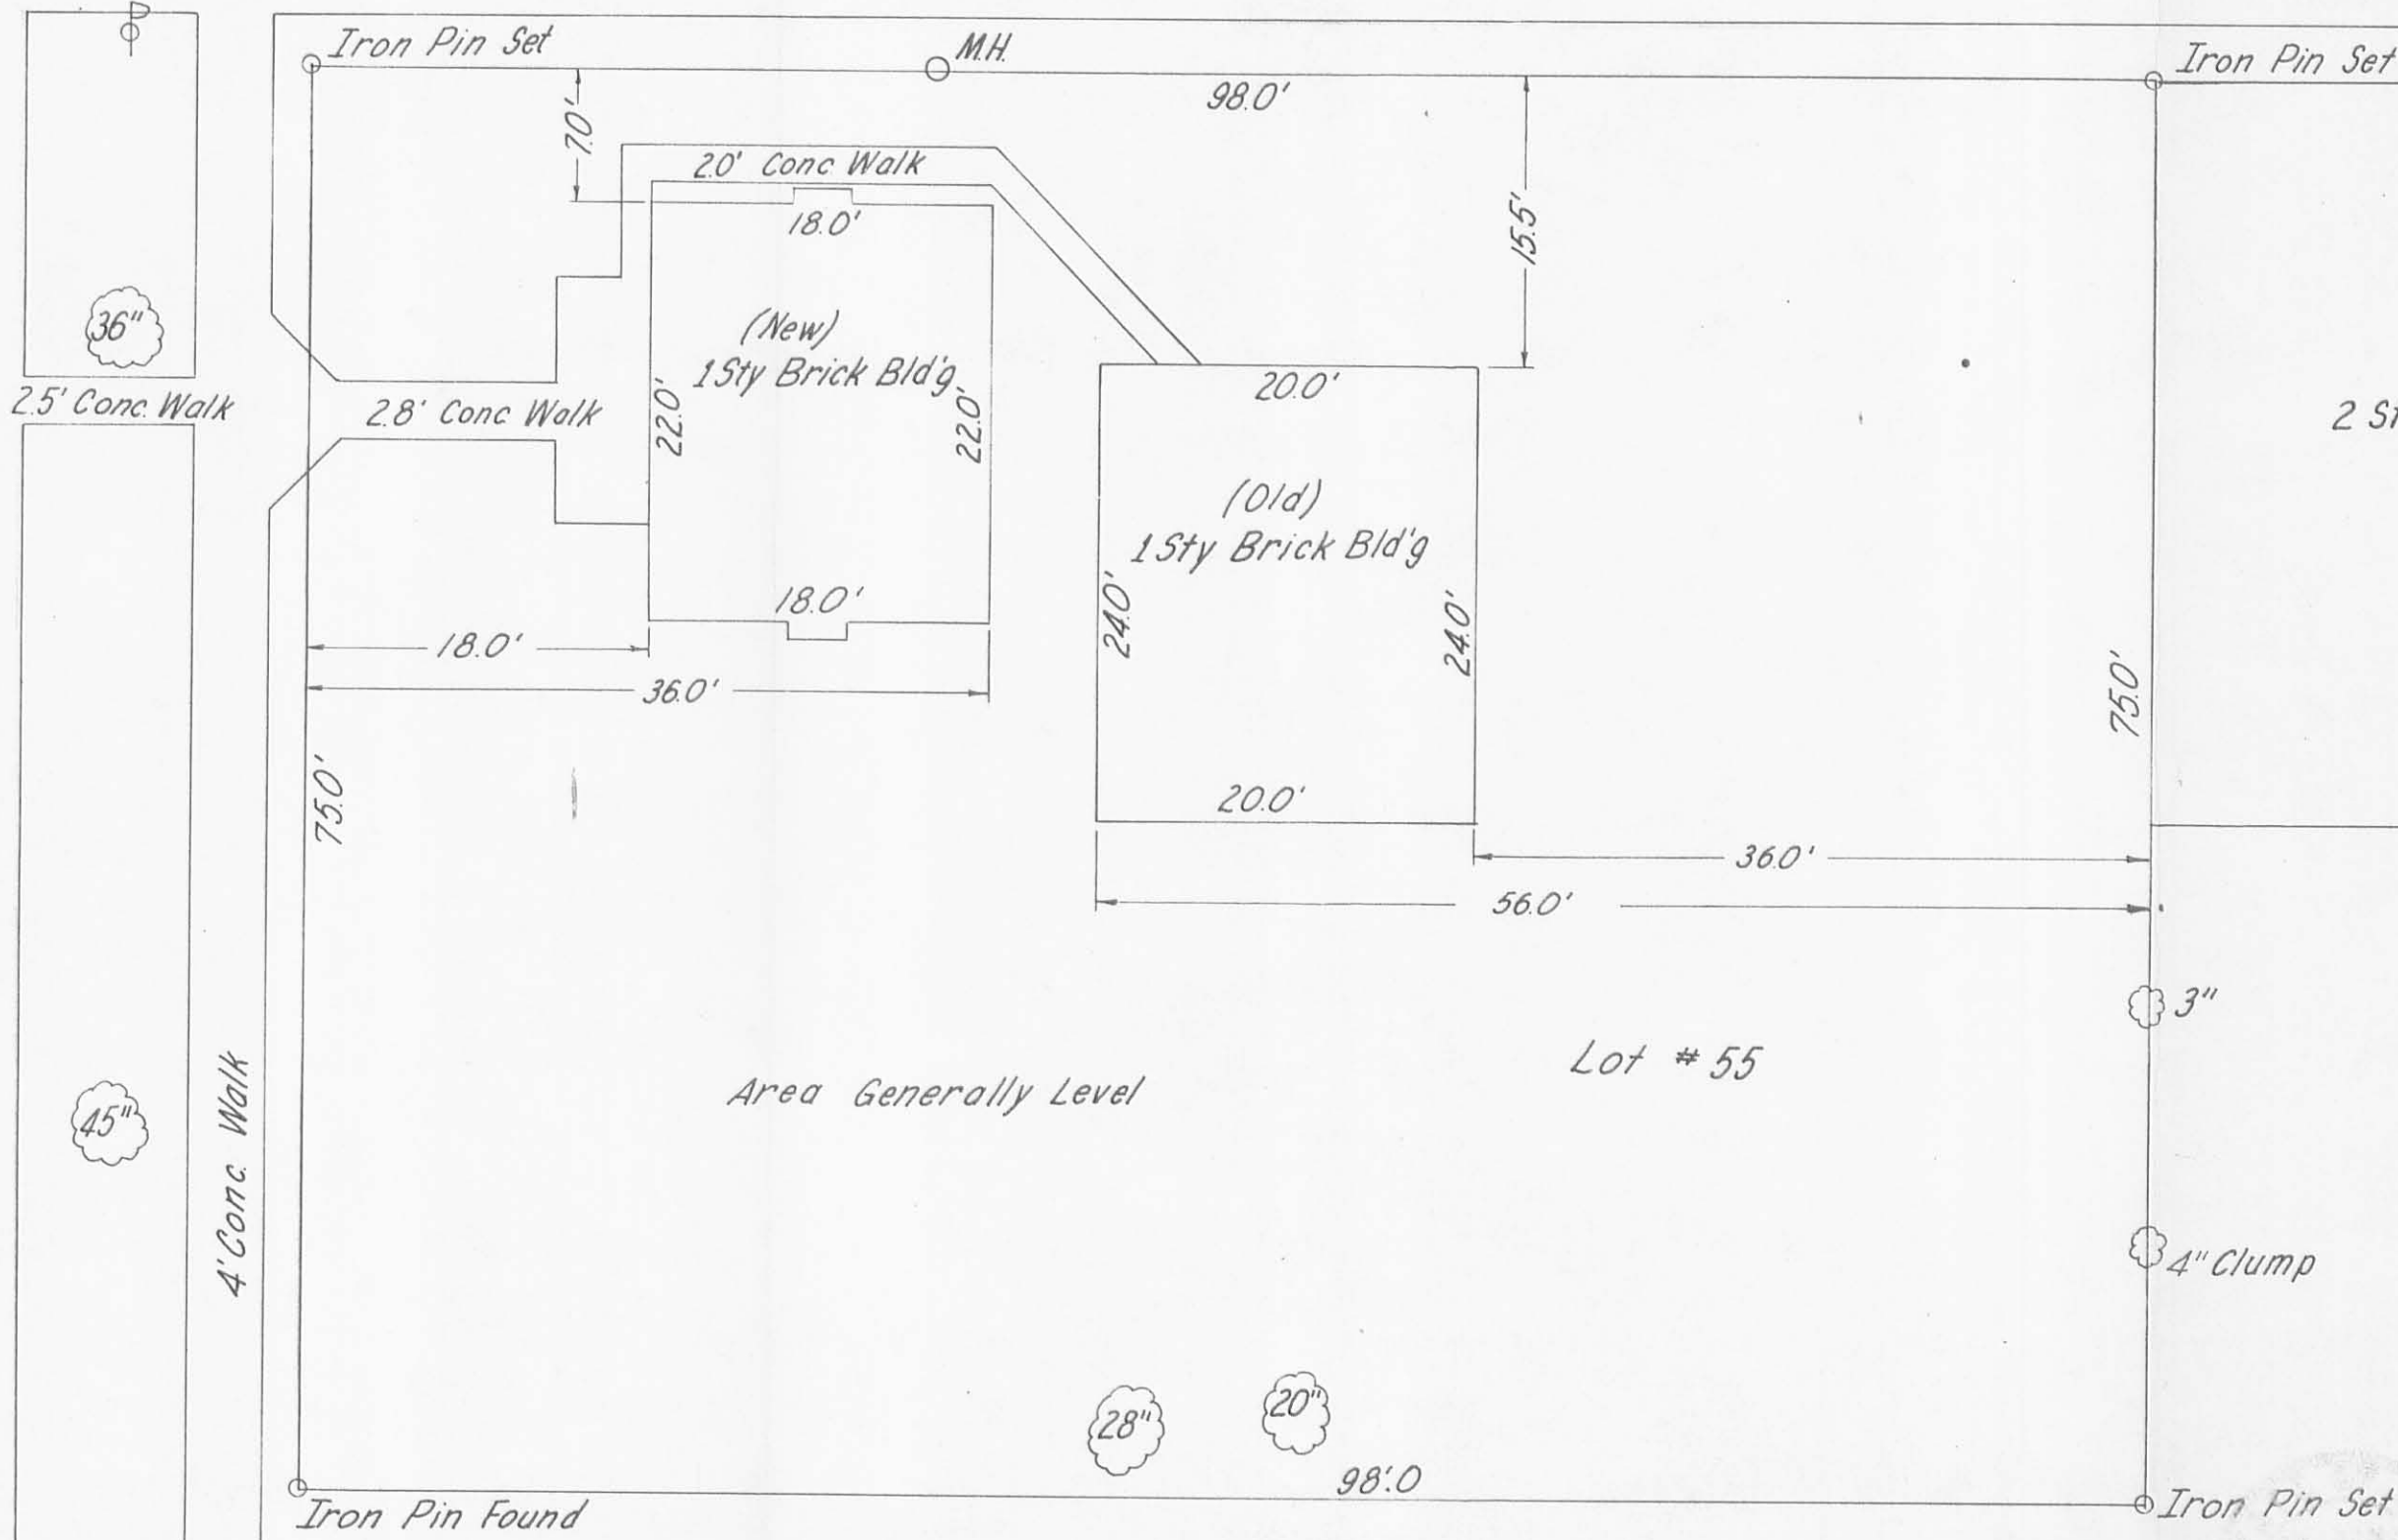

Blacktop Alley
16' R/W

2 Sty Fr. Gar.

BY: C.B. Parrett
C.B. PARRETT
REG. SURVEYOR NO. 2871

SCALE: 1" = 10'

Area Generally Level

Lot # 55

Richland Engineering Limited
CONSULTING ENGINEERS
MANSFIELD, OHIO

SURVEY FOR
**UNITED TELEPHONE COMPANY
OF OHIO**

LOT NO. 55 INDEXED ON MAP

BELLE CENTER, OHIO LOGAN COUNTY

| | | | | | | |
|----------|-------|--------|---------|----------|------|---------|
| DESIGNED | DRAWN | TRACED | CHECKED | REVIEWED | DATE | REVISED |
| | EB | GB | MS | | | |