

Cancro - Jacobs Survey  
Belle Center, Ohio

The following described real estate situated in the Village of Belle Center, Township of Richland, County of Logan, State of Ohio and being a part of Virginia Military Survey No. 9972 and being more particularly described as follows:

Beginning at an iron at the intersection of Charles Street(S. R. No. 638) and Buckeye Street (S. R. No. 273);

Thence with the centerline of Buckeye Street (S. R. No. 273), N. 86° 51' W. 211.60 feet to a P. K. Nail at an angle in said street;

Thence continuing with said centerline, N. 51° 29' W. 35.40 feet to a P. K. Nail for the true place of beginning for this survey, said P. K. Nail being the northwest corner to Robert G. Baker's present 0.50 Acre tract and the northeast corner to Robert Cancro's present 0.56 Acre tract;

Thence continuing with the centerline of Buckeye Street, N. 51° 29' W. 140.80 feet to a P. K. Nail;

Thence S. 5° 42' E. 717.64 feet to a point in the north line of Isabell Templeton Murphy's present 18.00 Acre tract; passing through an iron bar at the south side of Buckeye Street at 41.86 Feet (Being 30.00 feet from the centerline when measured at right angles), passing the Corporation Line of Belle Center at 291.44 feet and an iron bar on line at 365.59 feet and the center of the Red Slough Ditch at 654.64 feet;

Thence with the north line of Murphy's tract, N. 80° 59' E. 106.80 feet to a round wood corner post at the southwest corner to Robert G. Baker's present 2.50 Acre tract and the northeast corner to the Murphy tract, passing through an iron pipe at 6.70 feet;


Thence with the west line of Baker's two tracts, N. 6° 14' W. 613.24 feet to the place of beginning, passing the center of Red Slough Ditch at 136.00 feet, an iron bar at 345.85 feet, an iron pipe in the Corporation Line of Belle Center at 421.00 feet and an iron pipe at the south side of Buckeye Street at 571.00 feet, containing in all 1.582 Acres, more or less.

Of the above described 1.582 Acre tract, there is 0.56 Acres in the Corporation of Belle Center and 1.022 Acres in the Township. Of the 1.022 Acres, there is all of a 0.97 Acre tract and 0.052 Acres out of a 3.63 Acre tract.

I hereby certify that this is a true and accurate description of a survey made by me on June 2, 1913.

*Daniel E. Gilbert*  
Daniel E. Gilbert, P.S.

Reg. Sur. No. 5402

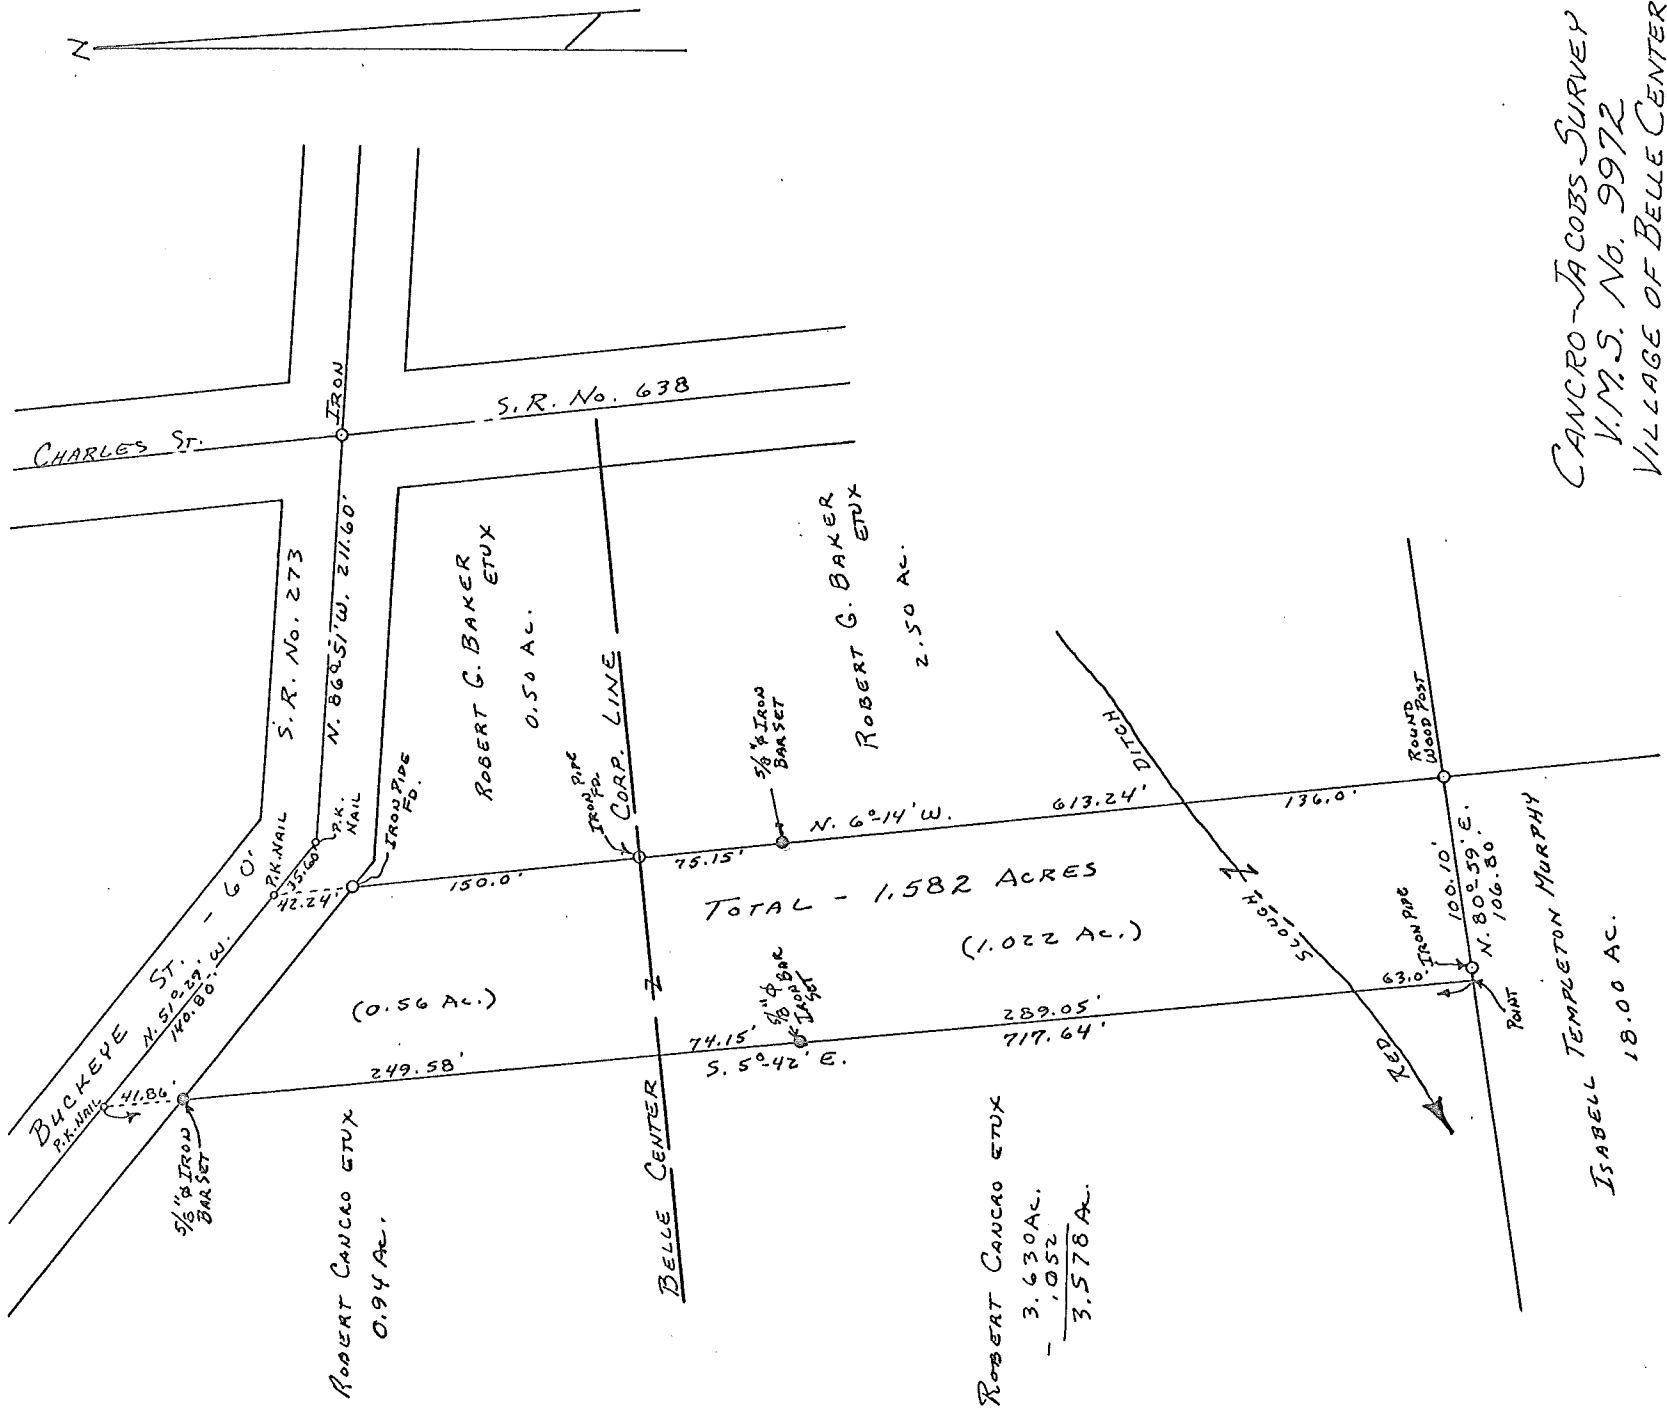

CANCRO-JACOBS SURVEY  
 V.M.S. No. 9972  
 VILLAGE OF BELLE CENTER  
 RICHLAND TOWNSHIP  
 LOGAN COUNTY, OHIO  
 JUNE 2, 1973

SCALE: 1" = 100'

ROBERT CANCAO ETUX  
 3.630 AC.  
 - .052  
 3.578 AC.

SURVEYED AND PLATTED BY:  
 DANIEL E. GILBERT, P.S.  
 REG. SUR. NO. 57402  
 1041 N. MAIN ST.  
 BELLEFONTAINE, OHIO 43311

5362

