


405 BUCKEYE ST.
BELLE CENTER, OHIO

[Handwritten signature]

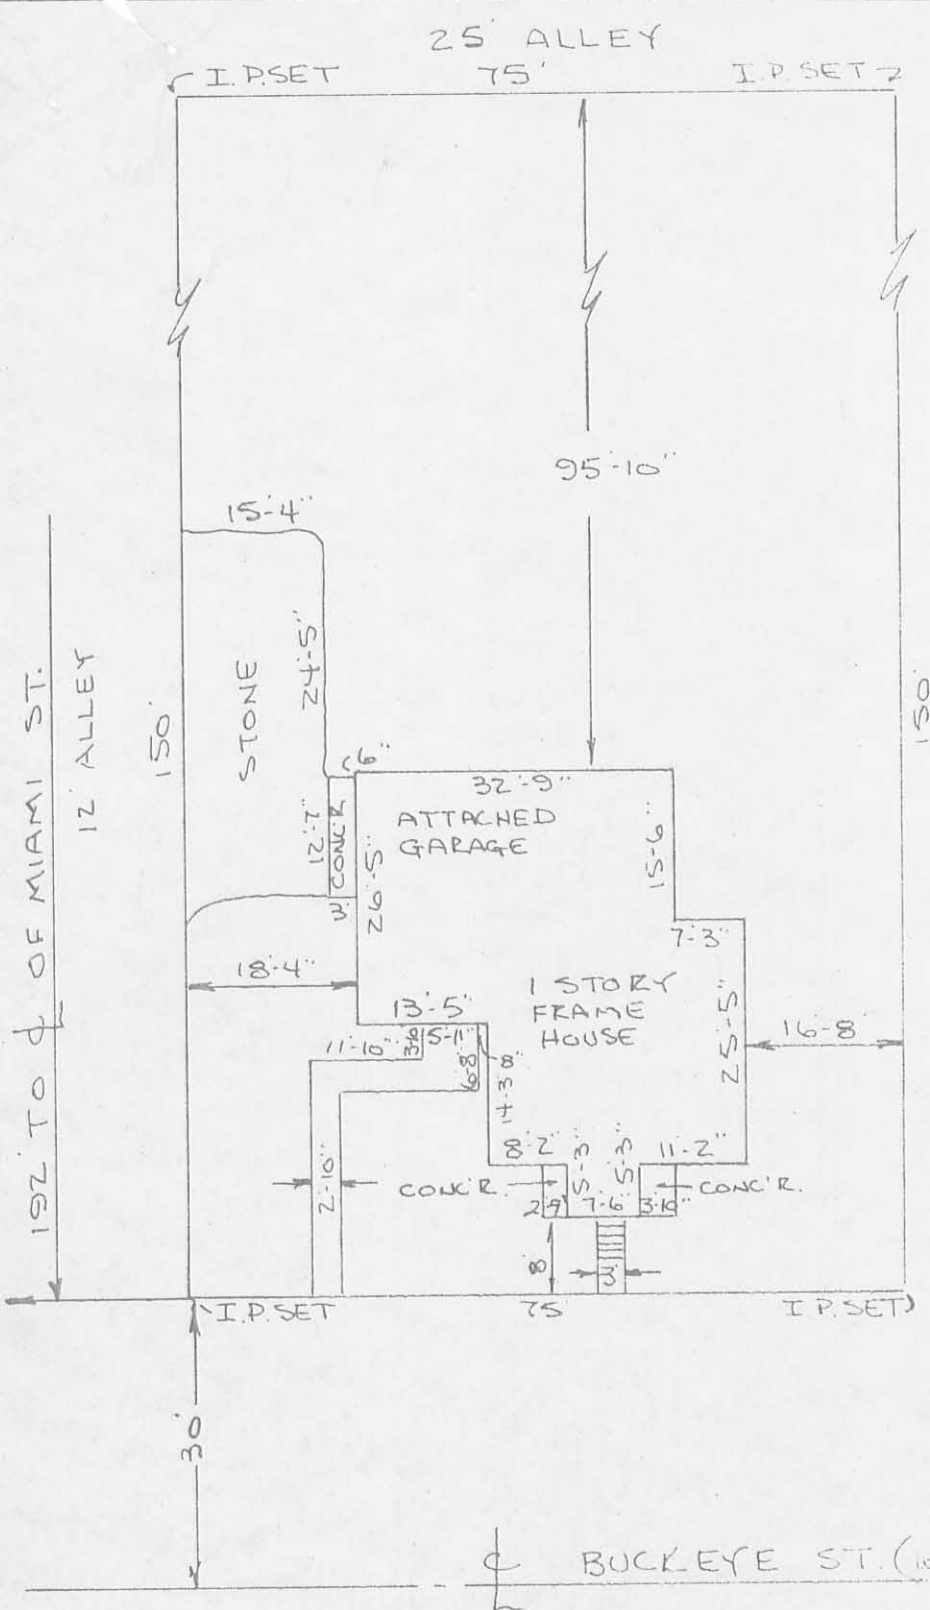

5635 IP

INDEXED ON MAP

THIS SURVEY FOR MORTGAGE PURPOSES ONLY

BUYER: RONALD O. MILLINGTON
 SELLER: JOSEPH A. HORD
 I HEREBY CERTIFY THAT THIS PLAN AND NOTES REPRESENT A SURVEY OF
 PROP. DESCRIPTION: LOT NO. 208 IN MACK'S ADDN., BELLE CENTER,
 LOGAN COUNTY, OHIO
 ENCROACHMENTS: NONE
 DATE: NOV. 18, 1974
 CORRECT TO THE BEST OF MY KNOWLEDGE AND BELIEF.
 SCALE: 1" = 20'



THE KISSELL COMPANY

ROLLY E. PION
 SURVEYOR NO. 5013

[Handwritten signature: Rolly E. Pion]