

Survey of lots 276-277-278


Wester Powers Addition
Belle Center, Ohio

Plat Bk A, Vol. 1, pg. 107

See County F.B. # 390 A-119
p. 501, pg. 80

INDEXED ON MAP
9610

2

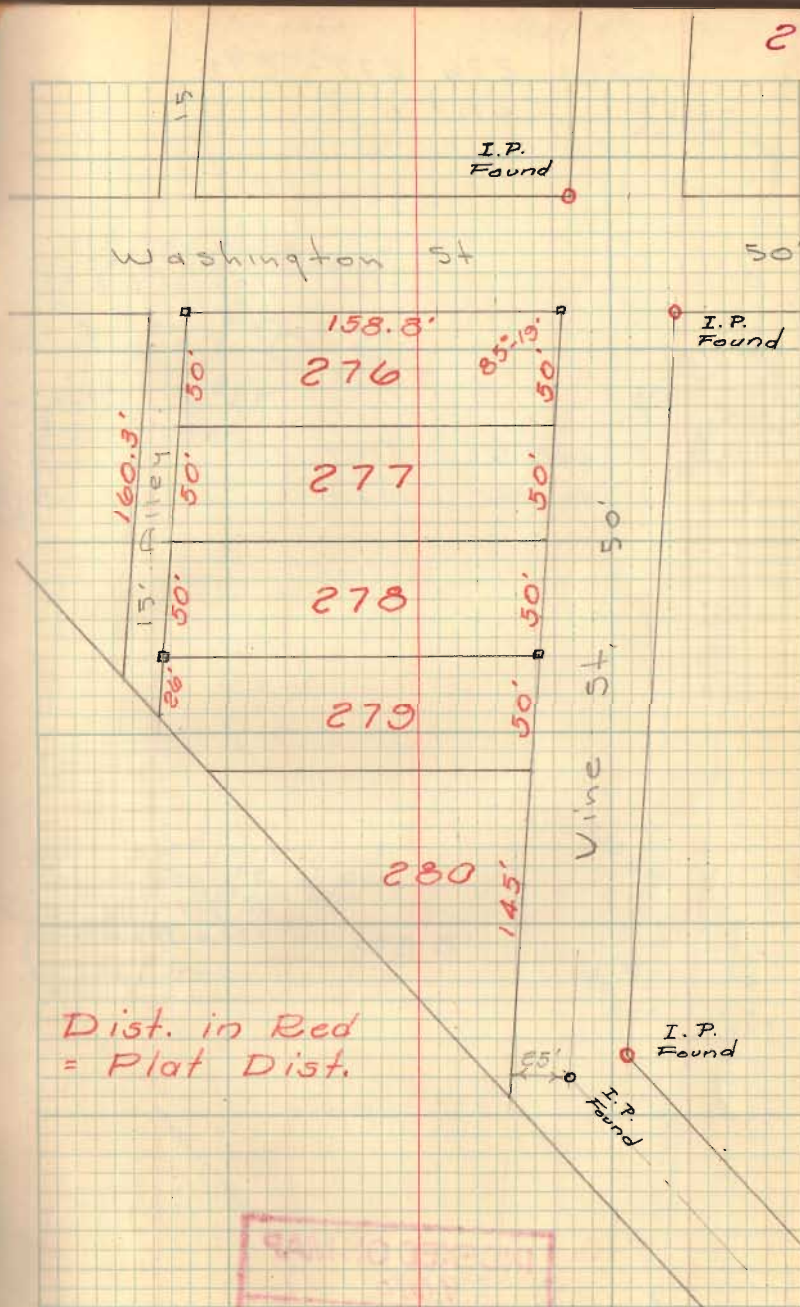

INDEXED ON MAP
9610

