

Survey of Carter Property near Water-works



CITY WATER WORKS.

ALLEY.



10/28/23
Cool - Windy


2

Enderlin's
1/1/1947.

North

54
INDEXED ON MAP

DETRIT ST.

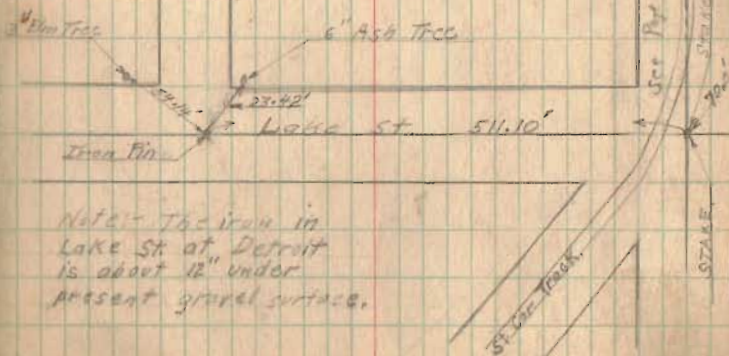

Note: The iron in
Lake St at Detroit
is about 12" under
present gravel surface.

STAKE

ST. CAR. TRACK.

BRICK HOUSE

Survey of Carter Property Near Water-works.

10/31/23 Entering
Clear-Cool Wright.

3

