


173  
675  
2,405

Survey for Jessie Reagh 4/1/25  
W.A. Montgomery  
H.M. Smucker

Bellefontaine  
& Chillicothe

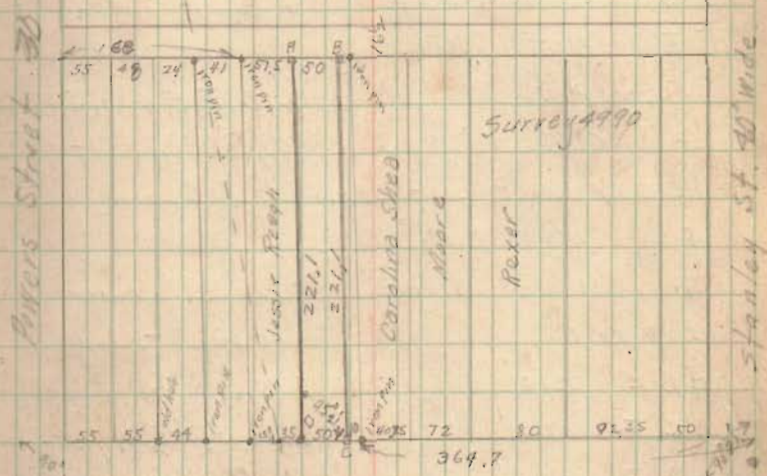

Survey 49990

- A - iron set 290.5 East of Powers on S - alley
- B - " " 290.5 " " " " " "
- C - " " 85 " " Ludlow and 30.85 East
- D - iron pin 35 " " and 26.85 East of E. of Powers

All other iron pin <sup>indicated</sup> found on ground for further notes see Field Book # 56 and Plot Book D page

129

INDEXED IN MAP

measured on Stanley 525  
measured on Powers 525.10  
set nails at 258.25 from Chil 4/1  
Powers + Stanley  
L Stanley + Chil 90°  
nail on Stanley 2' west of 4  
L Stanley + Chil 90° 31'

measured on Chil.  
20. street line  
70.5 fence  
143. fence  
248 fence  
314.7 iron pin East side of alley  
360.7 West side at alley cross from Stanley  
360.78 West side Reagh iron pin at Reagh West  
41 iron pin at  
45 old hub  
318.1 to E of Power from Reagh

Set stake at 290.5 from E. foundation  
on line of alley  
Set stake at 290.5 from E. Power  
West line 291  
East line 281  
L with Chil = 90° 31'