


Surveyed for Conda L. Smith.
Part of "So. Bellef. Add."
April 8th 1913.

222

INDEXED ON MAP

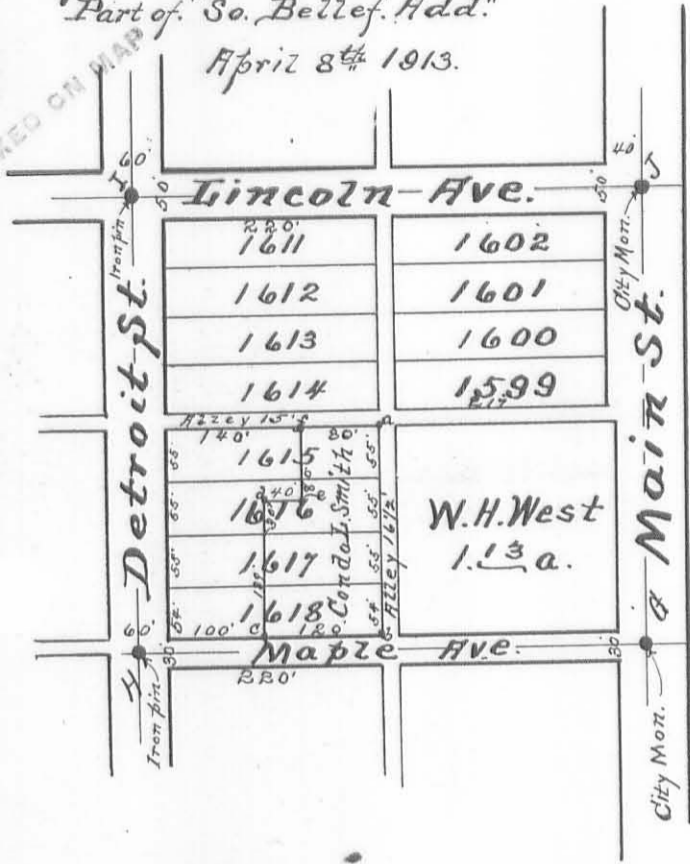

Field Notes.

- a = Post. N. E. cor. Lot N^o 1615
- b = Iron pin, 1" x 24". S. E. Cor. Lot N^o 1618.
- c = " " " " on S. line " " "
- d = " " " "
- e = " " " "
- f = Post on N. line Lot N^o 1615
- g = City monument on center Main St & Maple Ave.
- h = " " (Iron pin) " Detroit St. " " "
- i = " " (" ") " " " " Lincoln Ave.
- j = " " " " Main St " " "

Maple Ave = 30ft. wide. Lincoln Ave. 50ft wide
Detroit St. 60ft wide.

a to b = 219 feet. b to c = 120ft. c to d = 139ft.
d to e = 40 feet. e to f = 80 feet f to a = 80 feet.

Tract, a. b. c. d. e. f. a. surveyed as shown above for
Conda L. Smith. April 8th 1913.

Lines c-d & e-f are parallel to Detroit St.
Line d-e parallel to Maple Ave.

S. A. Buchanan Surveyor.