


INDEXED ON MAP

107	112
27	23
74	27
90	
112	18
84	52

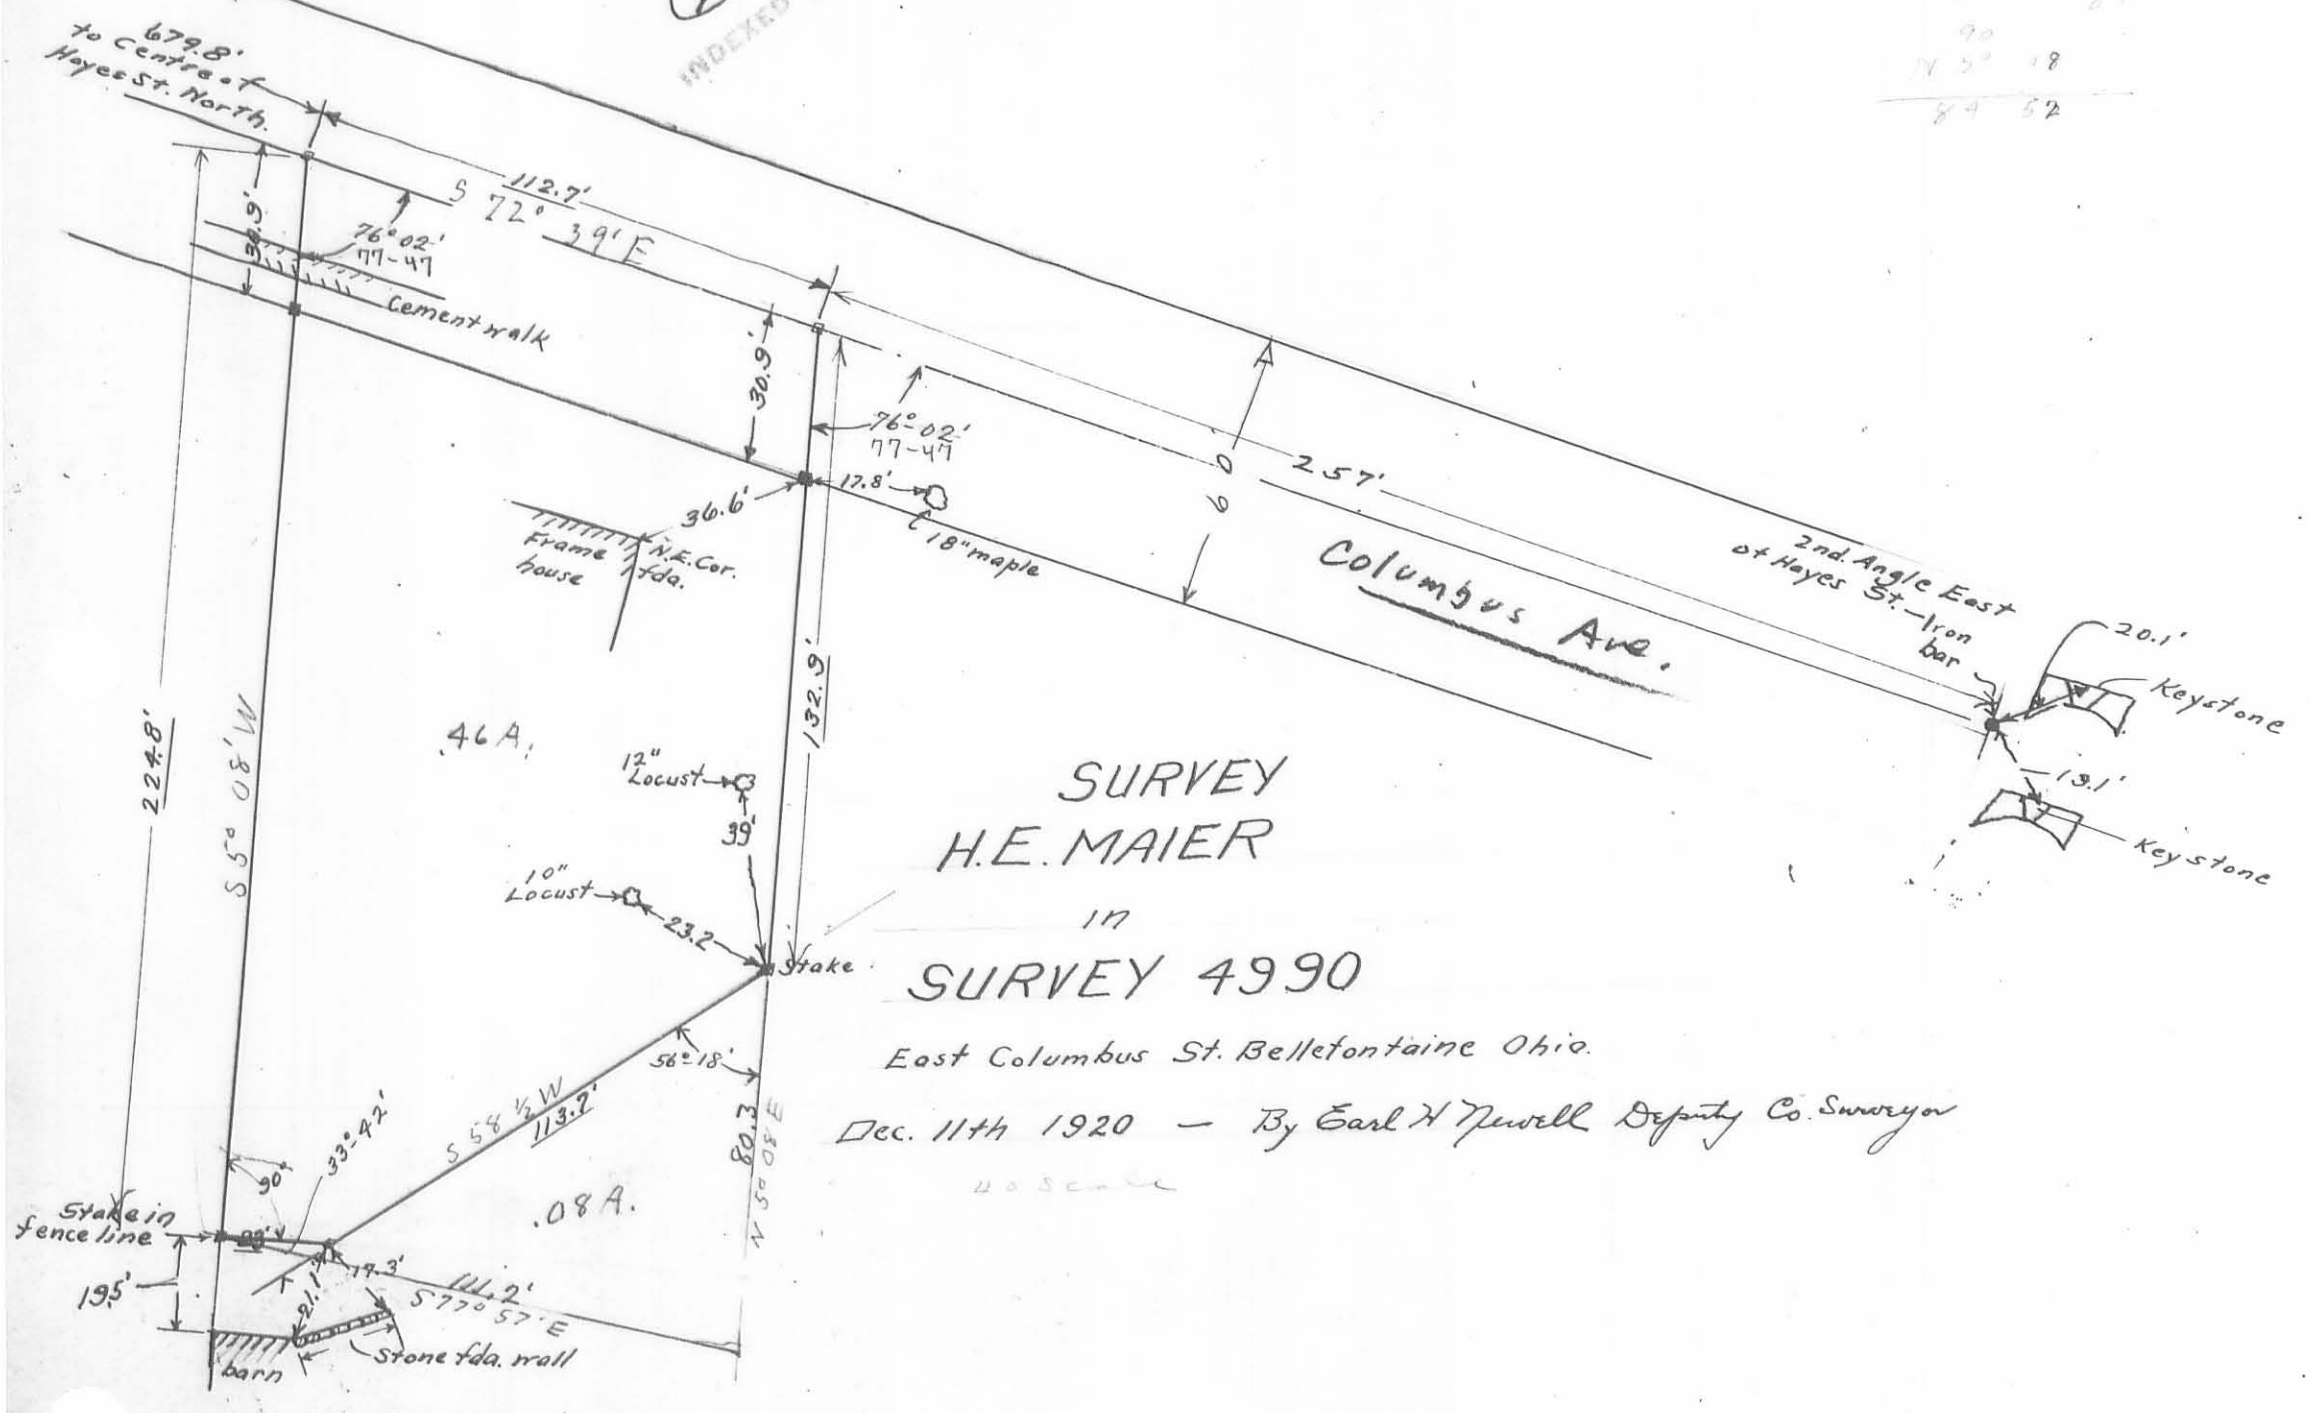

SURVEY
H.E. MAIER
17
SURVEY 4990

East Columbus St. Bellefontaine Ohio.
Dec. 11th 1920 - By Earl H. Newell Deputy Co. Surveyor

40 Scale