


30/ Survey Julia E White Land. 13/13

Bellefontaine O For Bellef Base Ball Co
 Don Detrich Flag.
 Earl Terrell 2 ch.
 Fullingbe West

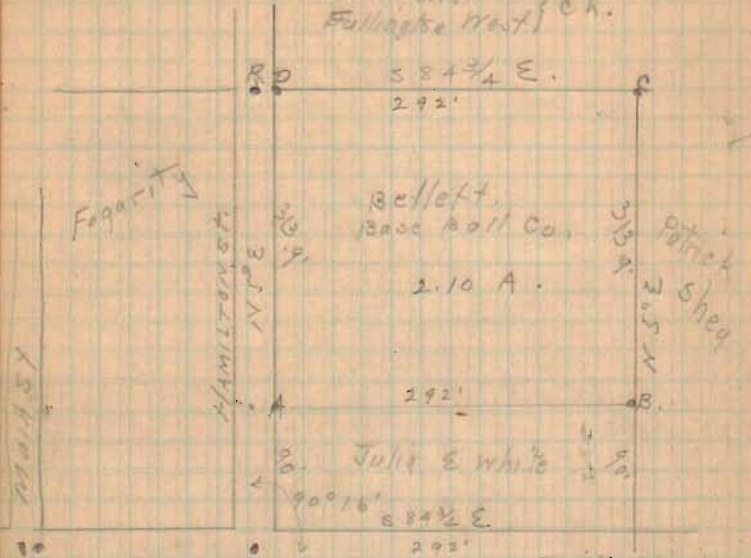

Washington Ave
 Washington = 50' wide
 Hamilton = 2 50'

Found Iron pin at + Washington & Hamilton
 " Mon. at + " & Main
 " Iron Pin @ Hamilton at " R.
 Set iron pins at A, B, C, D. as shown
 Line B & Co. in old fence row.


Levels Base Ball Grounds

5/17/13 Harold Emerson Rod
 Dir West
 B.M. 5.82 40.00 2 Tacks 6" above ground
 T. 45.82 in Telephone pole N.W. Grounds
 Grade

Surf Home plate.	4.52	41.30	41.22
50' E "	4.02	41.80	
125' " "	3.45	42.37	
200' " "	2.67	43.15	
50' S. of " X"	2.00	43.82	
100' " " X	2.64	43.18	
130' " " X	3.17	42.65	
160' " " X (R)	1.95	43.87	
125' West of R	5.14	40.68	
50' E of Hamilton at	3.02	40.17	
1st Base	6.05	39.77	41.22
2nd "	5.90	39.92	40.92
Center field	6.40	39.92	40.92
Right "	6.25	39.57	40.92
Left "	4.15	41.67	40.92
Pitcher box	4.80	41.02	42.22
Surf. 3rd Base	3.49	42.33	41.22
Peg in L. field	1.87	43.95	40.92

750

INDEXED ON MAP

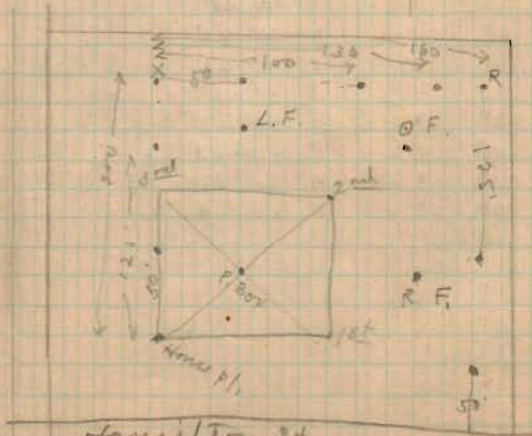


Hamilton St

30
Survey Julia E White Land. 5/13

Bellefontaine D For Bellefont Base Ball Co
Don Detrich Flag.
Earl Kerrell } ch.
Fullington West }

F.B. 390 A

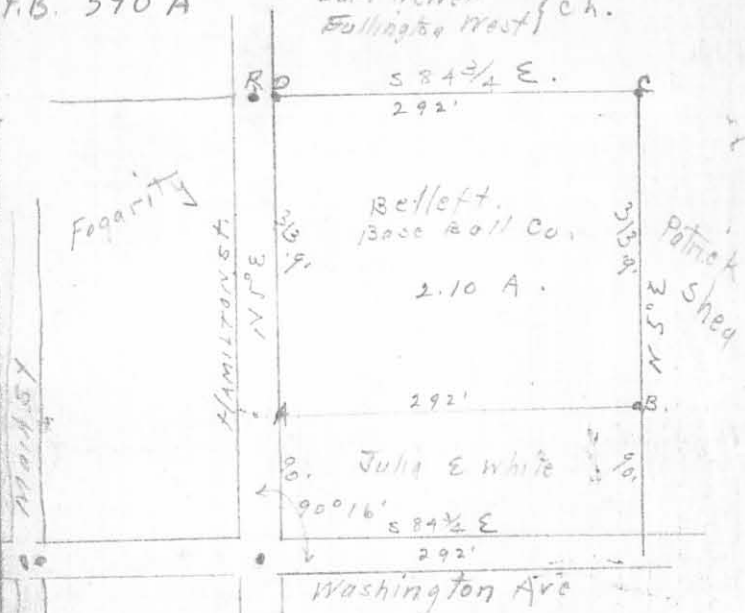

Found Iron Pin at + Washington & Hamilton
" Mon. at + " & Main
" Iron Pin @ Hamilton at " R.
Set Iron Pins at A, B, C, D. as shown.
Line BC & CD. in old Fence Row.

3F Levels Base Ball Grounds

5/17/12 Harold Emerson Rod

B.M. 5.82 40.00
T. 45.82
Dir West
2 Tacks 6" above ground
in Telephone pole N.W. Corner
Grade

Surf. Home plate.	4.52	41.30	41.22
50' E "	4.02	41.80	
125' " " "	3.45	42.37	
200' " " "	2.67	43.15	
50' S. of " X "	2.00	43.82	
100' " " X	2.64	43.18	
130' " " X	3.17	42.65	
160' " " X (R)	1.96	43.87	
125' West R R	5.14	40.68	
50' E of Hamilton St	4.52	40.17	
1st Base	6.05	39.77	41.22
2nd "	5.90	39.92	40.92
Center field	6.40	39.42	40.92
Right "	6.25	39.57	40.92
Left "	4.15	41.67	40.92
Pitchers Box	4.80	41.02	42.22
Surf. 3rd Base	3.49	42.33	41.22
Peg in L. Field	1.87	43.95	40.92

750 IP

INDEXED ON MAP

