


BRIGGS SURVEY : 613 NO. MADRIVER
 LOT 1046 : BELLEFONTAINE, OHIO

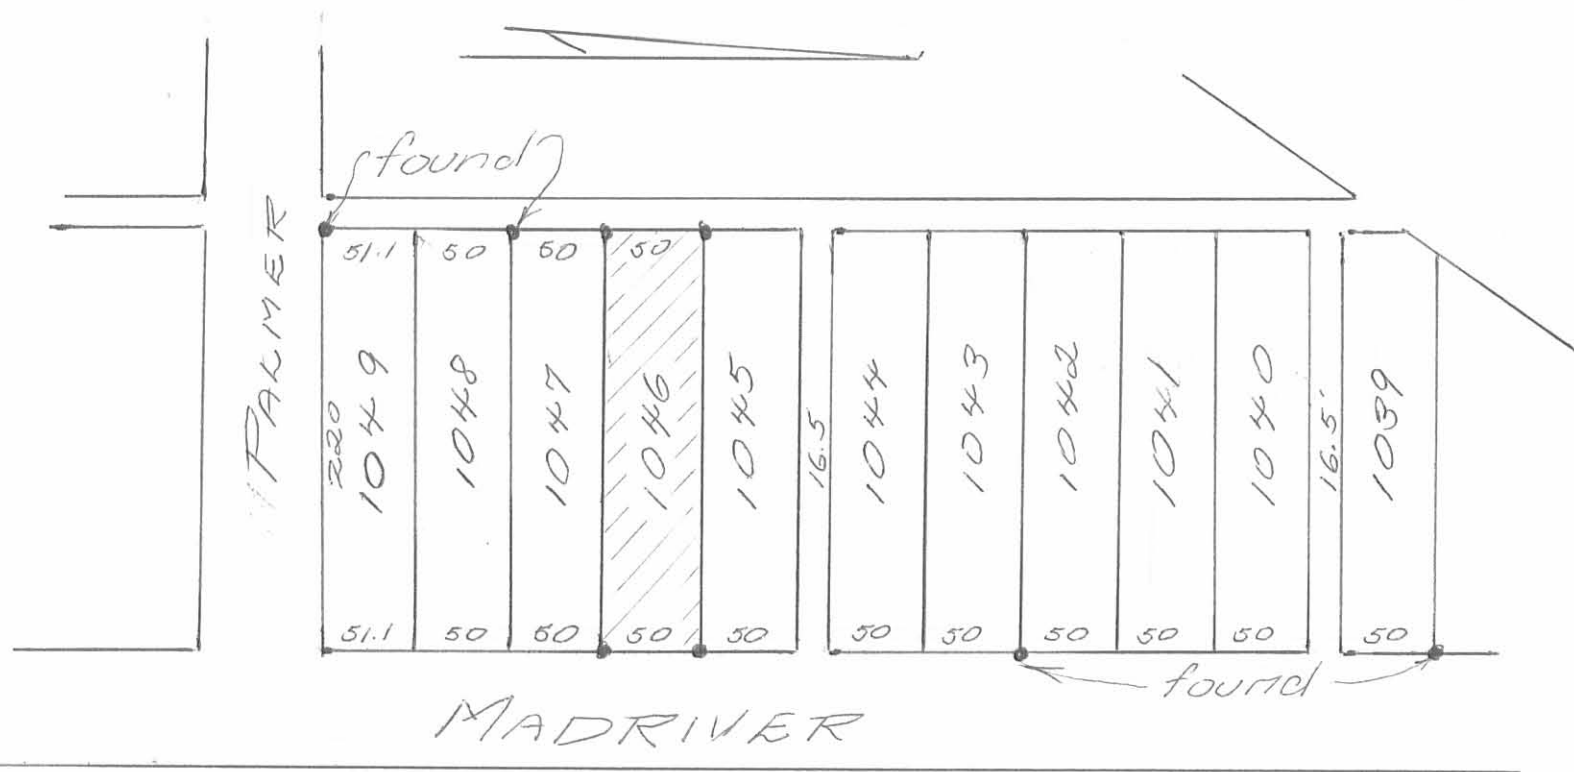

Owen K. Shirk
 Surveyor 4271
 May 28, 1976

896 IP

MAIN

ST.

N 2 1/4 E 49 1/2 p.

INDEXED ON MAP

(596) 2P Palmer survey
Billifontama
Between Main and Mad River

H. E. Palmer et al.

S. 1 W.

S 8 1/4 E 27 1/2 p.

N 8 1/4 W 11 1/4 p.

S 2 3/4 W 5 p.

N 8 1/4 W 16 1/2 p.

S 2 1/4 W 45 1/2 p.

MAD RIVER

ST.

