

Kalb Survey

Lot. 596 N. Detroit St

Lots as shown on Plat Book

Main To Detroit on Brown 2' EXCESS

" " " " High 2'-6" "

Made $\frac{1}{2}$ of alley allowing for excess 1' on Brown
and 1'-3" on High.

High To Brown on Detroit 2' EXCESS

Curbs at alley O.K. using 1' EXCESS from High

see next page

1102

INDEXED ON MAP

Kalb Recd Vol. 112 Page 314.

Powell's second Addition

Lot 7 = 595

Lot 8 = 596

All of lot 8


60' E. by W. of lot 7 S.W. cor. 5' wide.

April-13-1929

Cool

Wright
Bill Wright.

27

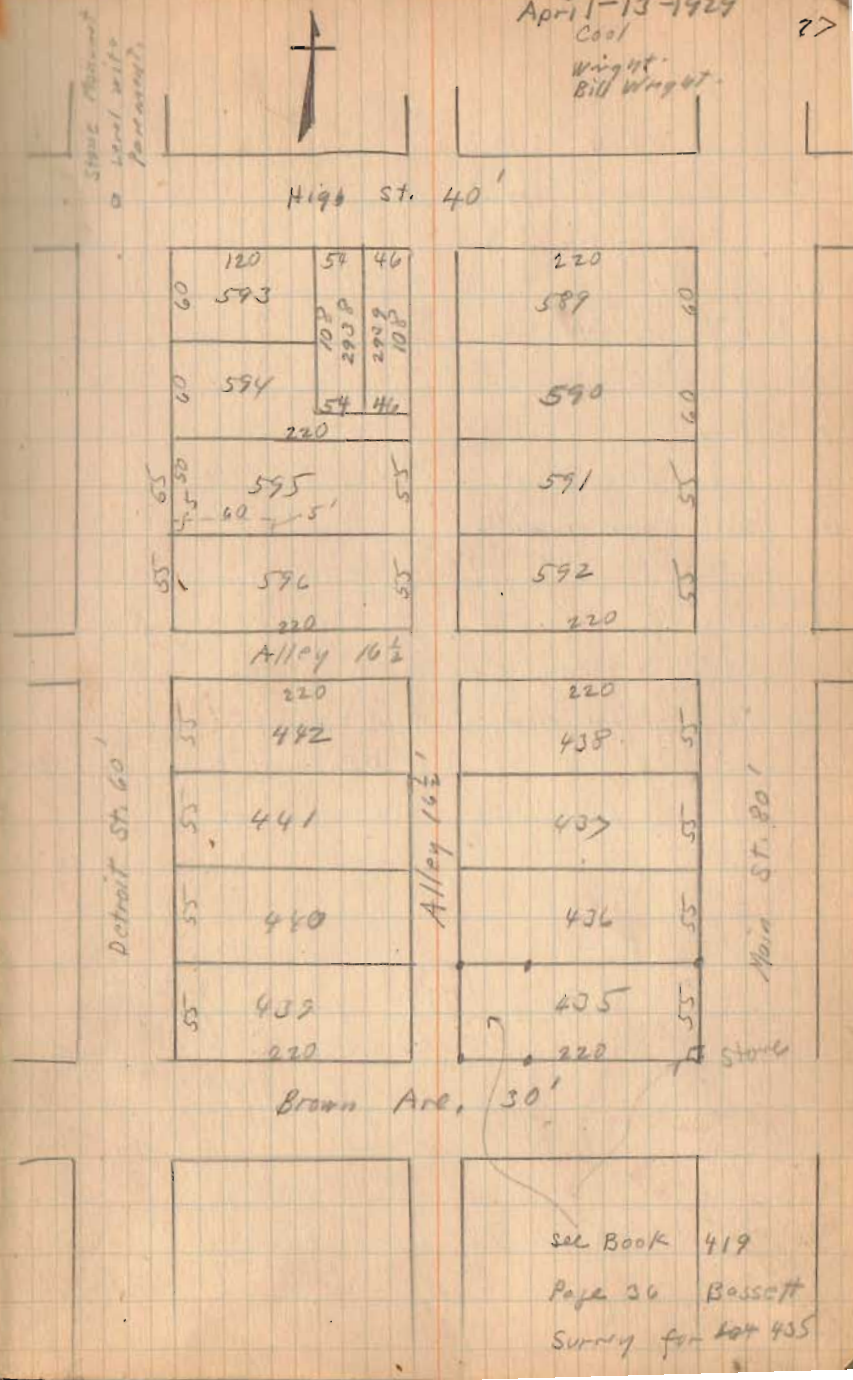

Kalb Surveys

- A $\frac{1}{4}$ " Iron 18" long
- B $\frac{3}{4}$ " " " "
- C $\frac{3}{4}$ " " " "
- D $\frac{3}{4}$ " " " "
- E Hub
- F Hub with spikes
- G Old Iron Found

FG = 68'-8"

EF Trace of old Fence Row.


C 1'-8" From edge of walk

3" tree 9' west of line DE.

68-8
51-3
123-11

4-13-29

28

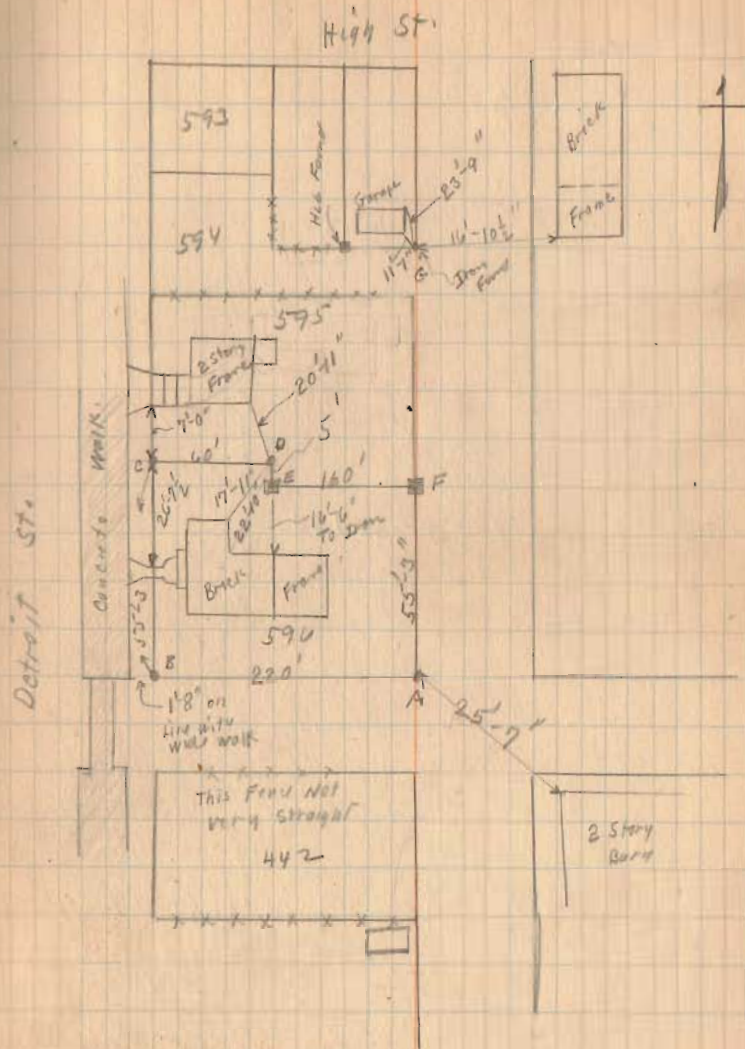

INDEXED ON MAP


HIGH AVE. (40')

259.31'



LEGEND

- PK MAIL FOUND
- PK MAIL SET
- ⊗ RRS SET
- 5/8" I. ROD SET

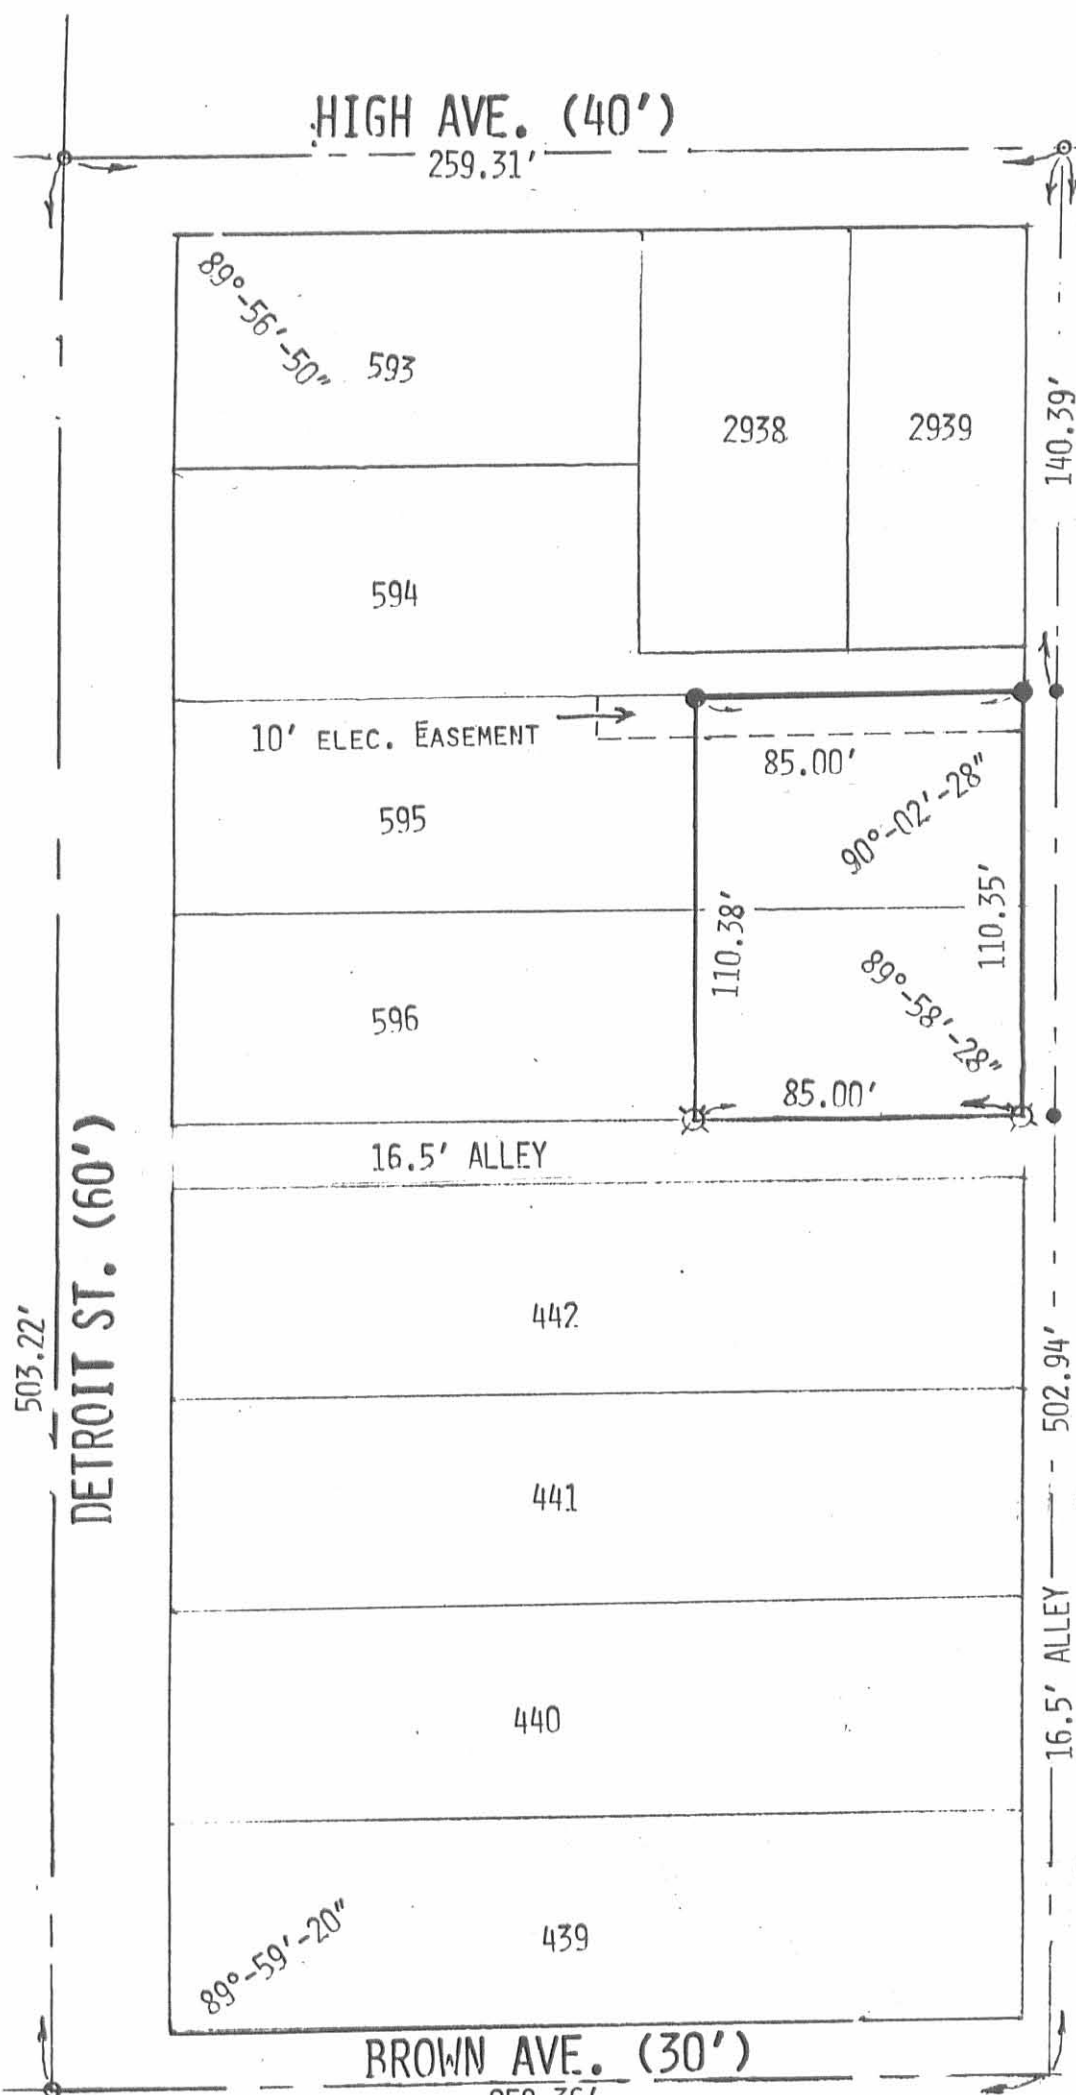

140.39'

10' ELEC. EASEMENT

85.00'

90°-02'-28"

110.38'

110.35'

89°-58'-28"

85.00'

16.5' ALLEY

442

441

440

439

BROWN AVE. (30')

259.36'

502.94'

16.5' ALLEY



ORIGINAL STAMP IN GREEN

SURVEYED BY:

Jeffrey T. Lee
 JEFFREY T. LEE
 PROFESSIONAL SURVEYOR 6359

SURVEY OF 85.00 FEET OFF THE EAST END OF
 LOTS 595 AND 596
 CITY OF BELLEFONTAINE
 LAKE TOWNSHIP, LOGAN COUNTY, OHIO

SCALE 50



JULY 16, 1990

INDEXED ON MAP
 1102 1P

L.1834-4

LEE SURVEYING & MAPPING CO.
 143 East Columbus Avenue
 BELLEFONTAINE, OHIO 43311
 (513) 593-7335

Kalb Survey
 Lot. 590 N. Detroit St

Lots as shown on Plat Book
 Main To Detroit on Brown 2' Excess
 " " " " High 2'-6" "
 Made $\frac{1}{2}$ of alley allowing for excess 1' on Brown
 and 1'-3" on High

High To Brown on Detroit 2' Excess
 Curbs at alley O.K. using 1' Excess from High

see next page

1102 2P-1

INDEXED ON MAP

Kalb Deed Vol. 112 Page 314.
 Powell's second Addition
 Lot 7 = 595
 Lot 8 = 596
 All of Lot 8
 60' E. & W. of lot 7 SW. cor. 5' wide.

Stone Monument
 Level with
 pavement



April 13-1929
 Cool
 Wright
 Bill Wright



see Book 419
 Page 36 Bassett
 Survey for lot 435

Kalb Surren

- A $\frac{1}{4}$ " Iron 18" long
- B $\frac{3}{4}$ " " " "
- C $\frac{3}{4}$ " " " "
- D $\frac{3}{4}$ " " " "
- E Hub
- F Hub with spikes
- G Old Iron Fencing

FG = 08'-8"

EF . Tray of old Fence Row


C 1'-8" From edge of wall

3" tree 9" west of line DE.

65-8
55-3
123-11

4-13-29

28

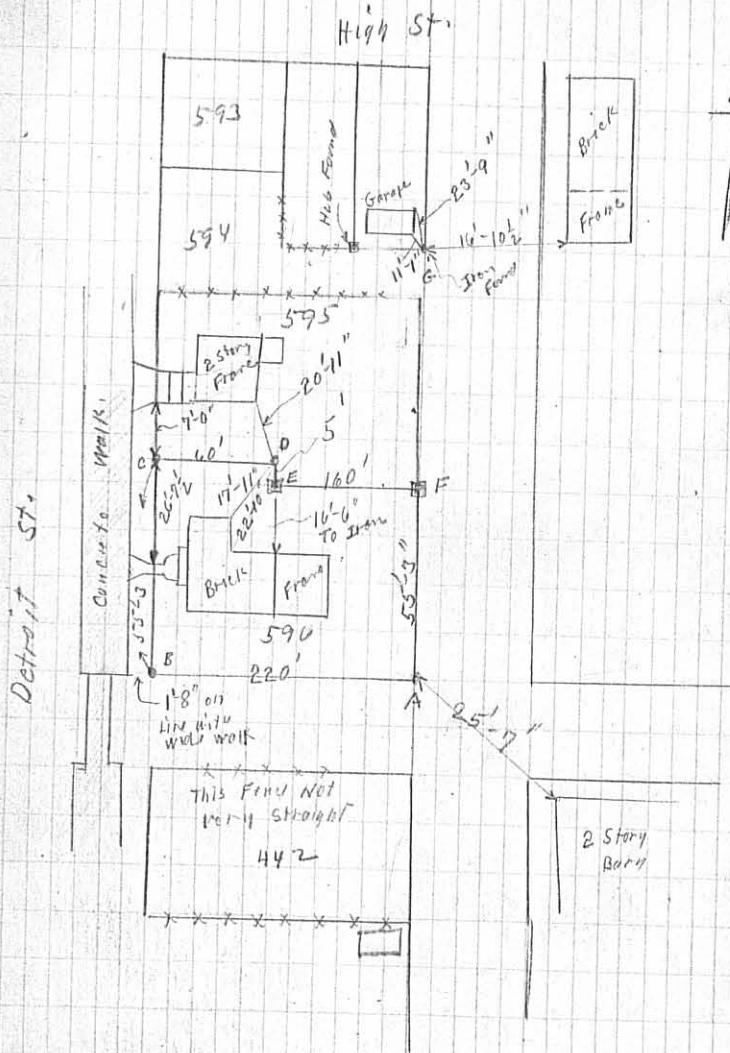

INDEXED ON MAP