



TOWNSHIP

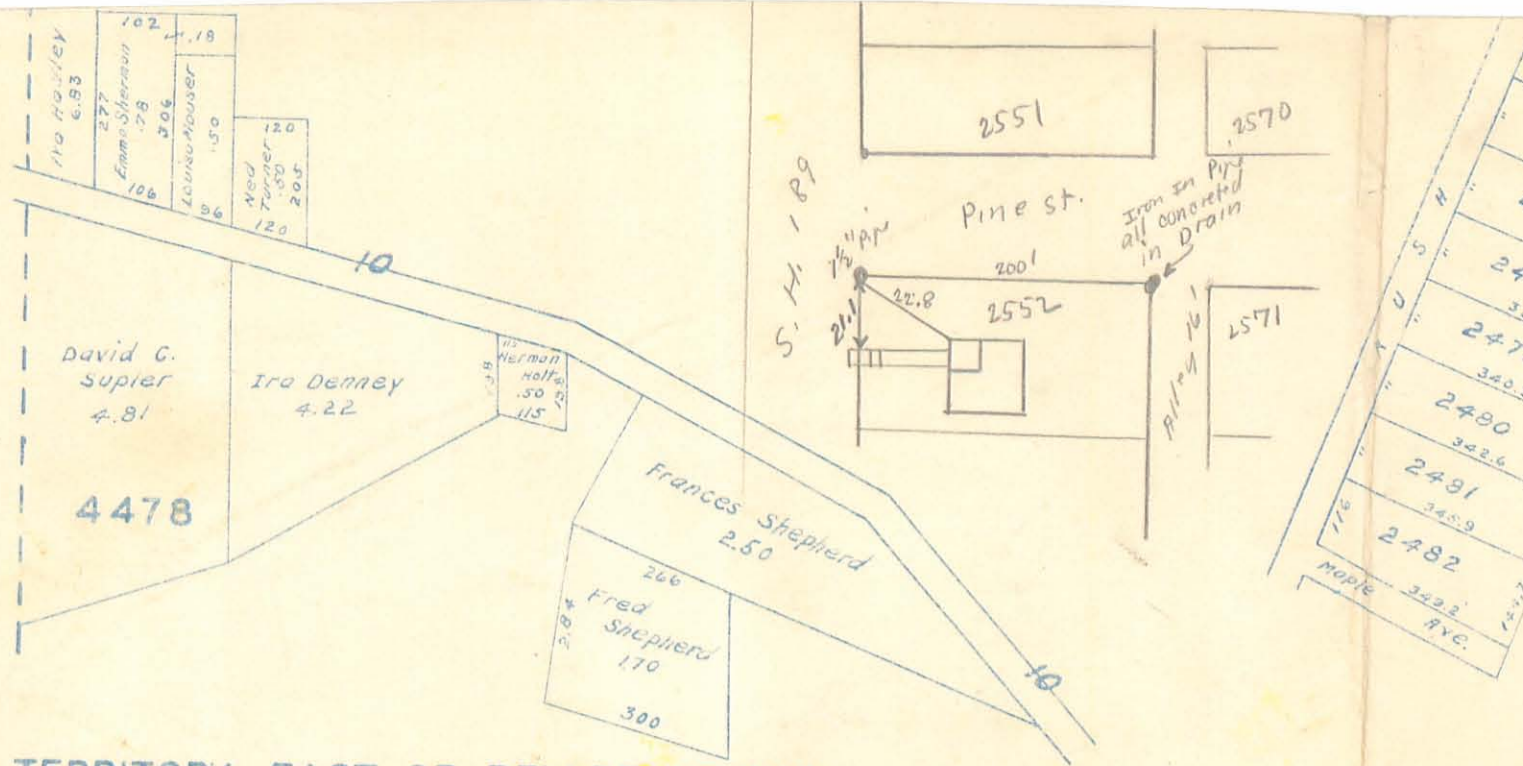



TERRITORY EAST OF BELLEFONTAINE

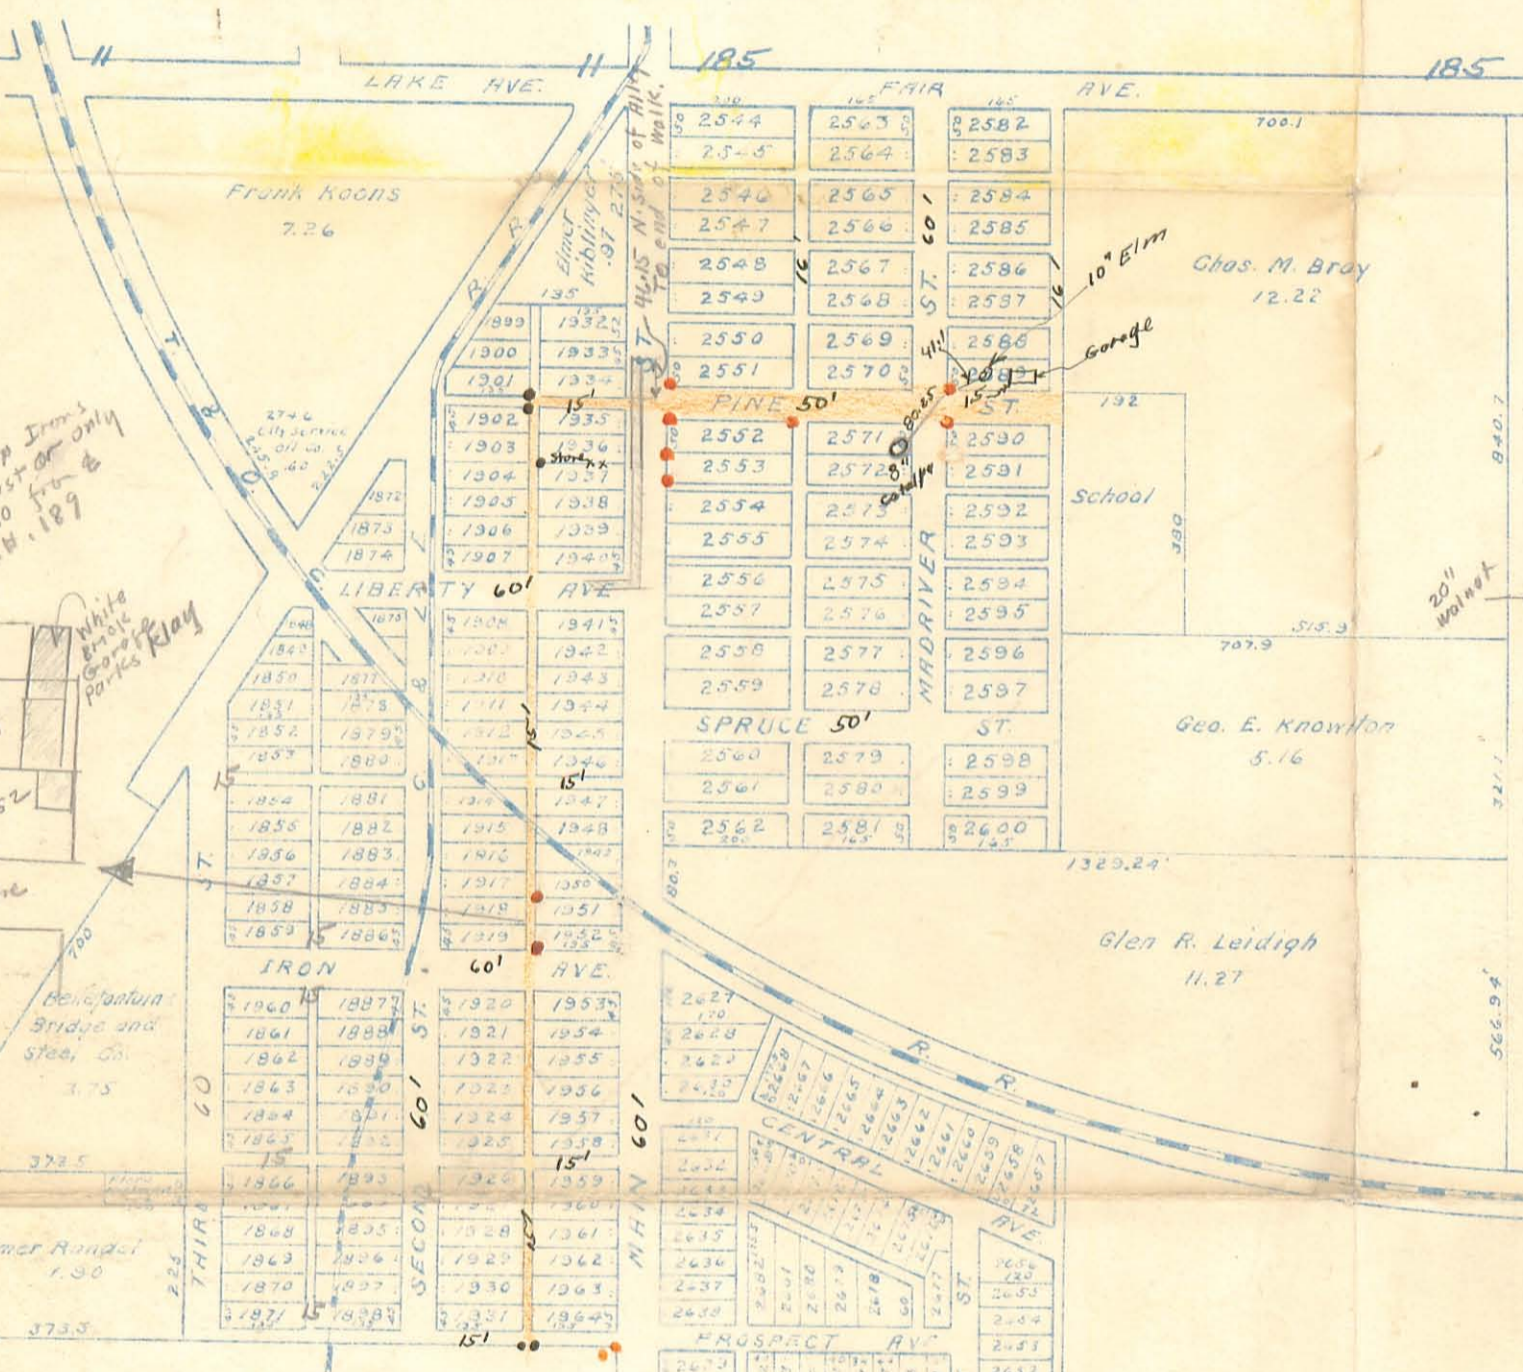

IRON CITY LOTS

TOWNSHIP ROAD NO.	MILES
56	2.10/2 1.05
57	2.00/2 1.00
181	.45
183	.45
185	1.40
200	.80/2 .40
216	1.55/2 .80
217	1.00
219	2.15
233	.25
245	.40
246	.30
Iron City	1.40
Clarks Addition	1.80
	12.85

STATE ROUTES  
 COUNTY PIKES  
 TOWNSHIP ROADS

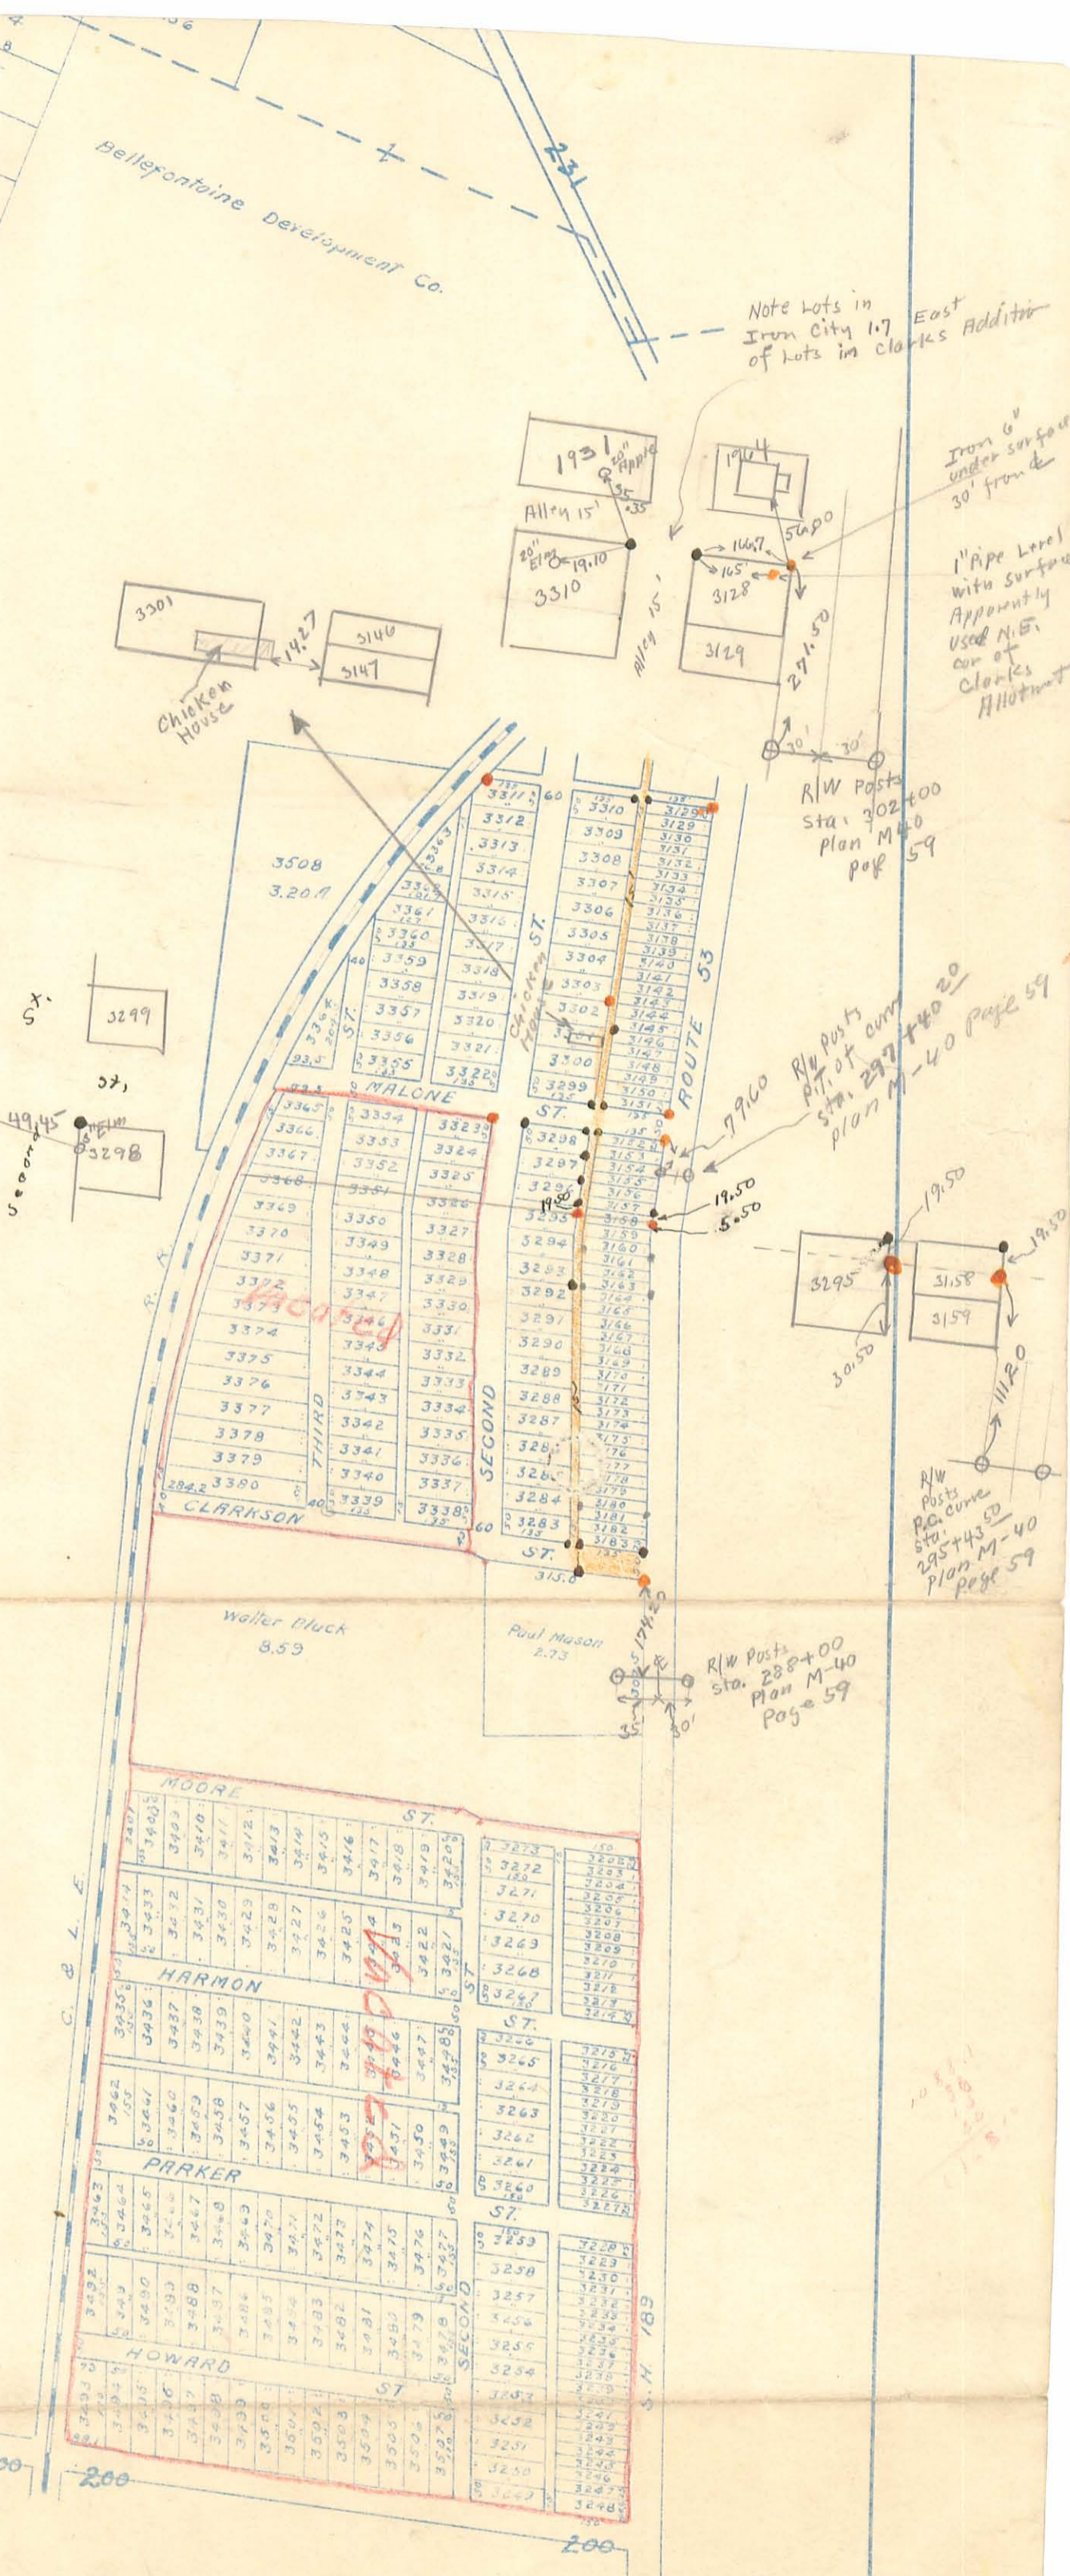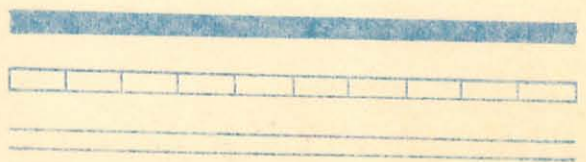

CLARKS PARK ADDITION

stakes for Iron City Light Poles.  
 ● Irons found  
 ● Hubs  
 Dec-15 & 16 1936  
 F. Wright  
 G. Wilgus  
 G. Pusy

NOTE:  
 stakes for Alley and street lines placed Not at lot corners Except where old Hub or Iron was found.

1769 IP  
 INDEXED ON MAP

Lake Twp.