


Street Centers Bellefontaine Ohio

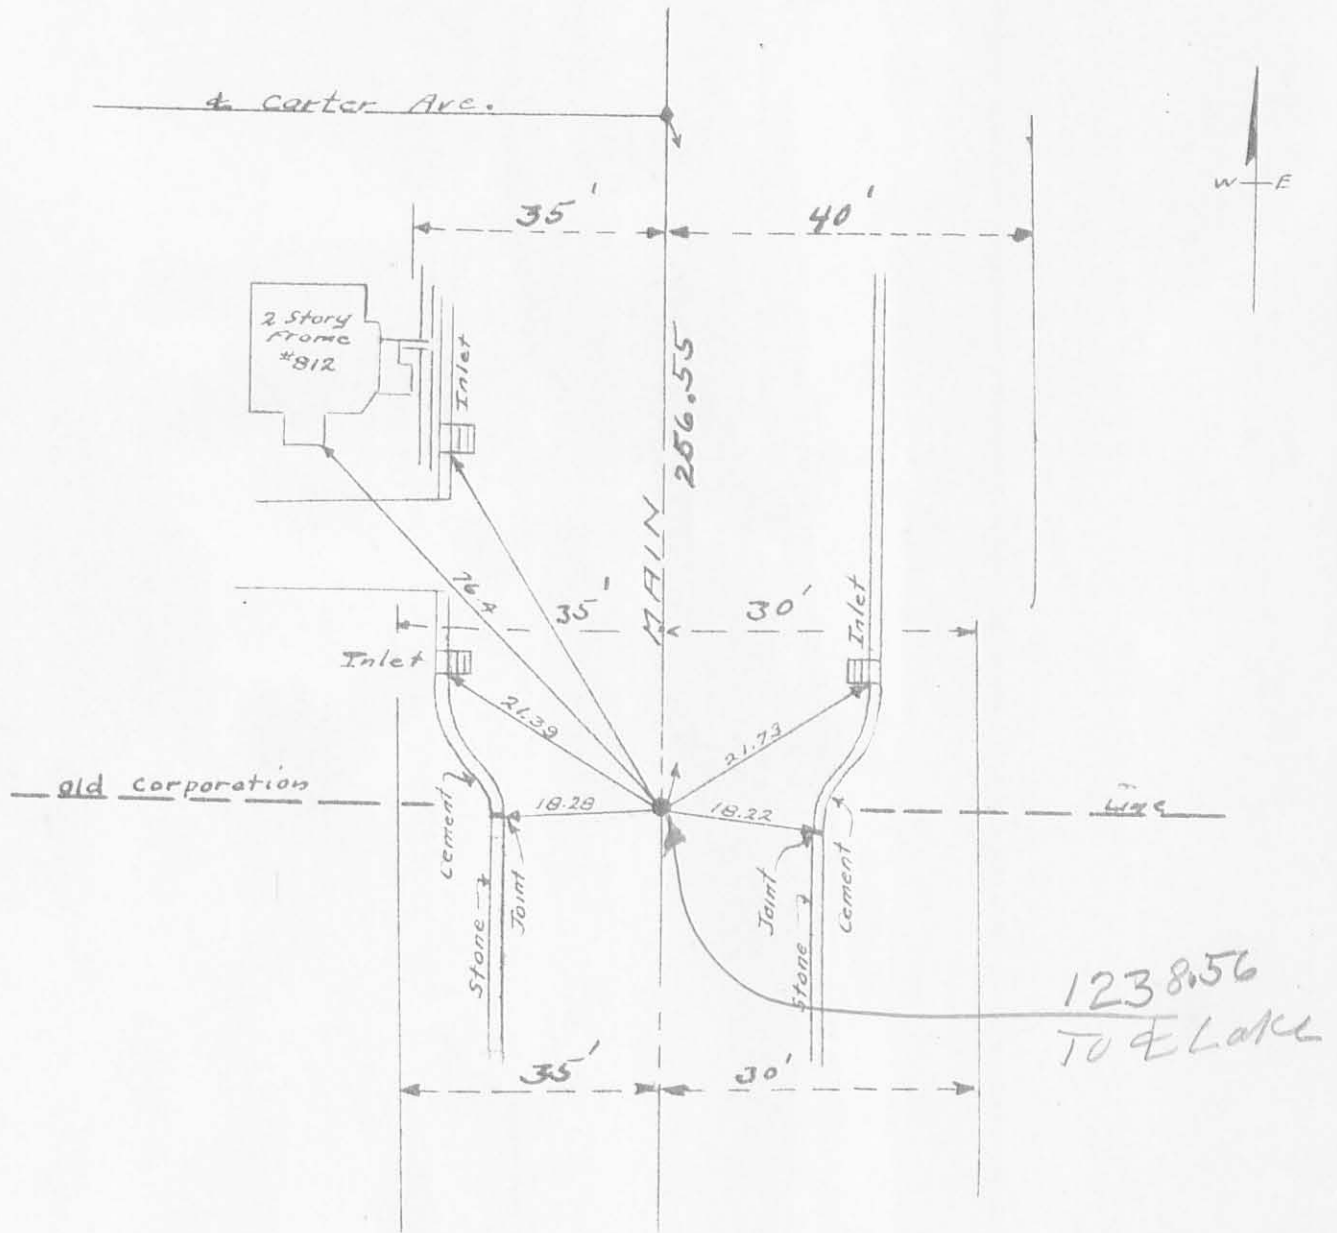

Date Witnessed... *May 22-1940* .....

Material... *Copper in Lead* .....

Scale..... *None* .....

Monument Cover... *None* .....

Book.....Page.....

*Old Corporation Line 256.55 south  
of & of Carter.*

..... **MAIN** .....

At

**OLD CORPORATION LINE**