

Survey -  
Bellefontaine Library lot  
+ Bldg.


Note: - 7" shortage between  
Sandusky & Columbus Streets.  
8" over-run between  
Main & Madriver Streets.

2057


INDEXED ON MAP

Party: -  
C. Keyson  
G. Wilgus  
V. Detrick  
E. Core Jr.

June 1950

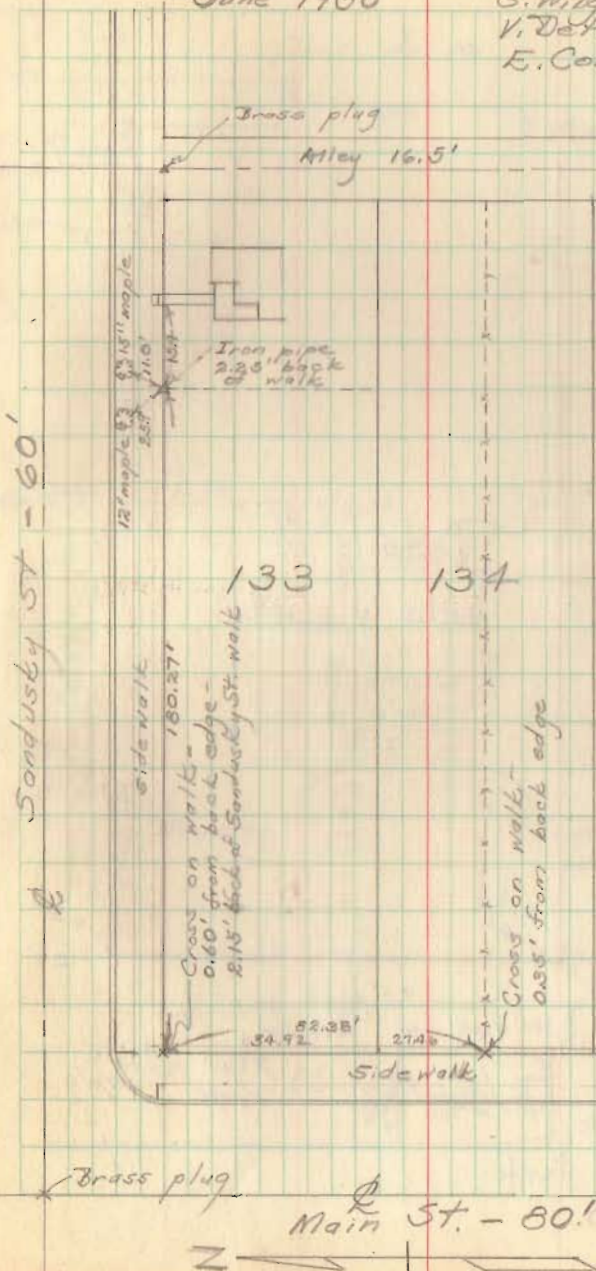


Library (contd)

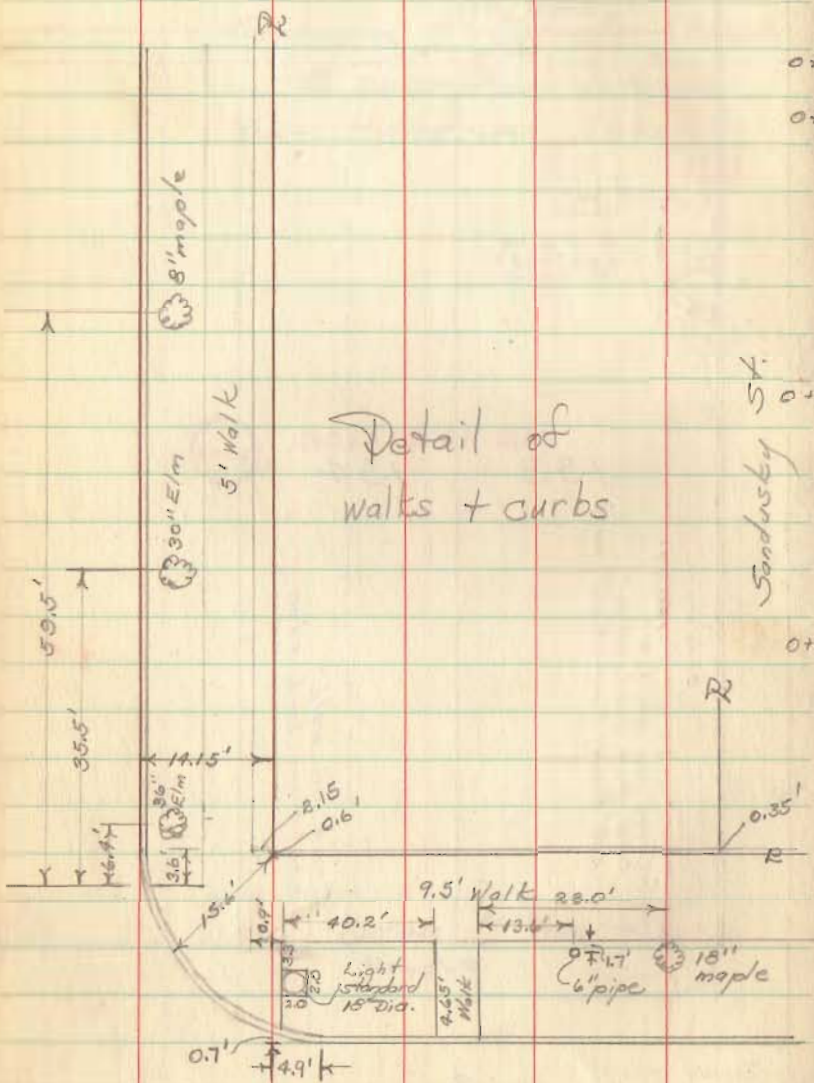

Detail of  
walks + curbs

Sandusky St.

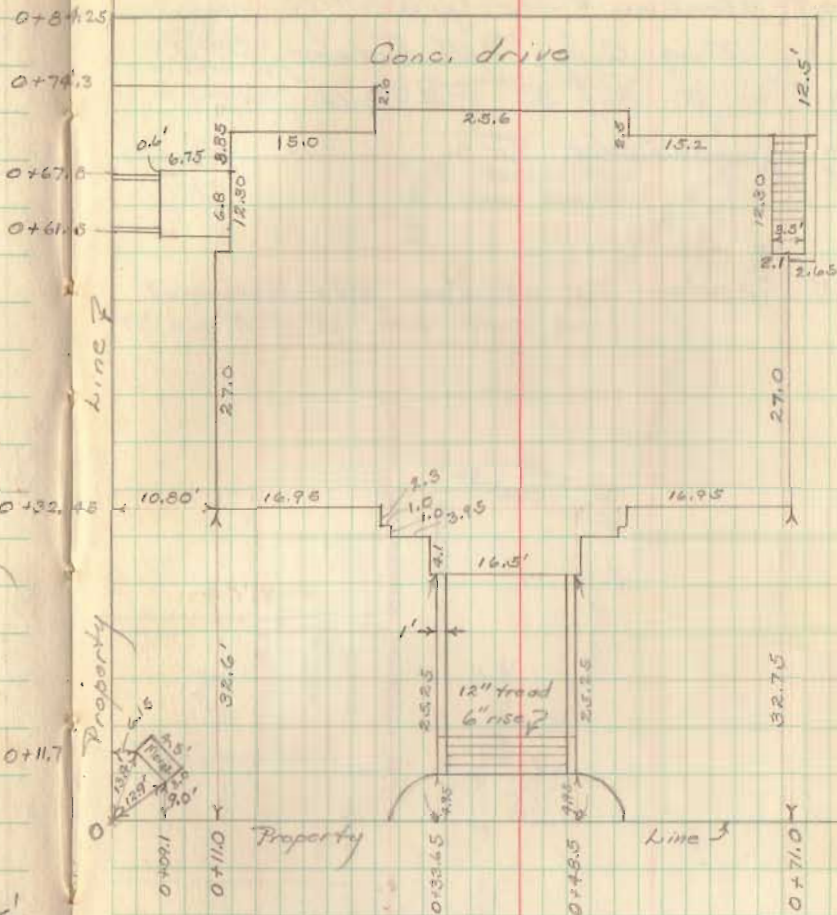

Main St.