


7/29/37

Lot 2991

Indian Park Btt. O.

- A Spike in sidewalk (found)  
 B same  
 C Iron pipe (set) in fence line  
 D Iron pipe (set) in fence line

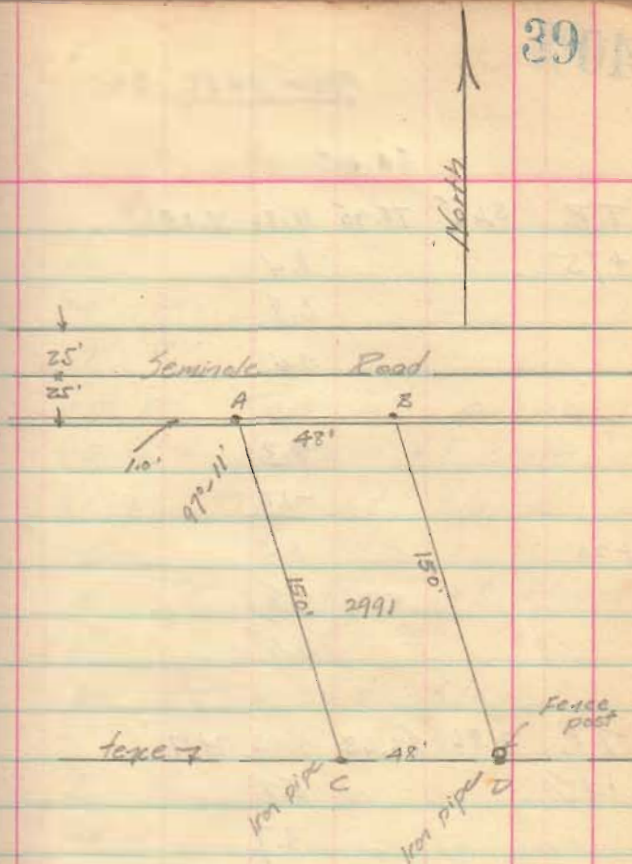

Surveyed as shown 7/29/37

INDEXED ON MAP

2273