

153
19

1124
13

13
12

65.17

Survey of Part of Lot
439 in Bellefontaine
for the Citizens Federal
Savings & Loan Co.


on L's	Plot	Measure
Main Brown to High	501.5	502.74
High Main to Det	526.5	528.65
Detroit High to Brown	501.5	503.03
Brown Det to Main	526.5	528.65

- A set iron pipe
- B set iron pipe
- C set iron pipe
- D set iron pipe

Citizens Federal Savings 155-1
to Chester S. Bradley A-20-36


Aug. 31, 1937
C.A. Miskoop
G.C. Miskoop
Fred Frozer

89-59
90-02
59-55-30
90-02-30
79-59-00

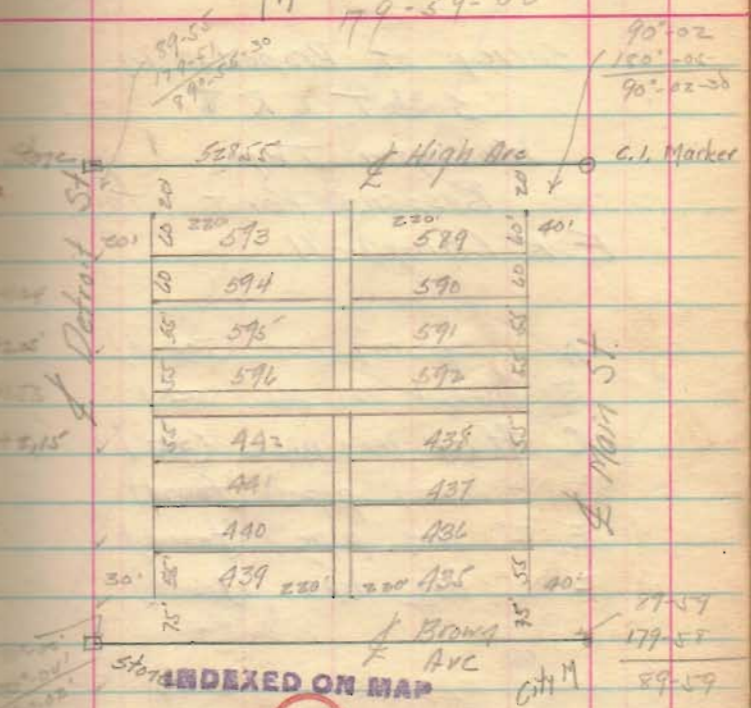

INDEXED ON MAP

2279

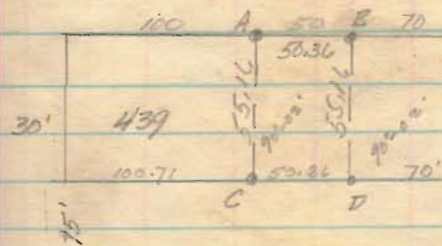

Brown