

Original Town Plat
Shows Lots 55' x 220'

● Irons
x Chisel Cross
--- Original Lot Lines
--- Land lines

- (A) B.O. Beatty To Herbert Buckenroth
Deed Vol. 191 Page 43 Jan. 15, 1949
- (B) F.J. Kaylor To Herbert Buckenroth
Deed Vol. 250 Page 213-214
April 14 1958
- (C) Stephen Azary To Herbert Buckenroth
Deed Vol. 250 Page 385-387
May 2, 1958
- (D) Helen Brophy (Guardian) To Etha Curl
Deed Vol. 187 Page 391 Nov. 9, 1945
- (E) Maggie W. Ginn To Harry F. Merrillees
Deed Vol. 130 Page 304 Oct. 2, 1925
- (F) Lulu M. Klaepfer To Harry F. Merrillees
Deed Vol. 128 Page 145 Feb. 23, 1924

BUCKENROTH SURVEY
BELLEFONTAINE OHIO
LOTS 208-213

JUNE 1958 1"=15'
 0 10 20 30




INDEXED ON MAP
 208 1P
 INDEXED ON MAP

Book 320

Bellefontaine Federal Savings
(Fire Station)

16

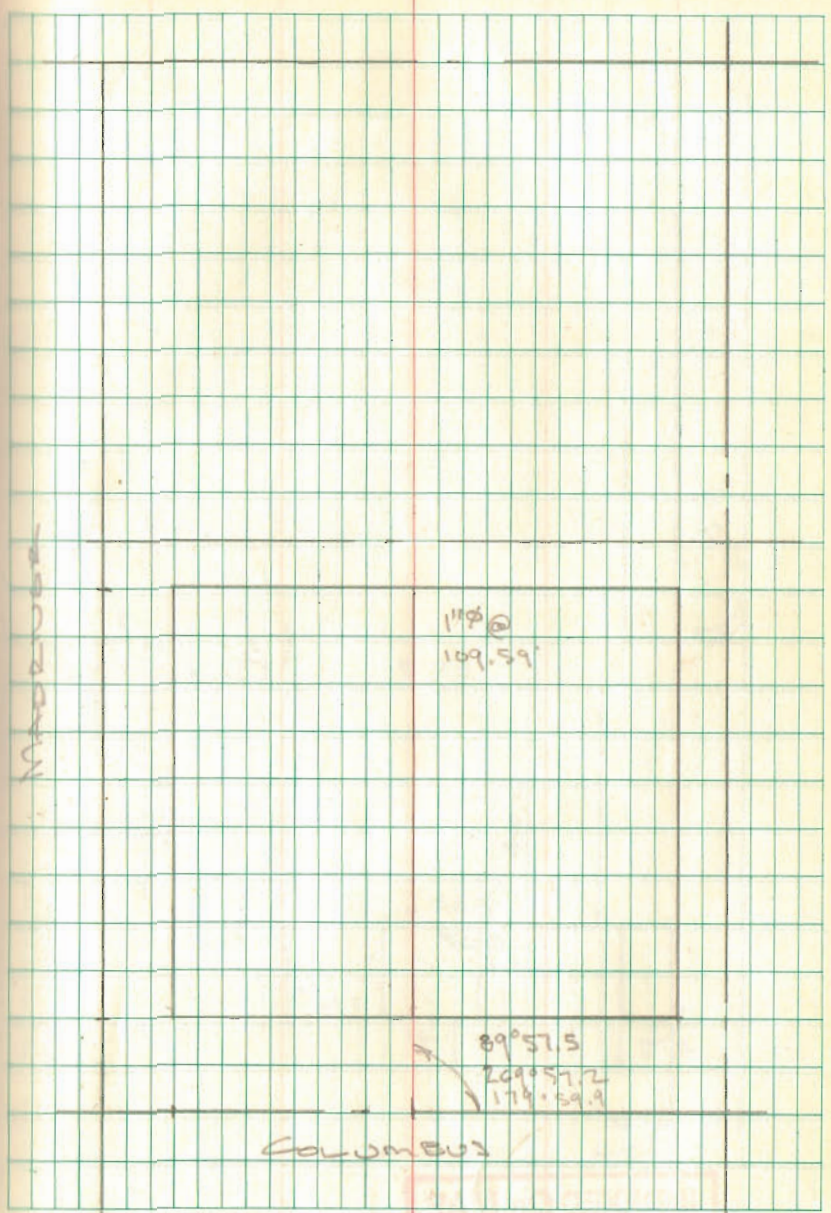

111° 0'
109.59'


ROAD

89° 57.5'
179.59.9

COLUMBUS

INDEXED ON MAP
2468

INDEXED ON MAP
2468

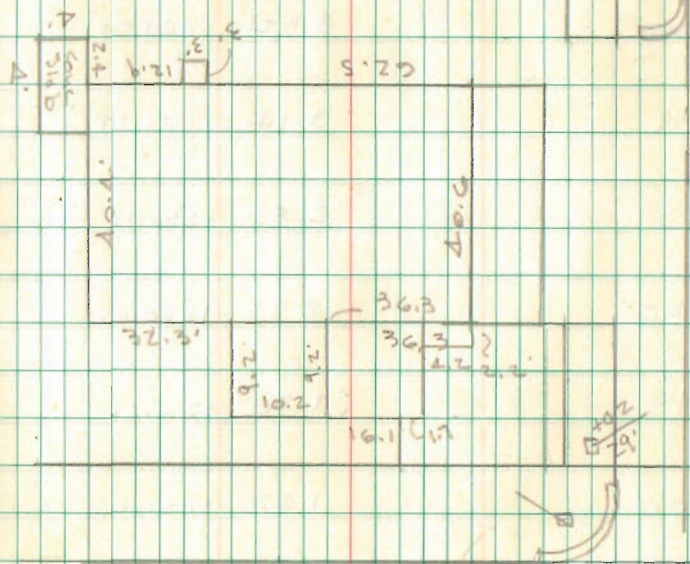

INDEXED ON MAP

2768