
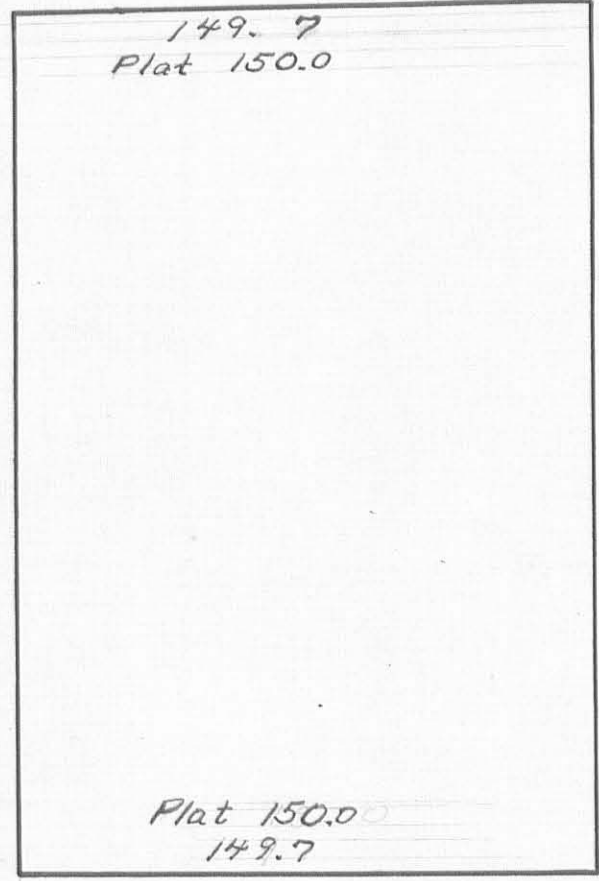


Note:

Albert measured 6.0' short between Florence & Clay.

• Denotes Irons

ALBERT 25.0'

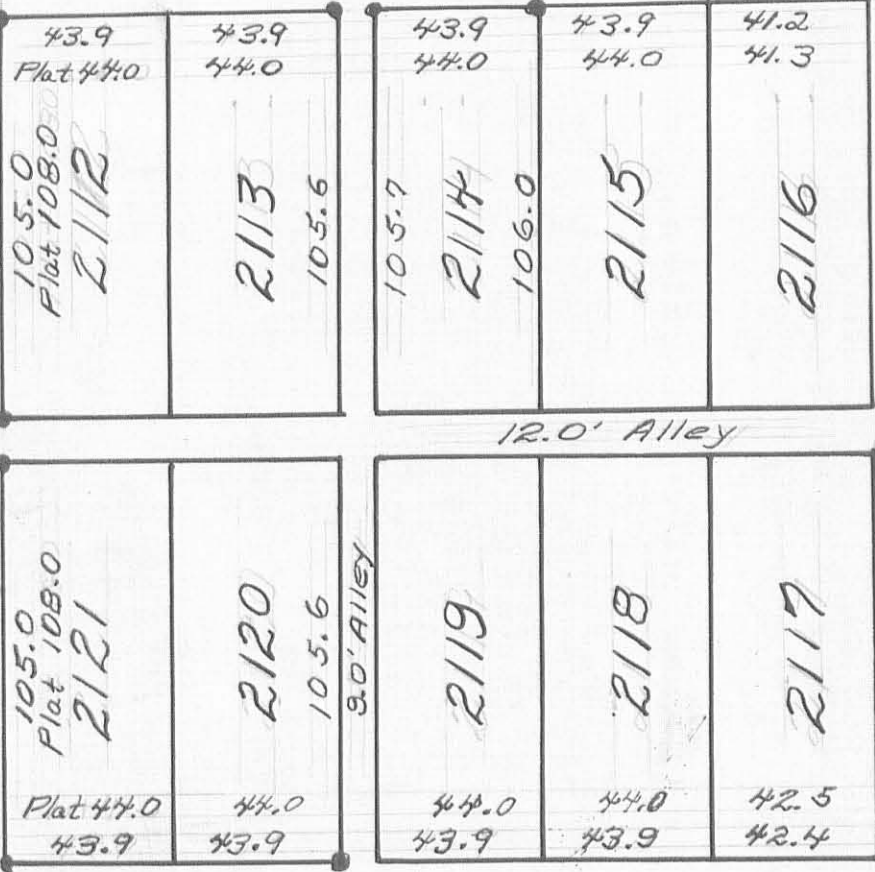

FLORENCE 60'

Measured 421.0

found

CLAY 50'

Measured 422.9

found

283.0

EULCID 60'

Surveyed by O.K. Shirk



INDEXED ON MAP
2522 1P