

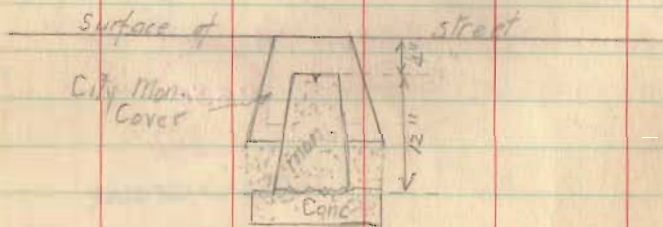
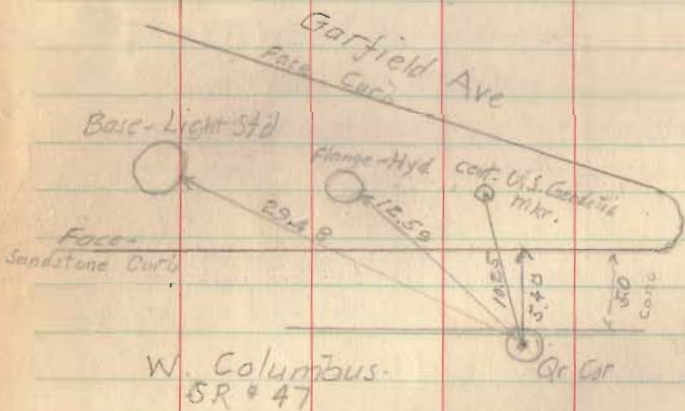


Sept 22/43 - Dailey
Dyess
Burnell
Kraig

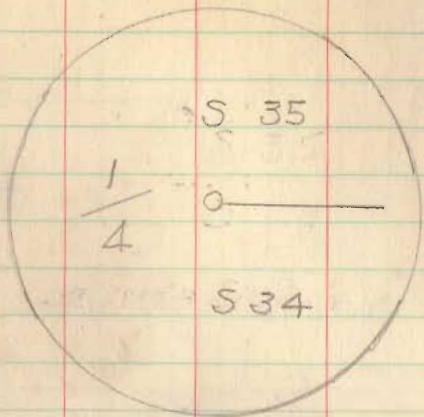

T4R14
1/4 S-35
S-34
Elm and Columbus - Bellef.

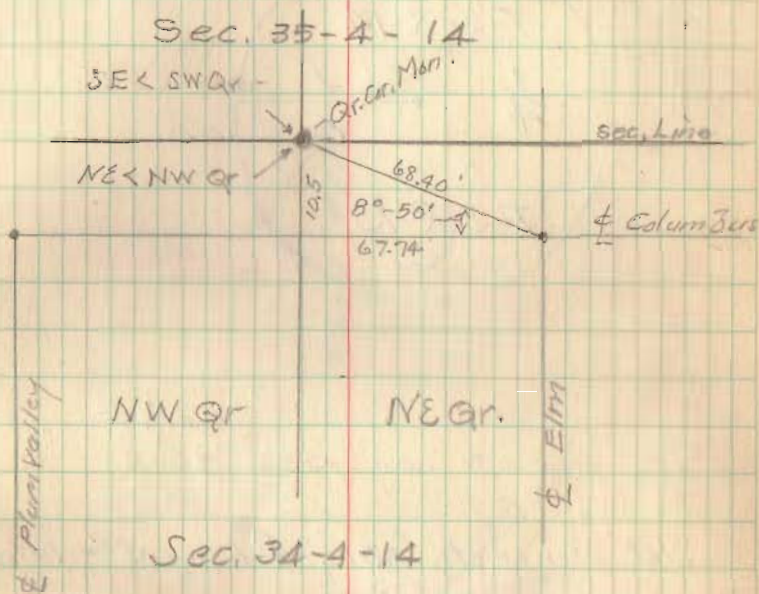

INDEXED ON MAP

2637

INDEXED ON MAP