


RED 9-14-04 DMK

MEADOW BROOK DRIVE - 50'



Scale: 1" = 20'

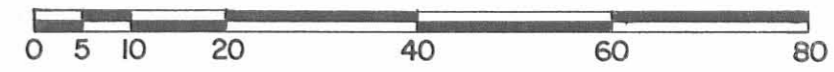

SYMBOLS:

- ⊙ - 1" Iron Pipes Fd.
- - 5/8" x 30" Rebars Set.

REFERENCE:
CLAPSADDLE ALLOTMENT.
Plat Cabinet A, Slide 359 (9-27-1957)

BRUCE-TAYLOR SURVEY, Part of Lots No. 4062 and 4063,
Clapsaddle Allotment, City of Bellefontaine,
Lake Township, Logan County, Ohio.

SCALE: 1" = 20'	APPROVED BY:	DRAWN BY DEG
DATE: 9-11-2004		REVISED


Daniel E. Gilbert

Daniel E. Gilbert, P.S.
Reg. Sur. No. 5402

DRAWING NUMBER
2004-034

INDEXED ON MAP
3029 1P

MEADOWBROOK DR.

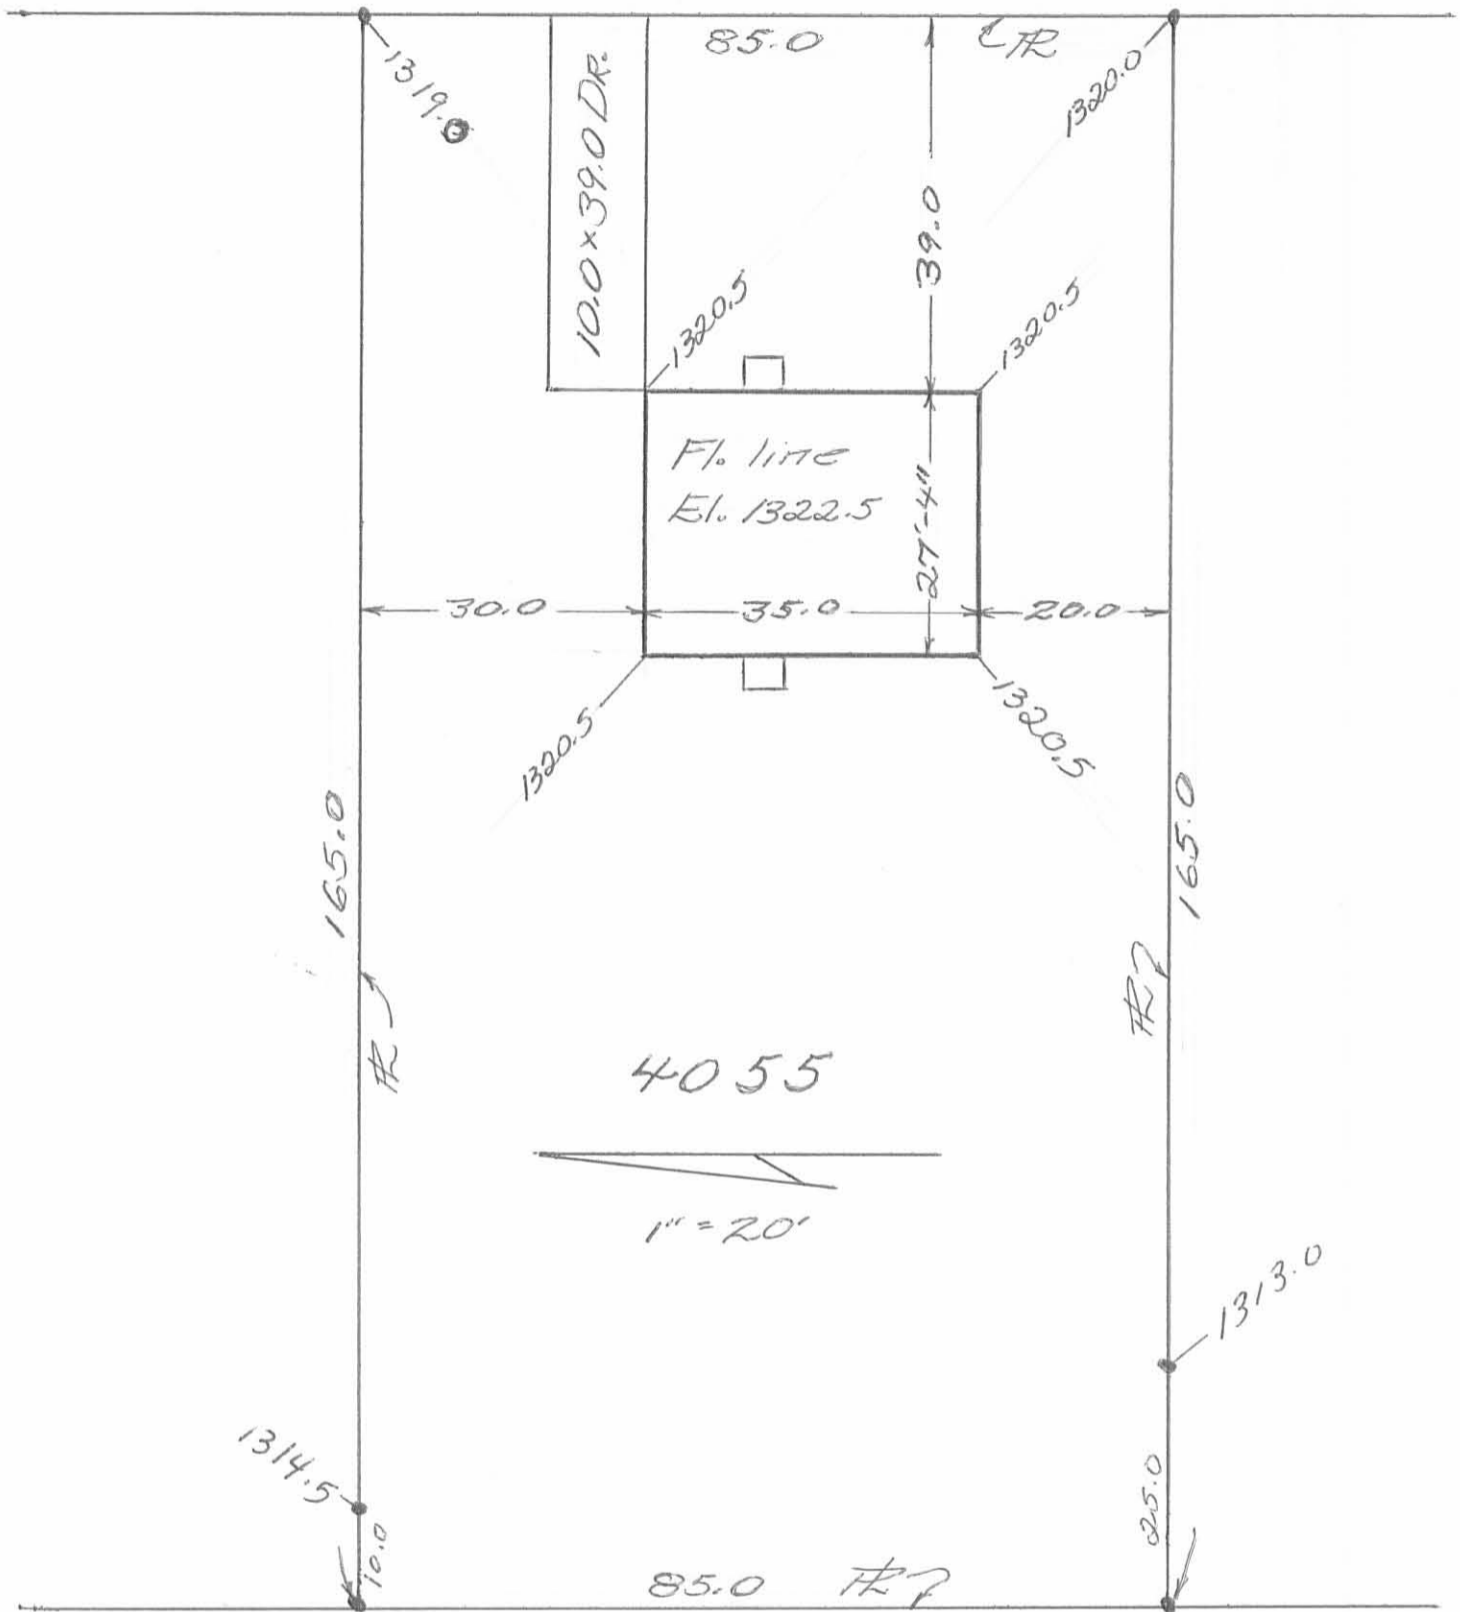

City: Bellefontaine
 Township: Lake
 County: Logan
 State: Ohio
 Plat Name: Clapsaddle Allotment
 Plat Lot: 4055
 Plat Book: Volume 4
 Page: 48

I certify that this survey shows the house as located on the premises described; that the house is entirely within the lot lines and there are no encroachments upon the premises described, by the adjoining premises.


Owen K. Shirk

Owen K. Shirk
 Surveyor 4271

INDEXED ON MAP
 3029 3P

1" = 20'

LOT 4059

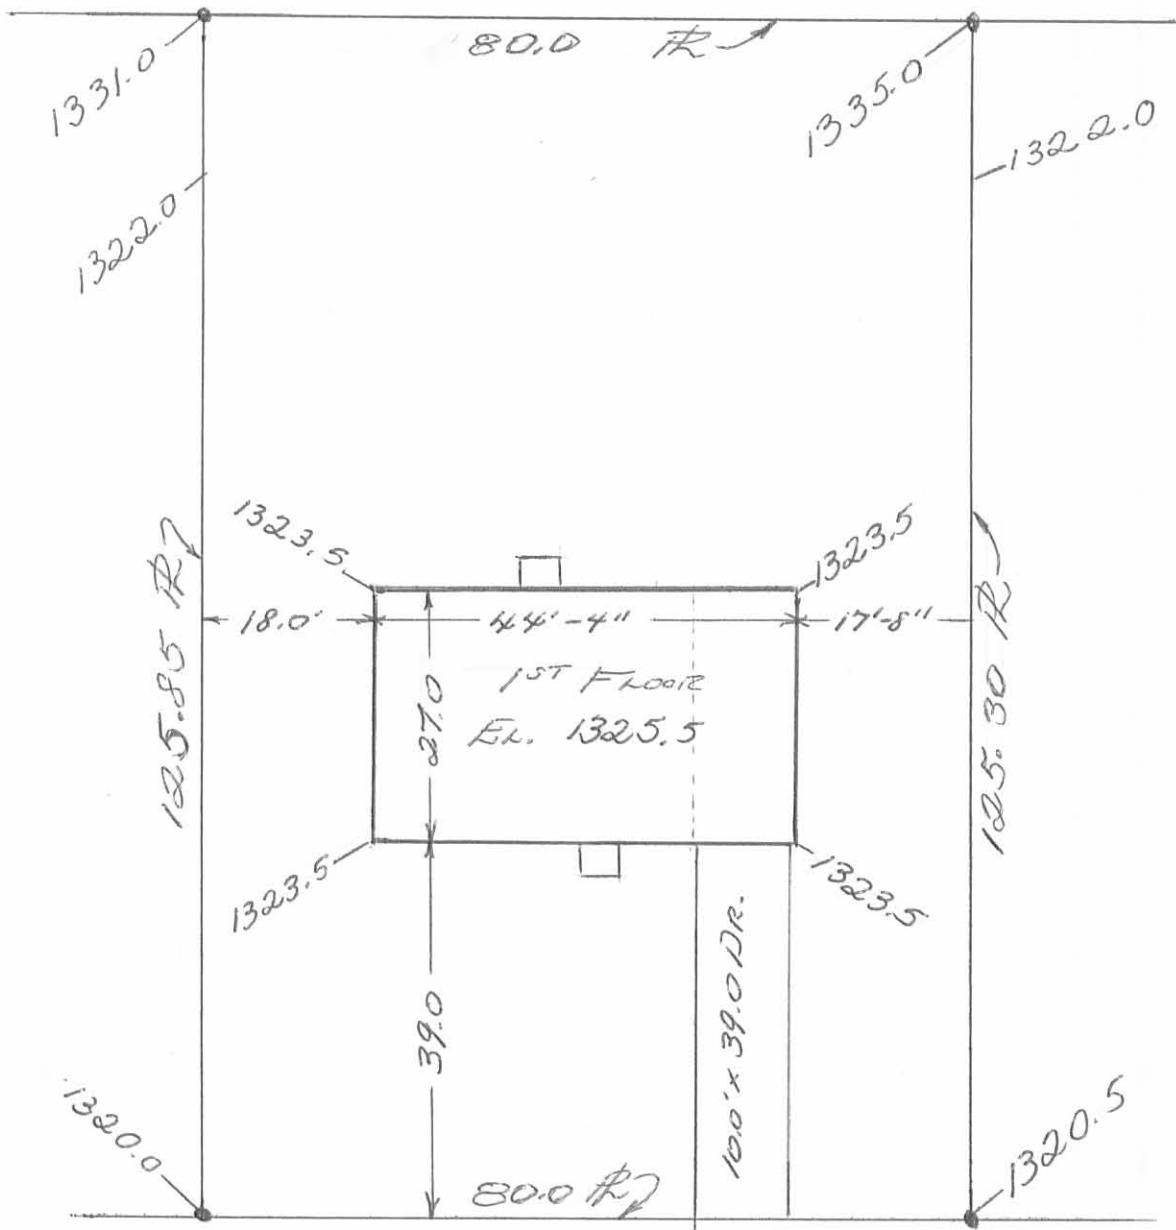

MEADOWBROOK DR.

City: Bellefontaine

Township: Lake

County: Logan

State: Ohio

Plat Name: Clapsaddle Allotment

Plat Lot: 4059

Plat Book: Volume 4

Page: 48


I certify that this survey shows the house as located on the premises described; that the house is entirely within the lot lines and there are no encroachments upon the premises described, by the adjoining premises.

Owen K. Shirk

Owen K. Shirk
Surveyor 4271

INDEXED ON MAP
3029 4P

MEADOWBROOK DR.

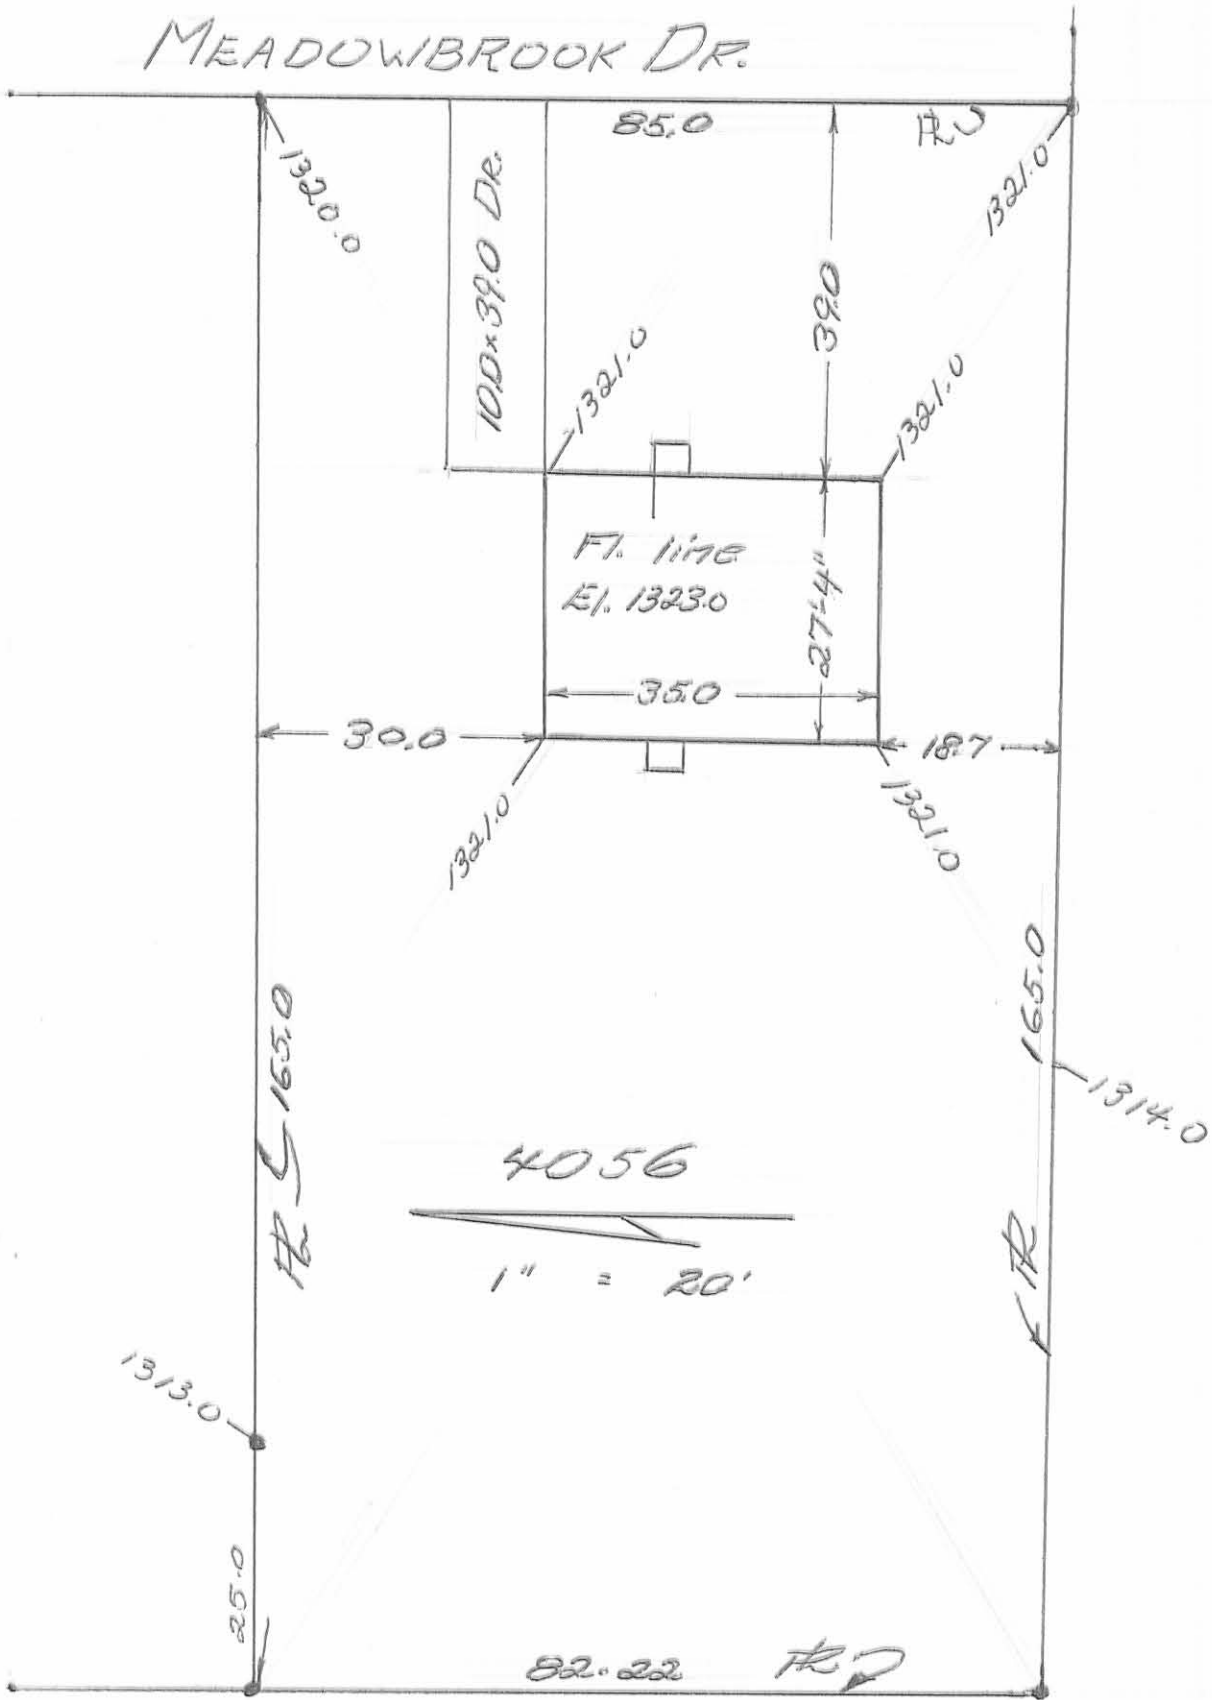

City: Bellefontaine
 Township: Lake
 County: Logan
 State: Ohio
 Plat Name: Clapsaddle Allotment
 Plat Lot: 4056
 Plat Book: Volume 4
 Page: 48

I certify that this survey shows the house as located on the premises described; that the house is entirely within the lot lines and there are no encroachments upon the premises described, by the adjoining premises.

Owen K. Shirk
 Owen K. Shirk
 Surveyor 4271

INDEXED ON MAP
 3029 5P