


REV'D 3-20-06 SMM/AL


CURVE	DELTA ANGLE	RADIUS	ARC LENGTH	TANGENT	CHORD LENGTH	CHORD BEARING
C1	03°46'47"	470.00'	31.01'	15.51'	31.00'	N 88°13'48" W

LEGEND

- 5/8 INCH IRON ROD SET
- 3/4 INCH IRON PIPE FOUND

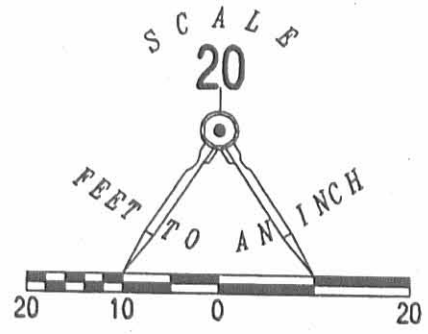

SUPERIOR AVENUE (50 FEET WIDE)

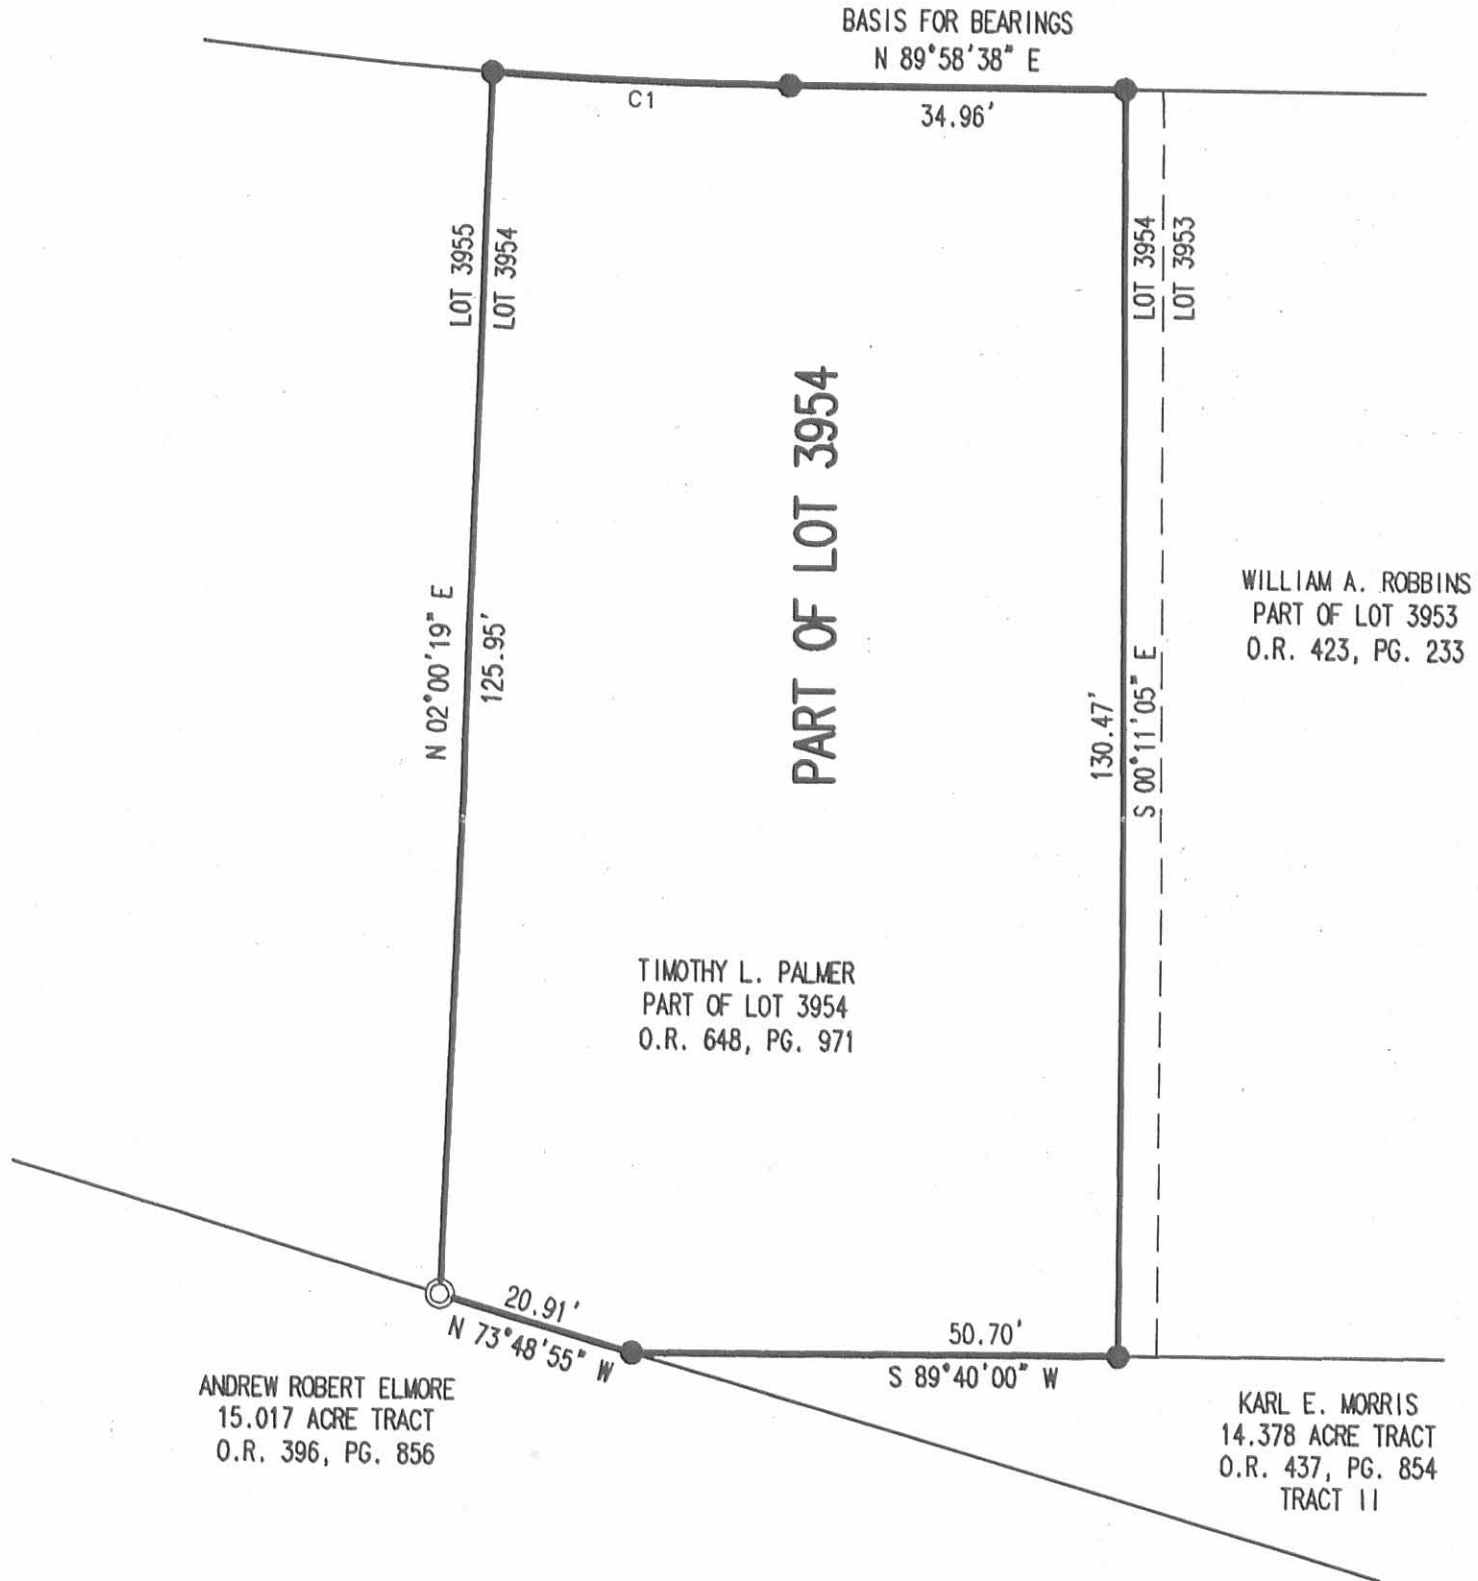

A RETRACEMENT SURVEY OF  
 PART OF LOT 3954  
 LAKE HEIGHTS ALLOTMENT # 2  
 PLAT CABINET A, SLIDE 341  
 CITY OF BELLEFONTAINE  
 LAKE TOWNSHIP  
 LOGAN COUNTY, OHIO

2 WORKING DAYS  
**BEFORE YOU DIG**  
 CALL TOLL FREE **800-362-2764**  
 OHIO UTILITIES PROTECTION SERVICE



SURVEYED BY:  
  
 JEFFREY I. LEE  
 PROFESSIONAL SURVEYOR 6359  
 MARCH 23, 2006

COPYRIGHT 2006 BY:  
**LEE SURVEYING & MAPPING CO., INC.**  
 117 North Madriver Street  
 BELLEFONTAINE, OHIO 43311  
 (937) 593-7335

INDEXED ON MAP  
 3423 IP

ADW D0206 4194026 L-4194026-3