

114

113

Tile Block Garage

Stone & Brick Office Bldg.


16 1/2' ALLEY

MAIN ST. 80'

BENCH MARKS
 U.S.G.S. Sea level datum Used.
 BM - S.E. cor. of top step, office entrance @ S.E. cor. lot 113. Elev. 1246.51
 BM Center of Cable M.H. cover @ S.W. cor. lot 113. Elev. 1242.01


SURVEY OF
LOT 113
 BELLEFONTAINE, OHIO
 FOR
 THE UNITED TELEPHONE CO.
 1962
 SCALE 1" = 10'

SURVEYED BY: Don E. Dodson
 REG. SURVEYOR 4270
 FEBRUARY, 1962

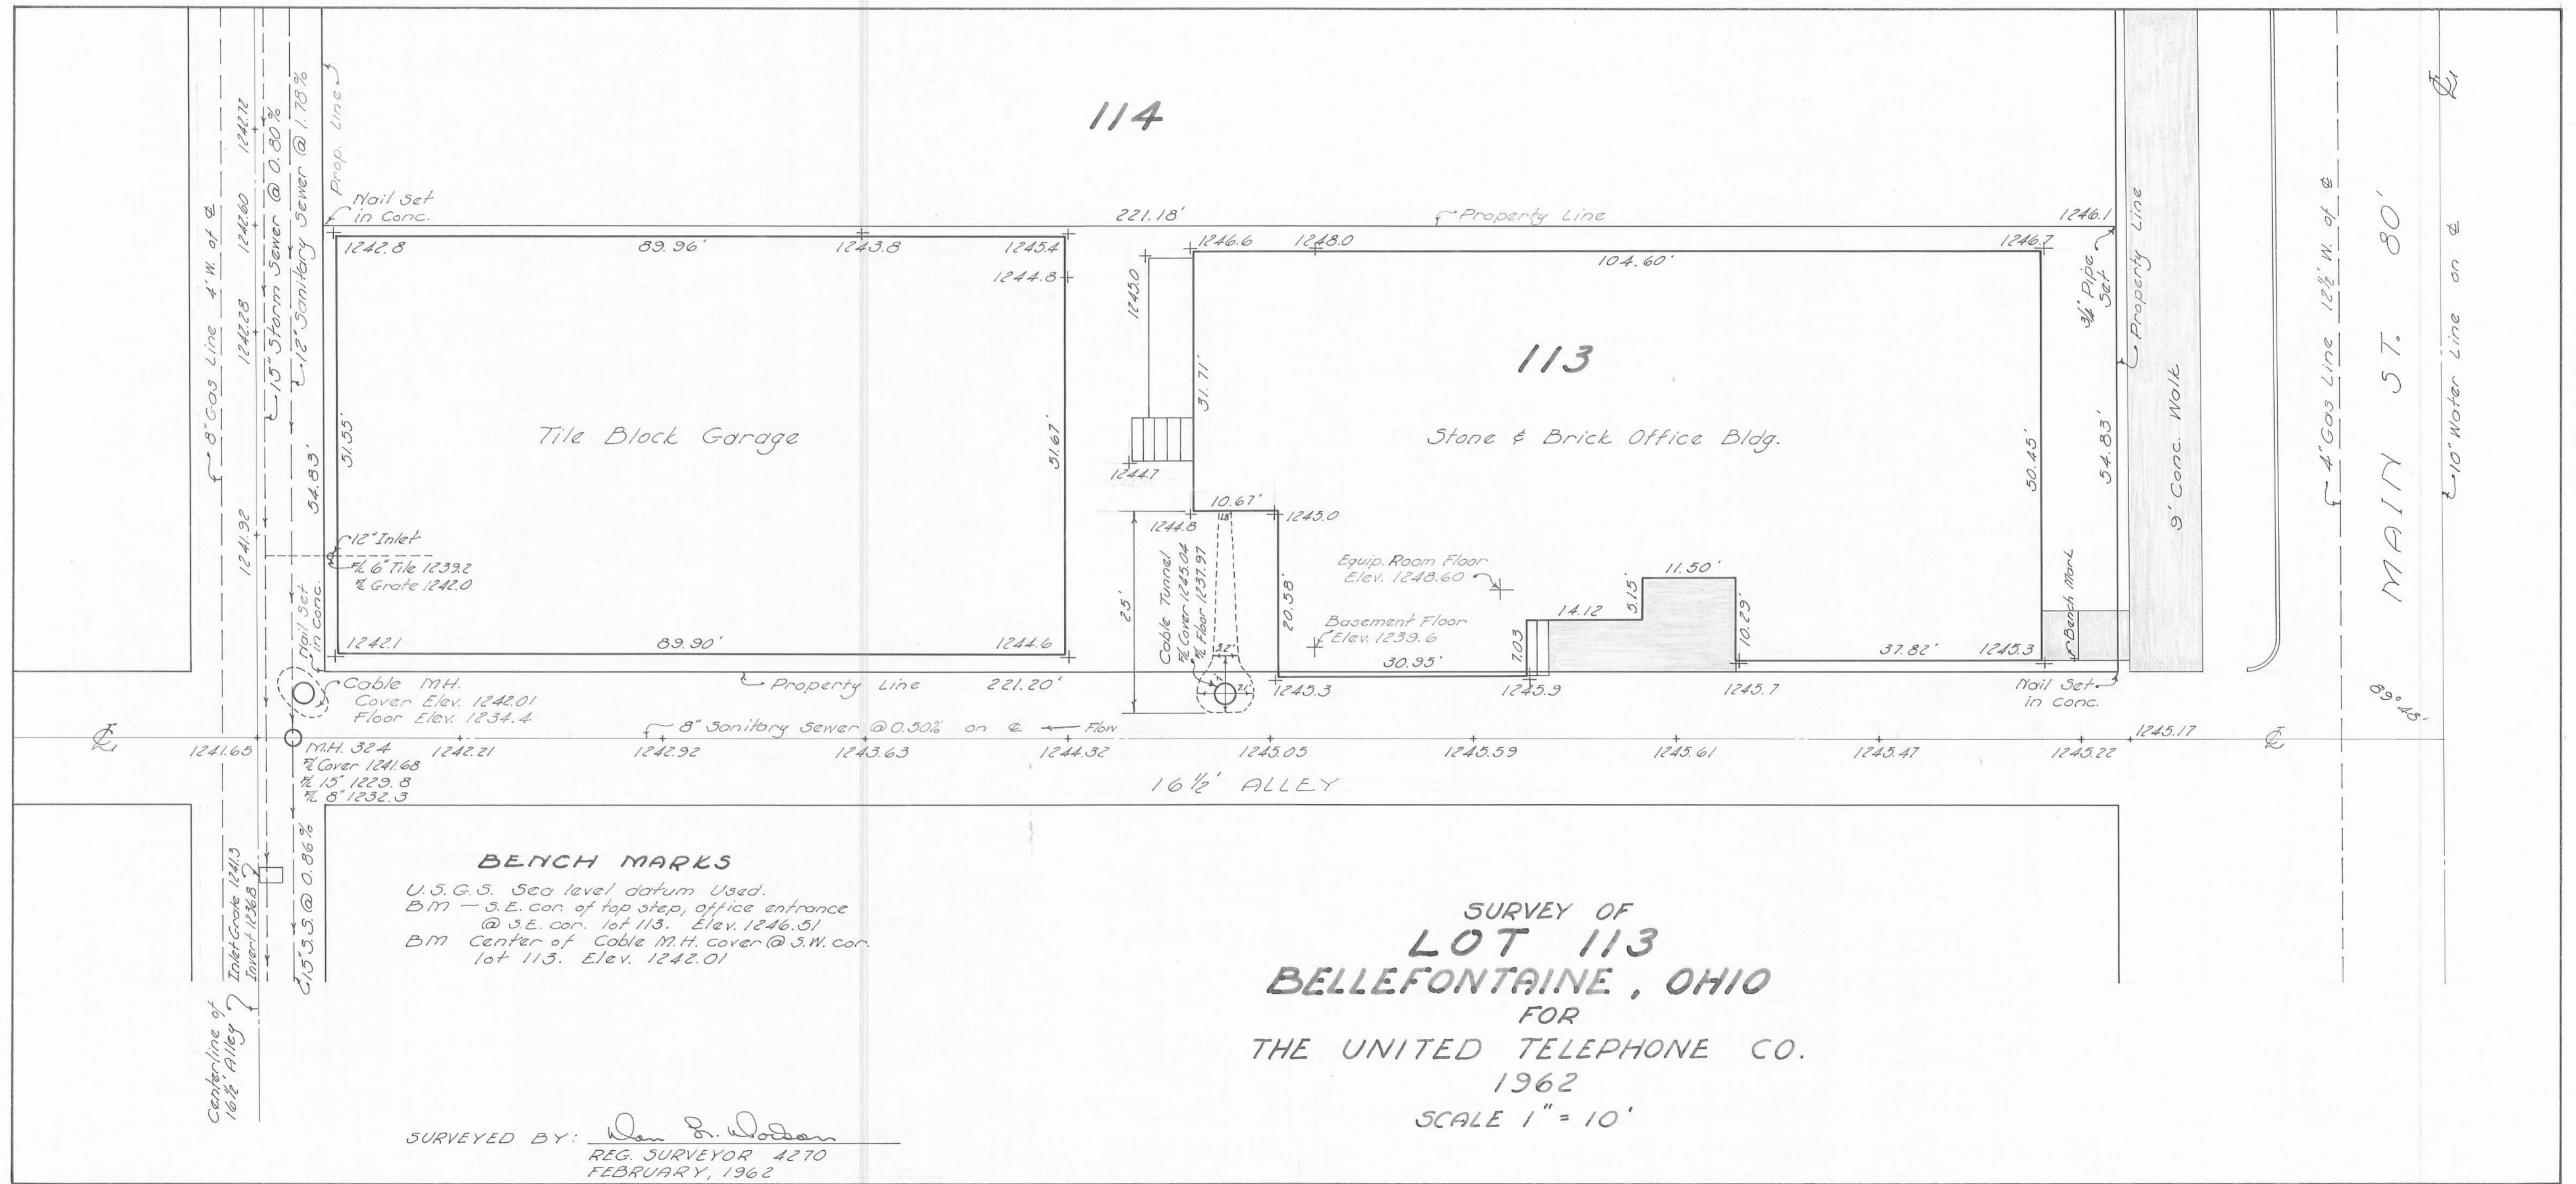

UNITED TELEPHONE CO. SURVEY
 LOT 113
 BELLEFONTAINE, OHIO

o = P-K Nail Set, unless otherwise indicated

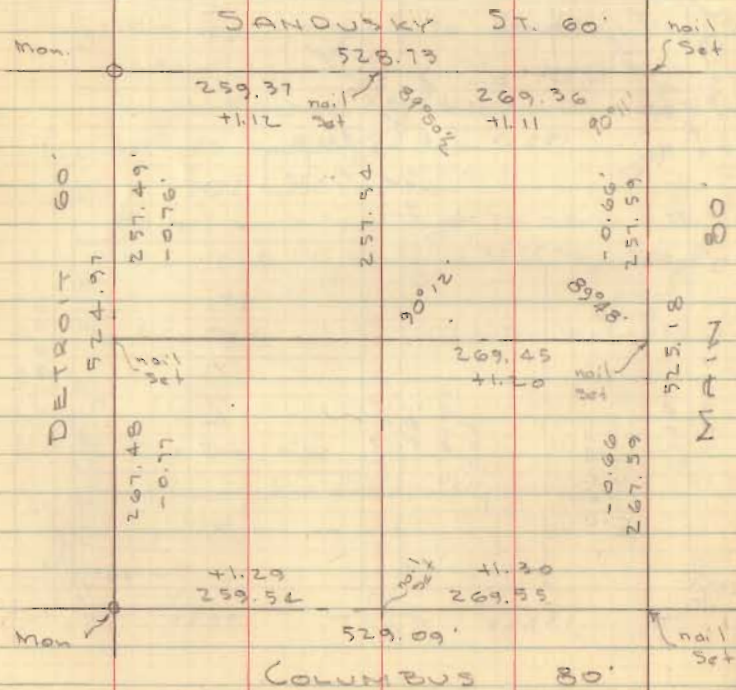


53.28
 8.55
 64.73

Dodson Geo. C. Lewis

Feb. 12, 1962

22

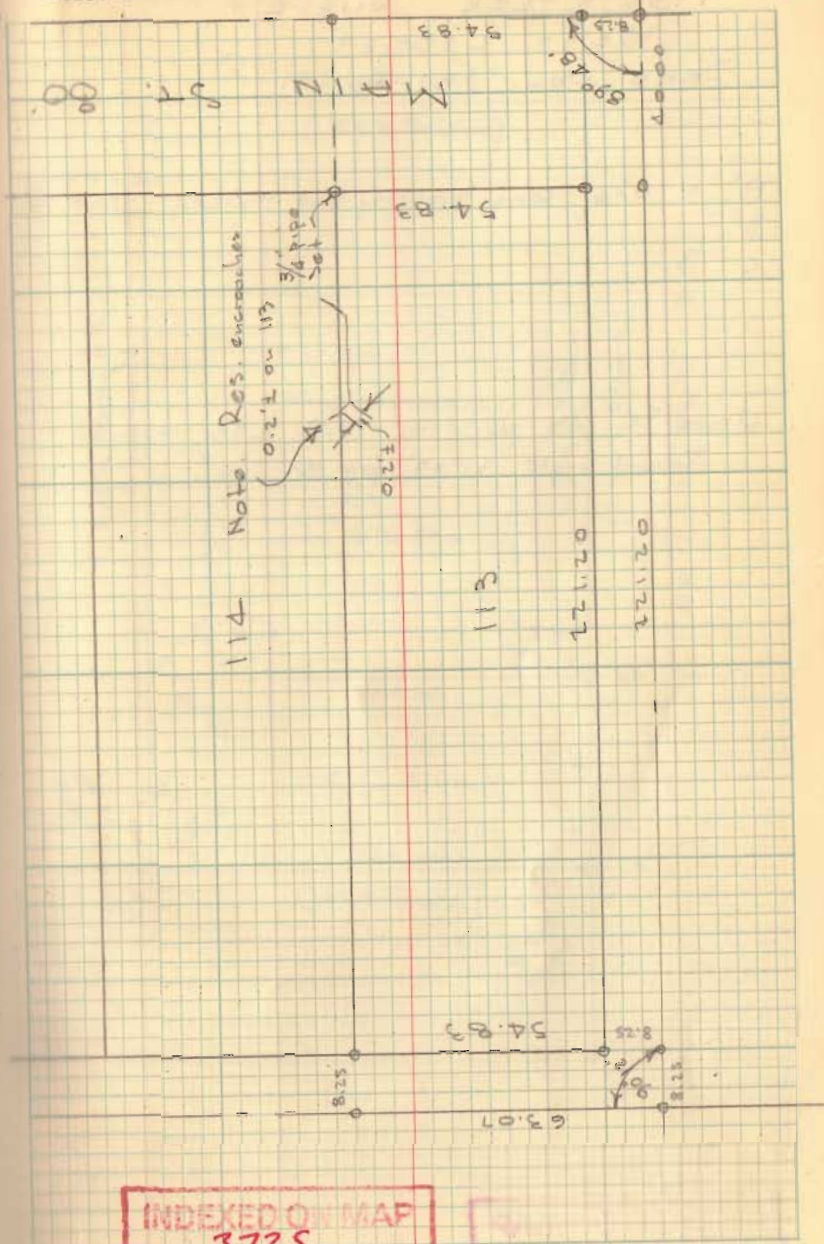

INDEXED ON MAP
 3725

On	From	To	Moos	Plot	
Main	Sandusky	Columbus	525.18	526.5	-1.32
Sandusky	Detroit	Main	528.73	526.5	+2.23
Columbus	Main	Detroit	529.09	526.5	+2.59
Detroit	Sand.	Col.	524.97	526.5	-1.53

BK 4/22

54.82
8.25
63.07

165
4) 66
4
26
26

220
8.25
258.25
297.52
4) 71 15
4
3

55.00
10
54.82
8.25
63.07

INDEXED ON MAP
3725

529.09
26.50
2.59

1.30

220
8.25
268.25
1.30
269.55

258.25

259.37

220
30
8.25
258.25

220
88.25

258.25

257.49

440

10

16 1/2

526.50

525.18

1.32 66

12

12

220

40

8.25

268.25

1.12


269.37


528.73

526.50

2.23

1.12

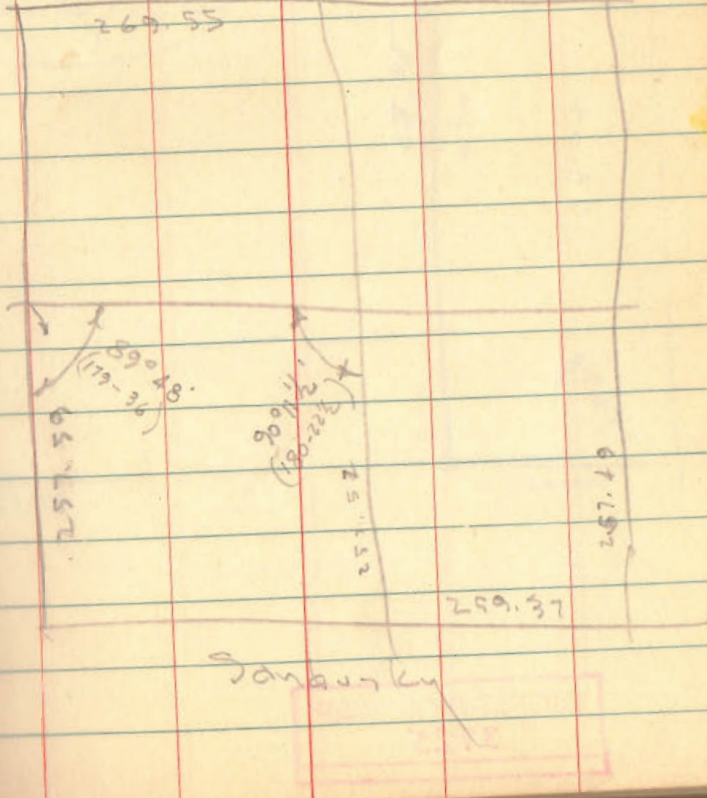

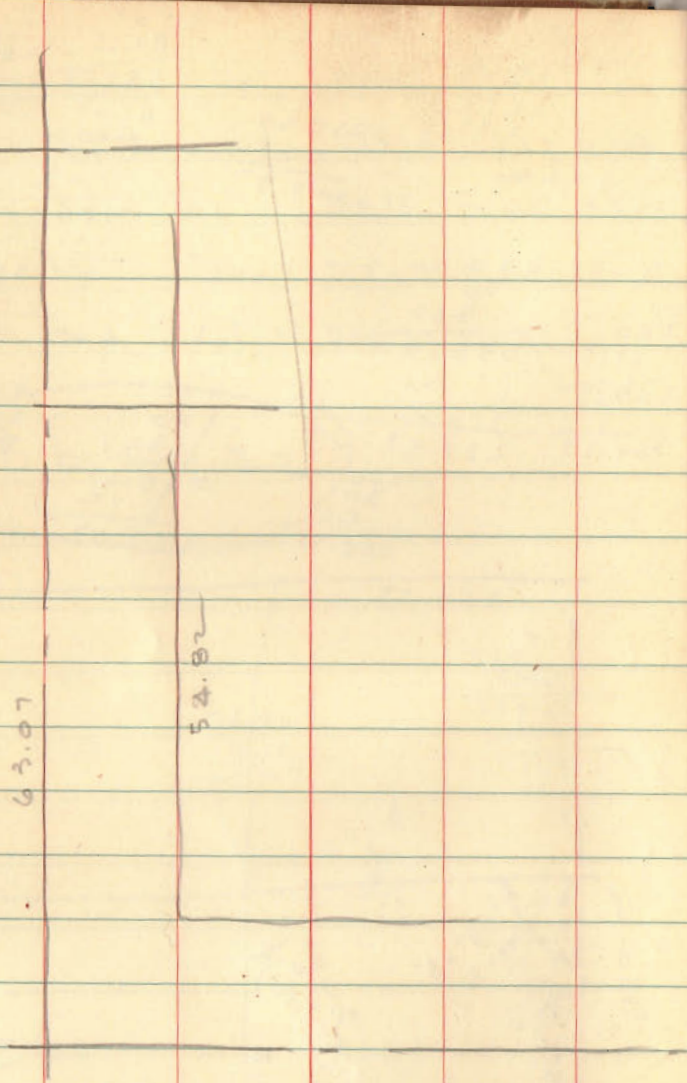

INDEXED ON MAP
3725


Dodson Touris
Geoslin Life

2/12/62
32°

10

6 hrs
lunch \$3.35

Bk 4/22

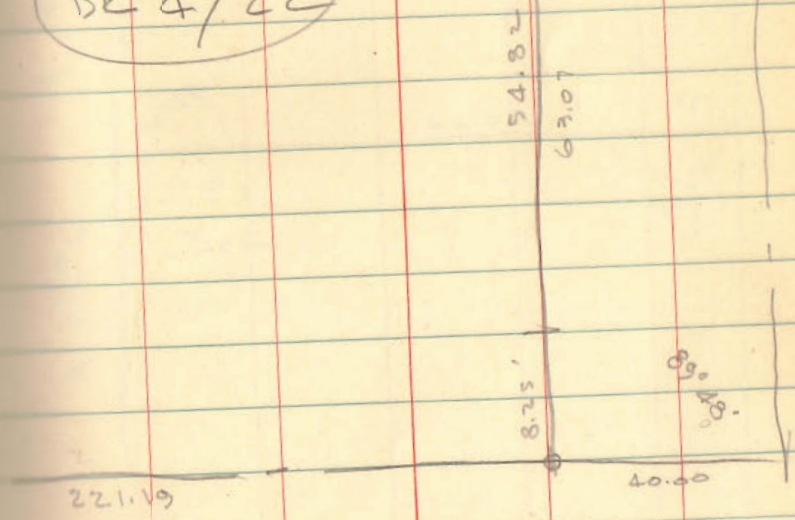

INDEXED ON MAP
3725