


PART LOTS 360-361  
BELLEFONTAINE, OHIO

October 24, 1964

The following described real estate situated in the City of Bellefontaine, Lake Township, Logan County, Ohio and being part of Lots 360 and 361 as shown on Logan County Recorder's Plat Book A, Volume 1, Page 8 and more particularly described as follows:

Beginning at an iron bar at the northeast corner of said lot 360; thence with the east line of said lot, S. 0°01 E. 85.00 feet to an iron bar; thence N. 89°37' W. 4.00 feet to an iron bar; thence S. 0°01 E. 9.00 feet to an iron bar; thence N. 89°37' W. 96.38 feet to an iron bar in the west line of lot 361, and in the east line of a 16½ foot alley, passing the east line of lot 361 at 46.19 feet; thence with the west line of said lot 361 and the east line of said alley, North 94.00 feet to an iron bar at the northwest corner of said lot 361 and in the south line of a 16½ foot alley; thence with the south line of said alley, S. 89°37' E. 100.36 feet to the place of beginning, passing the northeast corner of lot 361 at 50.18 feet.

INDEXED ON MAP  
3796 1D

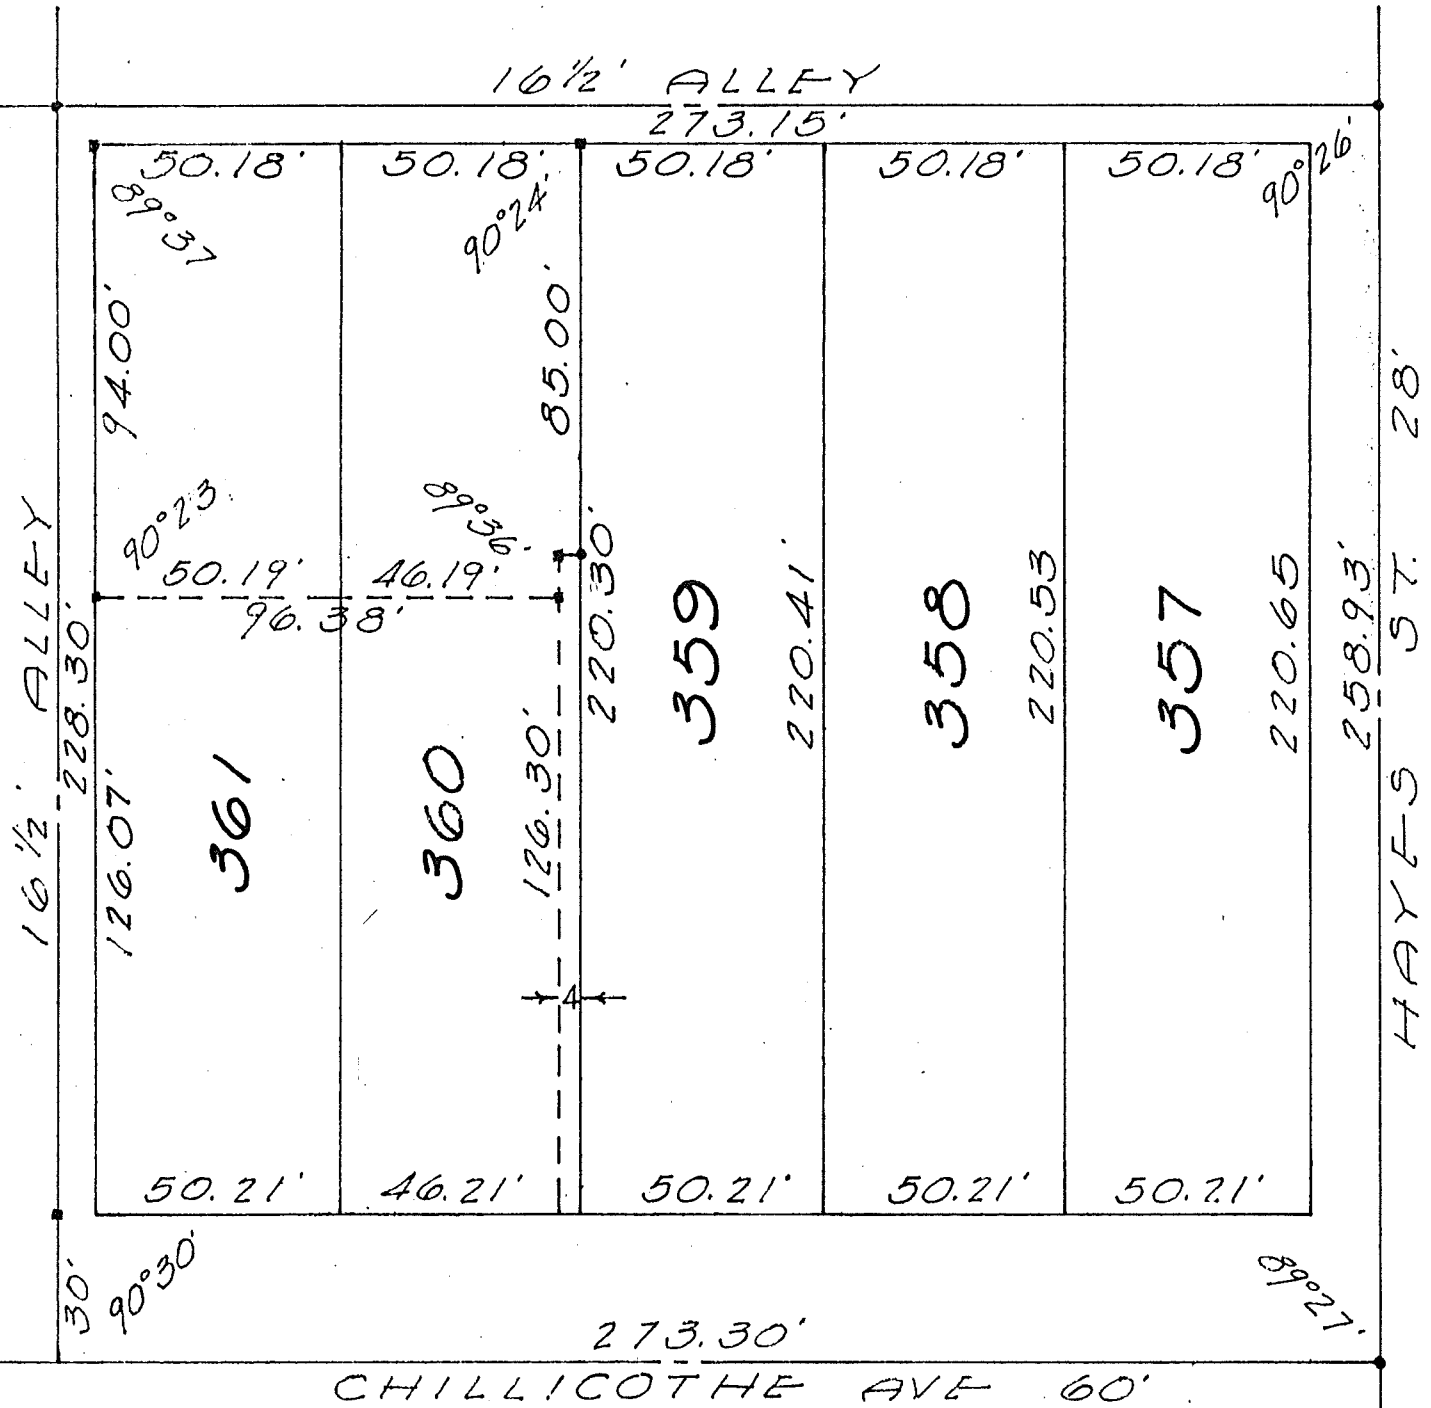

SURVEY OF  
 PT. LOTS 360-361  
 BELLEFONTAINE, OHIO  
 OCT. 24, 1964  
 SCALE 1"=40'

REFERENCE:  
 Eastern Bellefontaine  
 Plat Bl. A, Vol. 1, Pg. 8  
 City Eng. F.B. #258  
 Pgs. 9 & 42

INDEXED ON MAP  
 3796

*Dan L. Dodson*  
 Dan L. Dodson  
 Reg. Surveyor 4270  
 Bellefontaine, Ohio





