



Enderline
Montgomery
Wright
Smucker

Location of Iron Rush Ave.

INDEXED ON MAP

4446

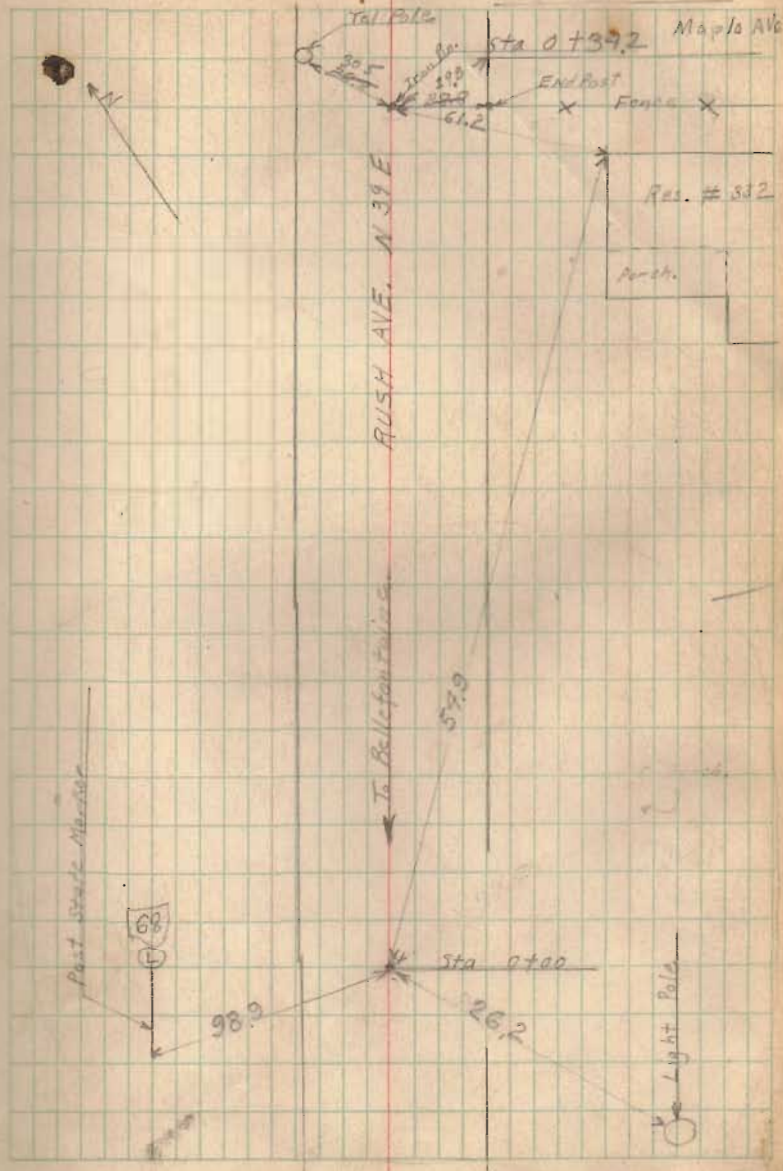

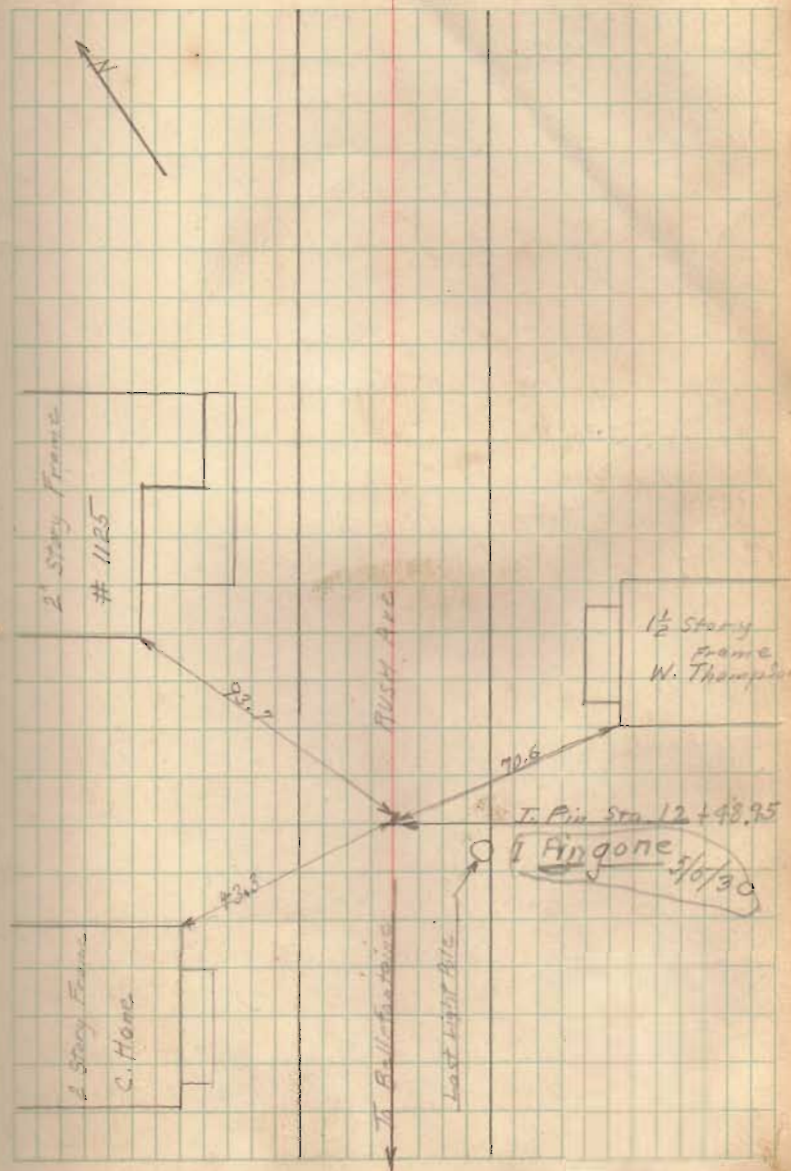

134405

6+00 9.4 1339.65


7+00 1.9 1342.15

T.P. 0.21 1343.84
 9/13
 1353.02

8+00 8.8 1344.22

9+00 7.9 1346.02

10+00 5.3 1347.72

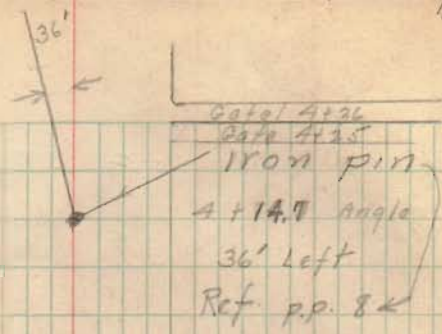


3+73 Drive

3+68.0
 Land Line


Drive 3+61

← 44.7 →

25. 3+49

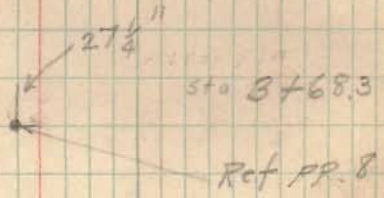

Land Line 3+26.6 231

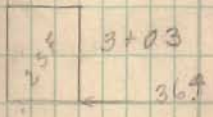

Land Line

2+66.3

← 28.1 →

1353.02

42 1348.32

57 1347.32

64736
Land Line

Drive 54785

5-51

Gate 5431
Fire Hydrant

54185 ~~52225~~

4475
Land Line ?




1353.02


11+00	6.2	1347.82
Cement Side work		
12+00	5.2	1347.32
Top tile 12+10	6.26	1346.66
12+00	4.9	1348.12
12+50 12 tile 4"	5.63	1347.39
Cement Work 12+25	5.6	1347.42
SW Cor 12+75	4.23	1348.79
Top tile 13+70	8.11	1344.91
13+00	5.2	1347.82
SE Corner 13+34	4.75	1348.27
Top 6" tile 13+96 Right	9.11	1344.91
14+00	5.6	1347.42
15+00	5.3	1347.72

Land Line

12+614

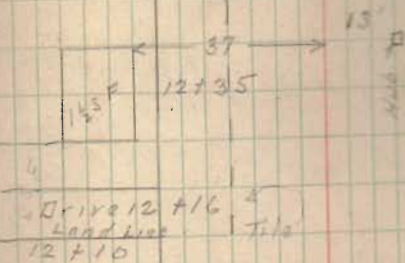

Drive 11+50

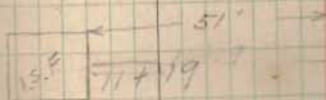10+78
Land Line9+46.5
Land LineDrive 12+55
12+48.25

PO 12+12

References
page 3