

Coon's Description for Lot 2019 and a part of 2020, June, 1971

Being situated in the City of Bellefontaine, and being in Harrison Township, Logan County, Ohio, and being a part of Section 5, Town 3, Range 14.

Being all of City Lot 2019 and the west 24.4 feet of City Lot 2020, and being more particularly described as follows.

Beginning at a iron at the southwest corner of Bellefontaine City Lot 2019.


Thence east 60.59 feet to a iron in the south line of Lot 2020, passing thru the southeast corner of Lot 2019 at 36.19 feet.

Thence north 112.5 feet to a iron in the north line of Lot 2020.


Thence west 60.6 feet to a iron at the northwest corner of Lot 2019, passing thru the northwest corner of Lot 2020 at 24.5 feet.

Thence with the west line of Lot 2019 south 112.5 feet to the place of beginning.

Owen K. Shirk  
Surveyor 427,

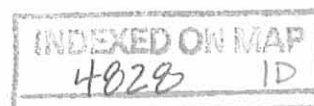

LOT 2019 & a part of LOT 2020  
 BELLEFONTAINE, OHIO

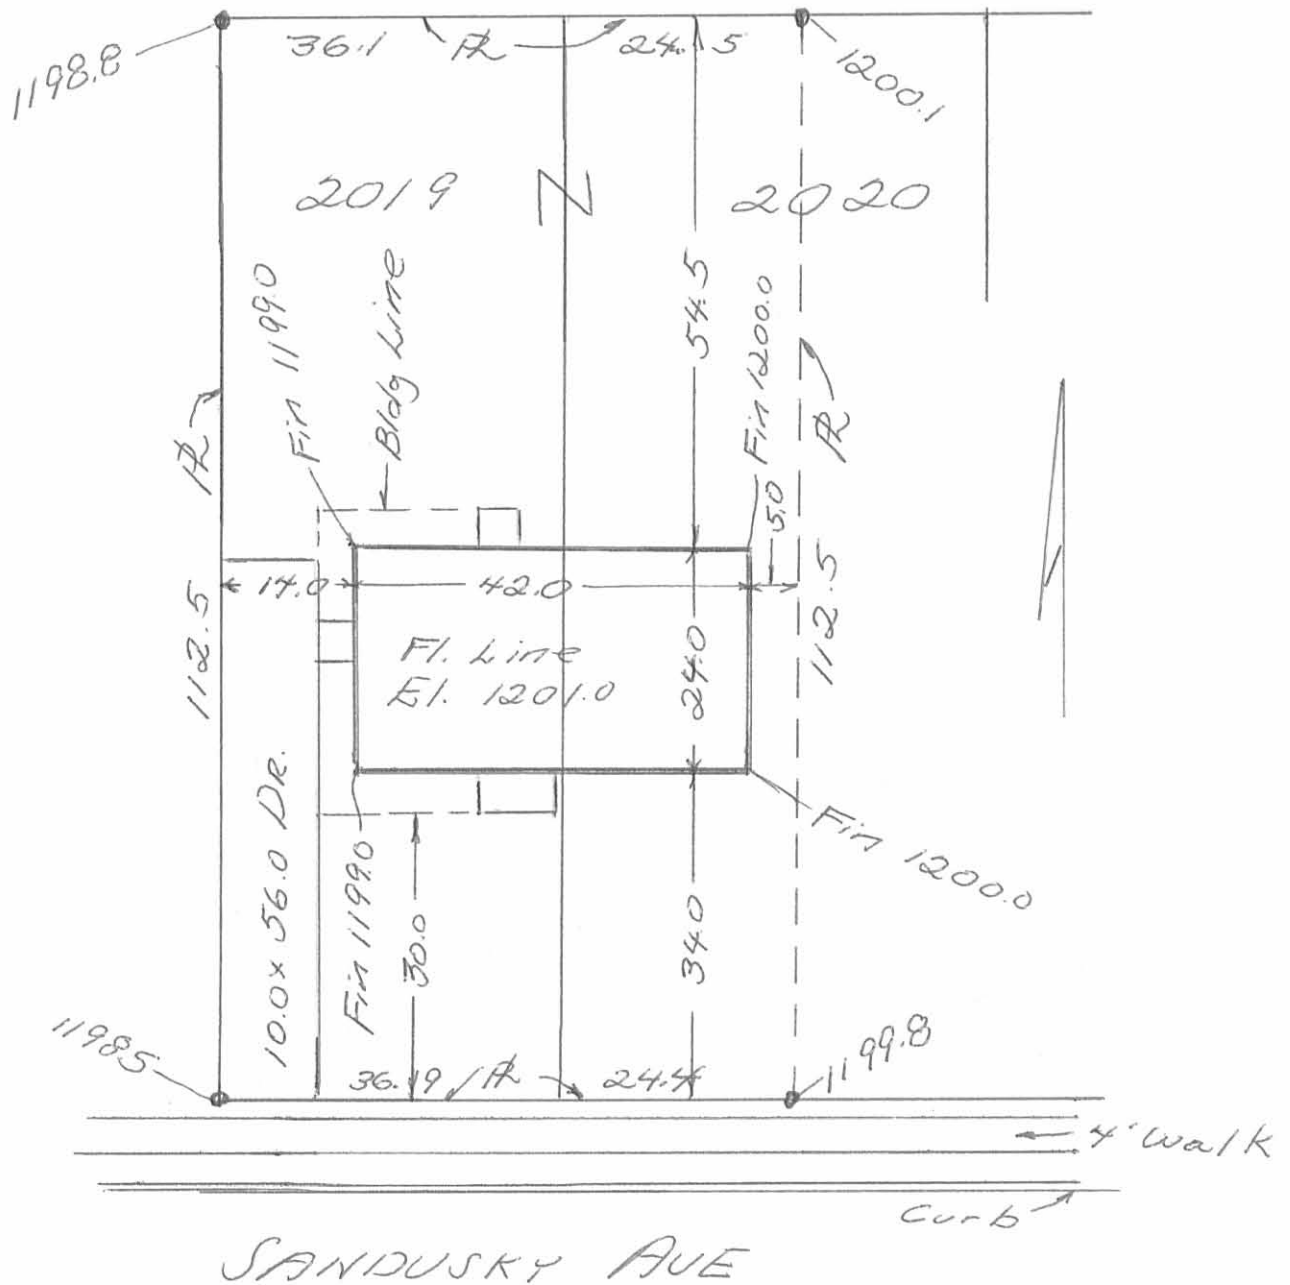

1" = 20'

*Owen K. Shirk*  
 Owen K. Shirk  
 Surveyor 4271  
 Surveyed: 6-10-71

INDEXED ON MAP  
 4028 1P

Coons description-East

Being situated in the City of Bellefontaine, in Harrison Township, Logan County, Ohio; and being a part of Section 5, Town 3, Range 14.

Being all of lot 2021 and the east 18.25 feet of lot 2020 of Woolman-Knight Allotment.

---

Owen K. Shirk  
Surveyor 4271

4828 2P