


NORTH MADRIVER ST. - 60'

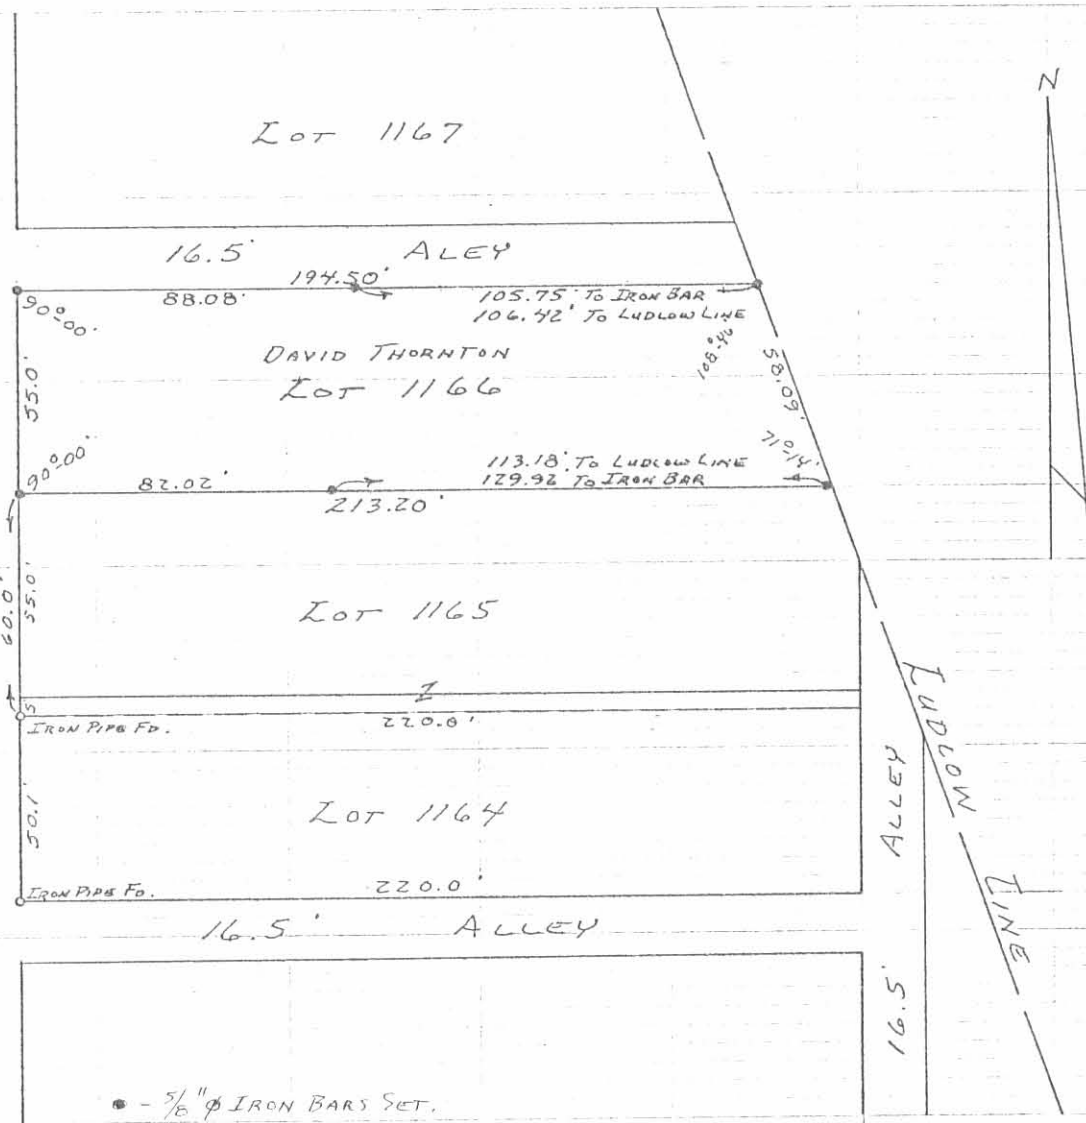

• - 5/8" Ø IRON BARS SET.

5738 1P

INDEXED ON MAP

SURVEYED AND PLATTED BY:
 DANIEL E. GILBERT, P.S.
 REG. SUR. No. 5402
 1041 N. MAIN ST.
 BELLEFONTAINE, OHIO 43311

THORNTON SURVEY
 Lot No. 1166
 524 N. MADRIVER ST.
 CITY OF BELLEFONTAINE
 LAKE TOWNSHIP
 LOGAN COUNTY, OHIO
 SEPTEMBER 14, 1974
 SCALE: 1" = 50'