


PITTMAN SURVEY
BELLEFONTAINE, OHIO

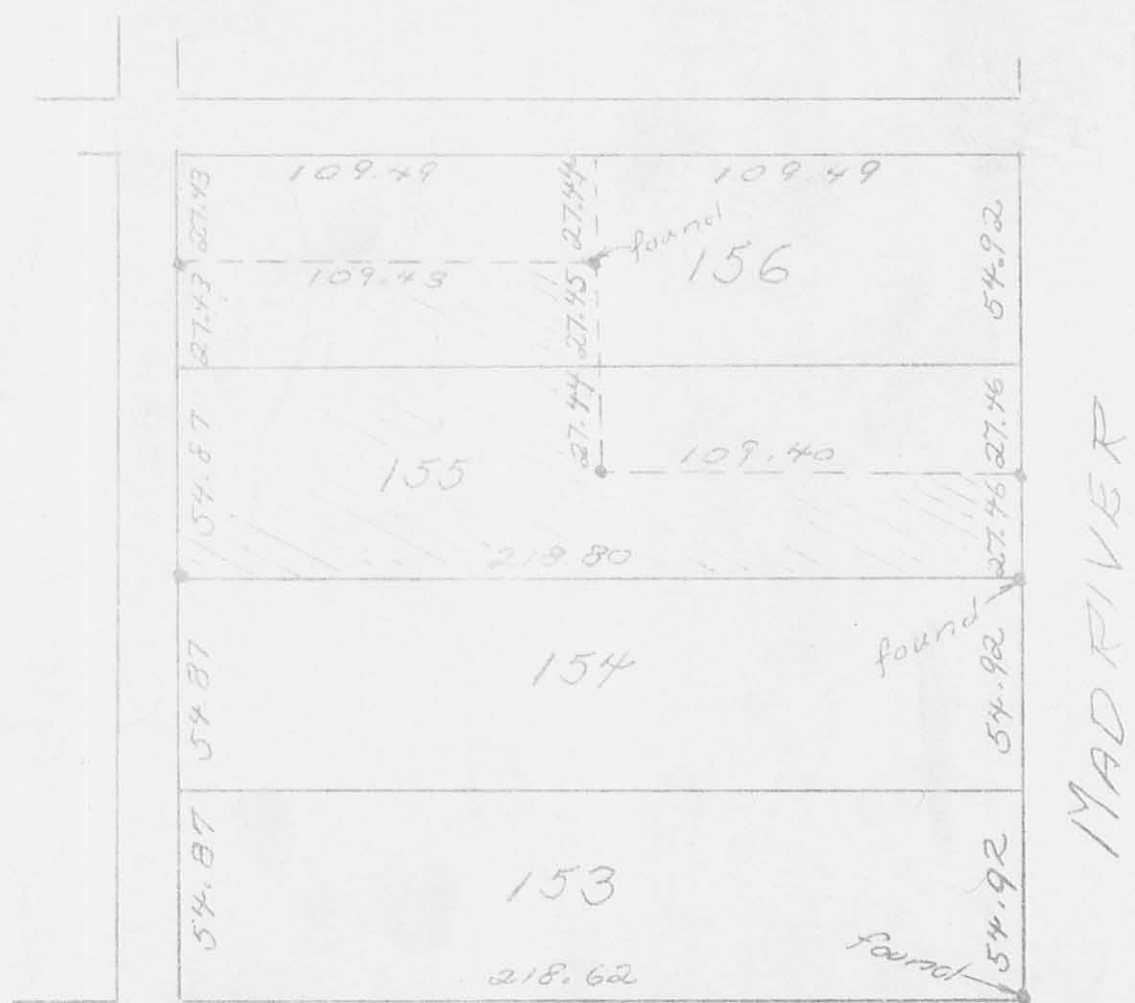

AUBURN

6092 IP

INDEXED ON MAP

Owen K. Shirk
Surveyor 4271