


SEELING SURVEY

LOTS 1300 & 1301 BELLEFONTAINE, O.

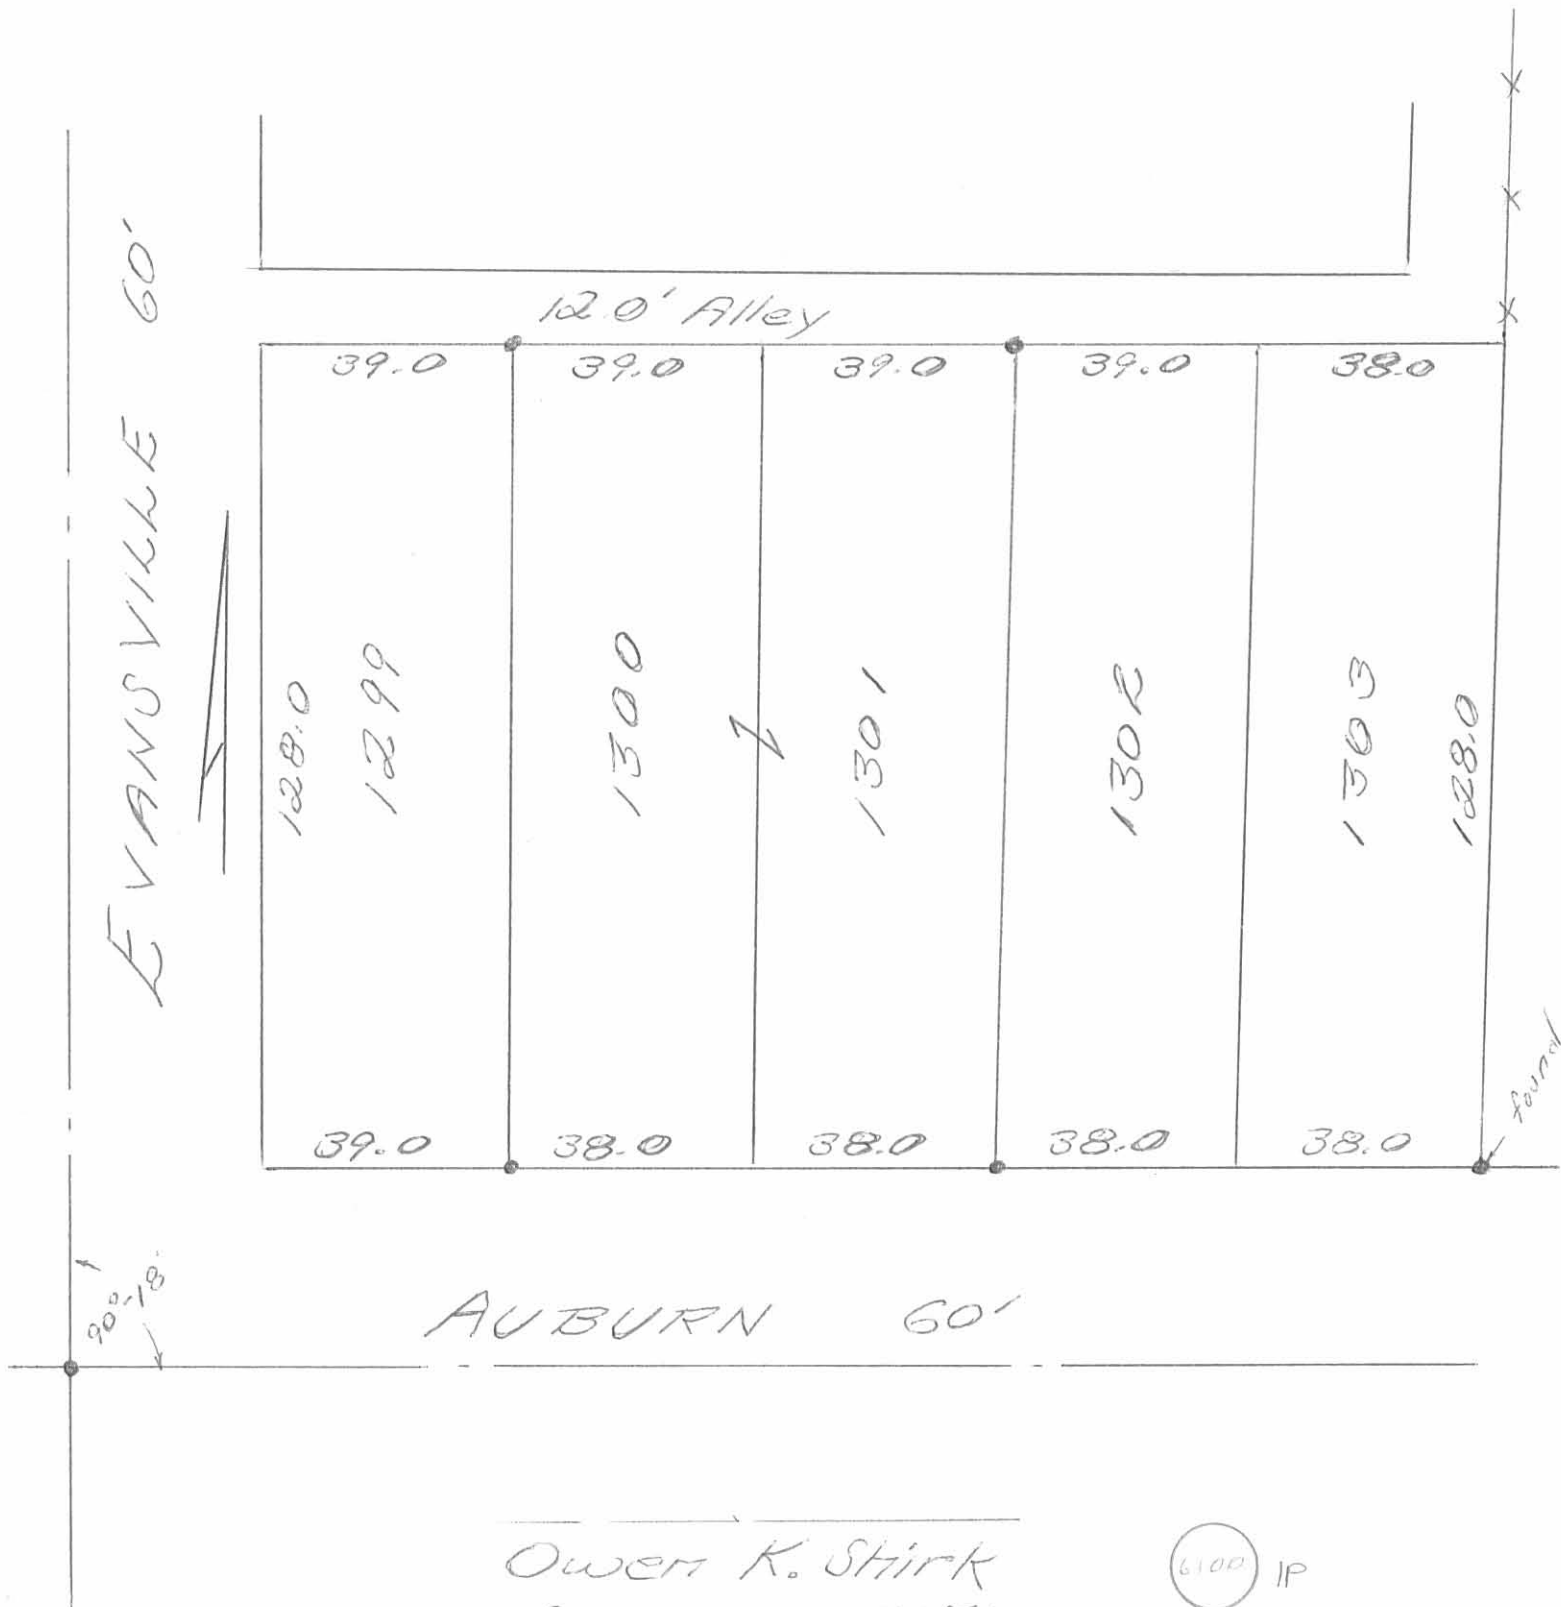

Owen K. Stirk
 Surveyor 4271
 Jan. 18, 1975

(6100) IP

INDEXED ON MAP

McCune

Conway

SURVEYED JAN 19-29 1882

Gibbons

Add.

Ch. 2-14-03.

by J.C. Wanders.

EVANSVILLE

STREET

30x30

30' 36'

30' 30'

FURBURN ST. 60' wide

128	1299	1298	1297	1296	1295	1294	1293	1292	1291	1290	1289	1288	1287	1286	1285
39'	38'	38'	39'	39'	39'	39'	39'	39'	40'	40'	40'	40'	40'	41'	41'
ALLEY 12' wide		ALLEY 12' wide		ALLEY 15' wide		ALLEY 12' wide		ALLEY 12' wide		ALLEY 12' wide		ALLEY 12' wide		ALLEY 12' wide	

CHILLICOTHE ST. 60' wide

McCune, Conway & Gibbons ADD.

IRON PIN.

S 40° W

1289	1288	1287	1286	1285	1284	1283	1282	1281	1280	139	1279	1278	1277	1276	1275
41'	41'	41'	41'	41'	41'	41'	41'	41'	41'	41'	42'	42'	42'	42'	43'
ALLEY 15' wide		ALLEY 15' wide		ALLEY 12' wide		ALLEY 12' wide		ALLEY 12' wide		ALLEY 12' wide		ALLEY 12' wide		ALLEY 12' wide	

CHILLICOTHE STREET 60' wide

INDEXED ON MAP 6100 2P